



**PLAN**  
 SURVEYED BY: [ ]  
 DATE: [ ]  
 CHECKED BY: [ ]  
 DATE: [ ]  
 NOTE BOOK NO. [ ]  
 PLANNING CHECKED BY: [ ]  
 DATE: [ ]  
 STRUCTURE NO. [ ]

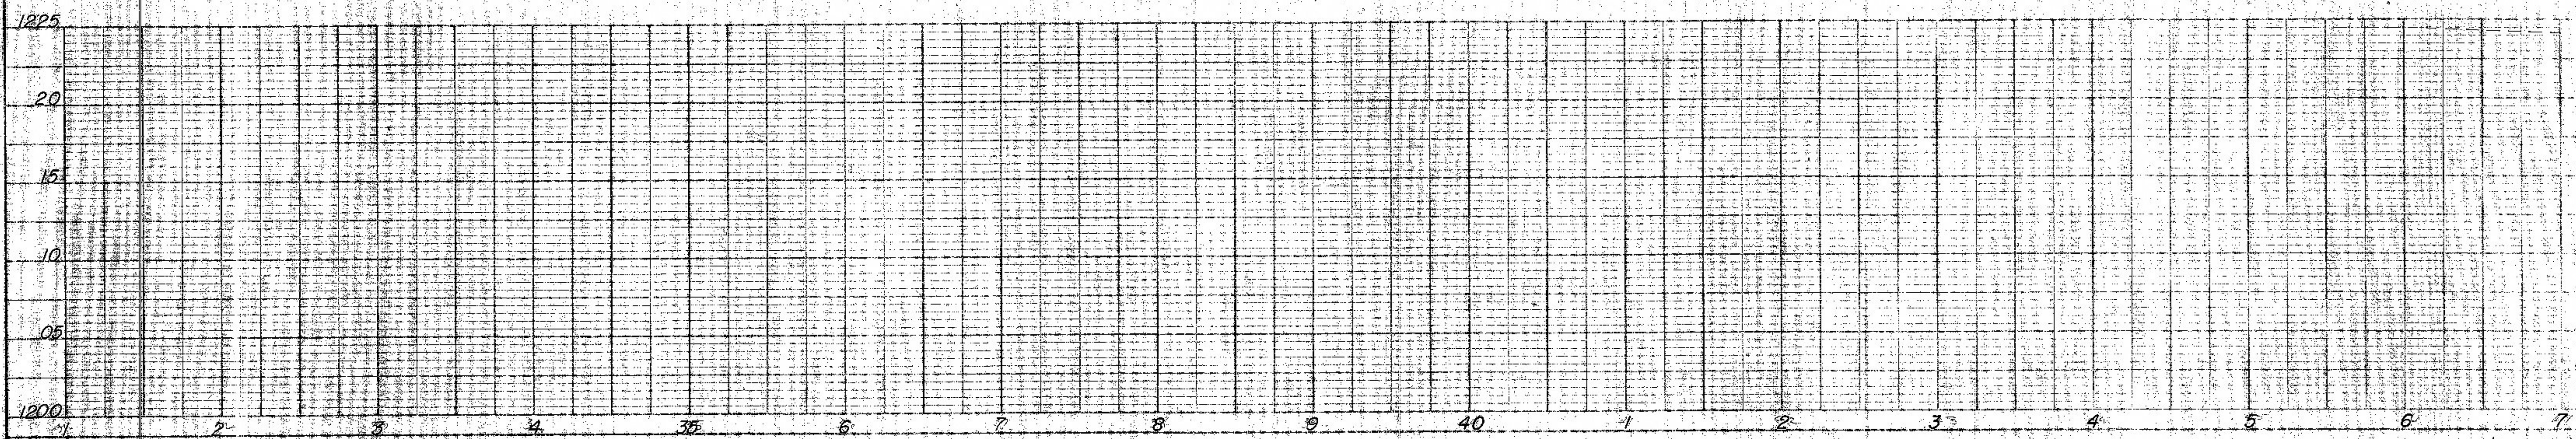

**PROFILE**  
 SURVEYED BY: [ ]  
 DATE: [ ]  
 CHECKED BY: [ ]  
 DATE: [ ]  
 NOTE BOOK NO. [ ]  
 PLANNING CHECKED BY: [ ]  
 DATE: [ ]  
 STRUCTURE NO. [ ]

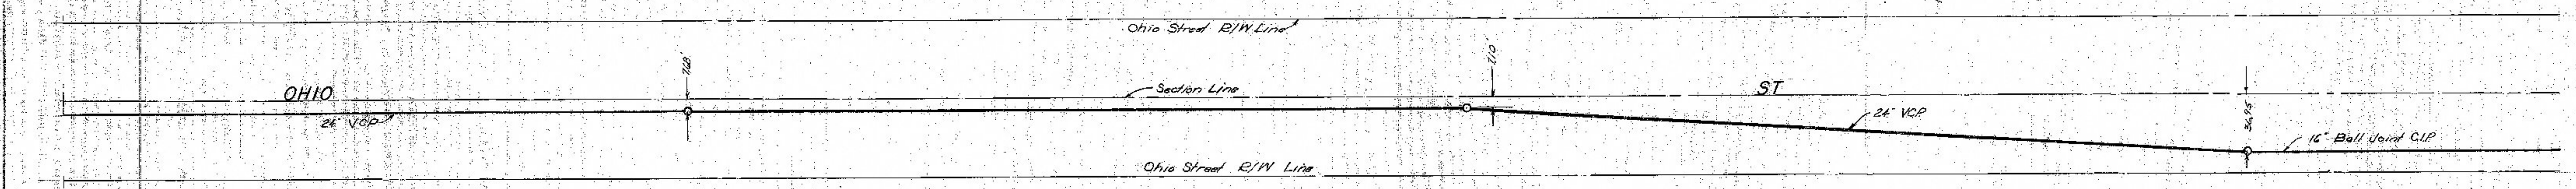