

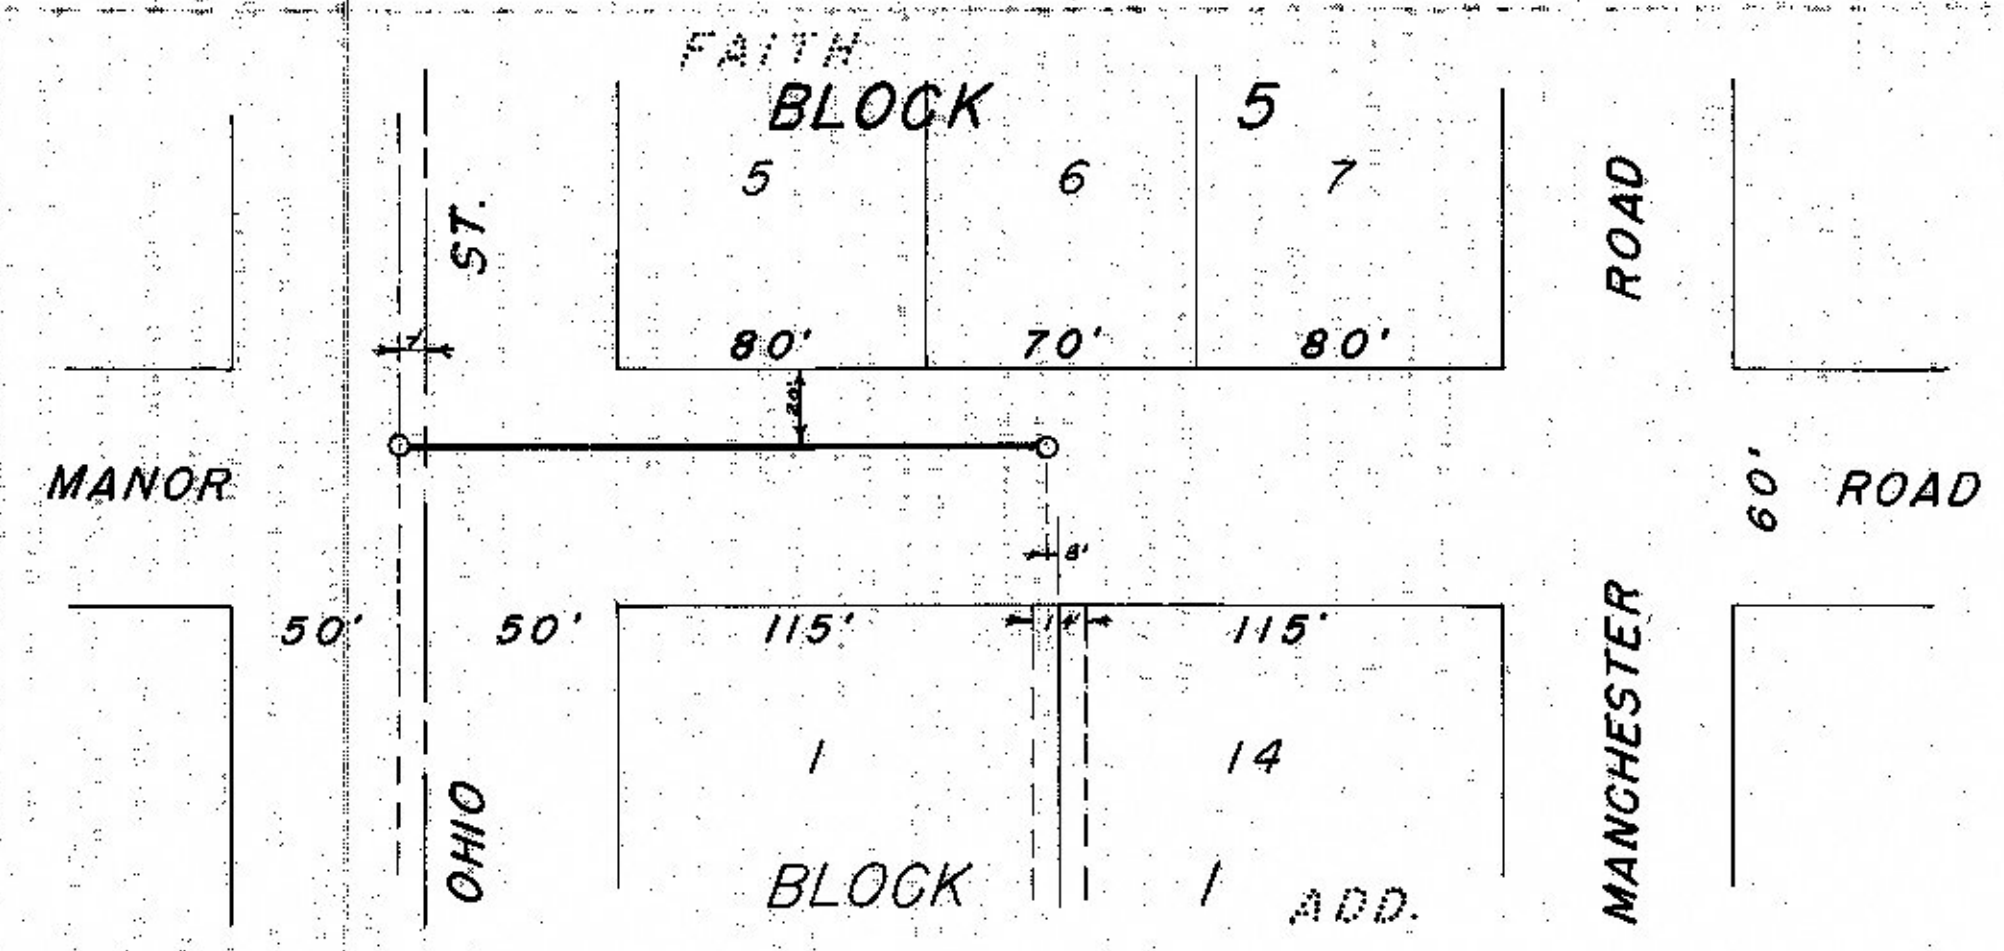
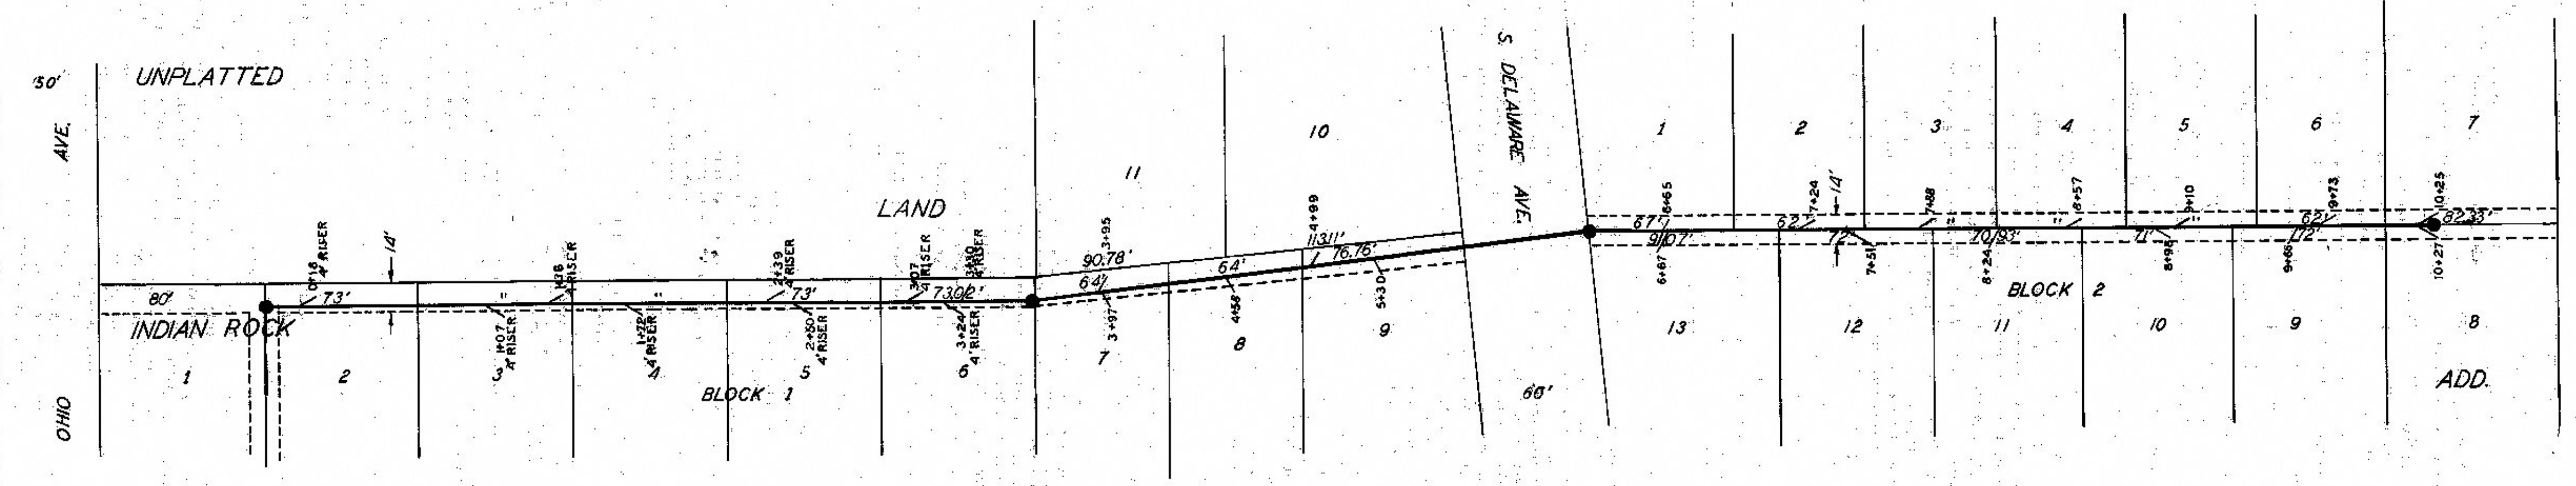


GG-63 P-14 F-2  
 (319)

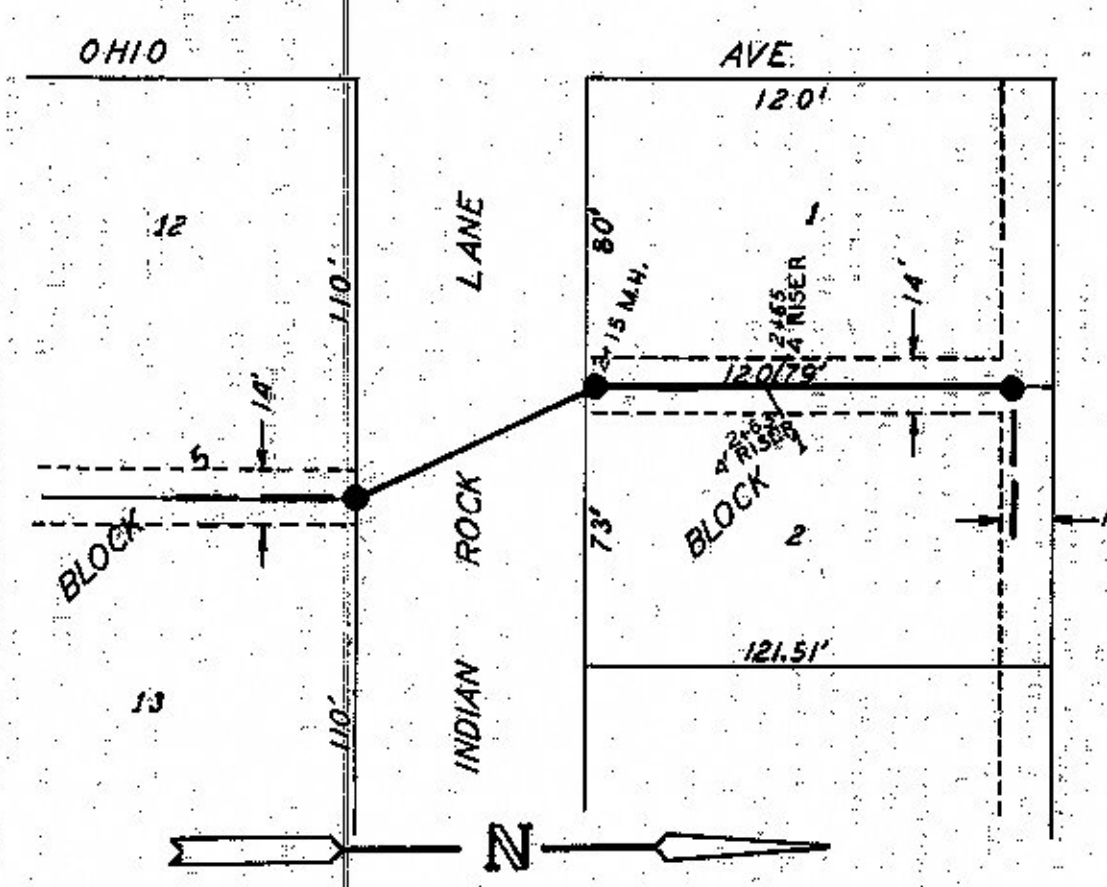

LATERAL 380 1 ST. RIW E. OHIO - MANOR TO McADAMS

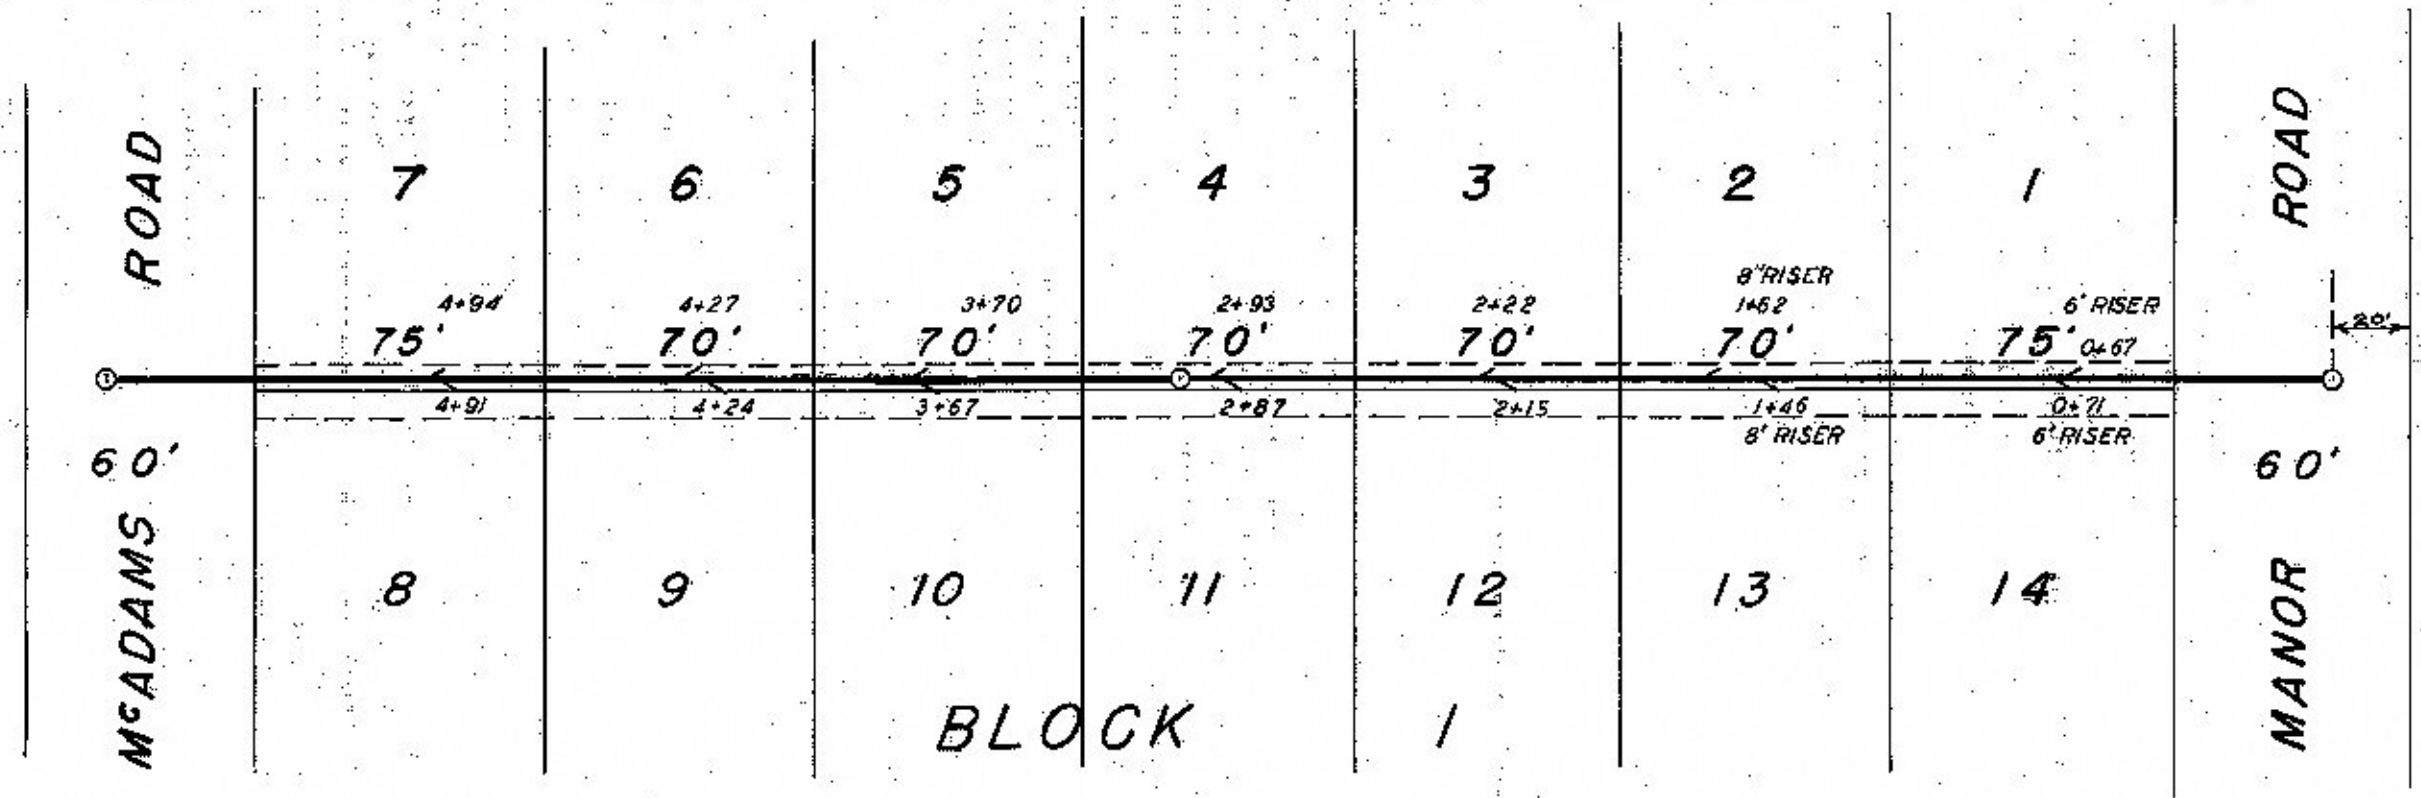

LAT 422

