

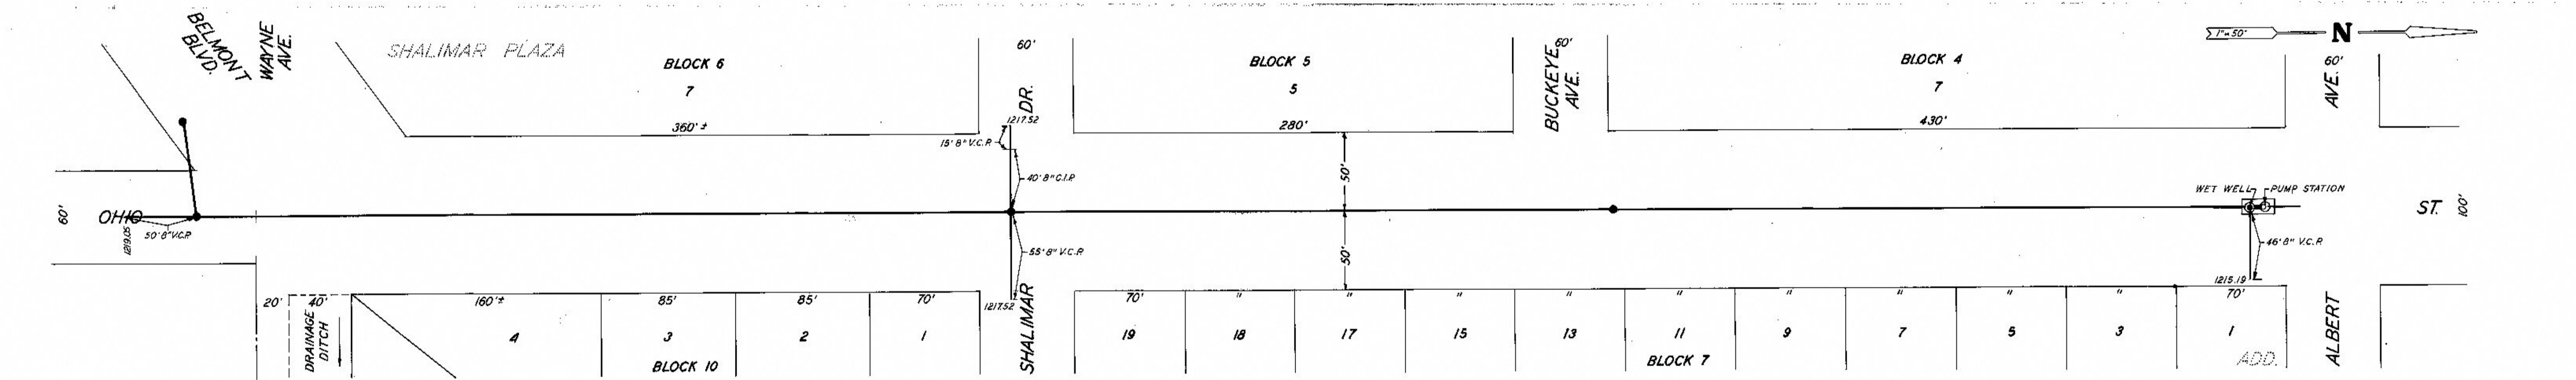


SANITARY SEWER FORCE MAIN 'A1' OHIO ST. - ALBERT TO CLOUD

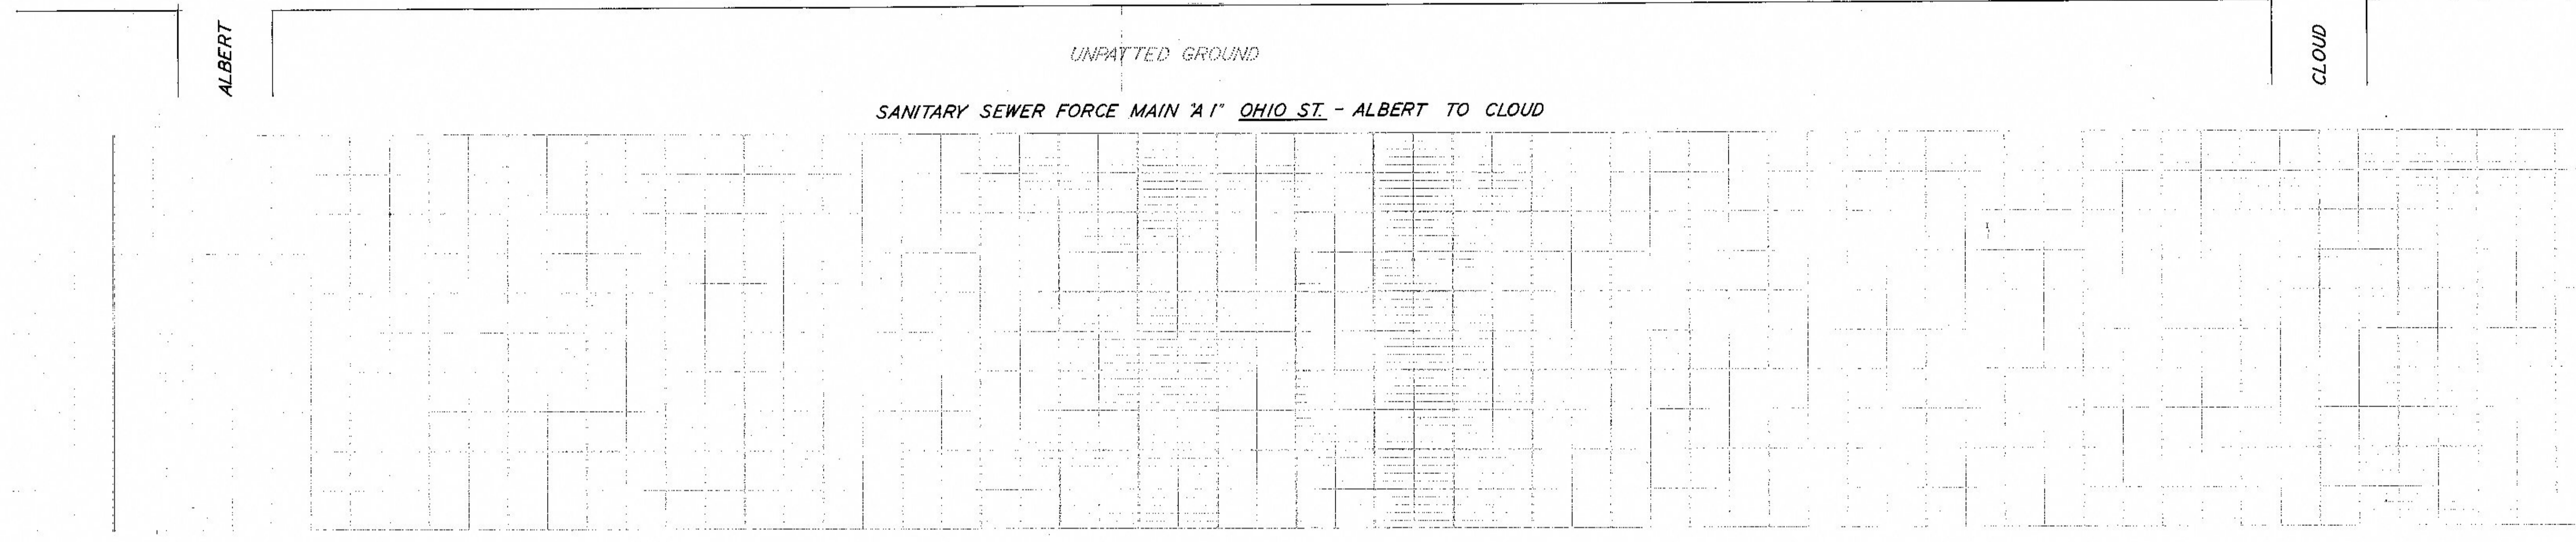

SANITARY SEWER MAIN 'A1' OHIO ST. - ALBERT TO BELMONT

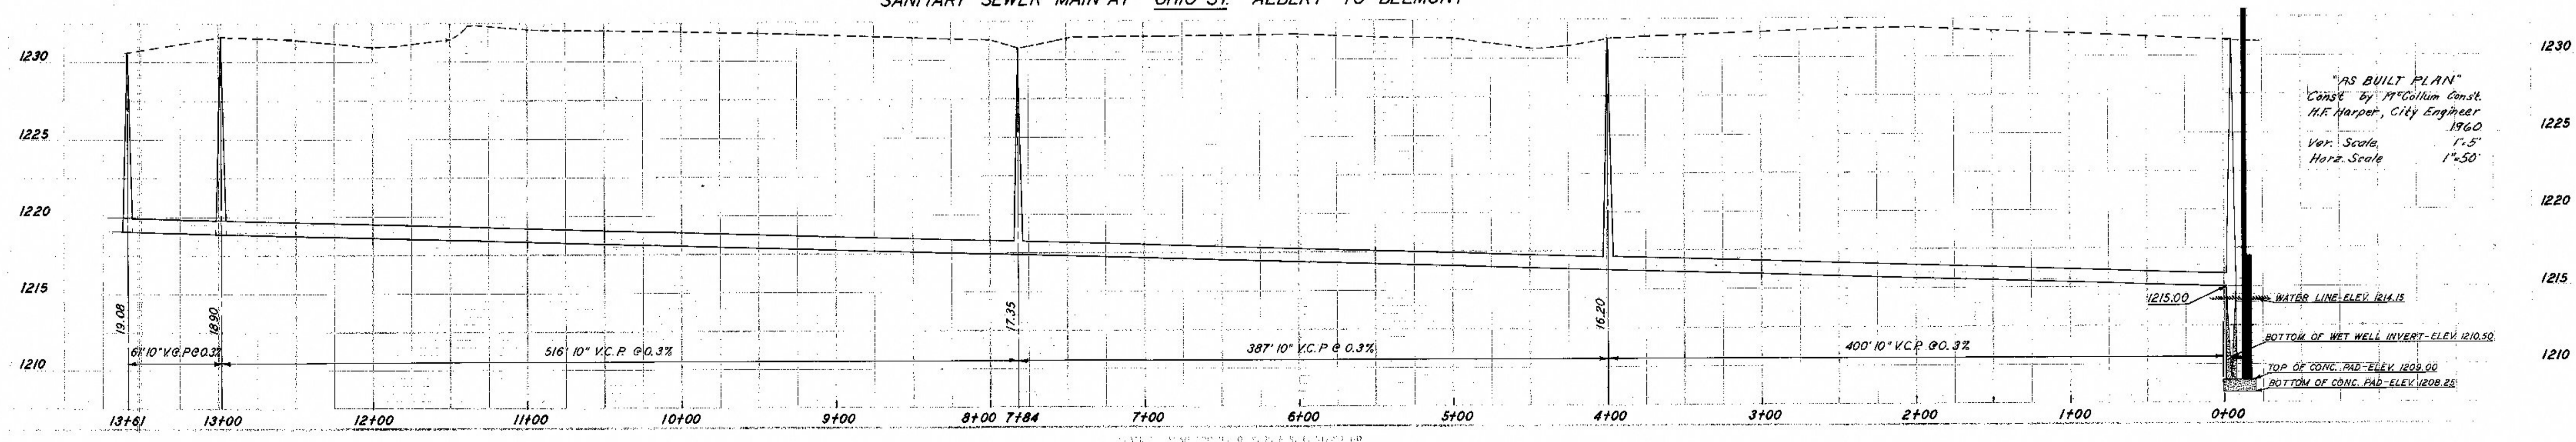

"AS BUILT PLAN"  
 CONSD. BY: M<sup>CE</sup> COLLUM CONST.  
 H.F. HARPER, CITY ENGINEER  
 1960  
 Vert. Scale: 1"=5'  
 Horiz. Scale: 1"=50'