



PLAN	DATE
BY	
CHECKED	
APPROVED	
NOTED	
NO.	

PROFILE	DATE
BY	
CHECKED	
APPROVED	
NOTED	
NO.	

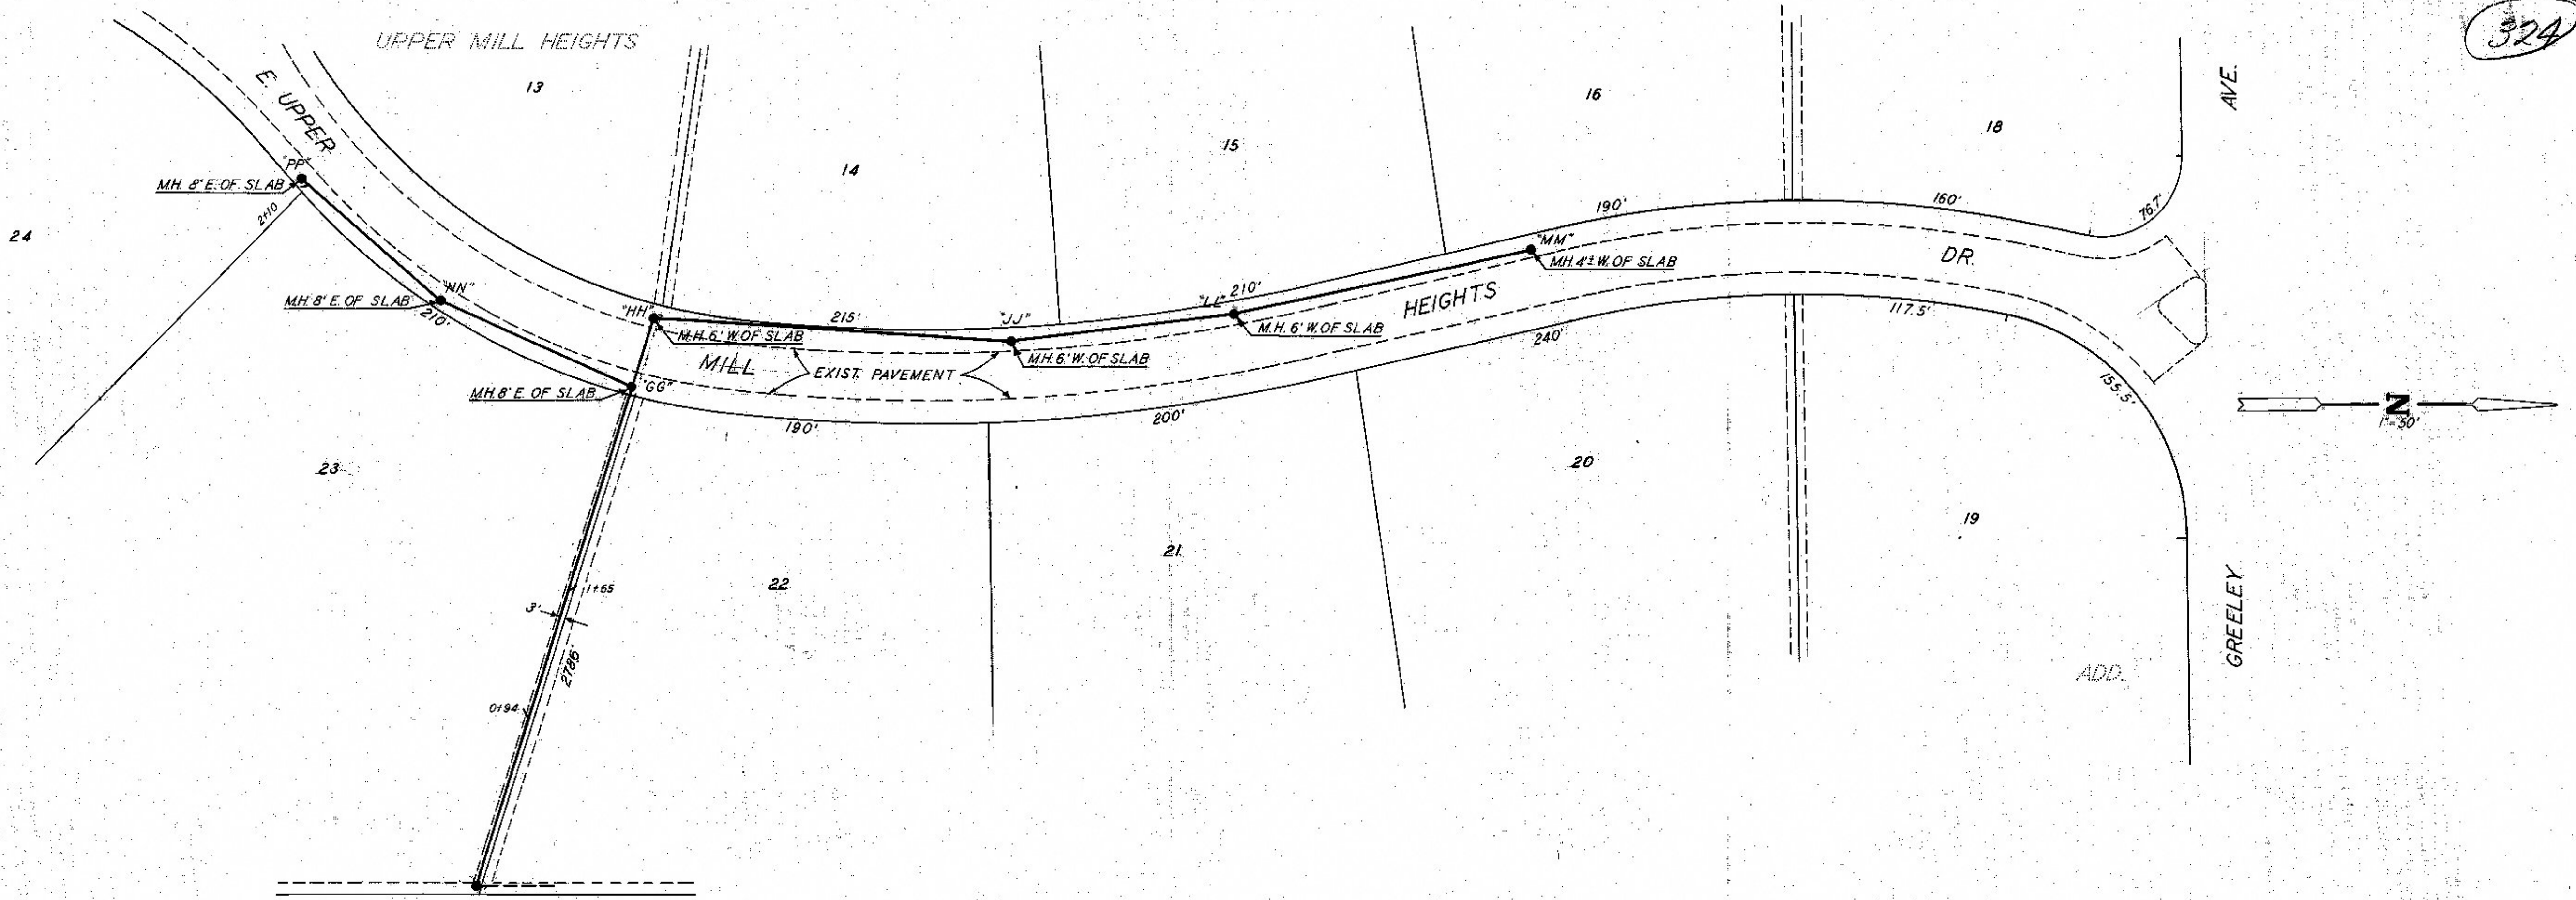

E. UPPER MILL HEIGHTS DRIVE SAN SEWER

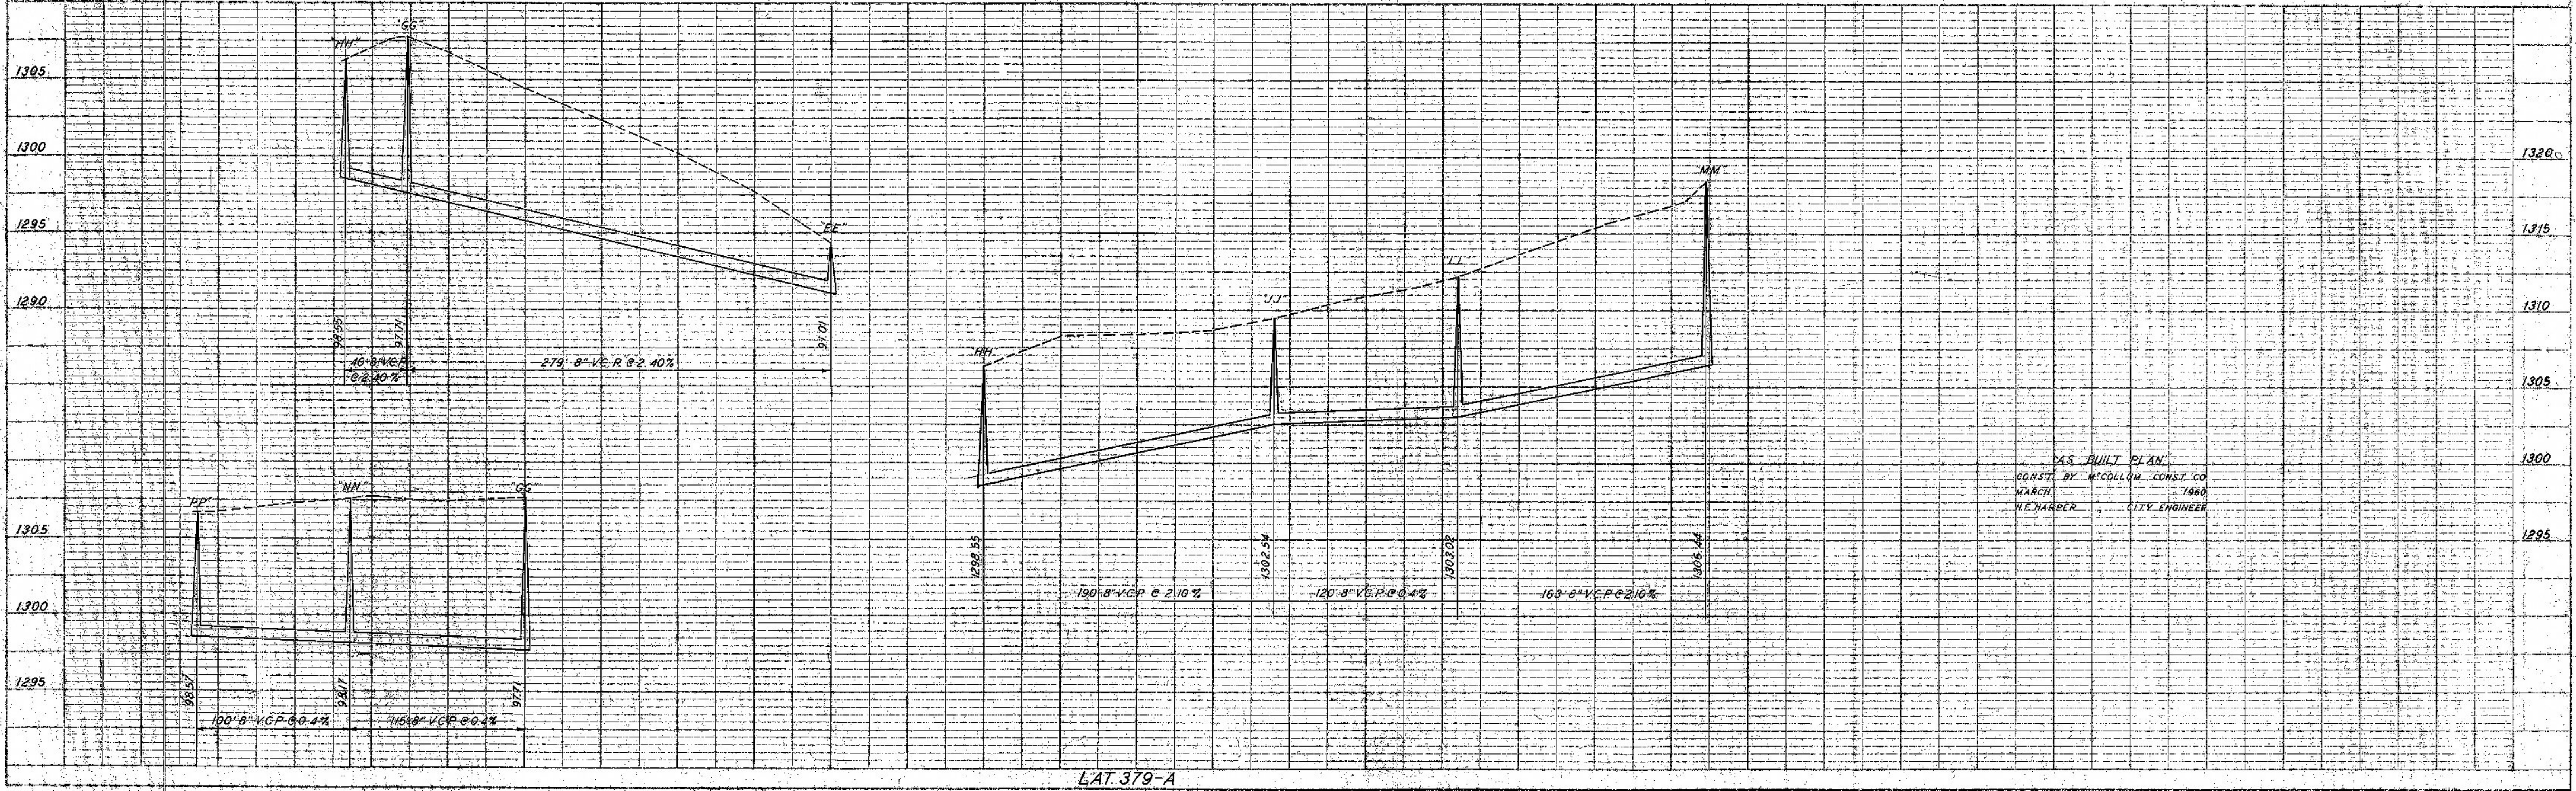

AS BUILT PLAN
 CONST. BY McCOLLUM CONST. CO.
 MARCH 1960
 W.F. HANBERG CITY ENGINEER