

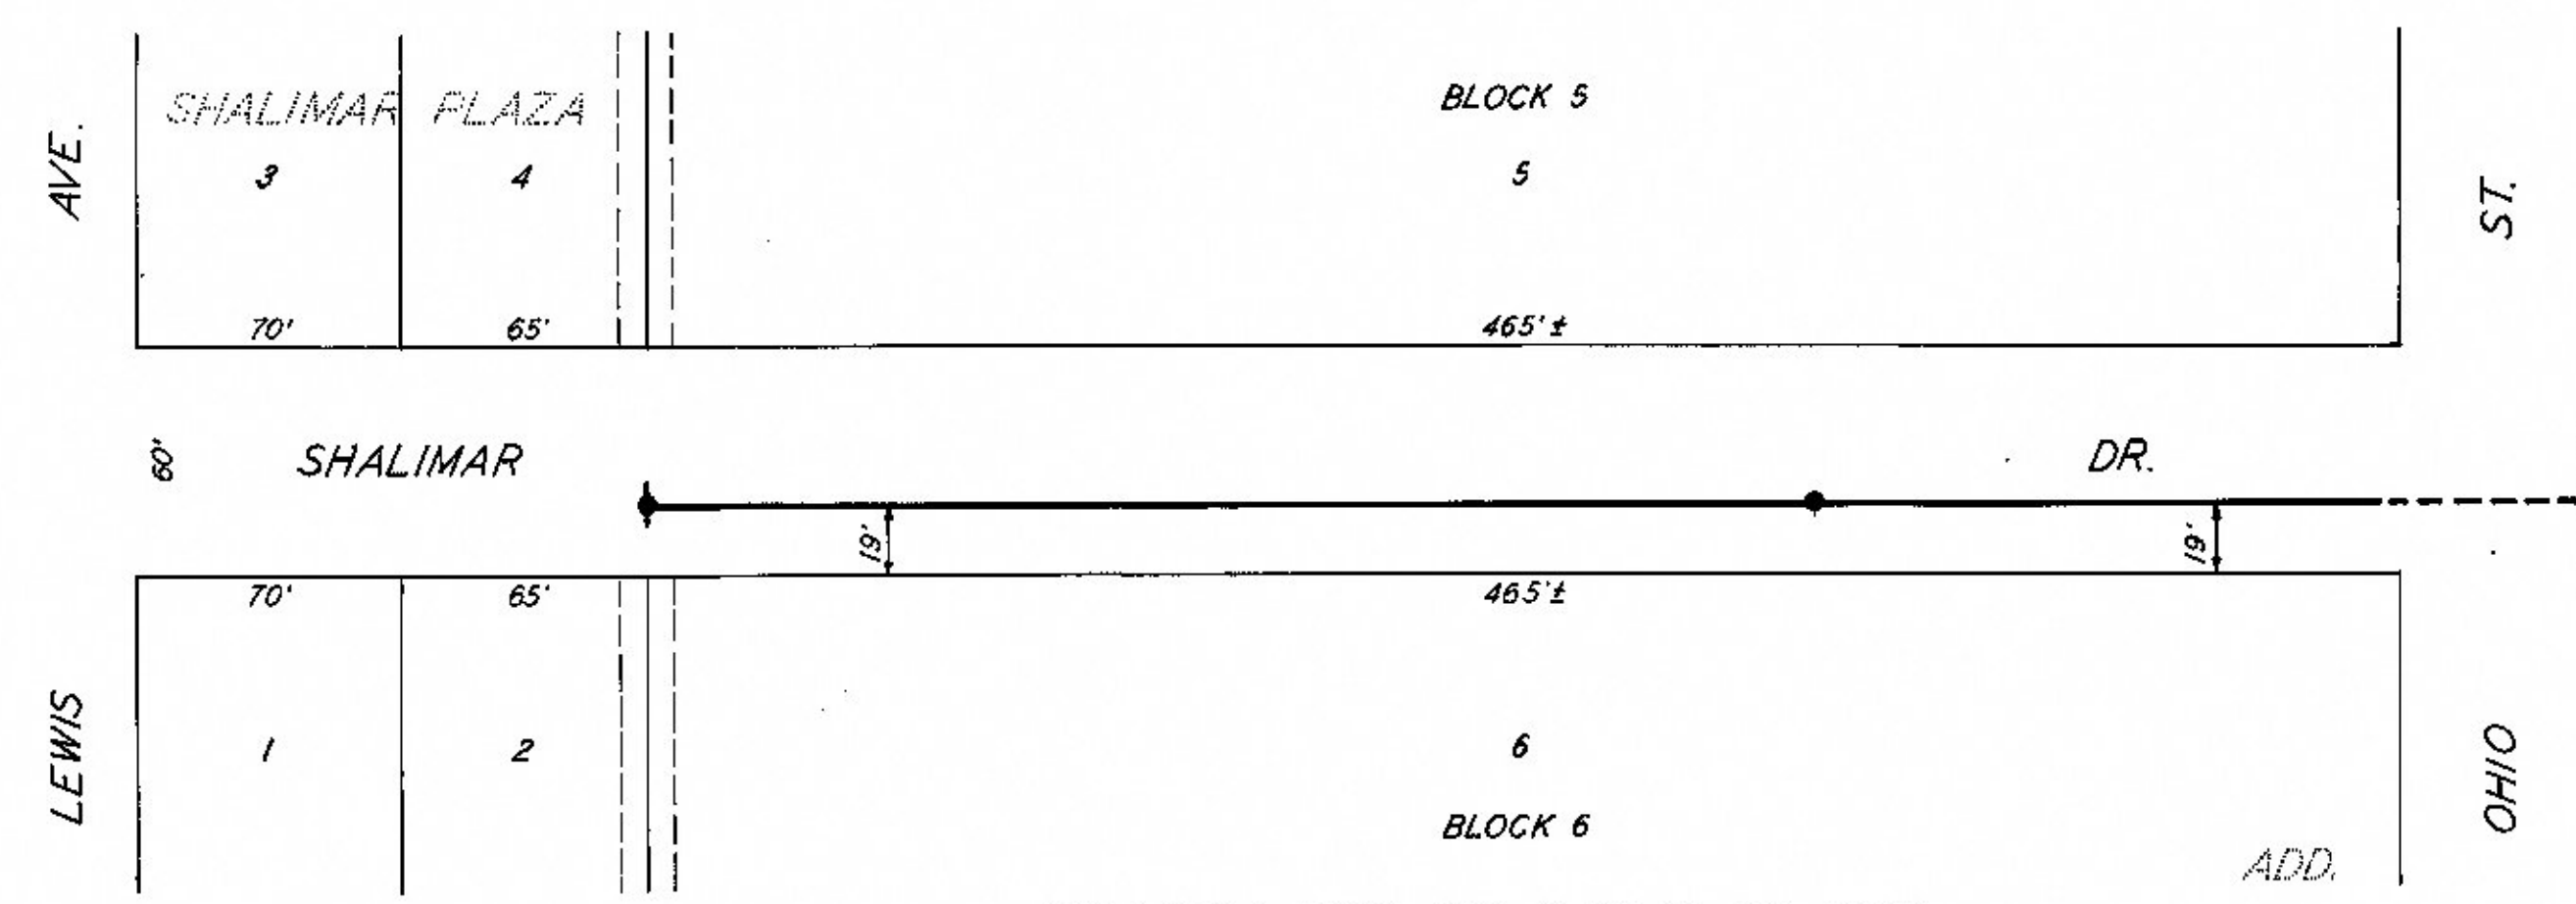



R/W W. OF OHIO - SHALIMAR TO R/W N. OF WAYNE

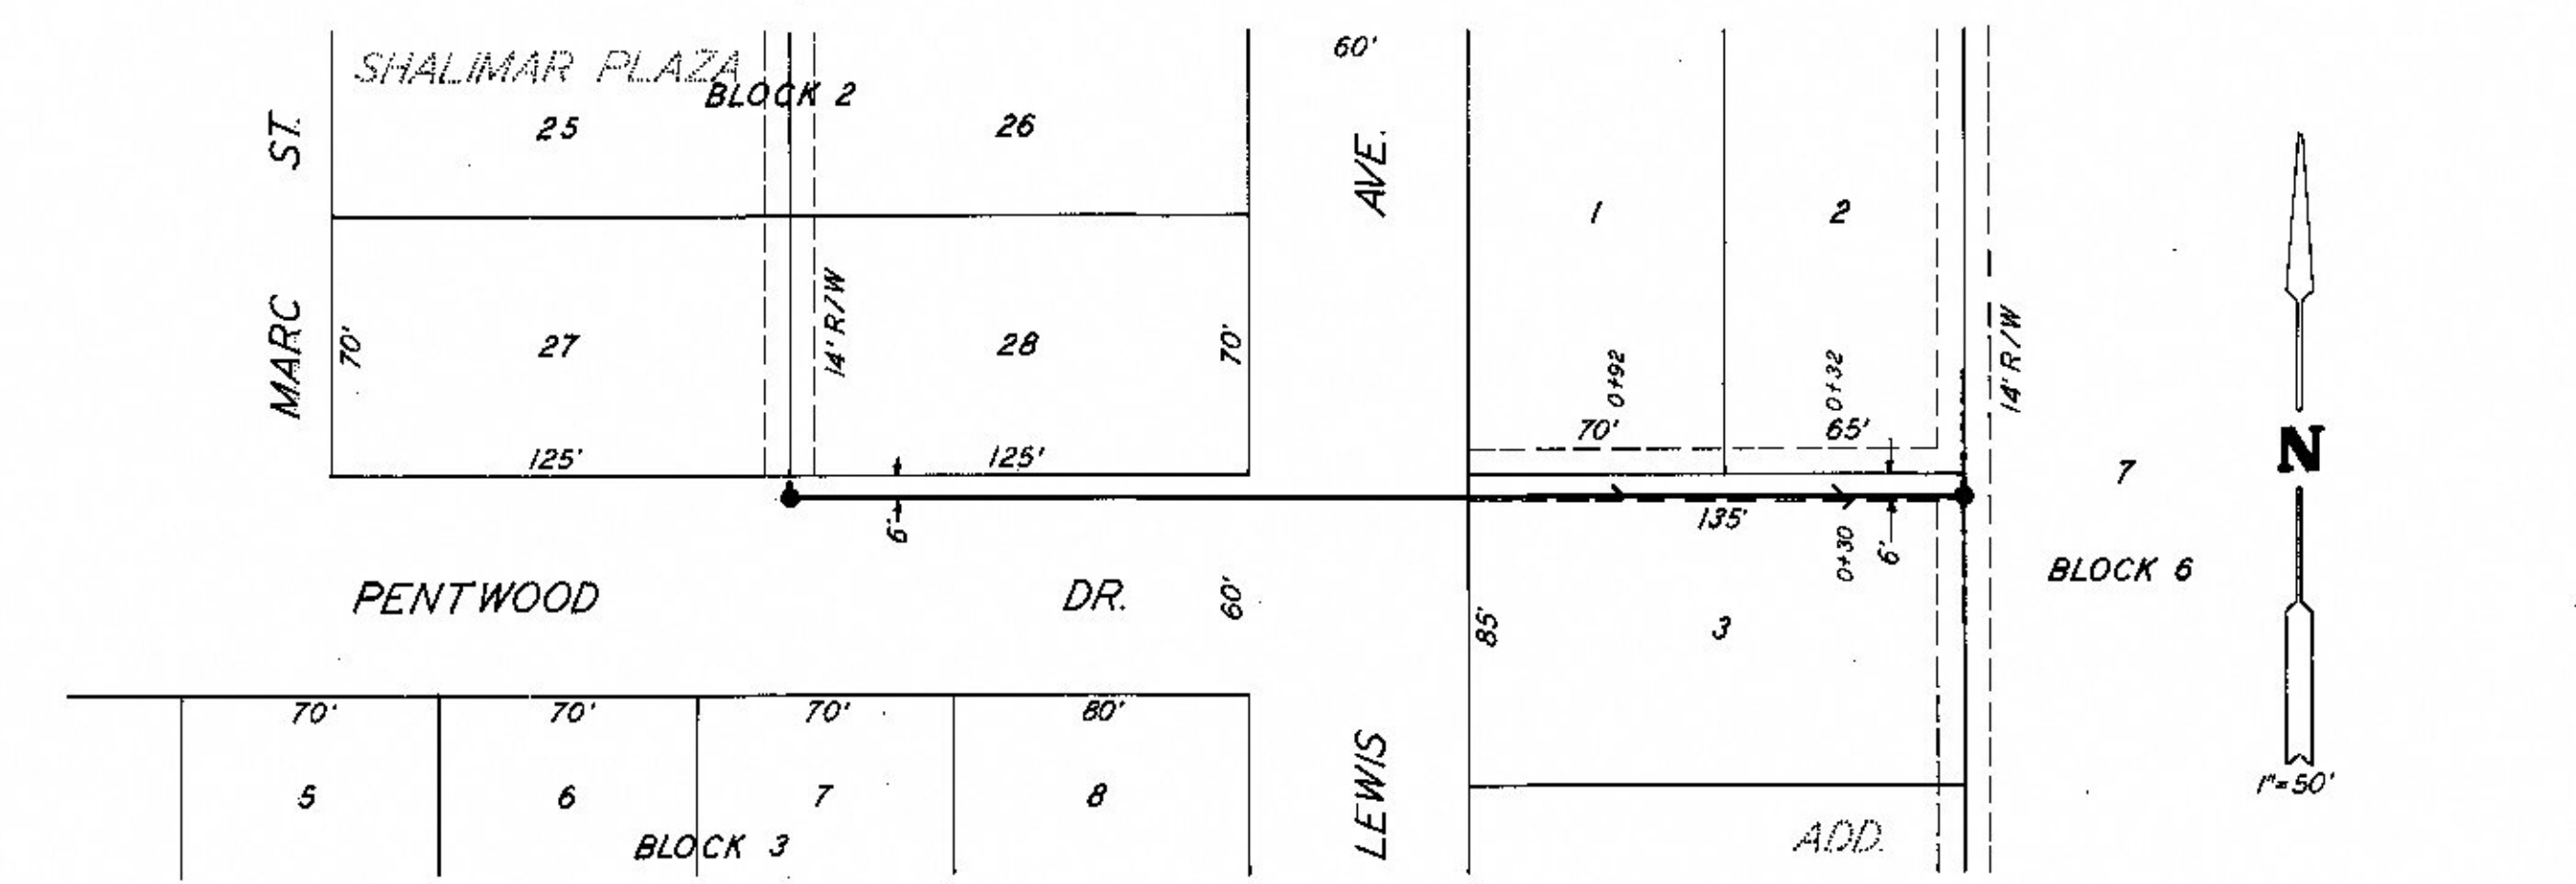


SHALIMAR - OHIO TO R/W W. OF OHIO

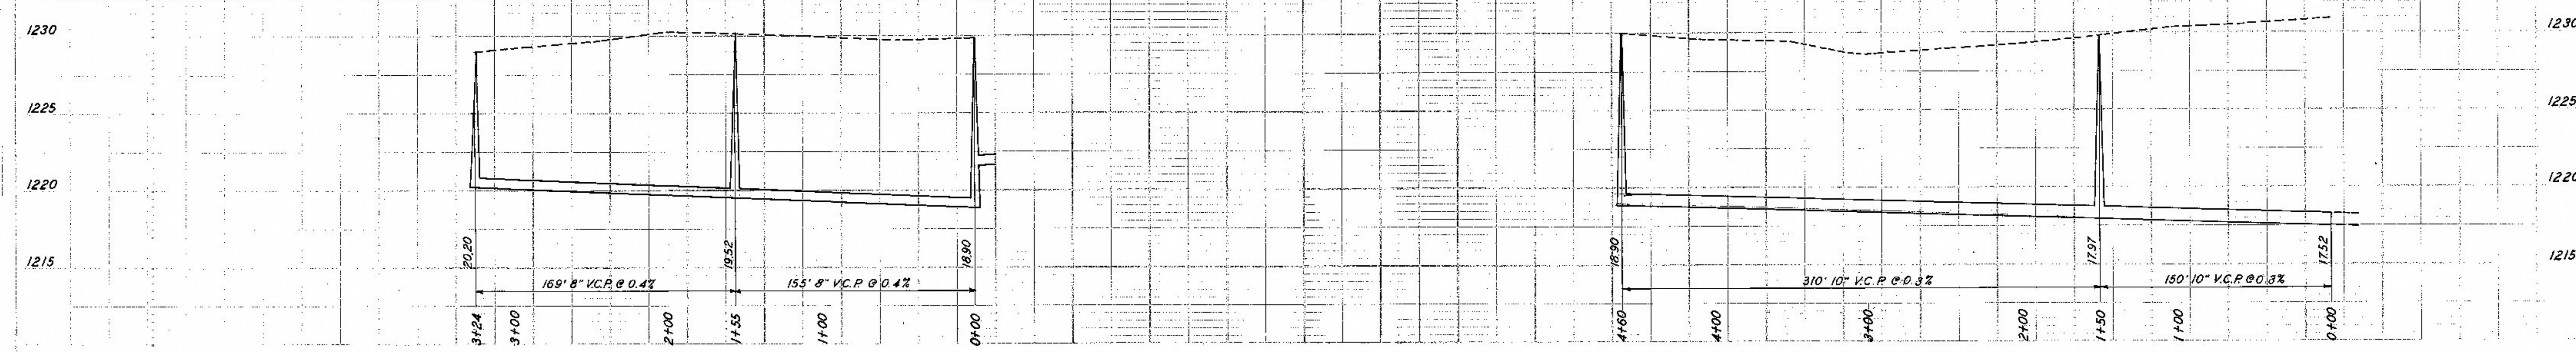

PENTWOOD - R/W W. OF OHIO TO R/W W. OF LEWIS

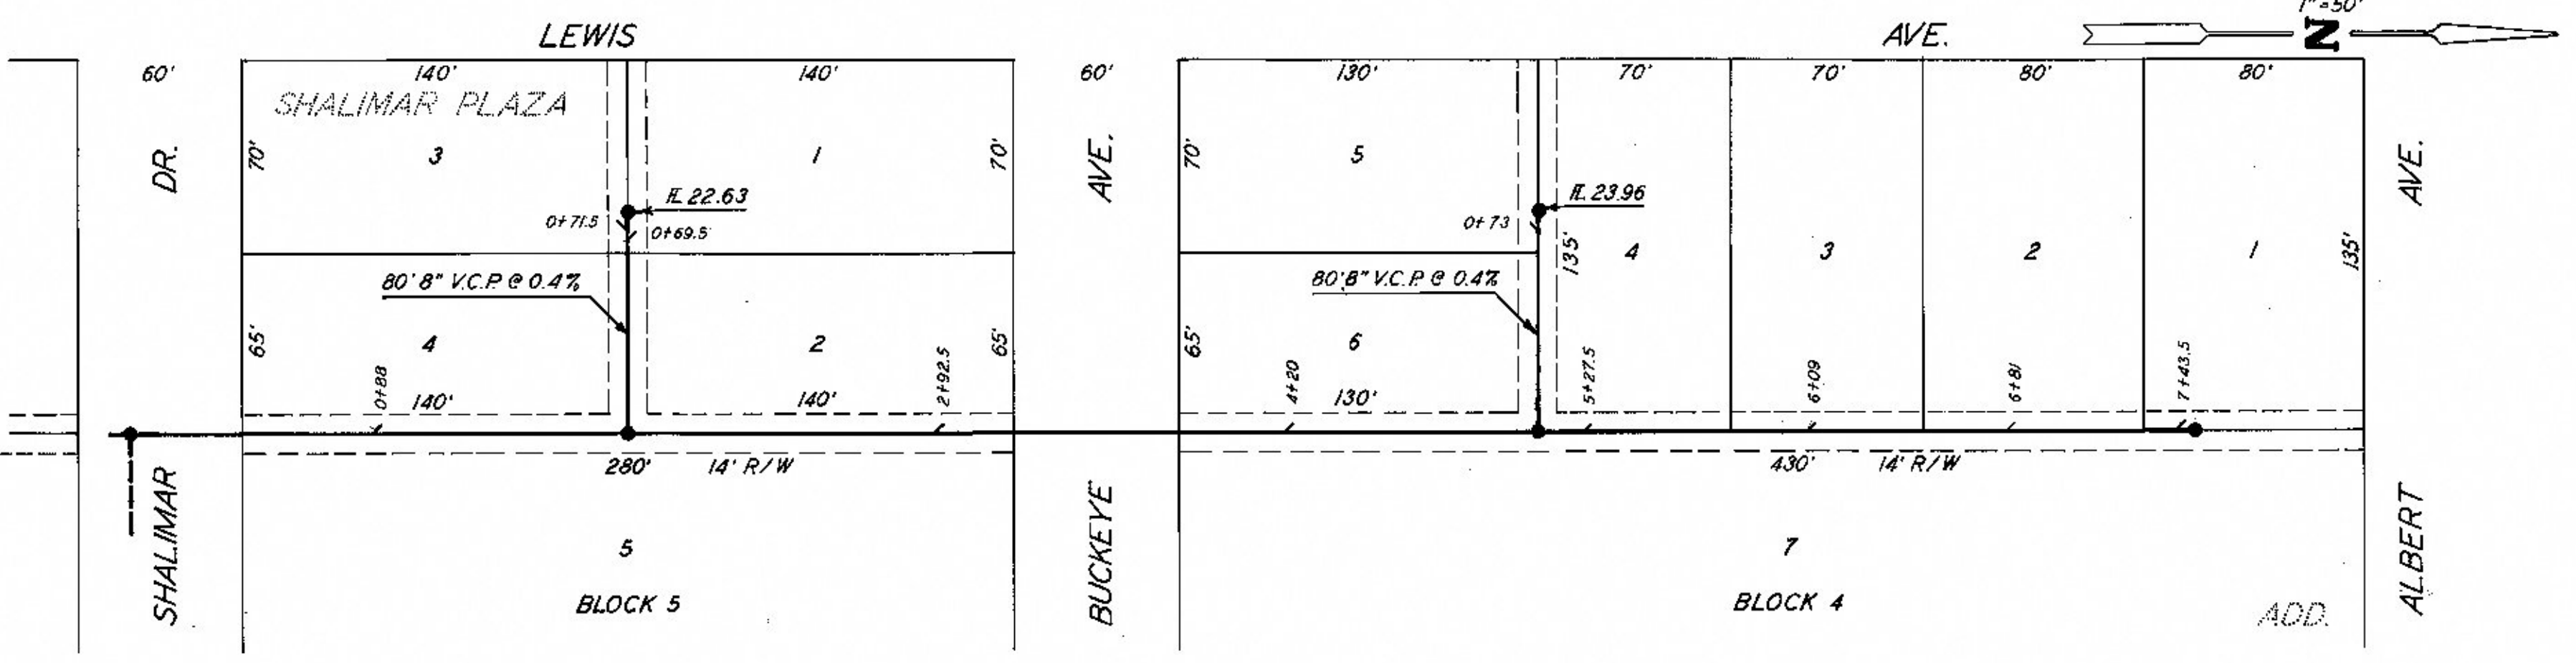

R/W W. OF OHIO - SHALIMAR TO ALBERT

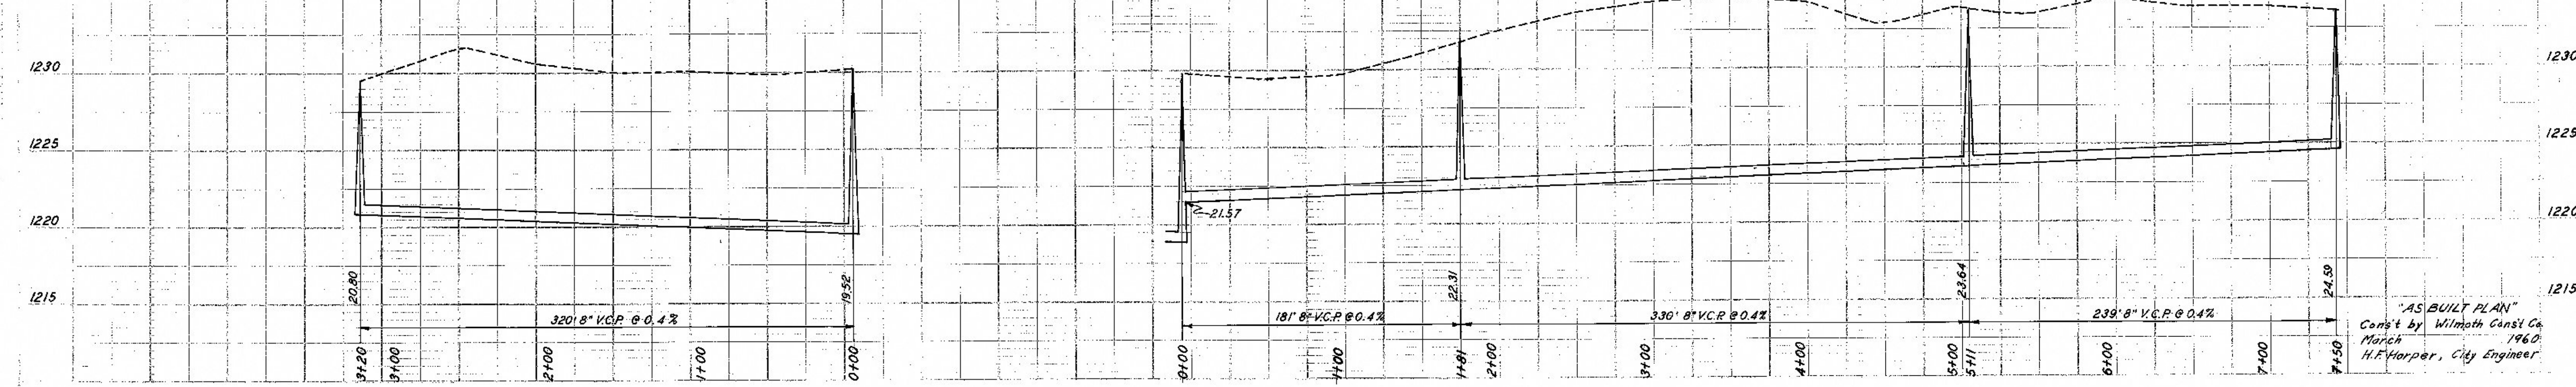

"AS BUILT PLAN"
 Const'd by Wilmoth Const Co.
 March 1960.
 H.F. Harper, City Engineer