

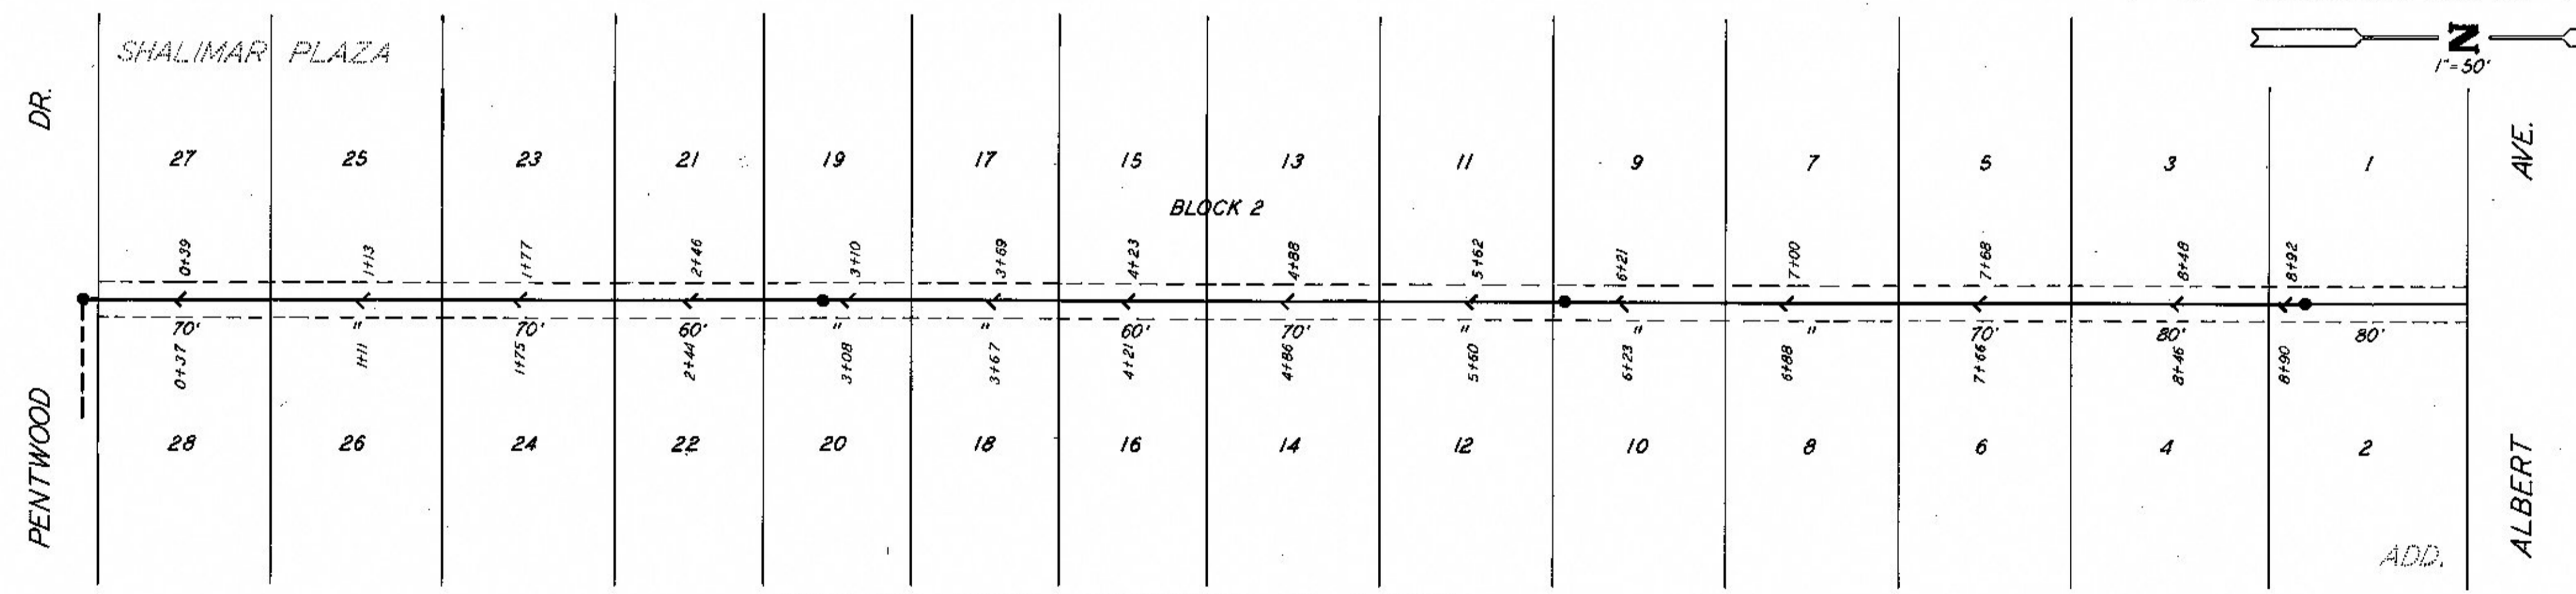


R/W E. OF ROACH - R/W N. OF WAYNE TO ALBERT

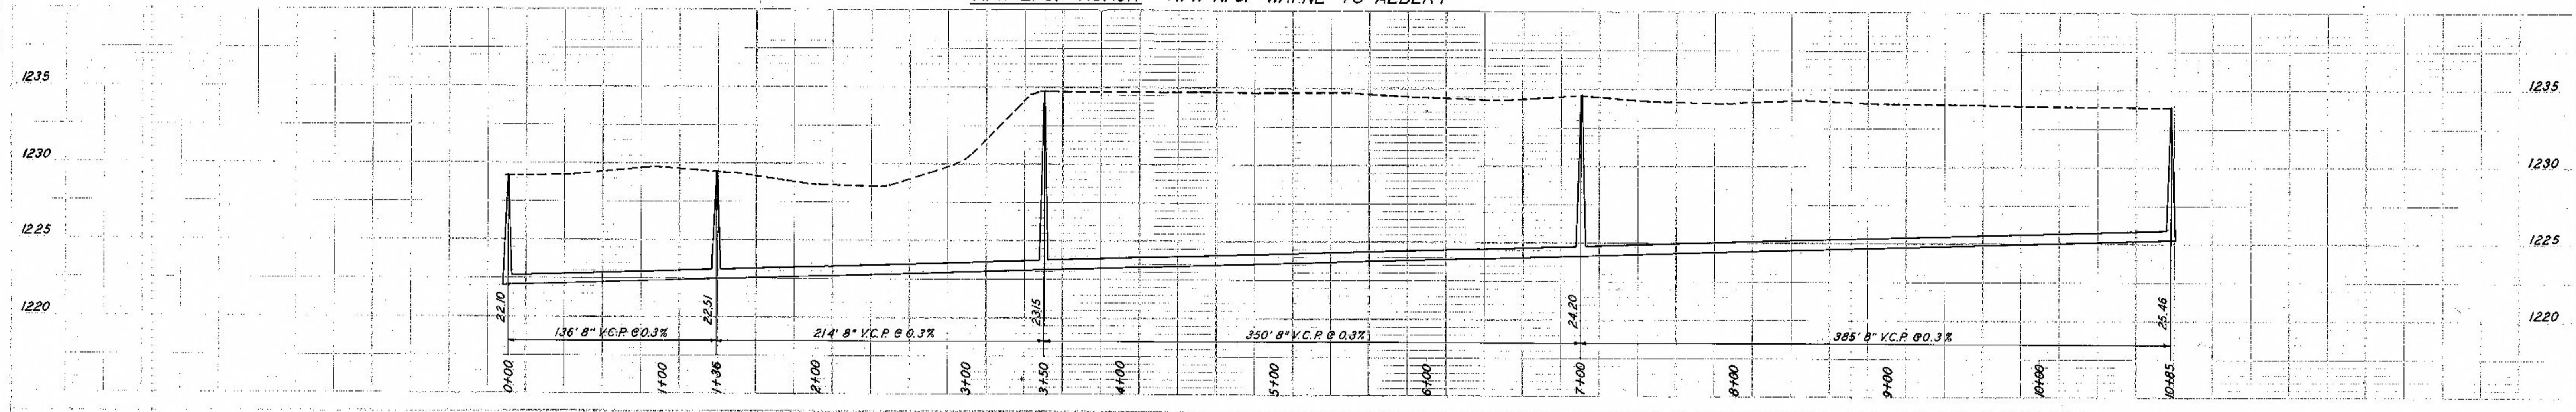

R/W W. OF LEWIS - PENTWOOD TO ALBERT

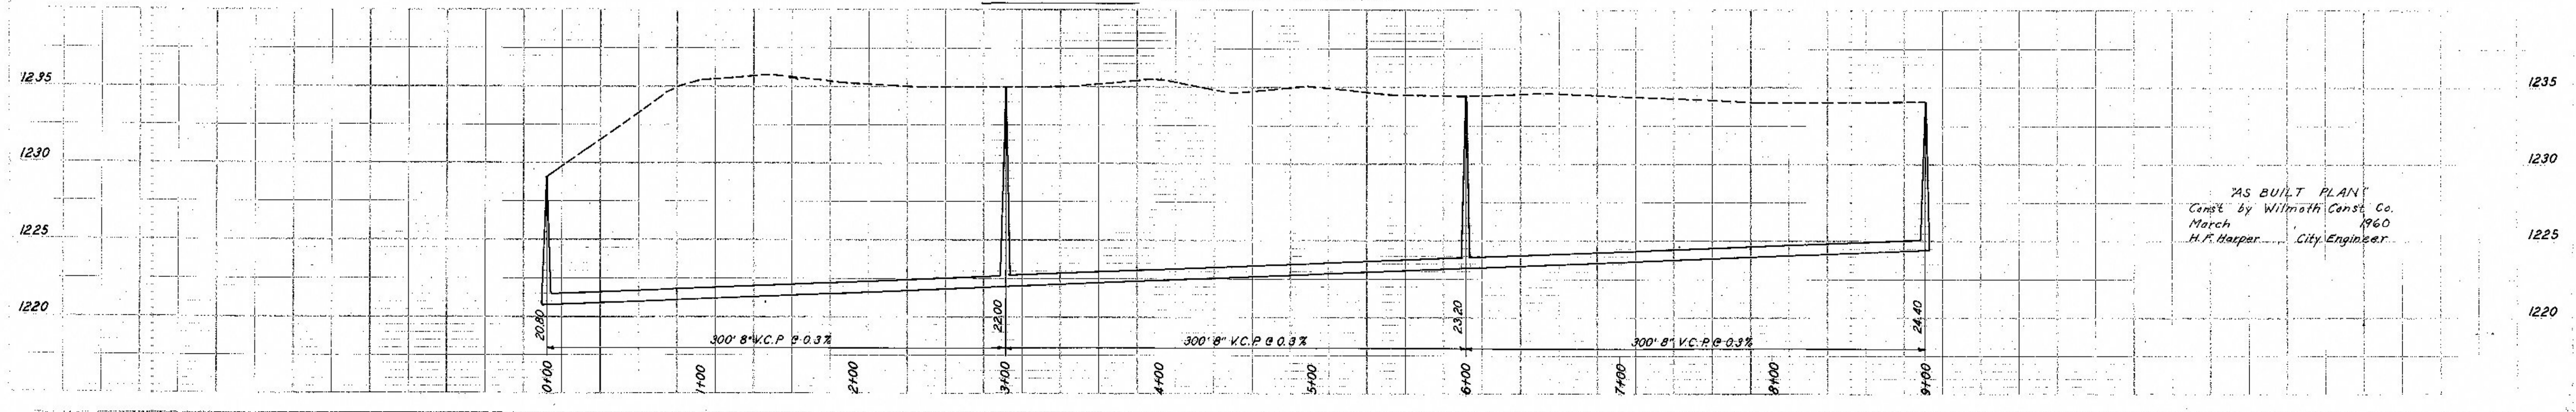

"AS BUILT PLAN"
 Const. by Wilmoth Const. Co.
 March 1960
 H. F. Harper, City Engineer