
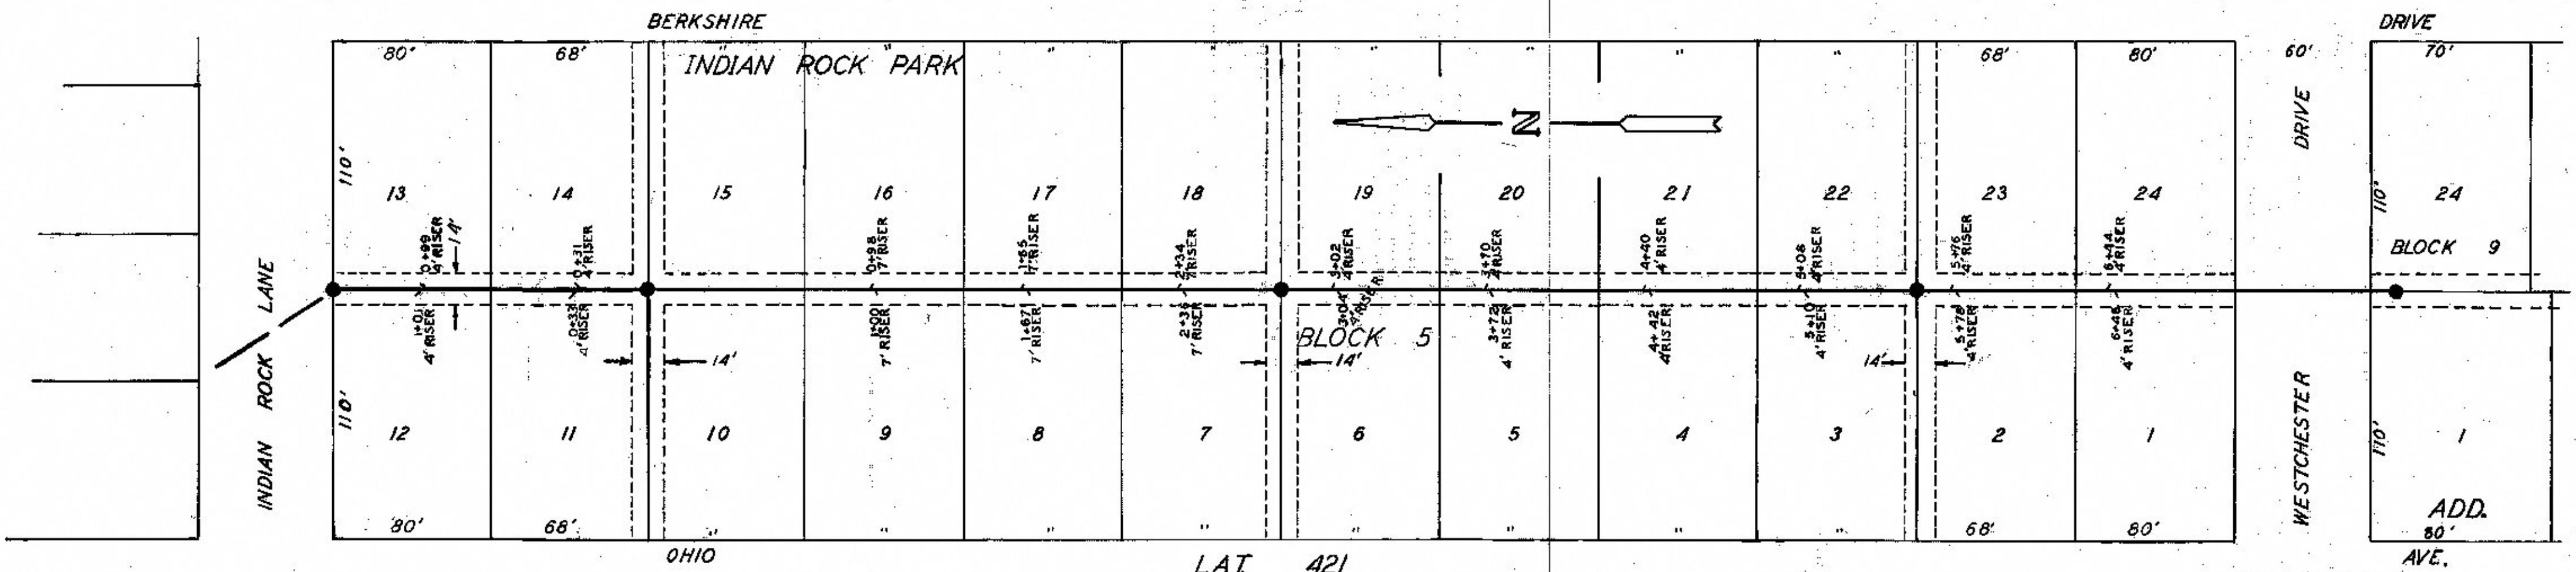
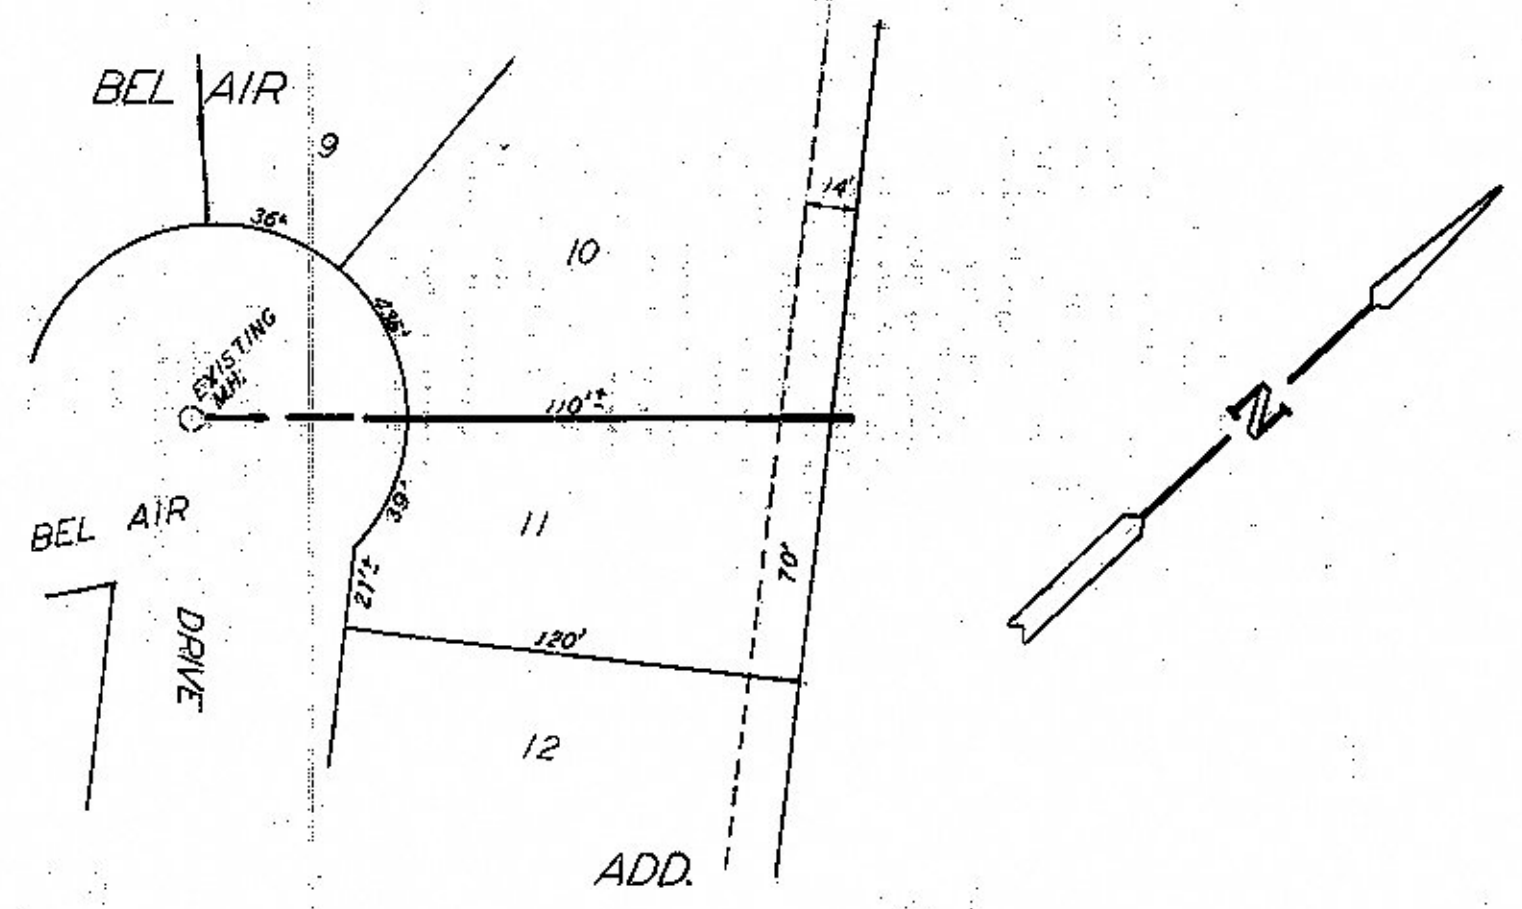


R/W NO. OF MILLWOOD FROM OHIO TO ROACH

AS BUILT PLAN
CONSTRUCTED BY
REXROAD CONST. CO.
1960 HEHARPER, CITY ENG.

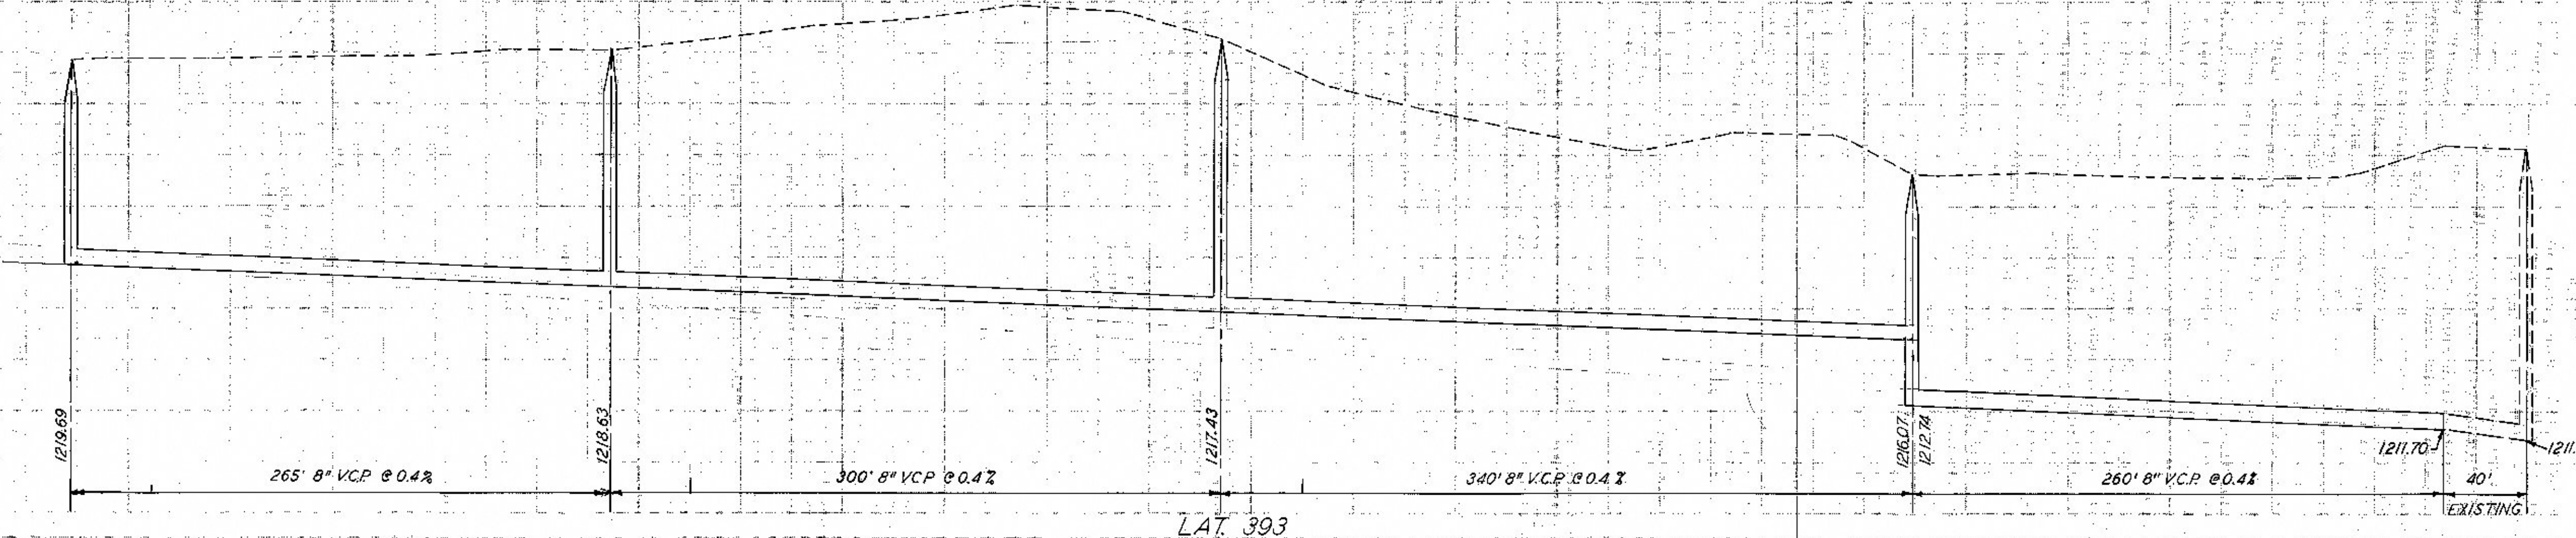

AS BUILT PLAN
CONSTRUCTED BY
GAGE PLUMBING CO.
1960 HEHARPER, CITY ENG.

AS BUILT PLAN
CONSTRUCTED BY
MC COLLUM CONST. CO.
1960 HEHARPER, CITY ENG.

