




RW EAST OF PEARL—BELMONT SOUTH TO LOT 31 BLOCK 10

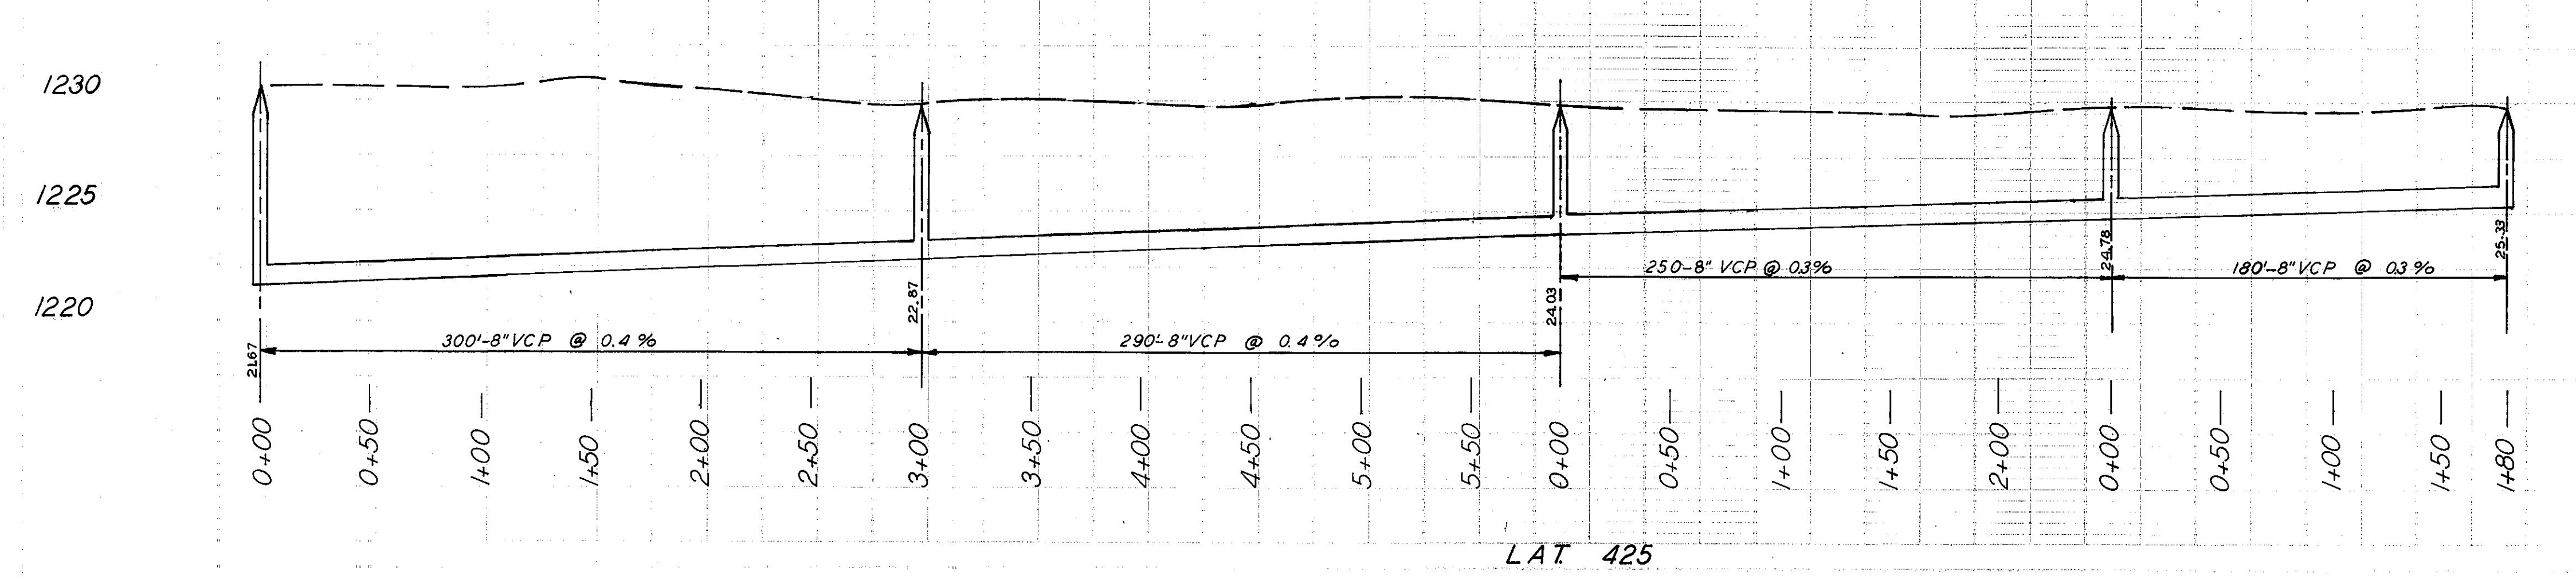


LAT. 425

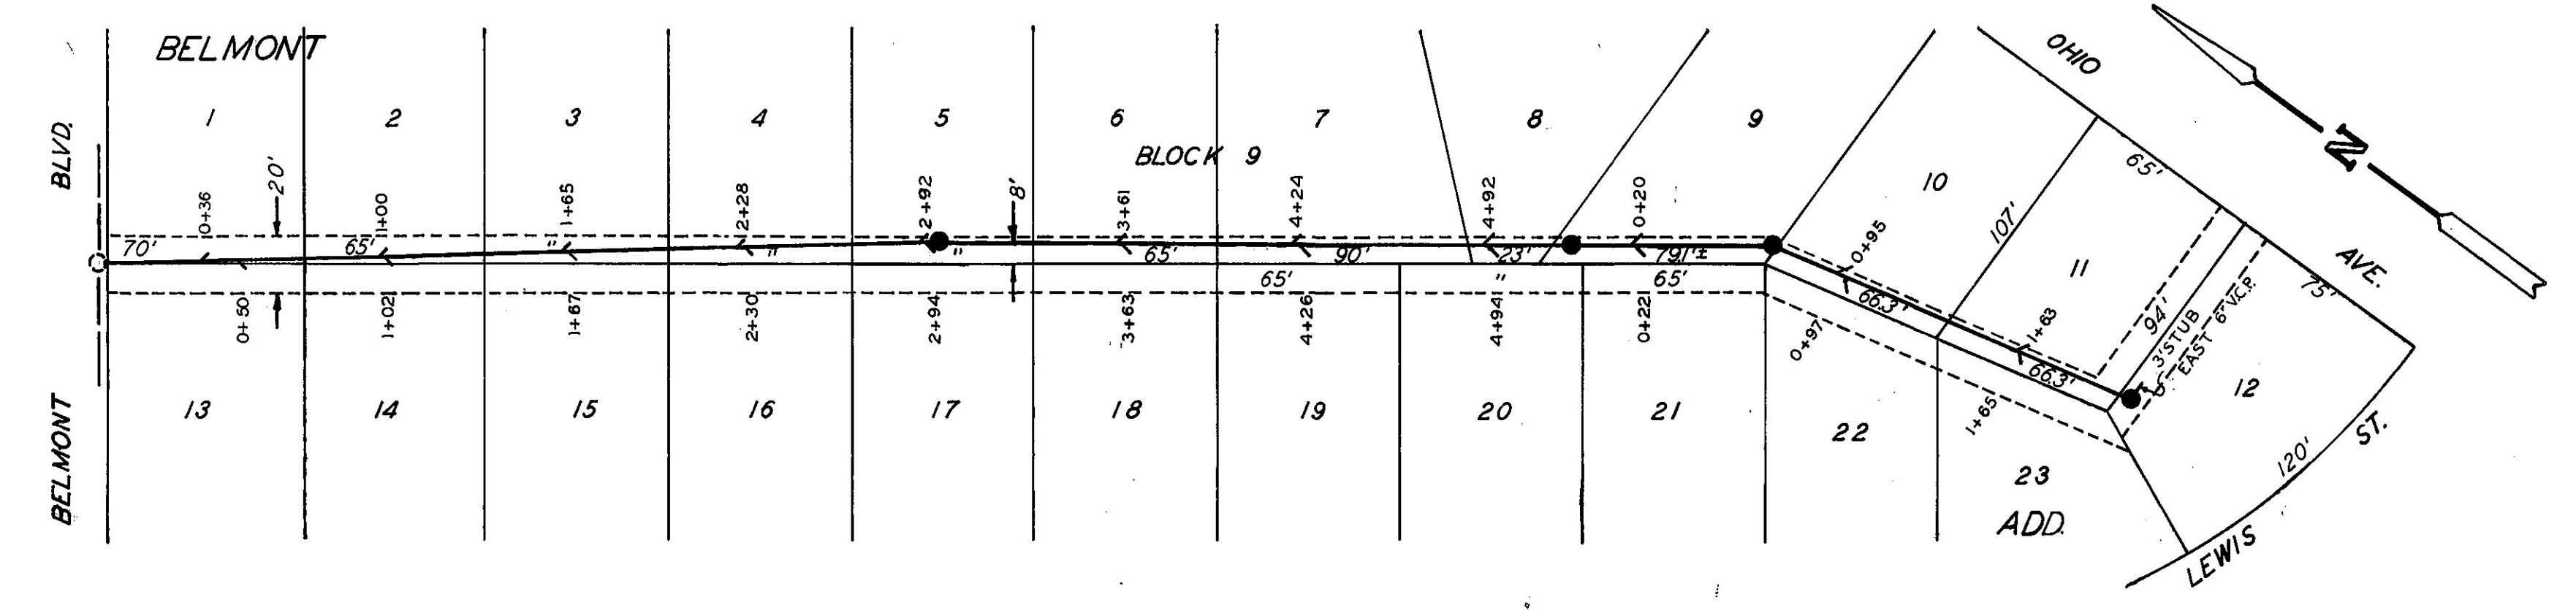


RW EAST OF LEWIS—BELMONT TO LOT 12 BLOCK 9

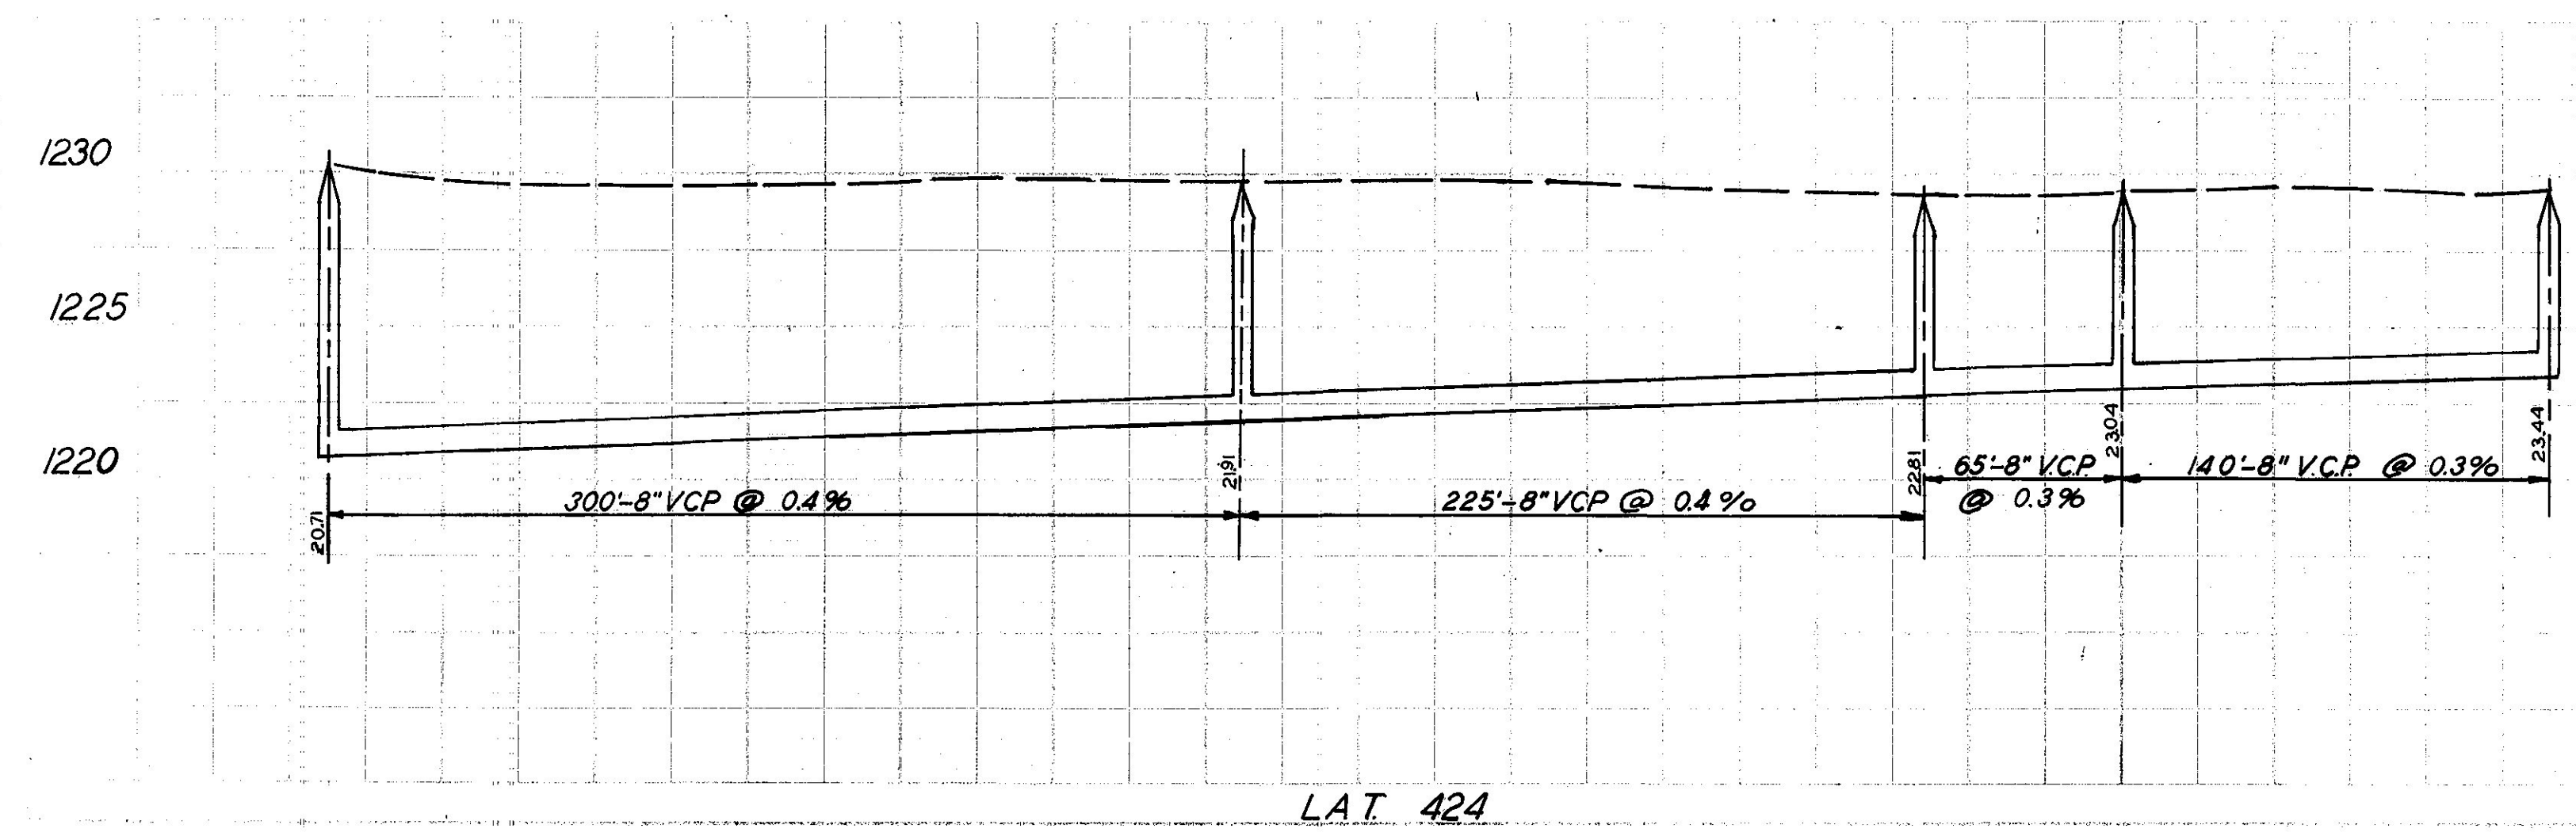

LAT. 424

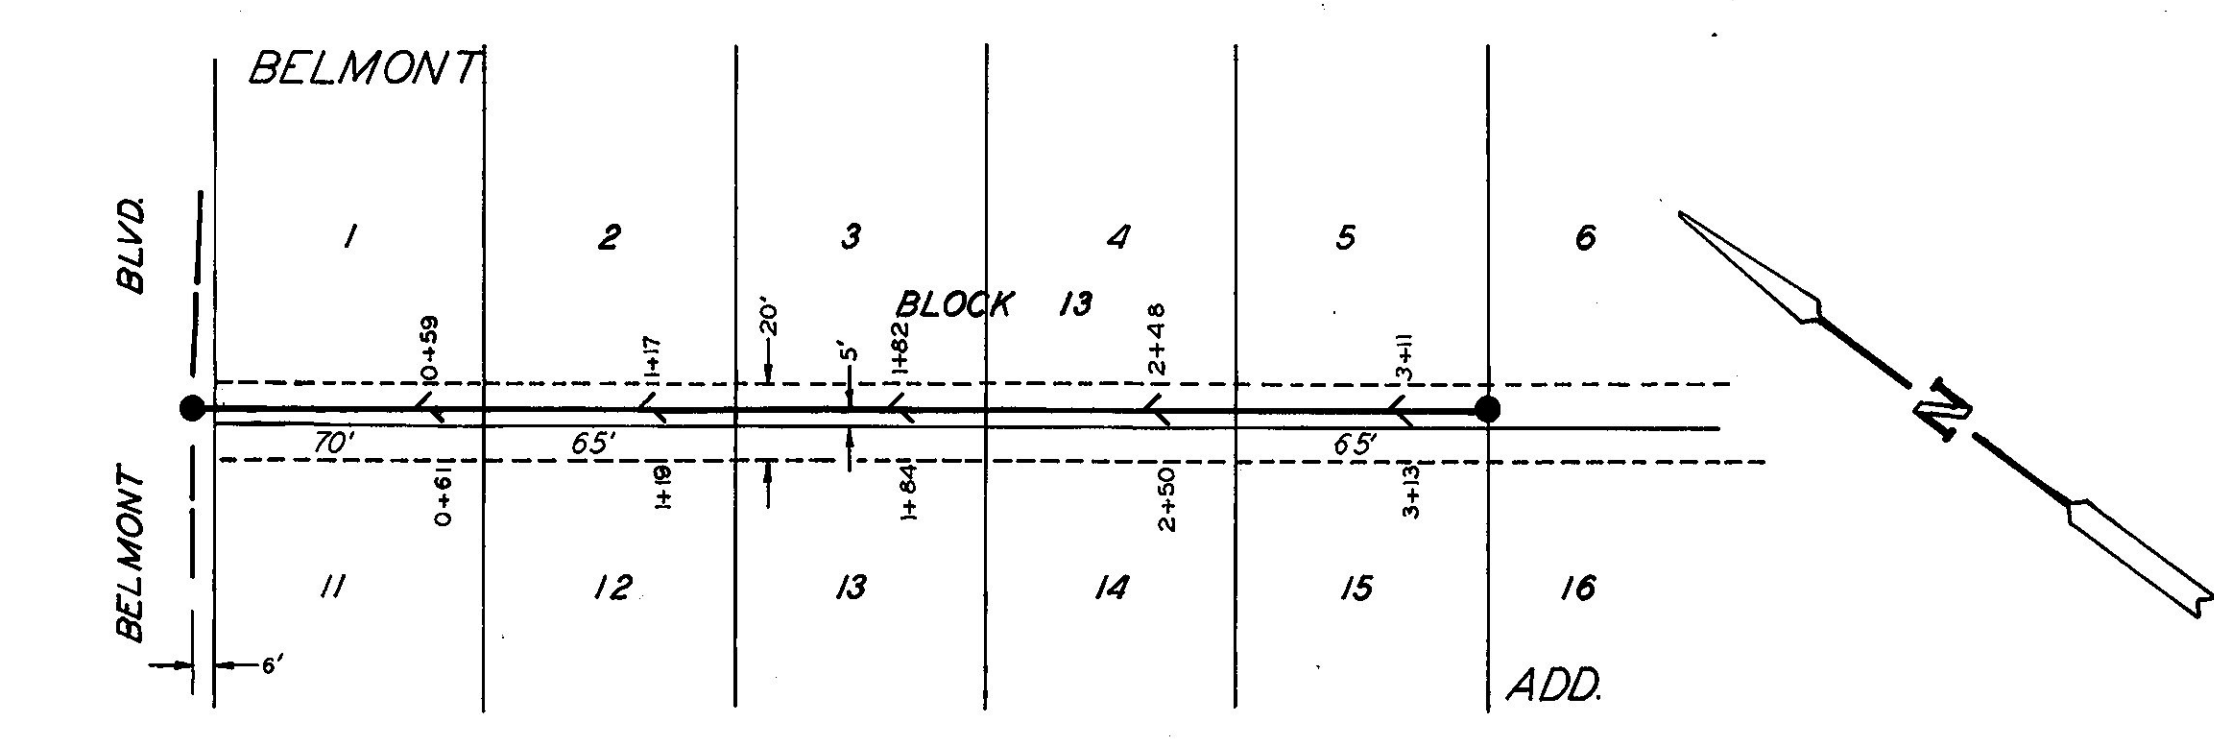

RW EAST OF EDWARD—BELMONT SOUTH

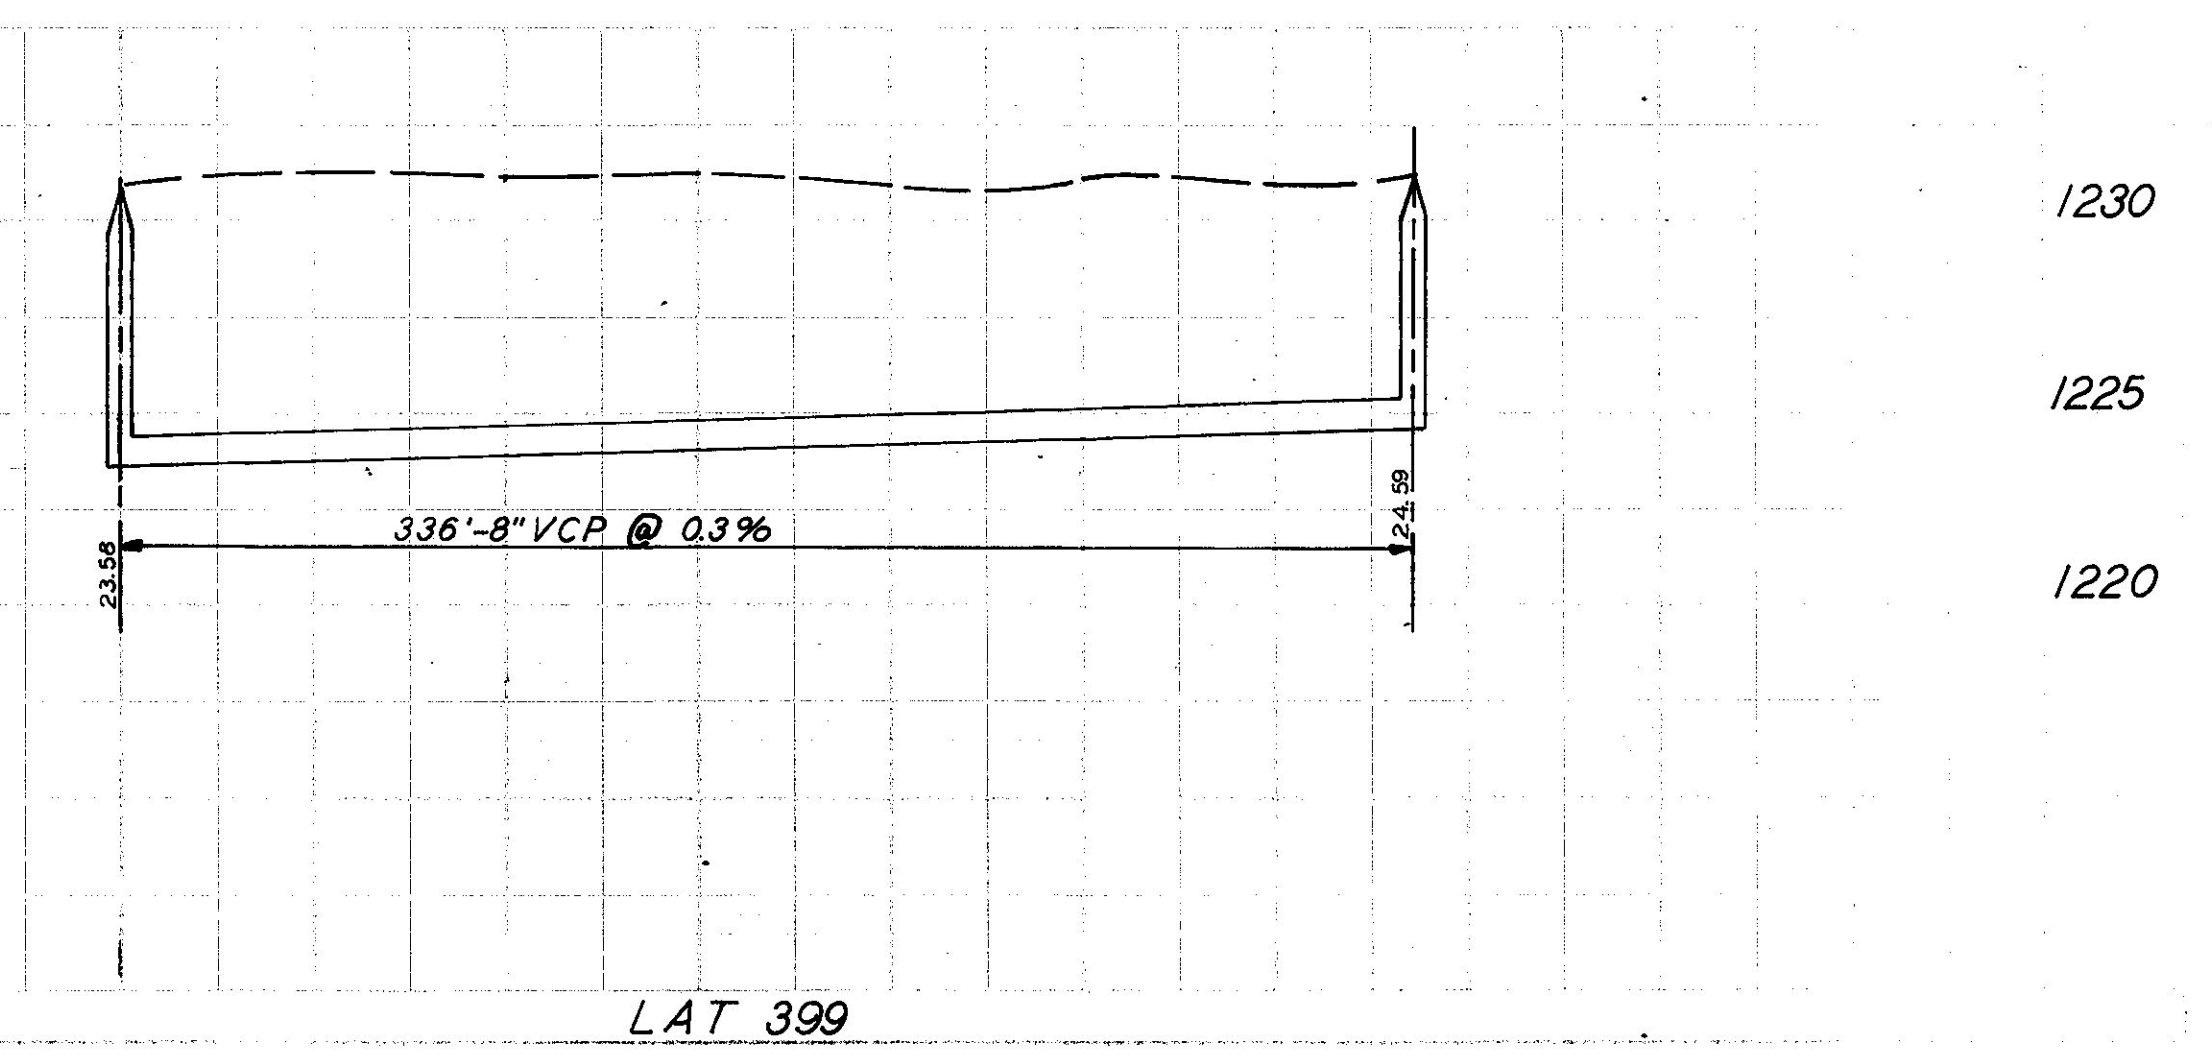

LAT. 399