

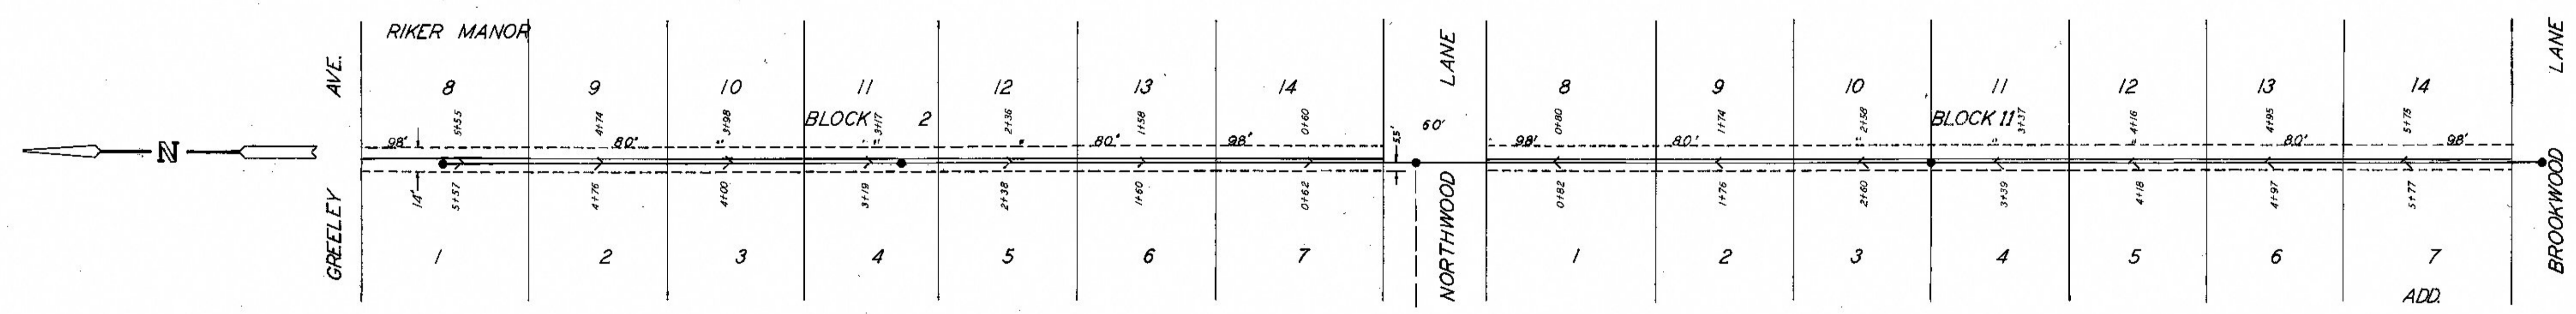


RAW E. OF MARYMOUNT - GREELEY TO BROOKWOOD

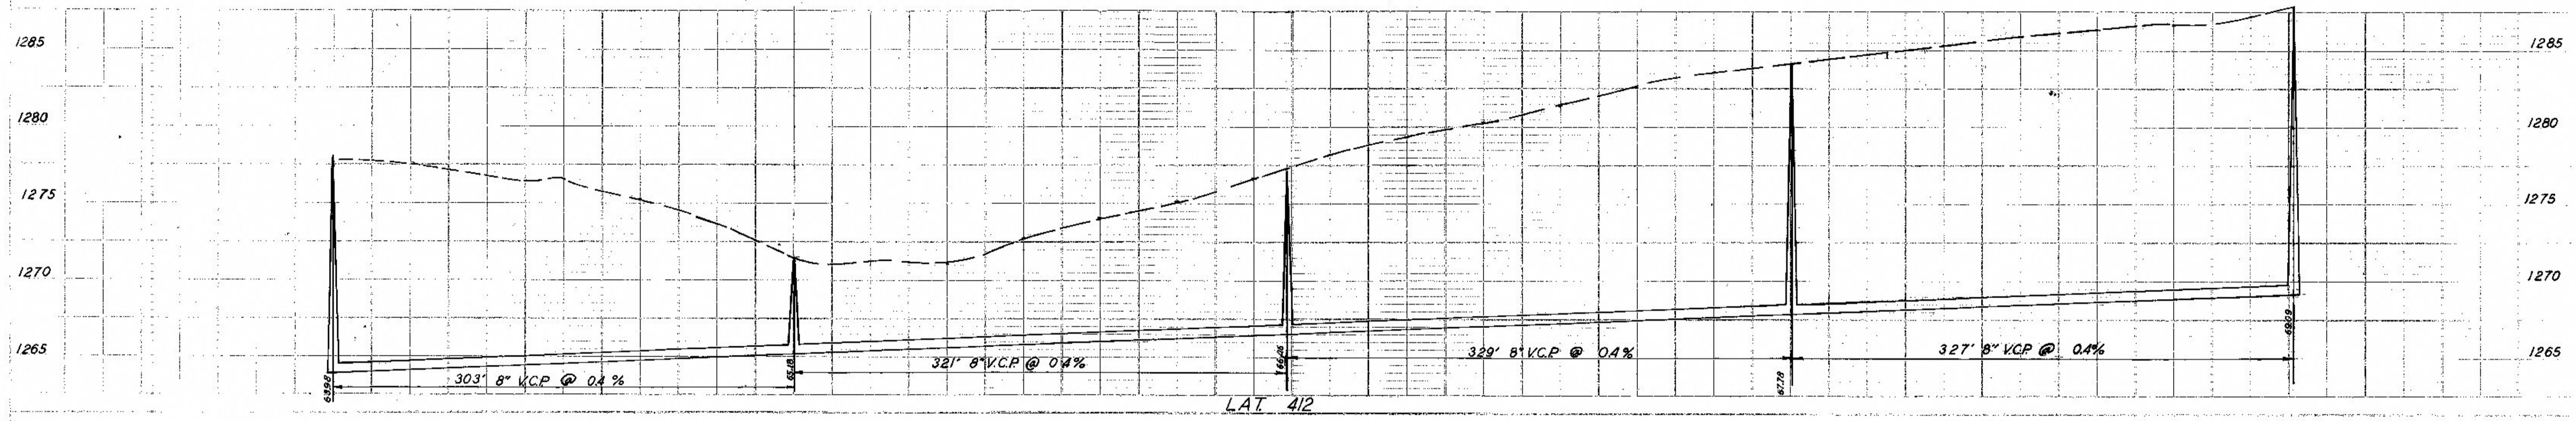

RAW E. AULLWOOD - GREELEY TO BROOKWOOD

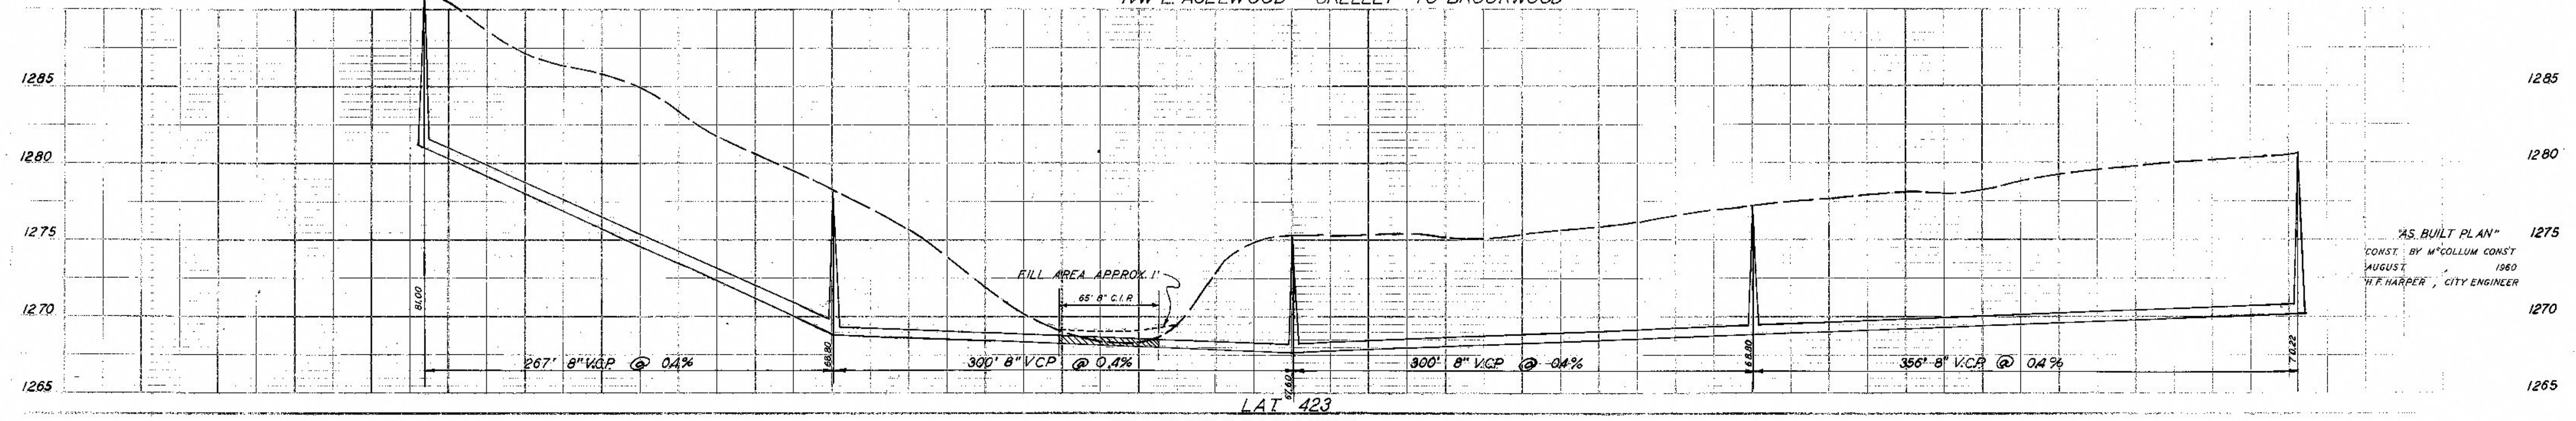

"AS BUILT PLAN"
 CONST. BY M^CCOLLUM CONST
 AUGUST 1980
 H. F. HARPER, CITY ENGINEER