

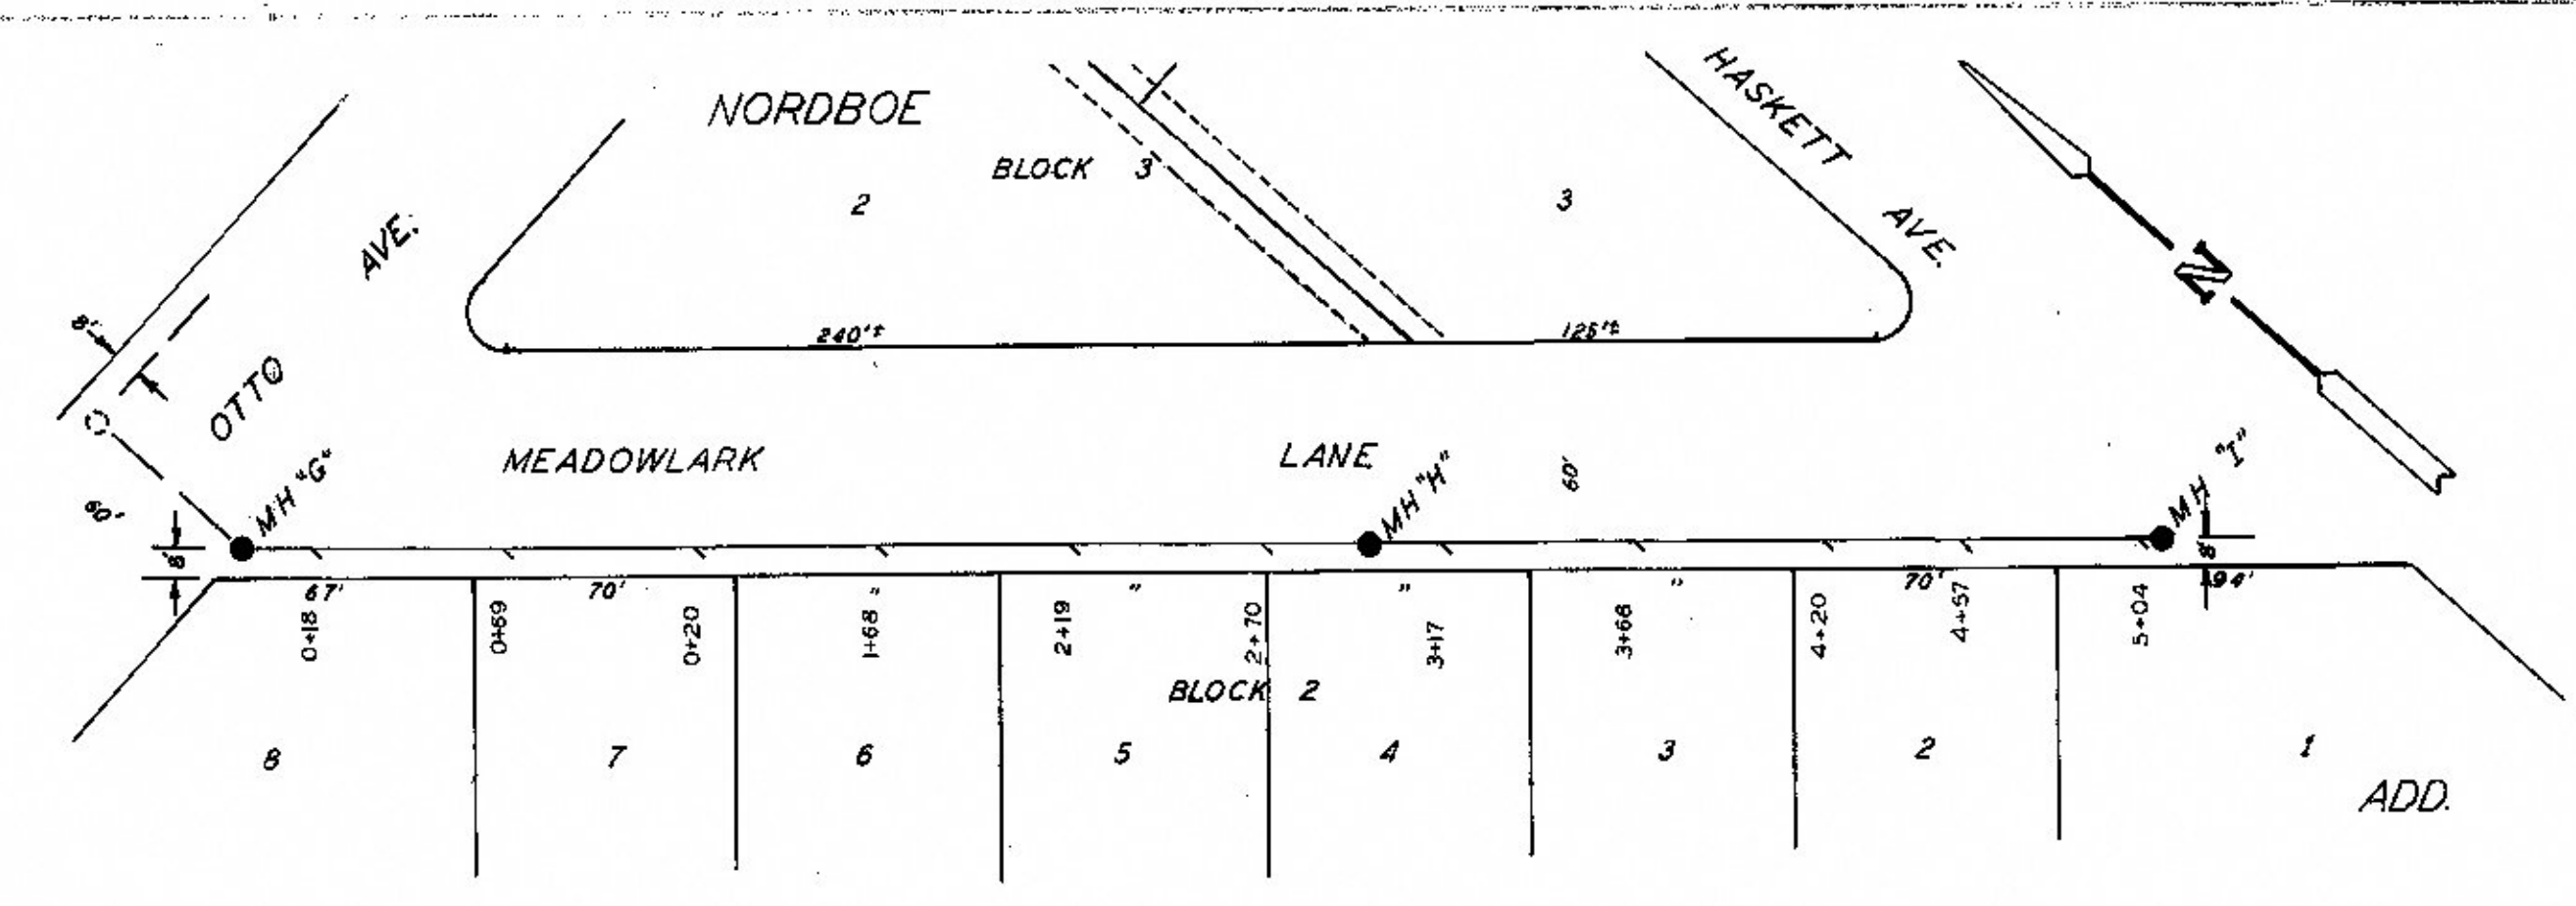



SANITARY SEWER SERVING BLOCK FIVE CIRCLE ADDITION

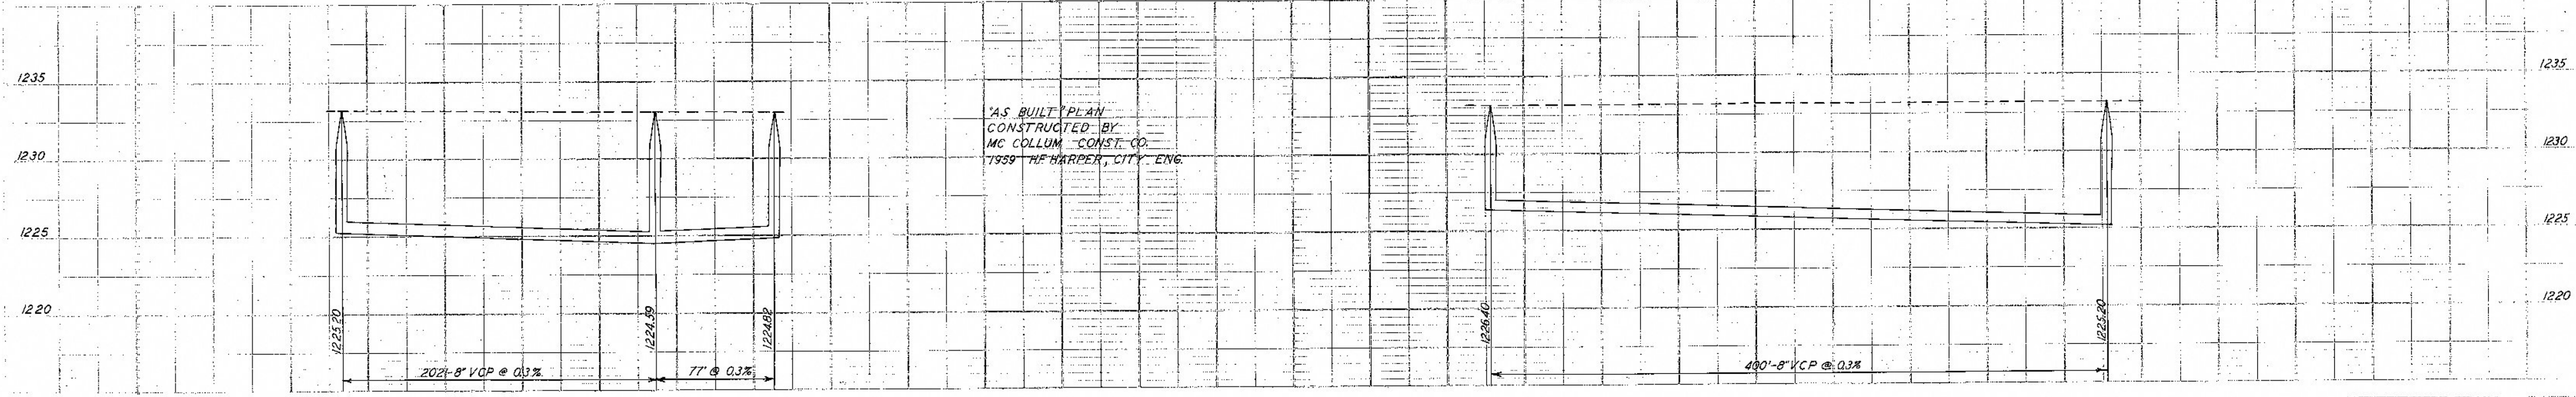

SANITARY SEWER SERVING BLOCK TWO NORDBOE ADD.

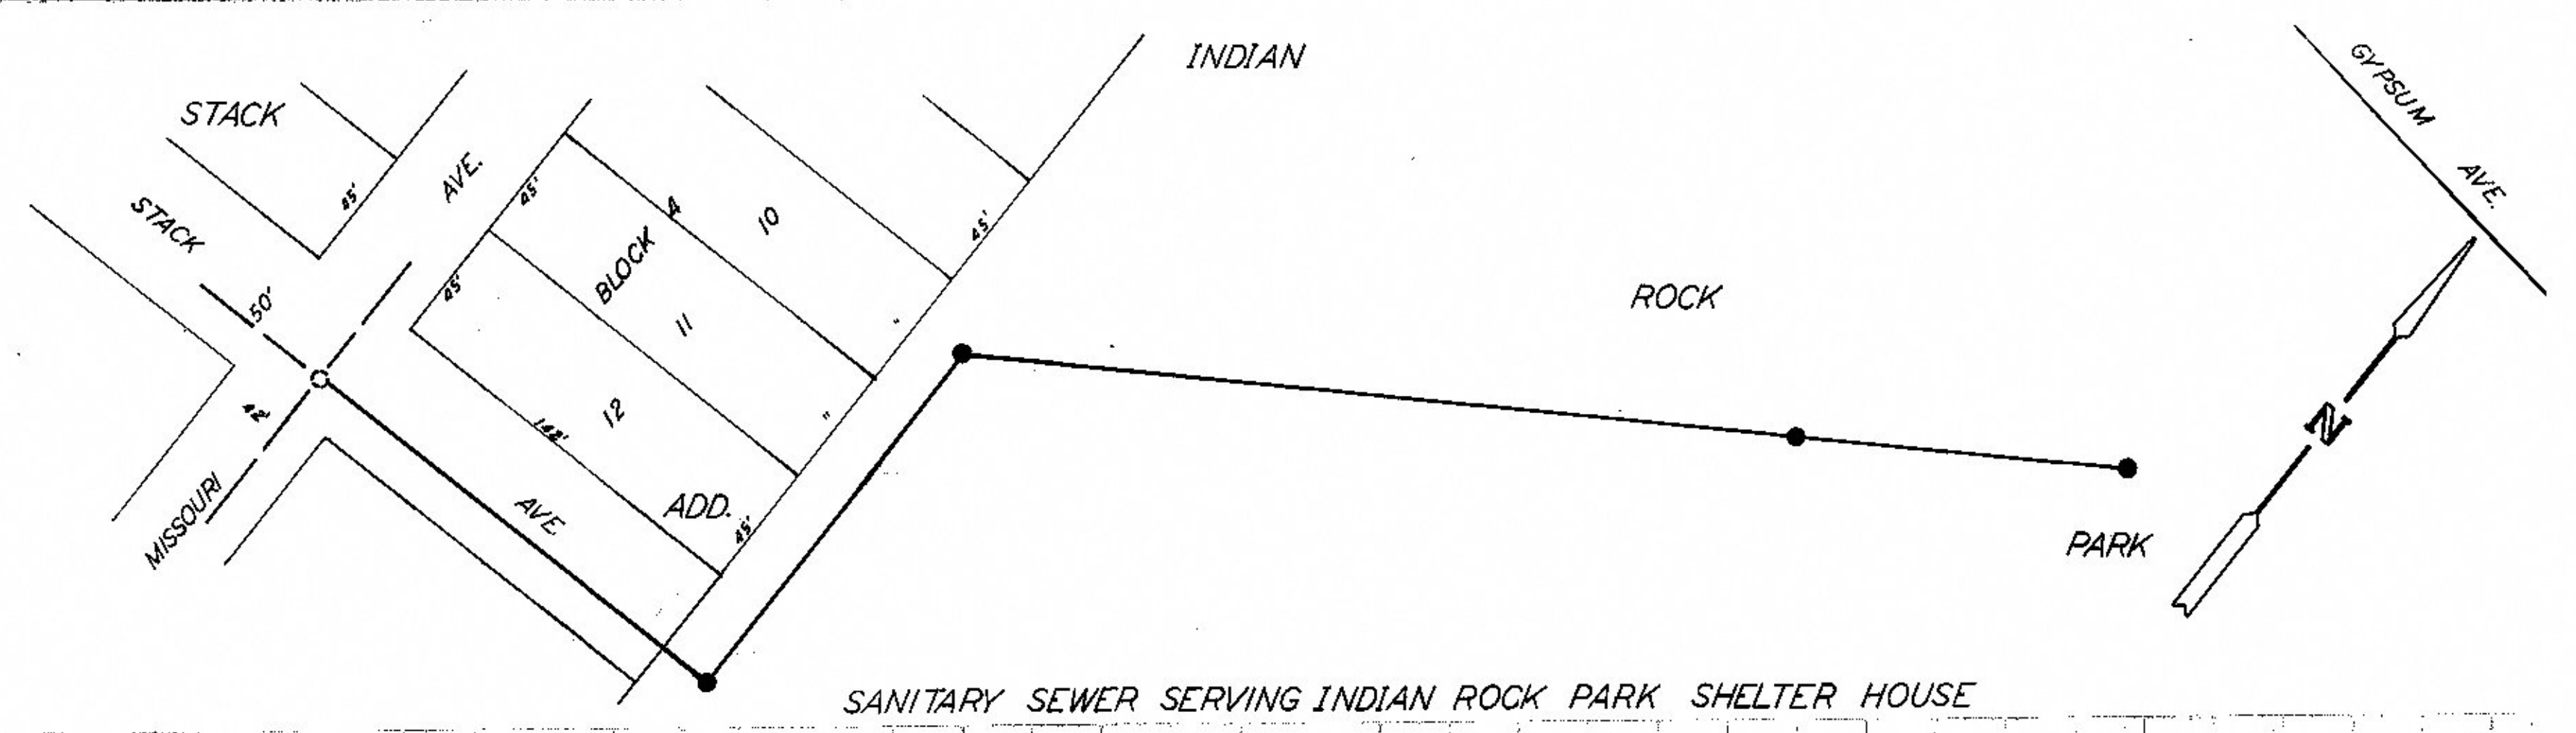

SANITARY SEWER SERVING INDIAN ROCK PARK SHELTER HOUSE

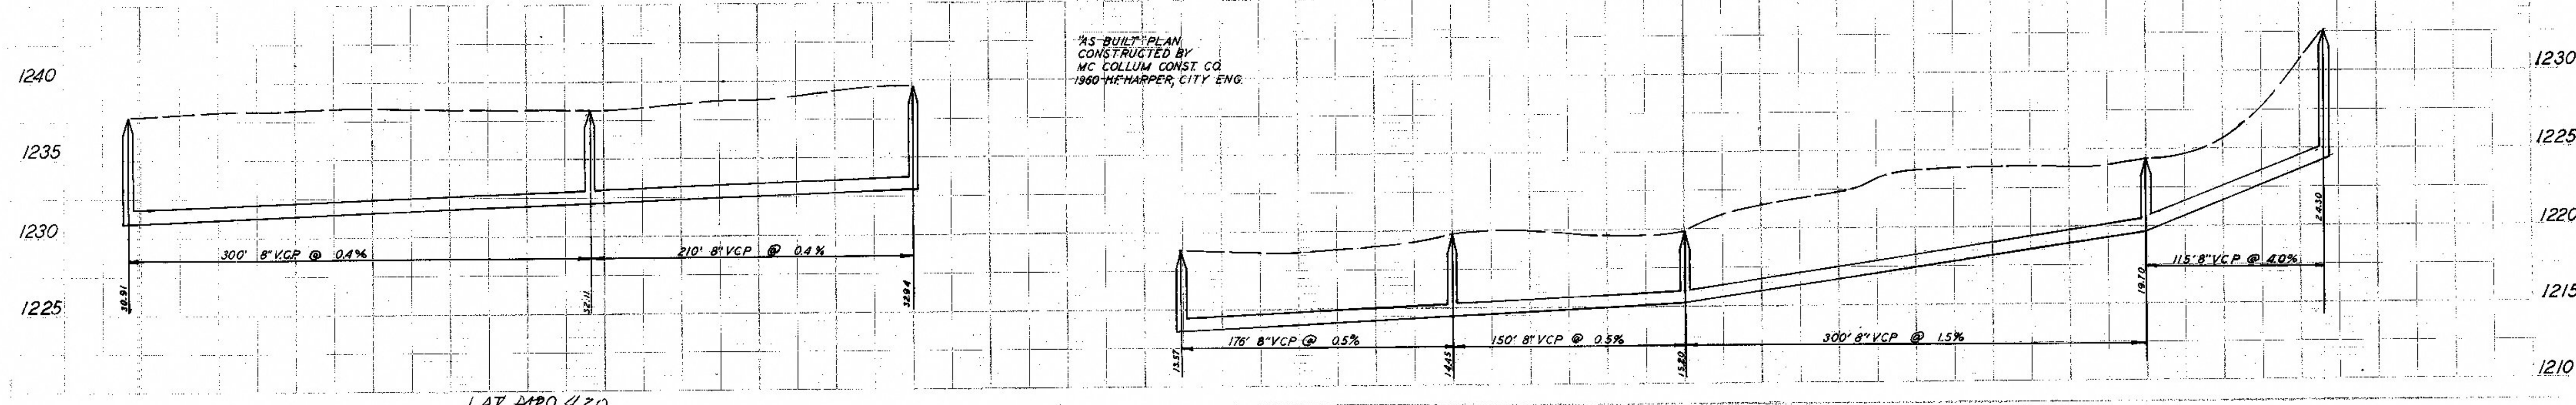

L.A.Z. MPO 420