




LAT 419

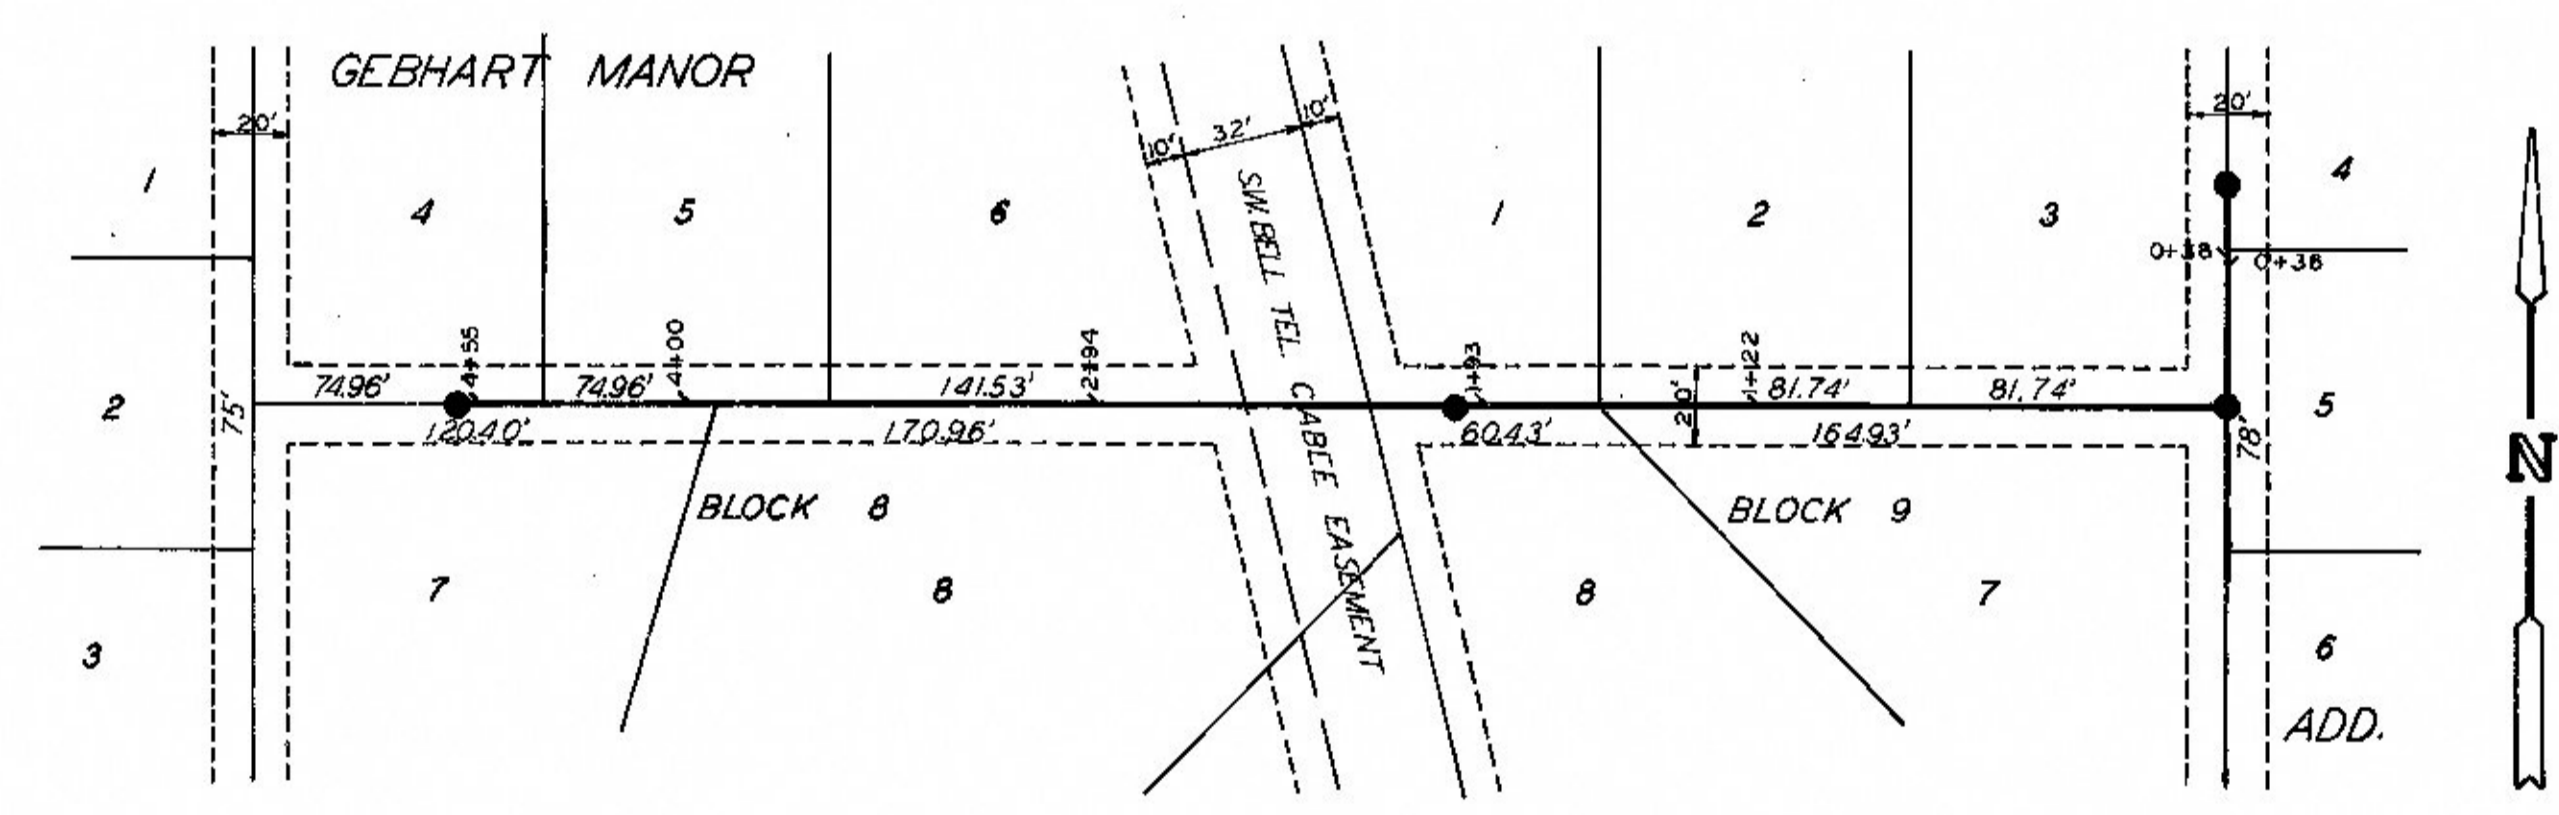



R/W S. OF ALBERT-LELAND TO QUINCY

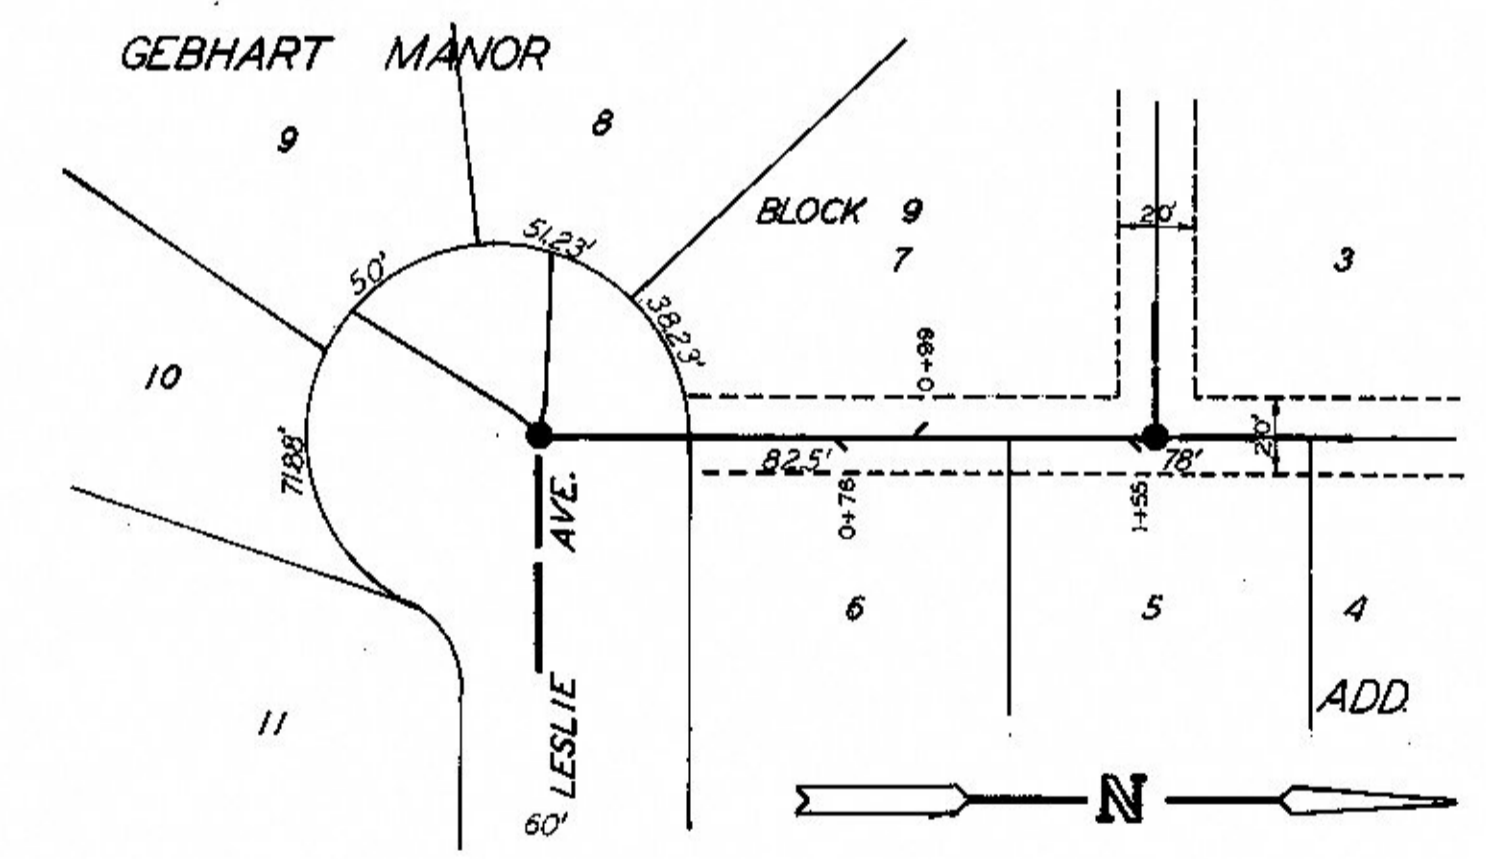

R/W W. OF QUINCY-LESLIE N. 161'

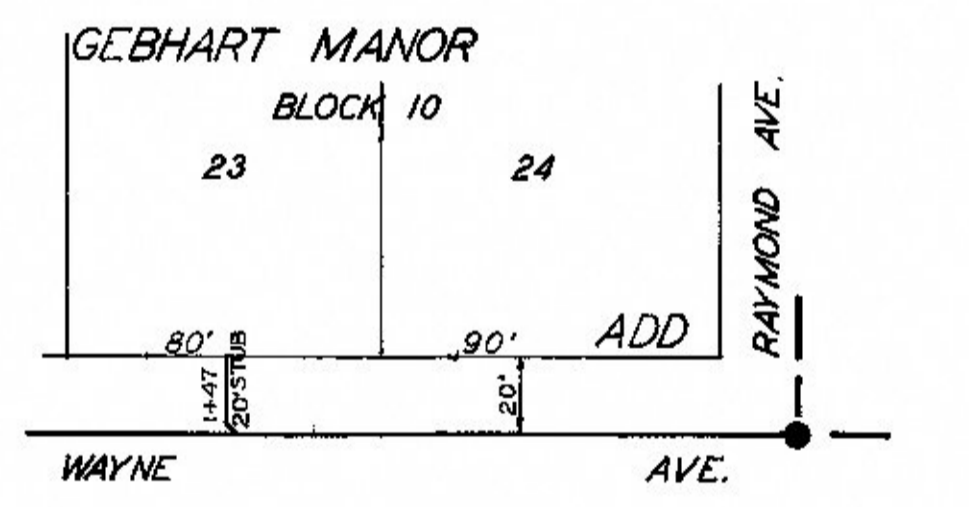

UNPLATED LAND
WYE & STUB FOR LOT 23 BLOCK 10 GEBHART MANOR ADD.

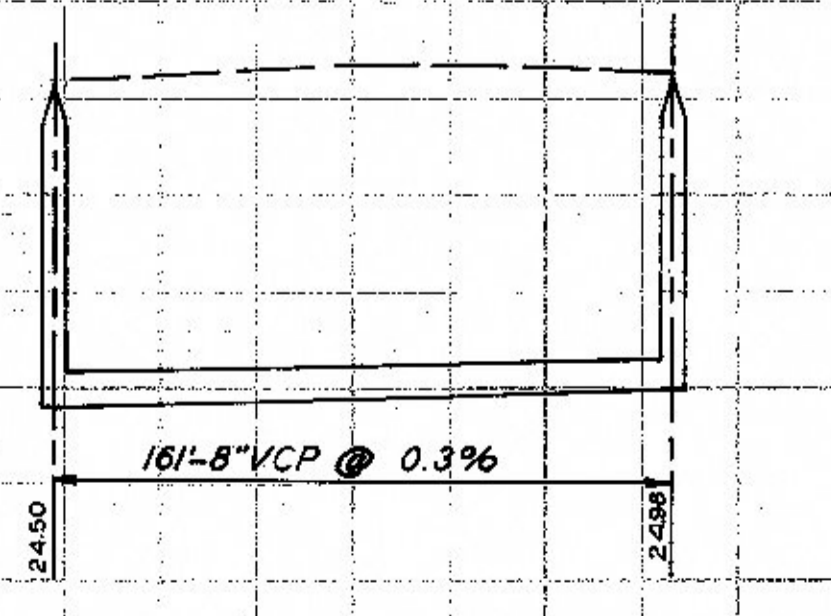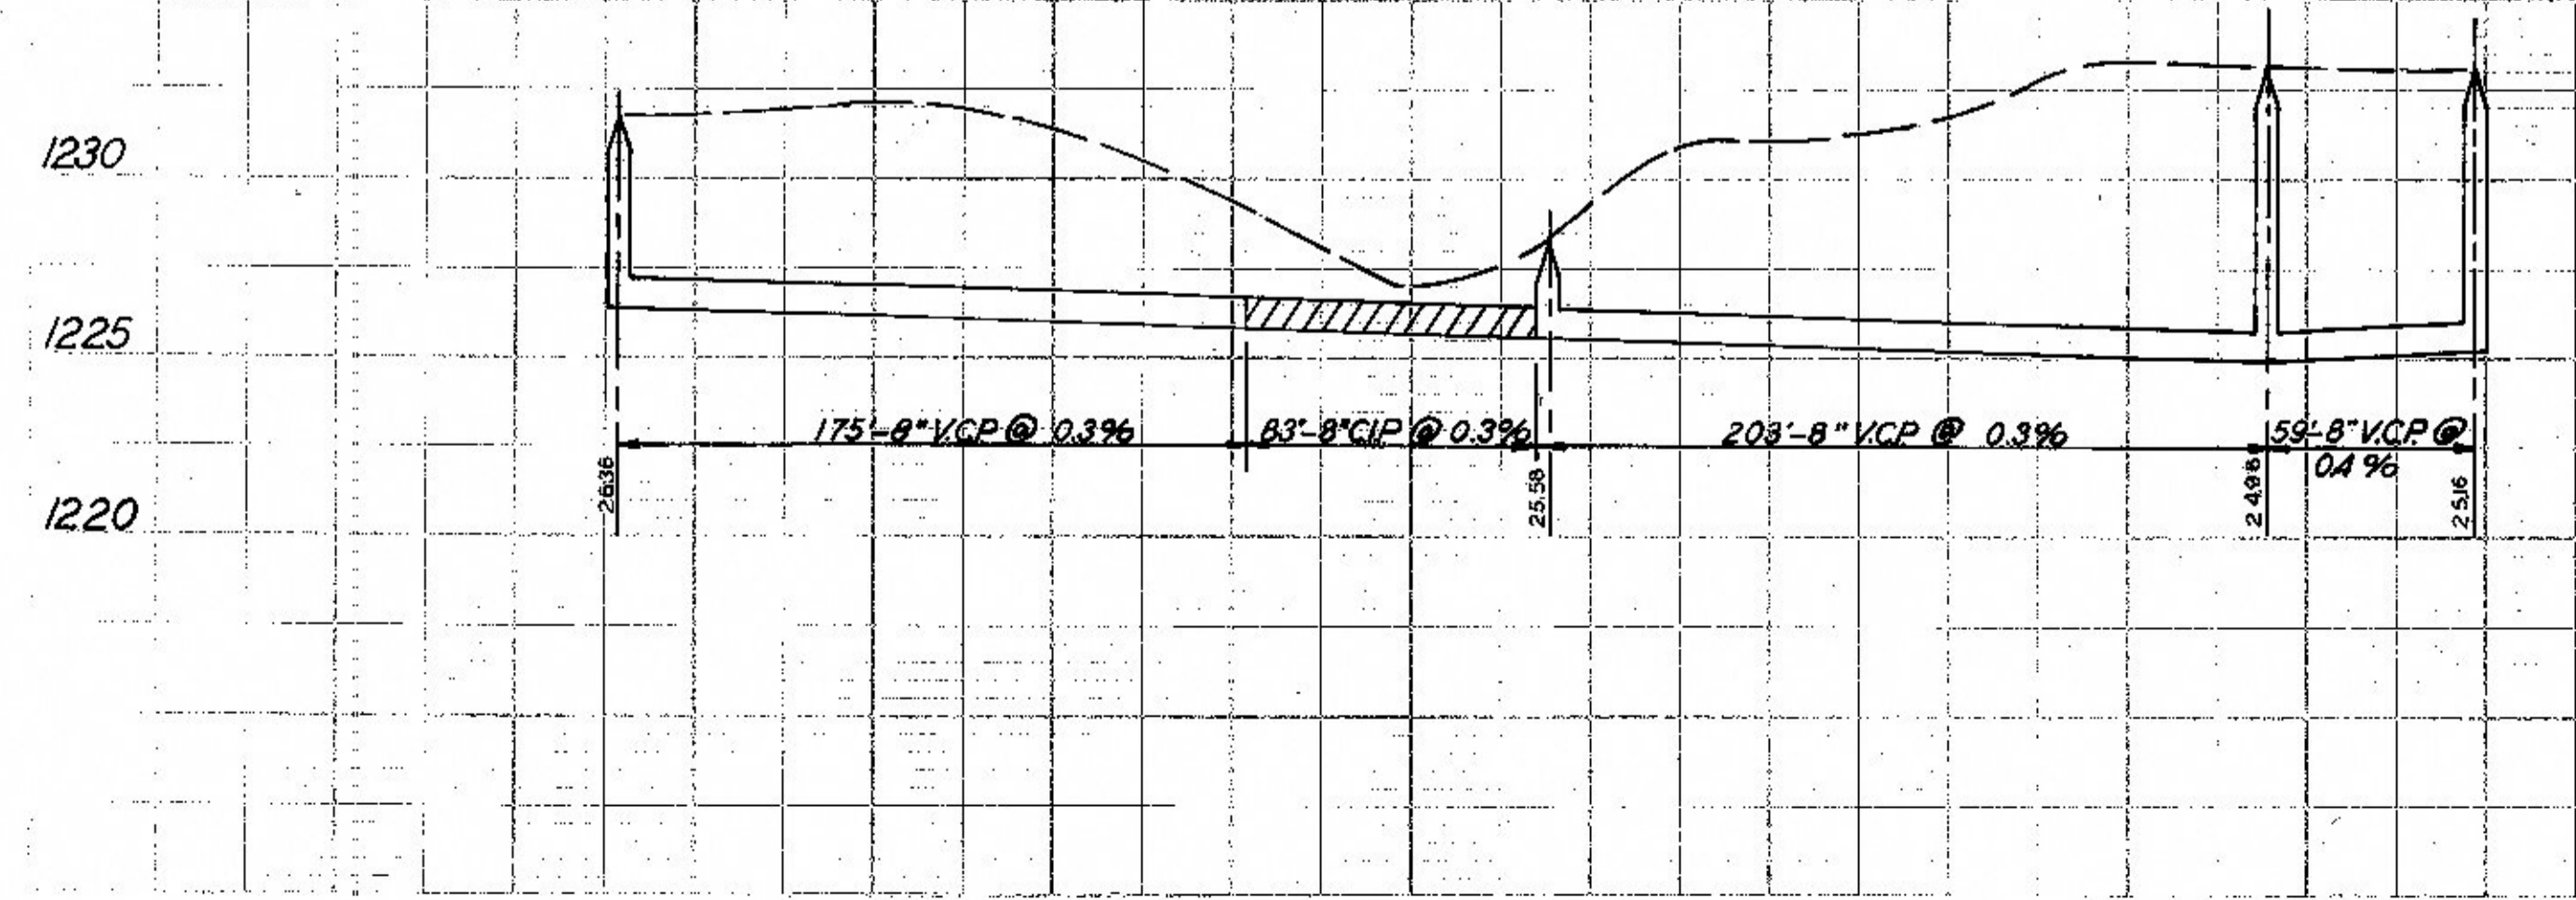

AS BUILT PLAN CONSTRUCTED BY MC COLLUM CONST. CO. AUG. 1960 H. HARPER CITY ENG.

LAT 419