




SAN SEWER - JARAN - WILBRE TO ROCKVIEW

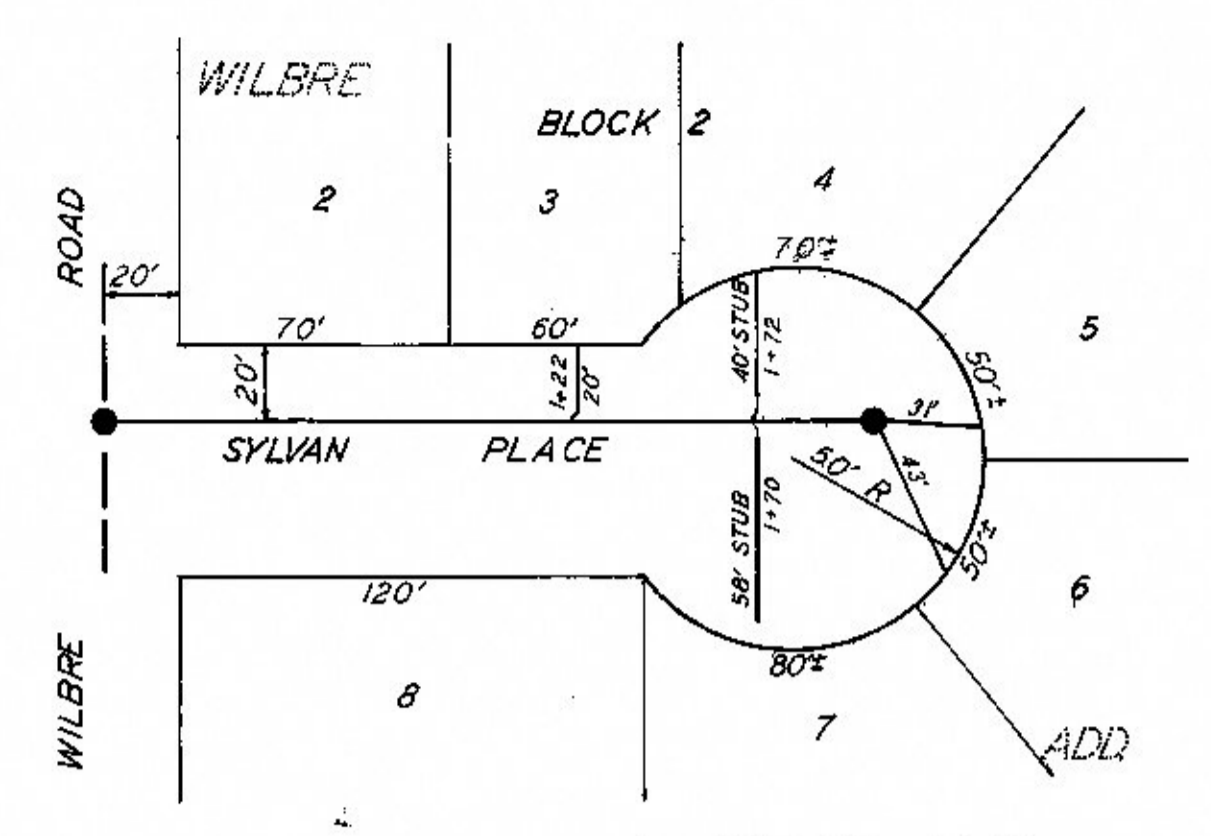

SAN SEWER - SYLVAN - WILBRE NO. 200'

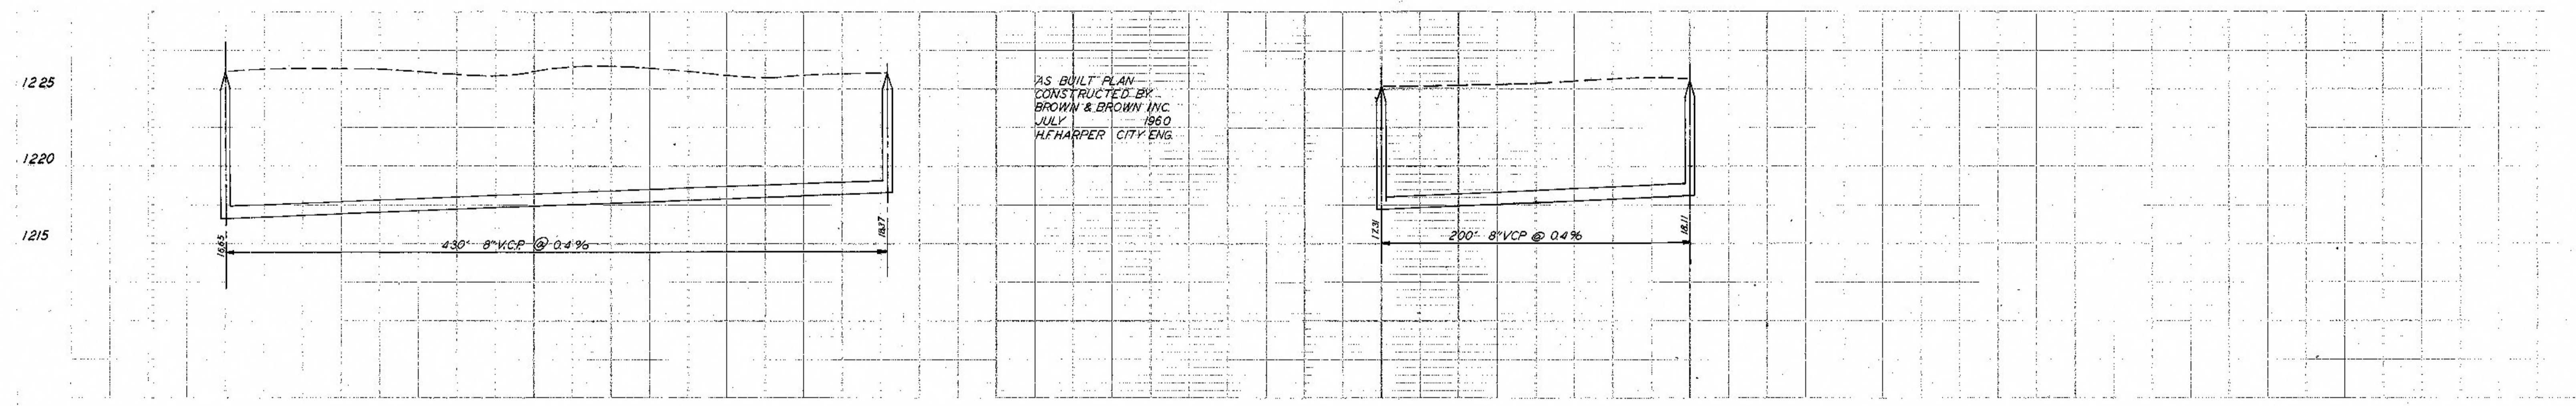

AS BUILT PLAN
CONSTRUCTED BY
BROWN & BROWN INC.
JULY 1960
H.F. HARPER CITY ENG.

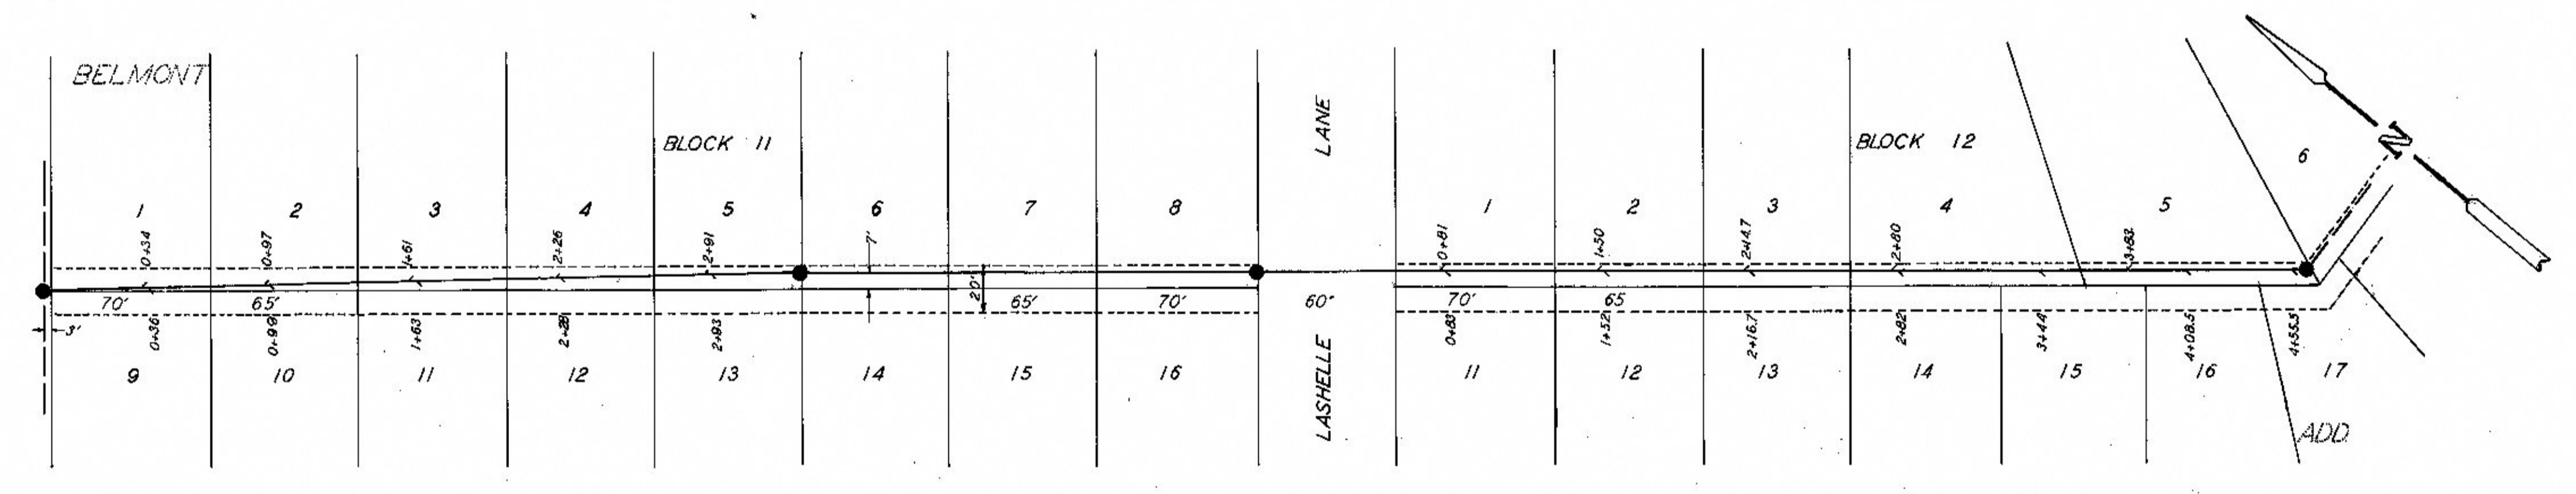

SAN SEWER RAW E. OF ROACH BELMONT TO OHIO

