





STUB EAST -RW NORTH OF WESTCHESTER

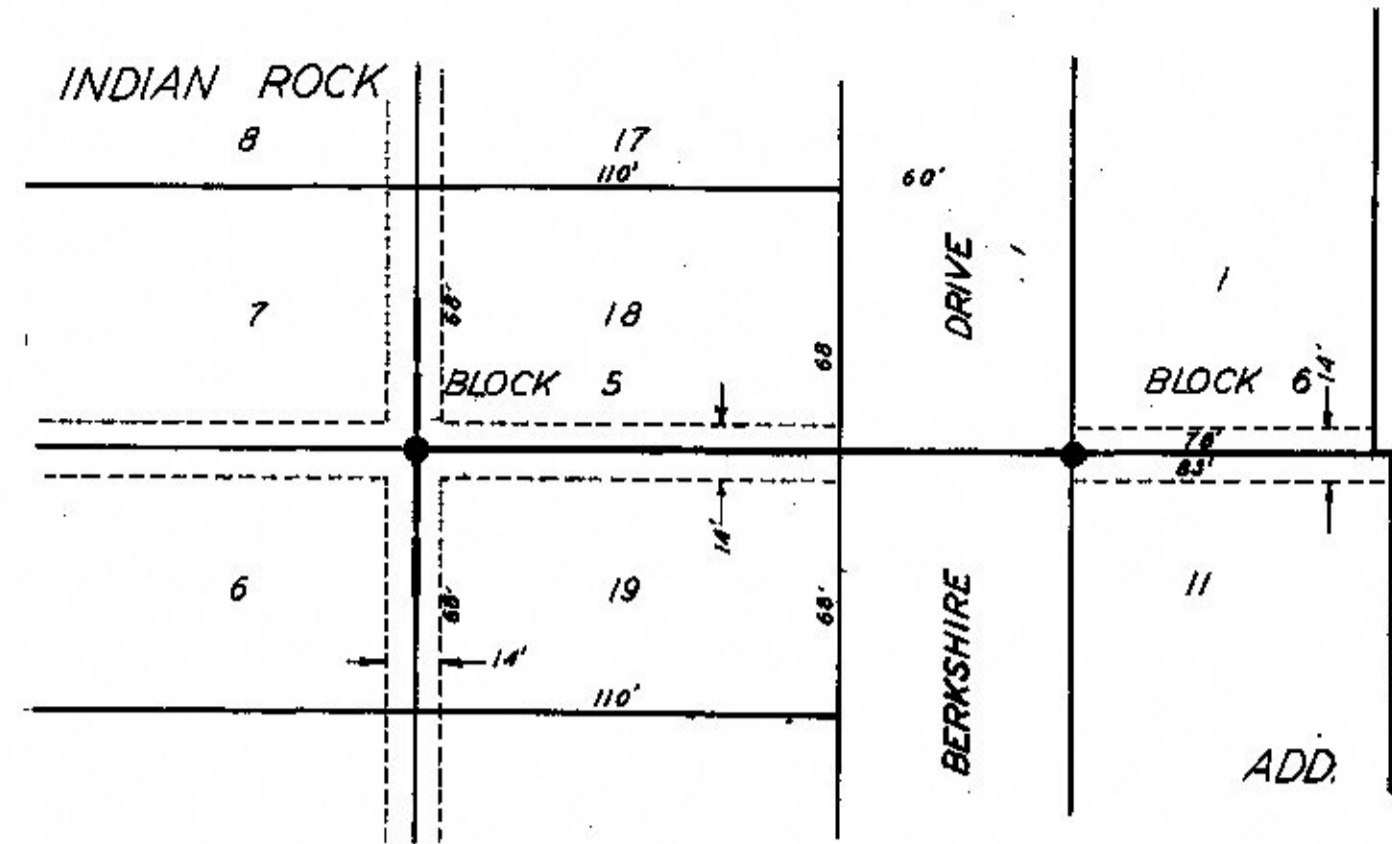

STUB EAST -RW NORTH OF STRATFORD

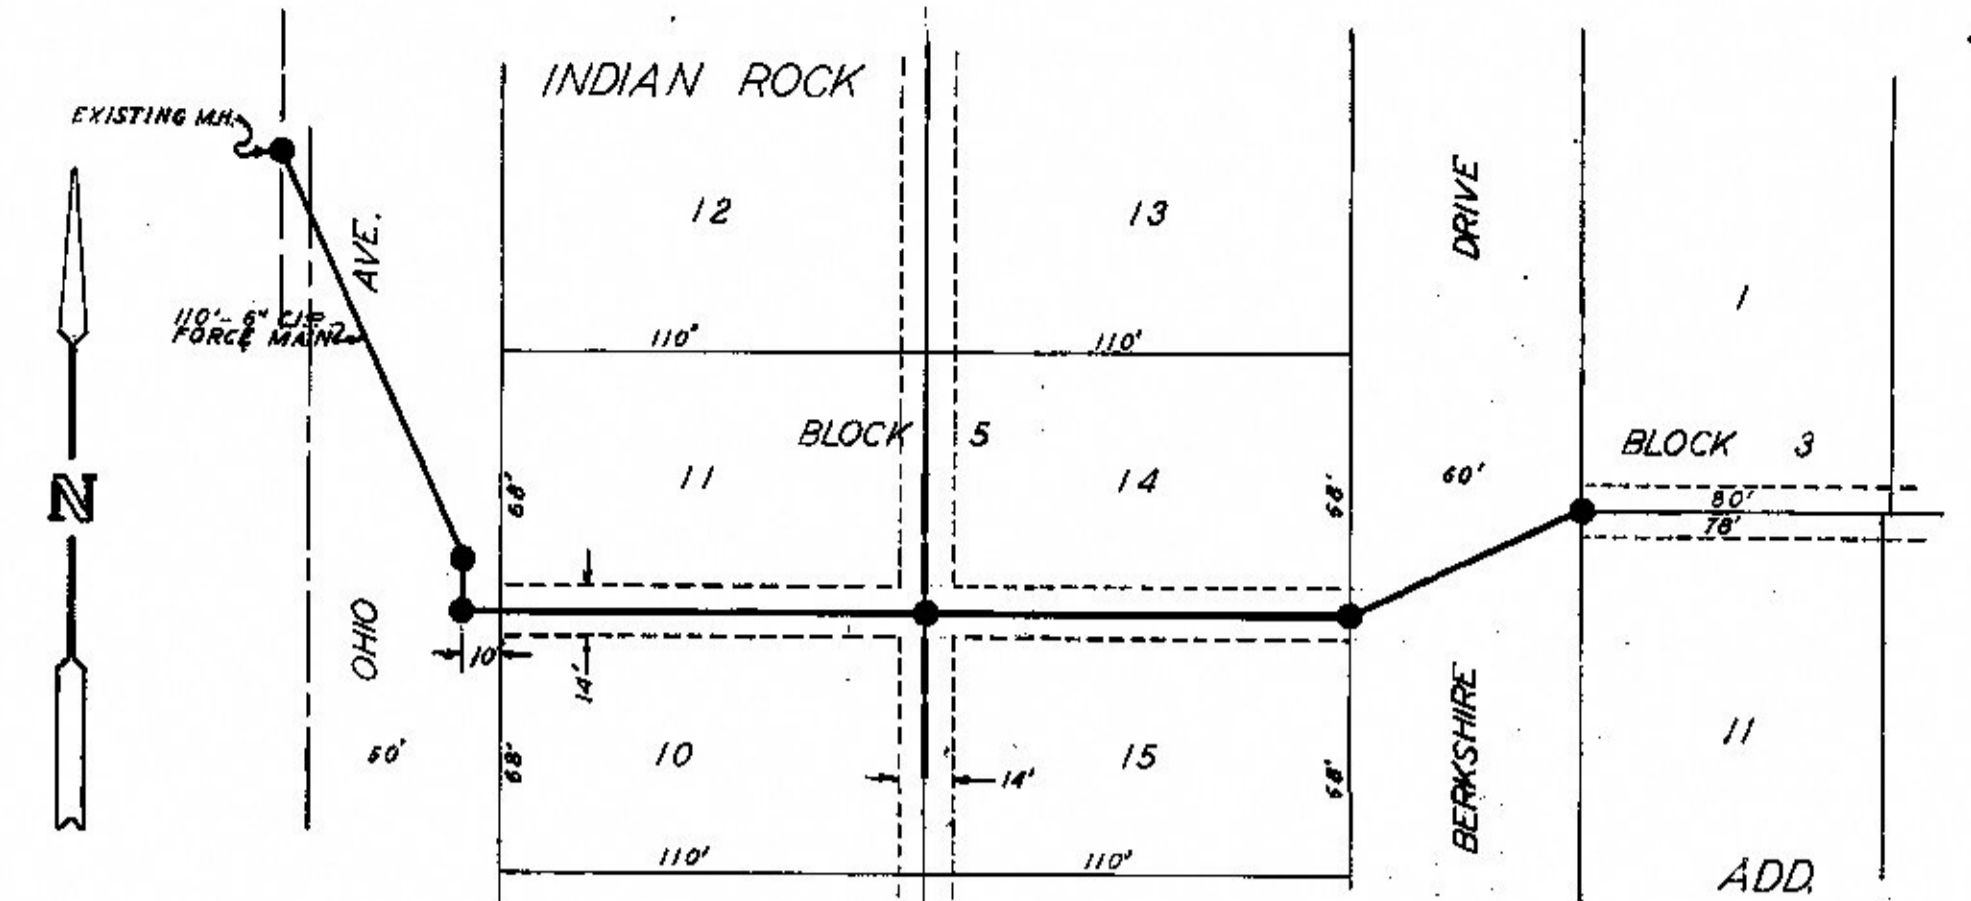

FORCE MAIN, LAT 421 & STUB EAST -RW NORTH OF ARLINGTON

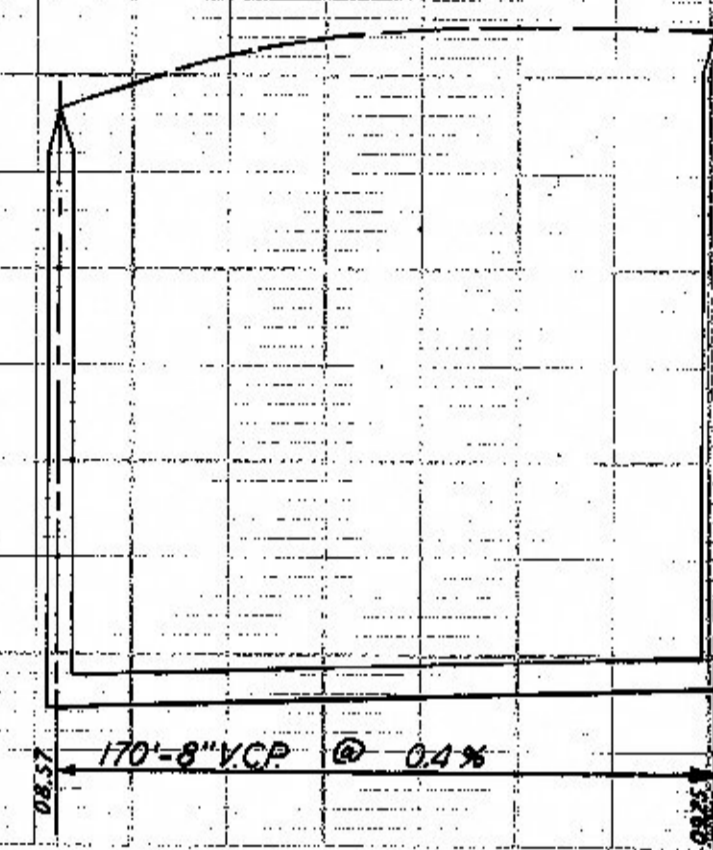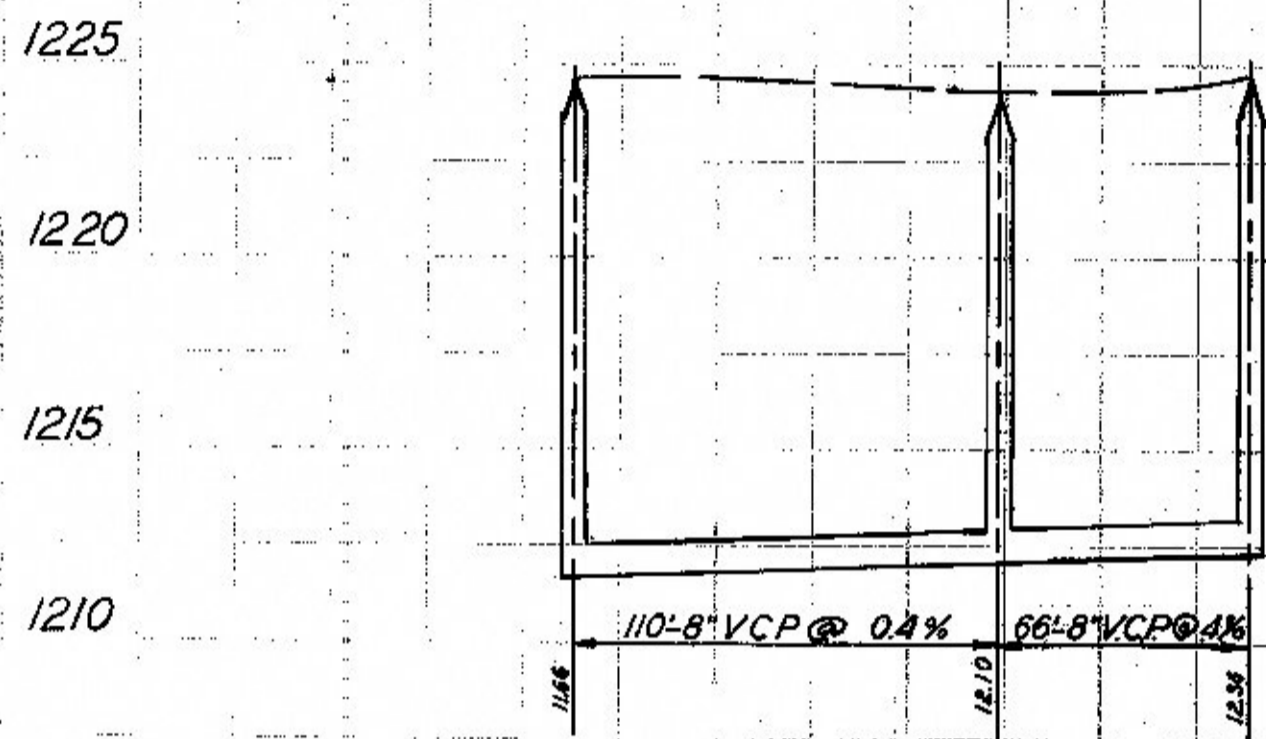

"AS BUILT PLAN"
 Cover by M'Callum Const
 Sept 1980
 H.F. Harper City Engineer
 Scale 1"=5'
 Vert. 1"=10'

