



SANITARY SEWER - BEVERLY - CRAWFORD TO SHADY BEND

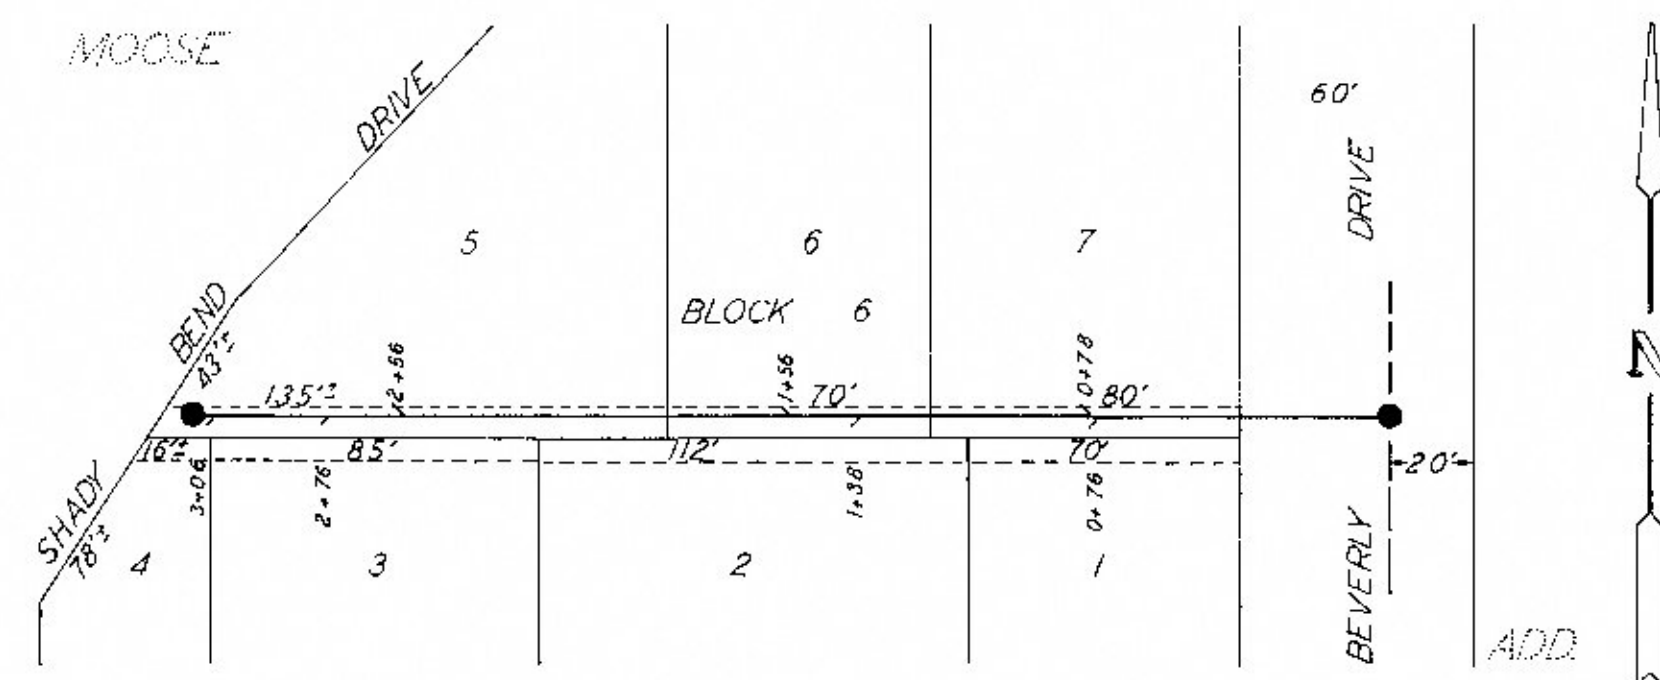

SANITARY SEWER - RW N. OF CRAWFORD - BEVERLY TO SHADY BEND

DATE: _____ BY: _____
 PLAN: SURVEYED, PLOTTED, ALIGNED, CHECKED, NOTE BOOK, NO. OF PAGES CHECKED

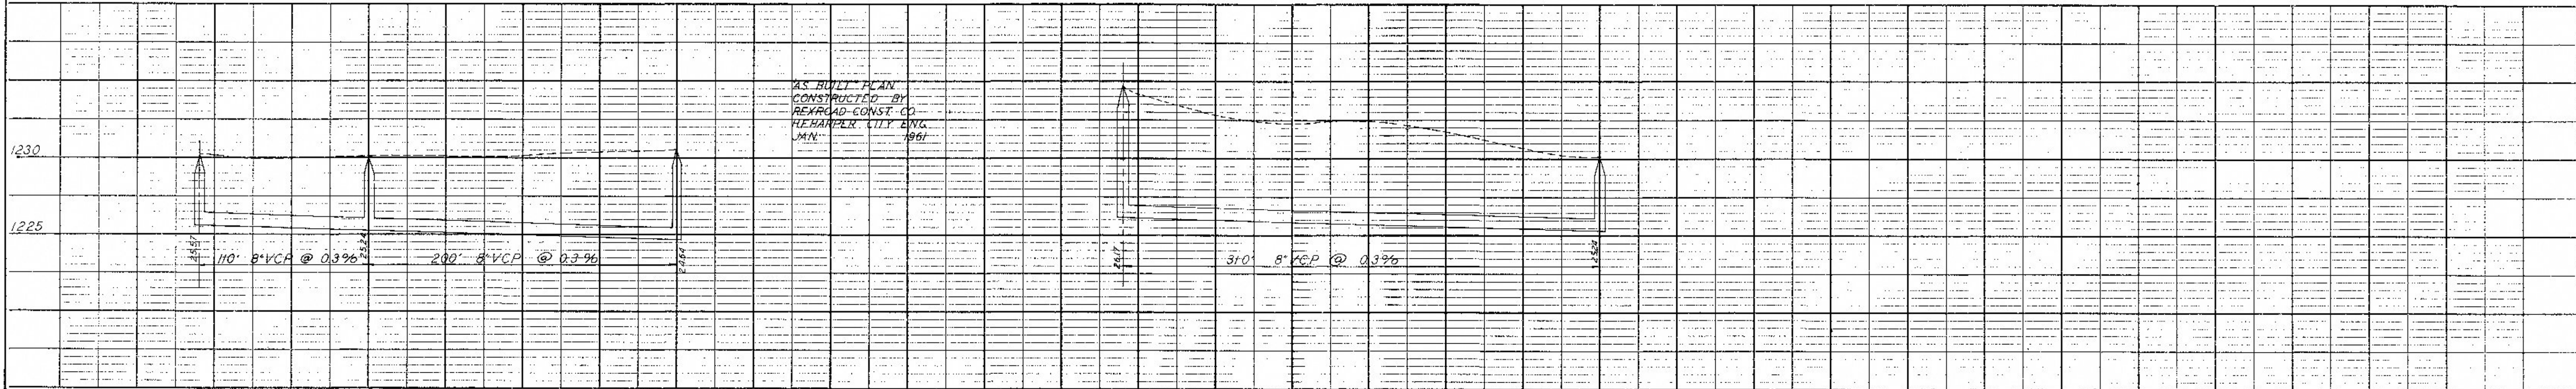

DATE: _____ BY: _____
 PROFILE: SURVEYED, PLOTTED, GRADES CHECKED, NOTE BOOK, NO. OF PAGES CHECKED

