




SANITARY SEWER-ALBERT-OHIO TO MISSION

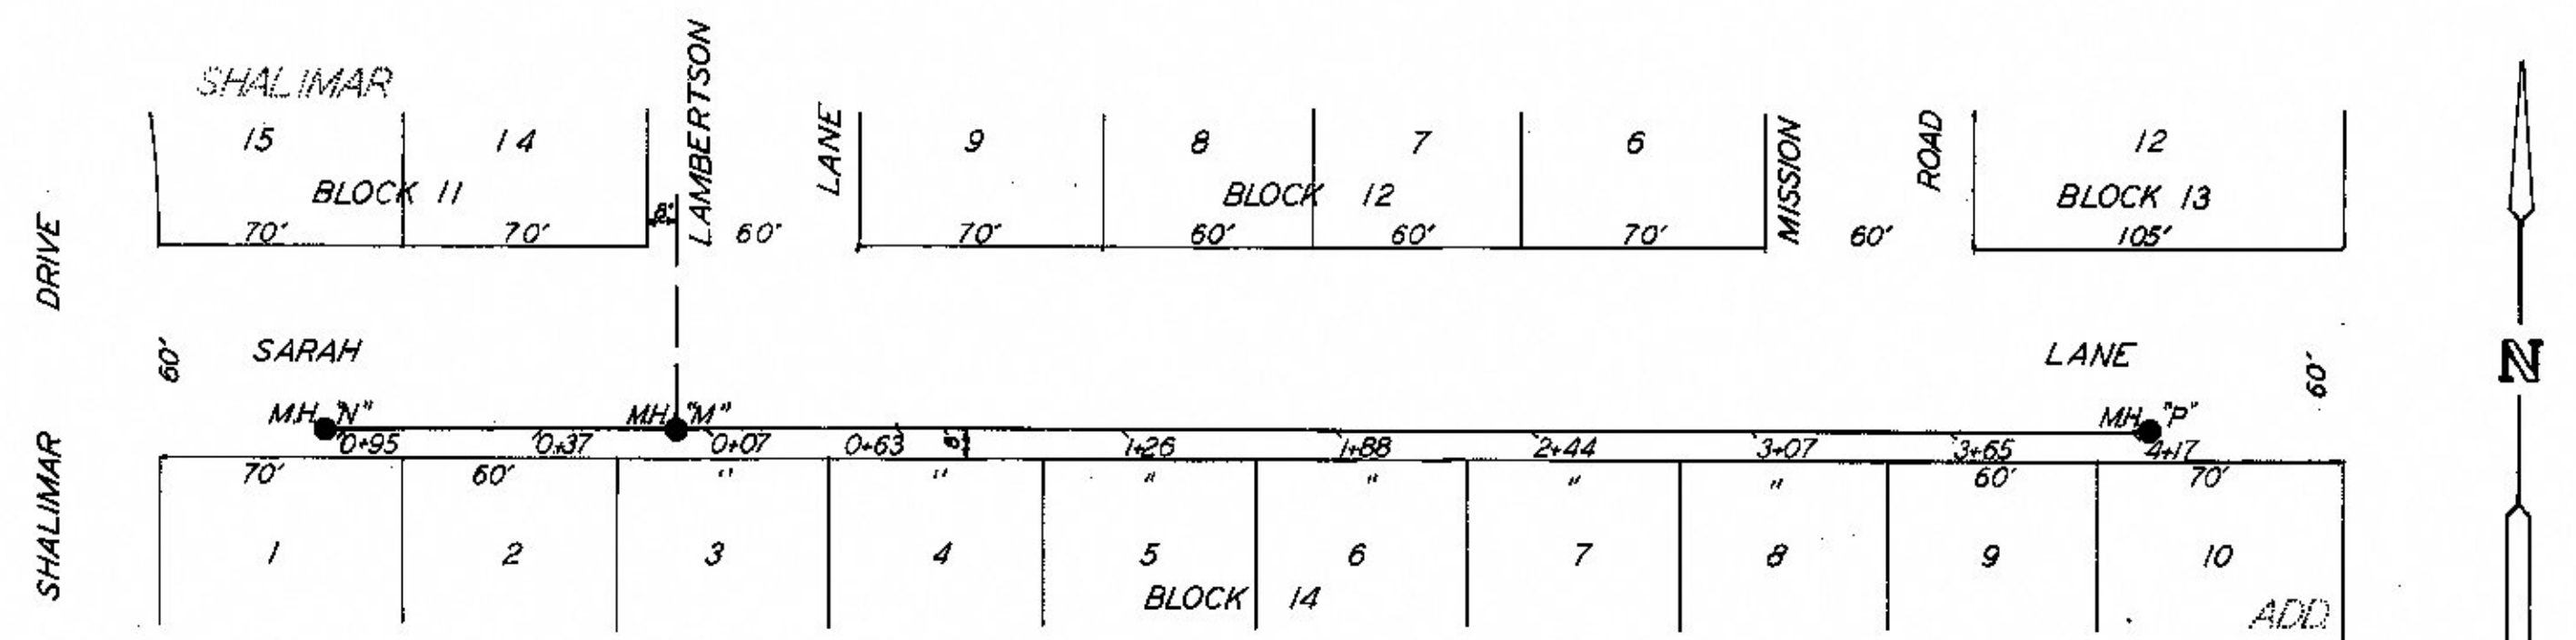


SANITARY SEWER-SARAH-SHALIMAR TO MISSION

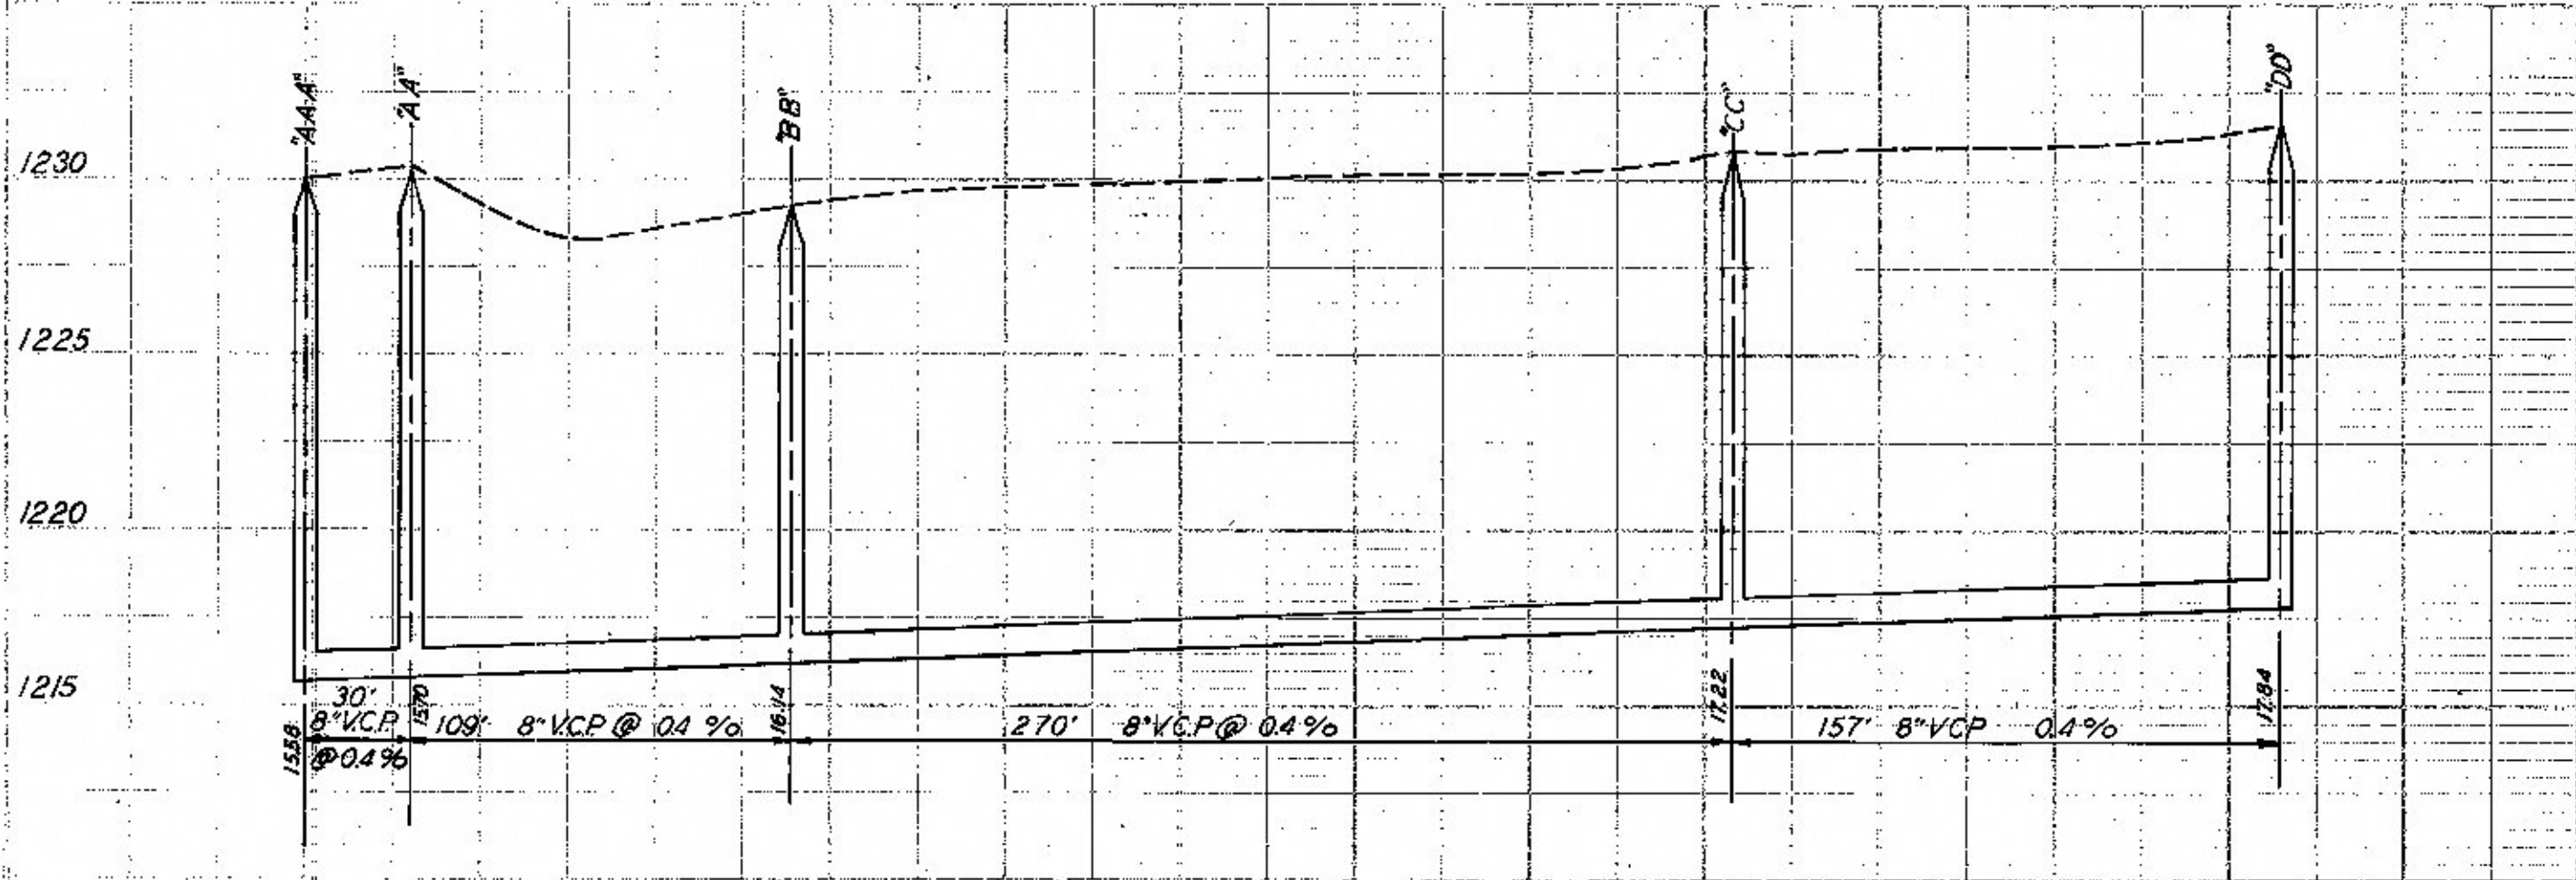


AS BUILT PLAN  
CONSTRUCTED BY  
WILMOUTH CONST. CO.  
NEWARKER CITY ENG.  
DEC. 1960

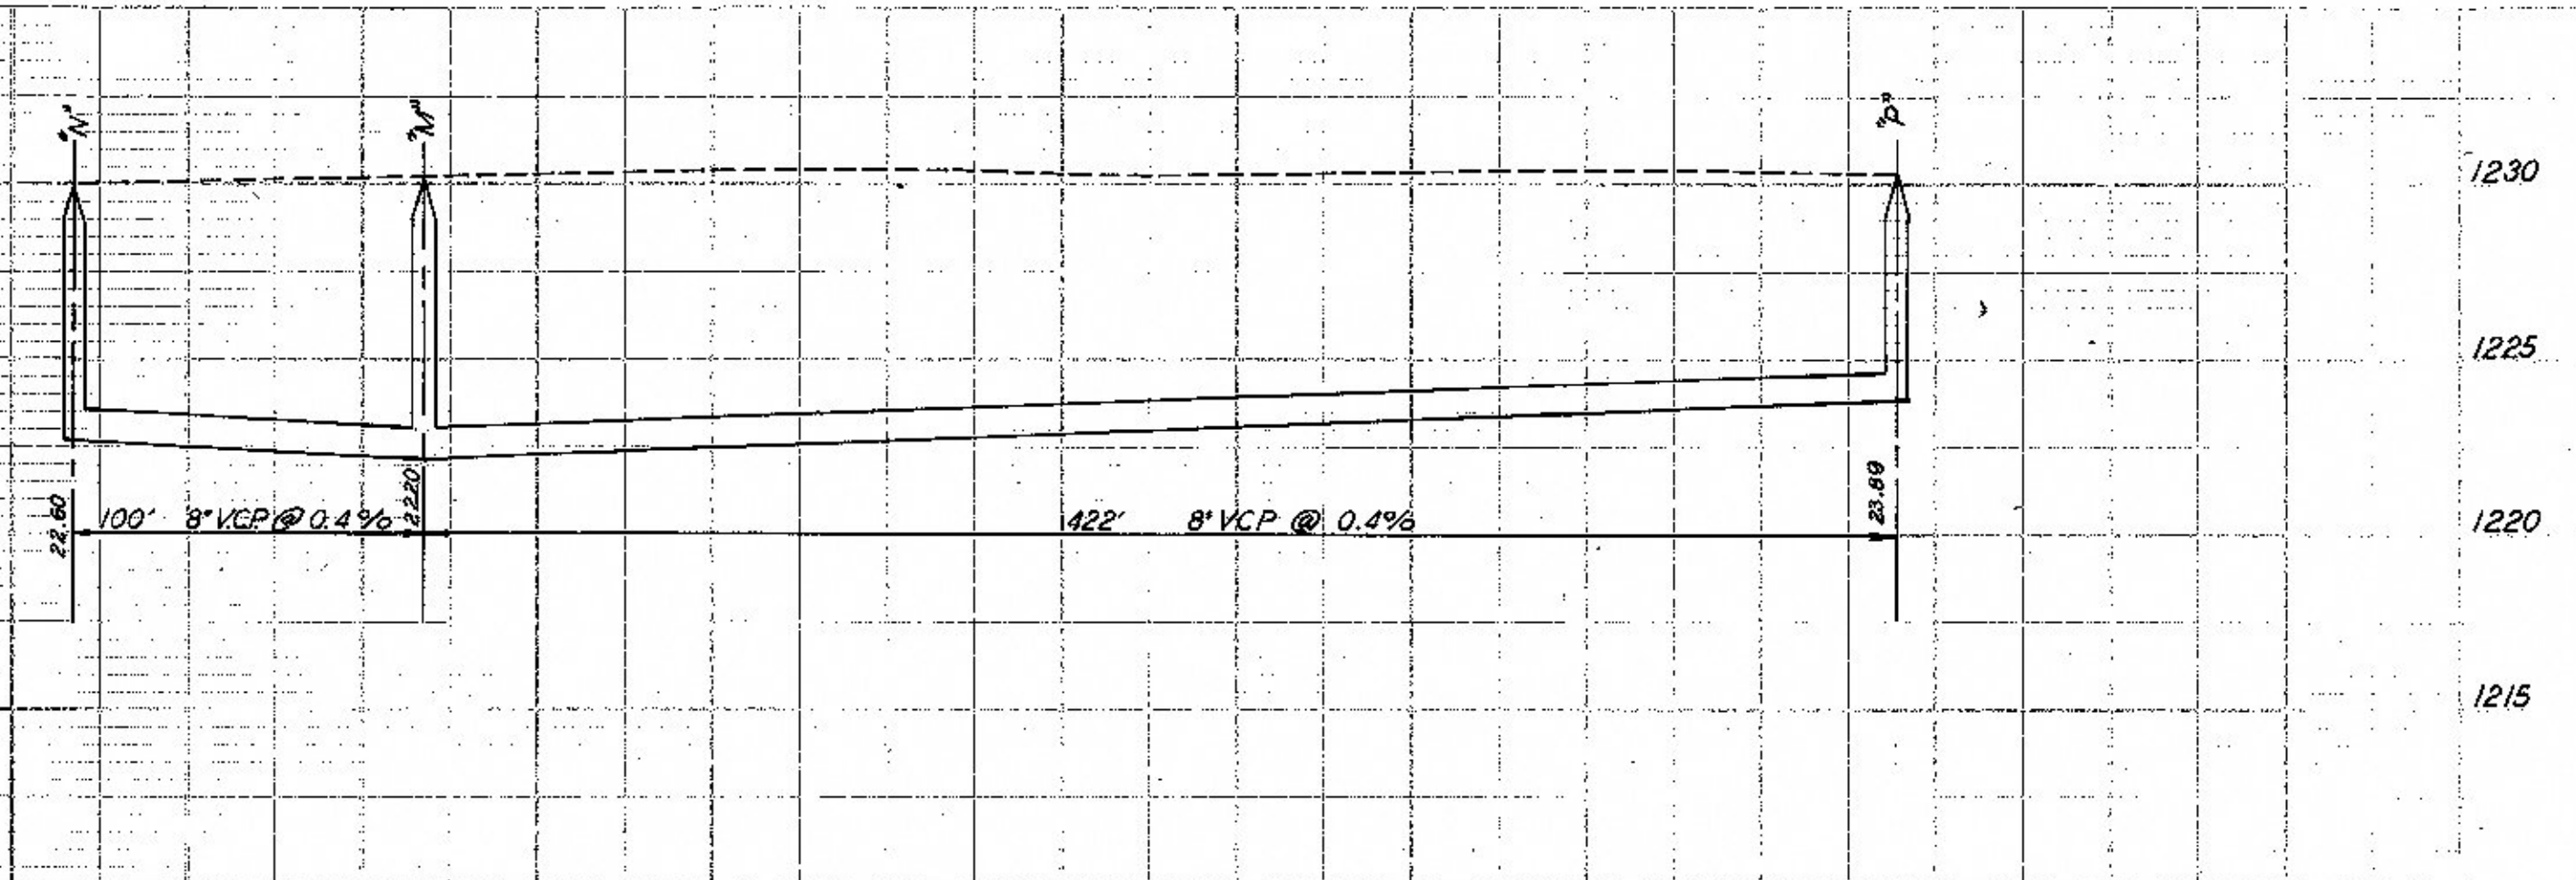


LAT 416

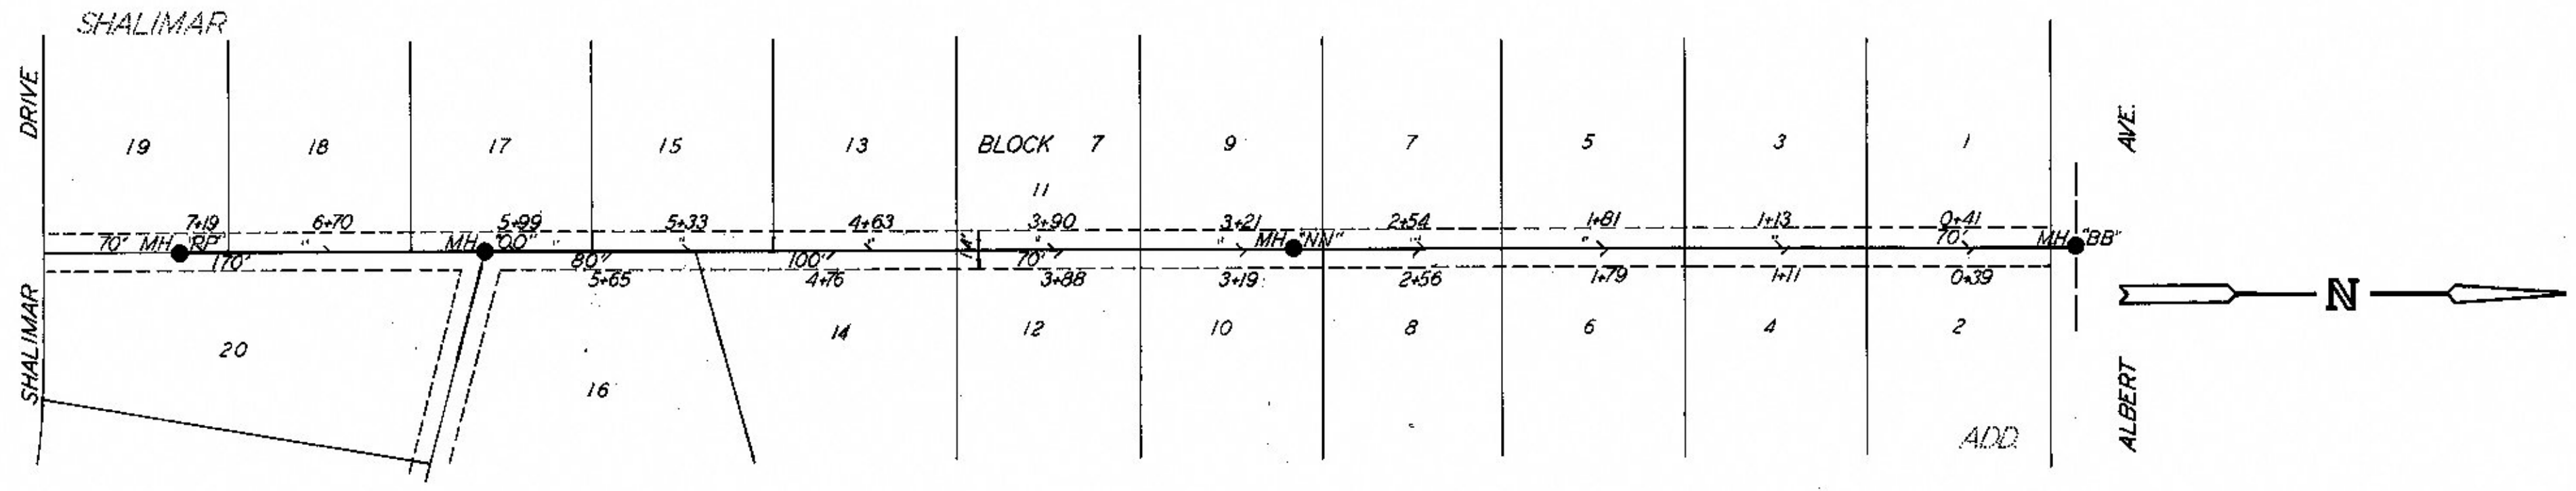

SANITARY SEWER-RW E. OF OHIO- ALBERT TO SHALIMAR

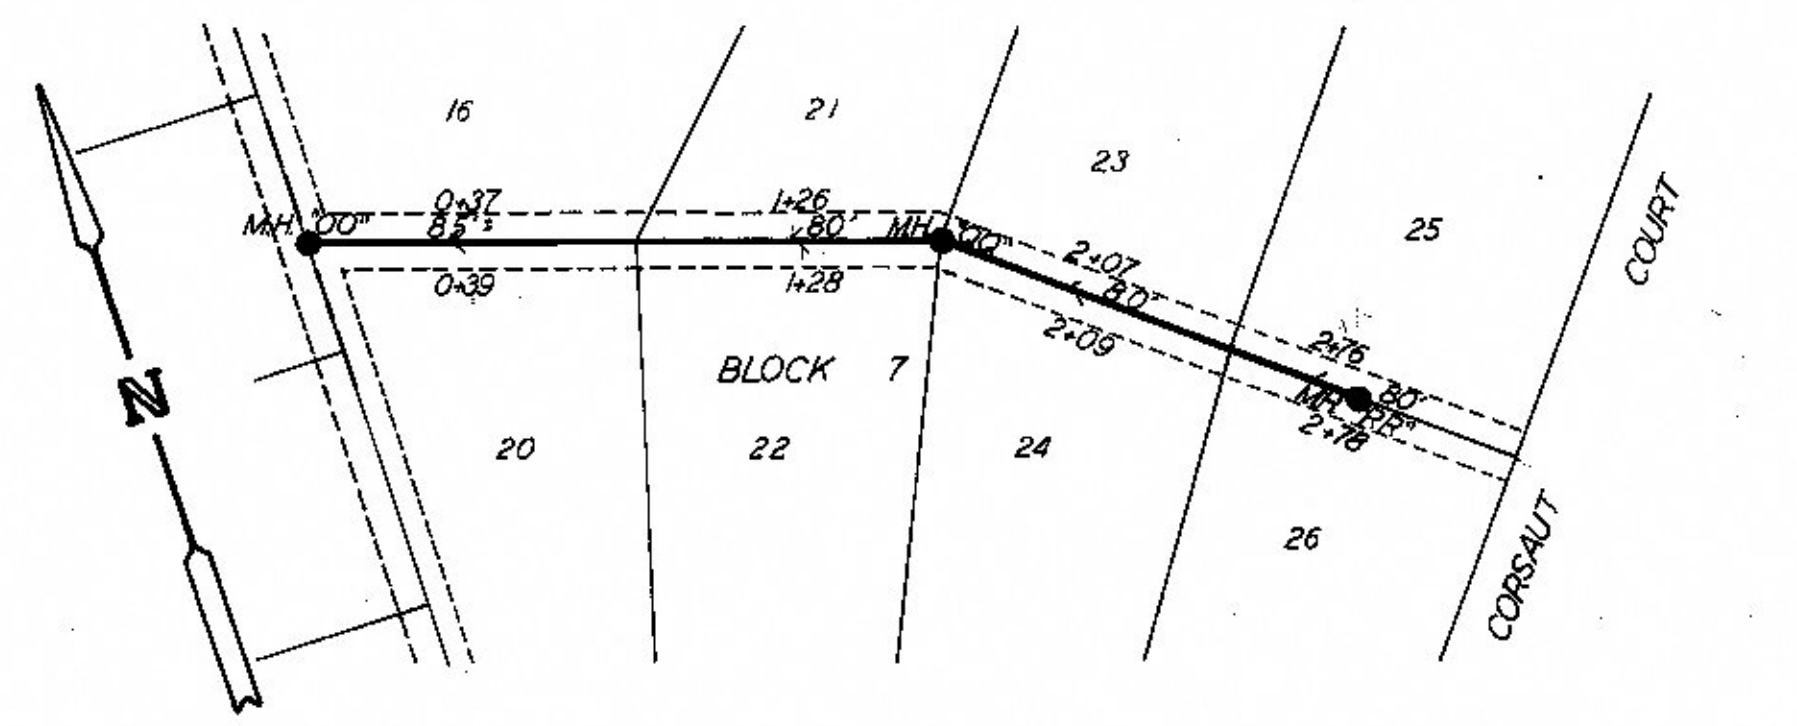

SANITARY SEWER-RW N. OF SHALIMAR-RW E. OF OHIO TO CORSAUT

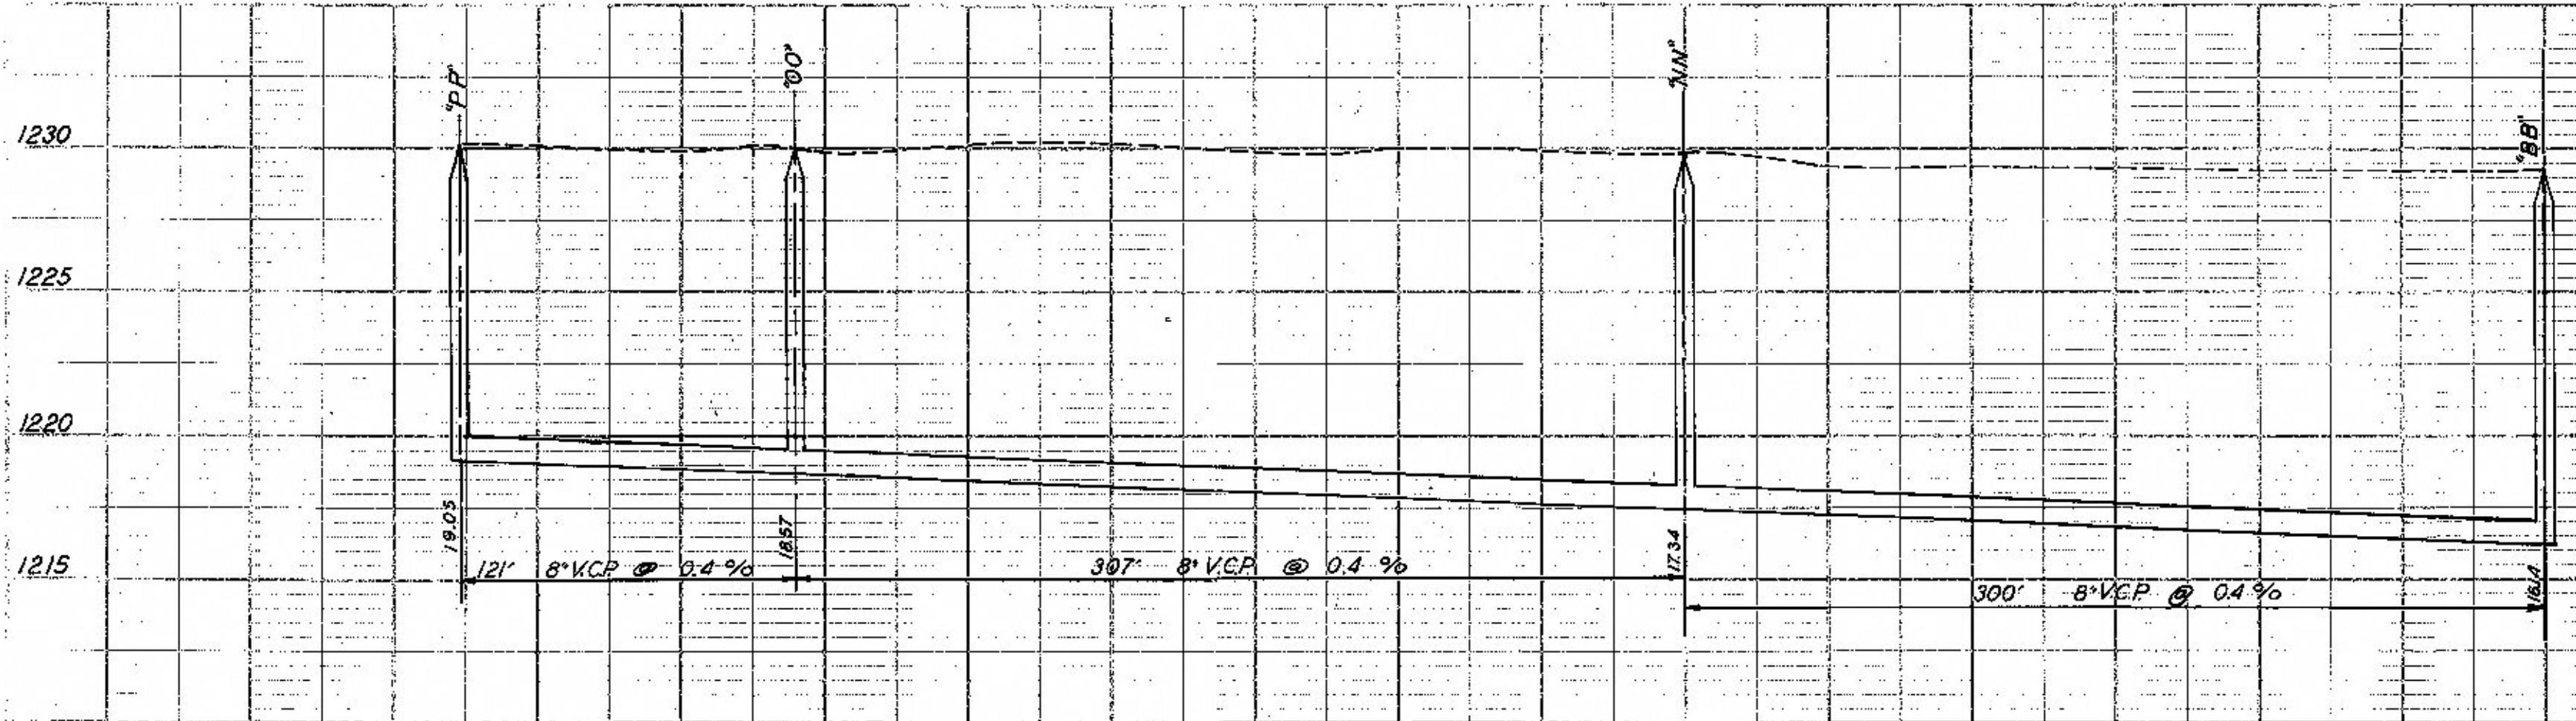

LAT 416

