


PLAN SURVEYED BY DATE
 PLOTTED BY DATE
 NOTE BOOK NO. CHECKED BY DATE
 NO. OF WAYS CHECKED BY DATE



SANITARY SEWER-BLOCKS 10,11&12 SHALIMAR ADD.

PROFILE SURVEYED BY DATE
 PLOTTED BY DATE
 NOTE BOOK NO. CHECKED BY DATE
 NO. OF WAYS CHECKED BY DATE

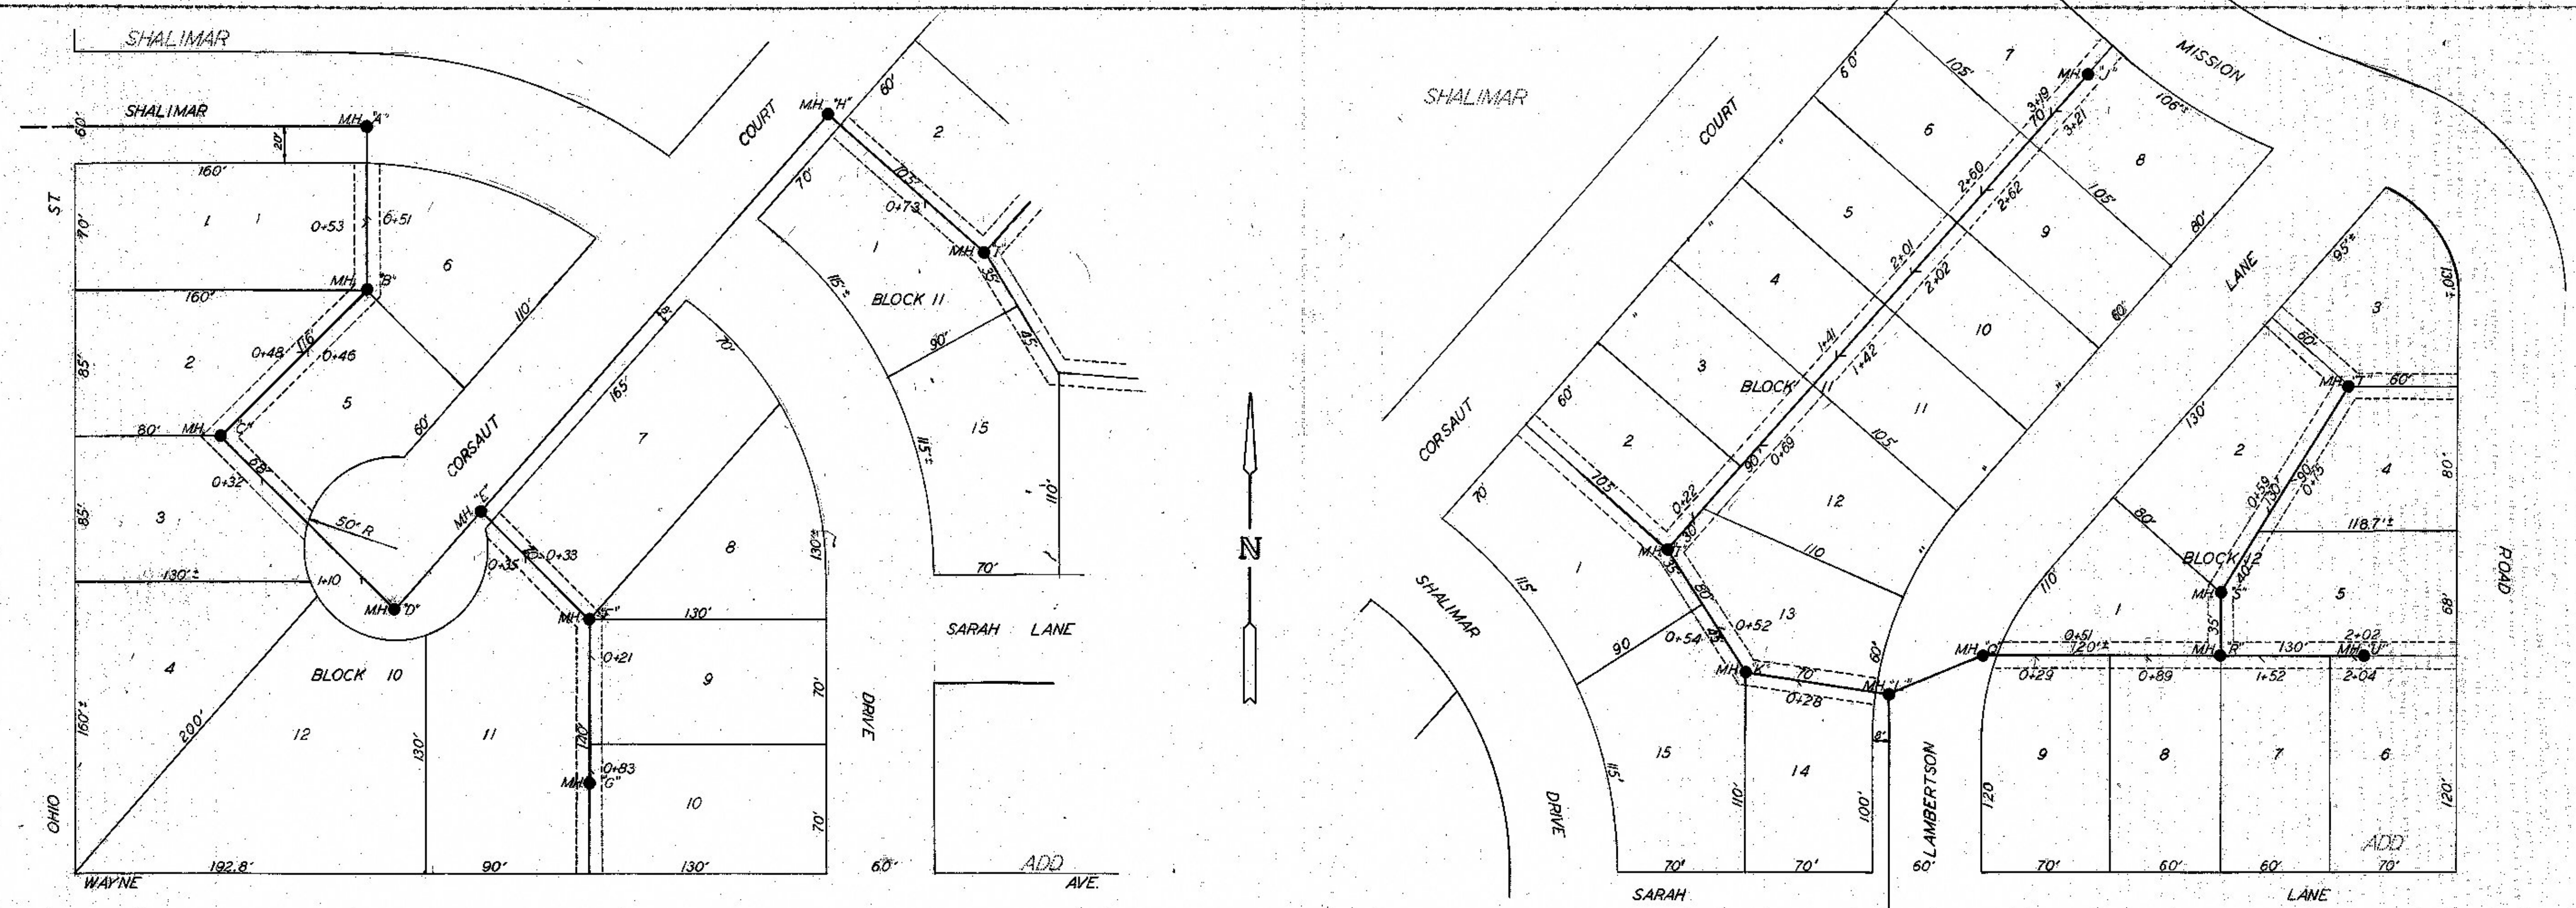