



HASKETT AVE.

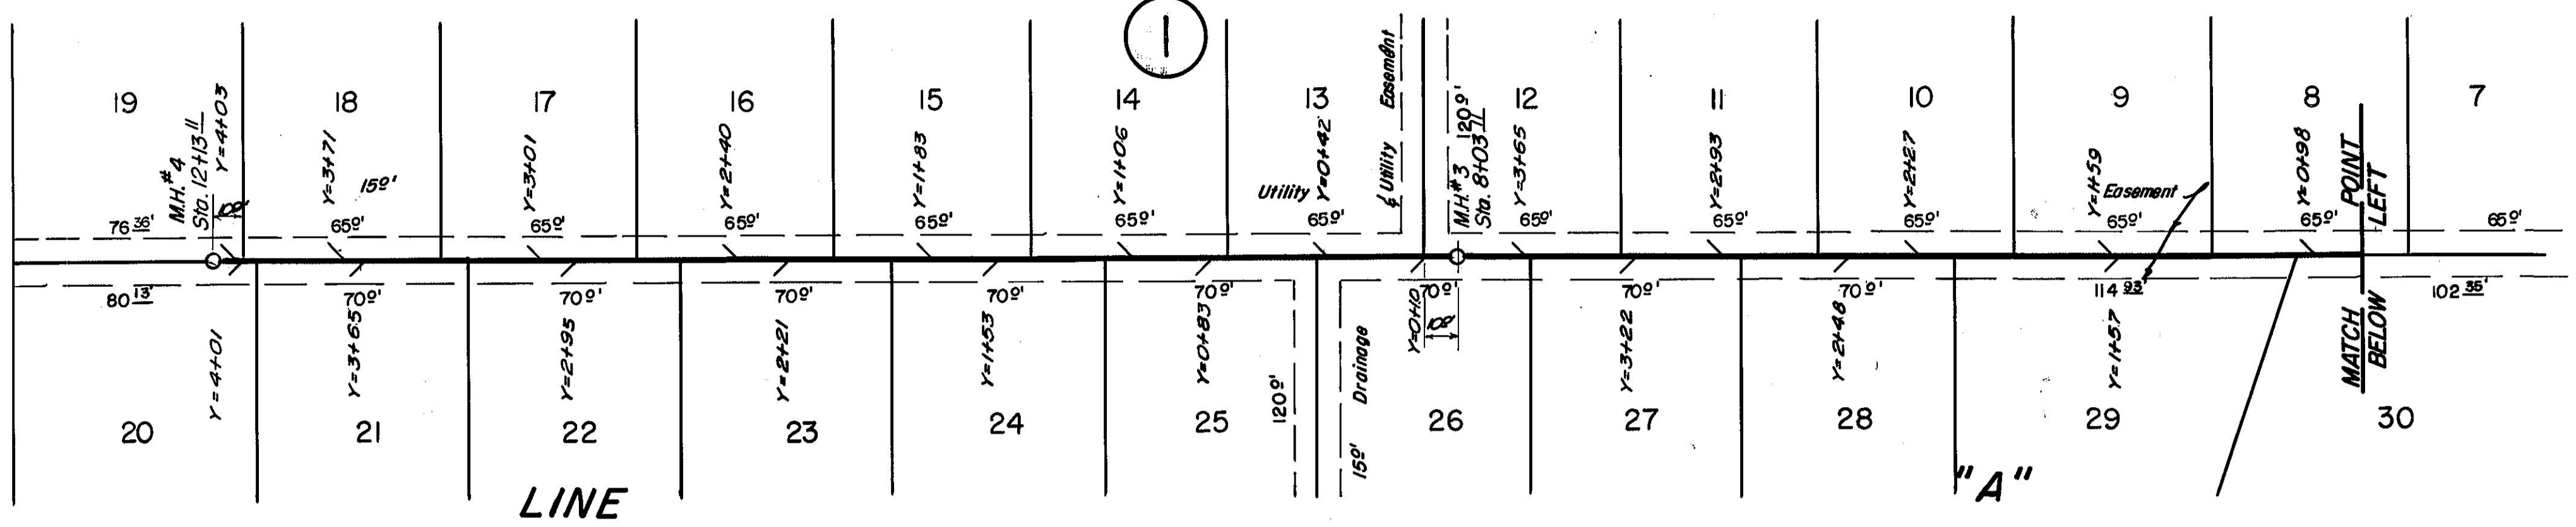


LINE

"A"

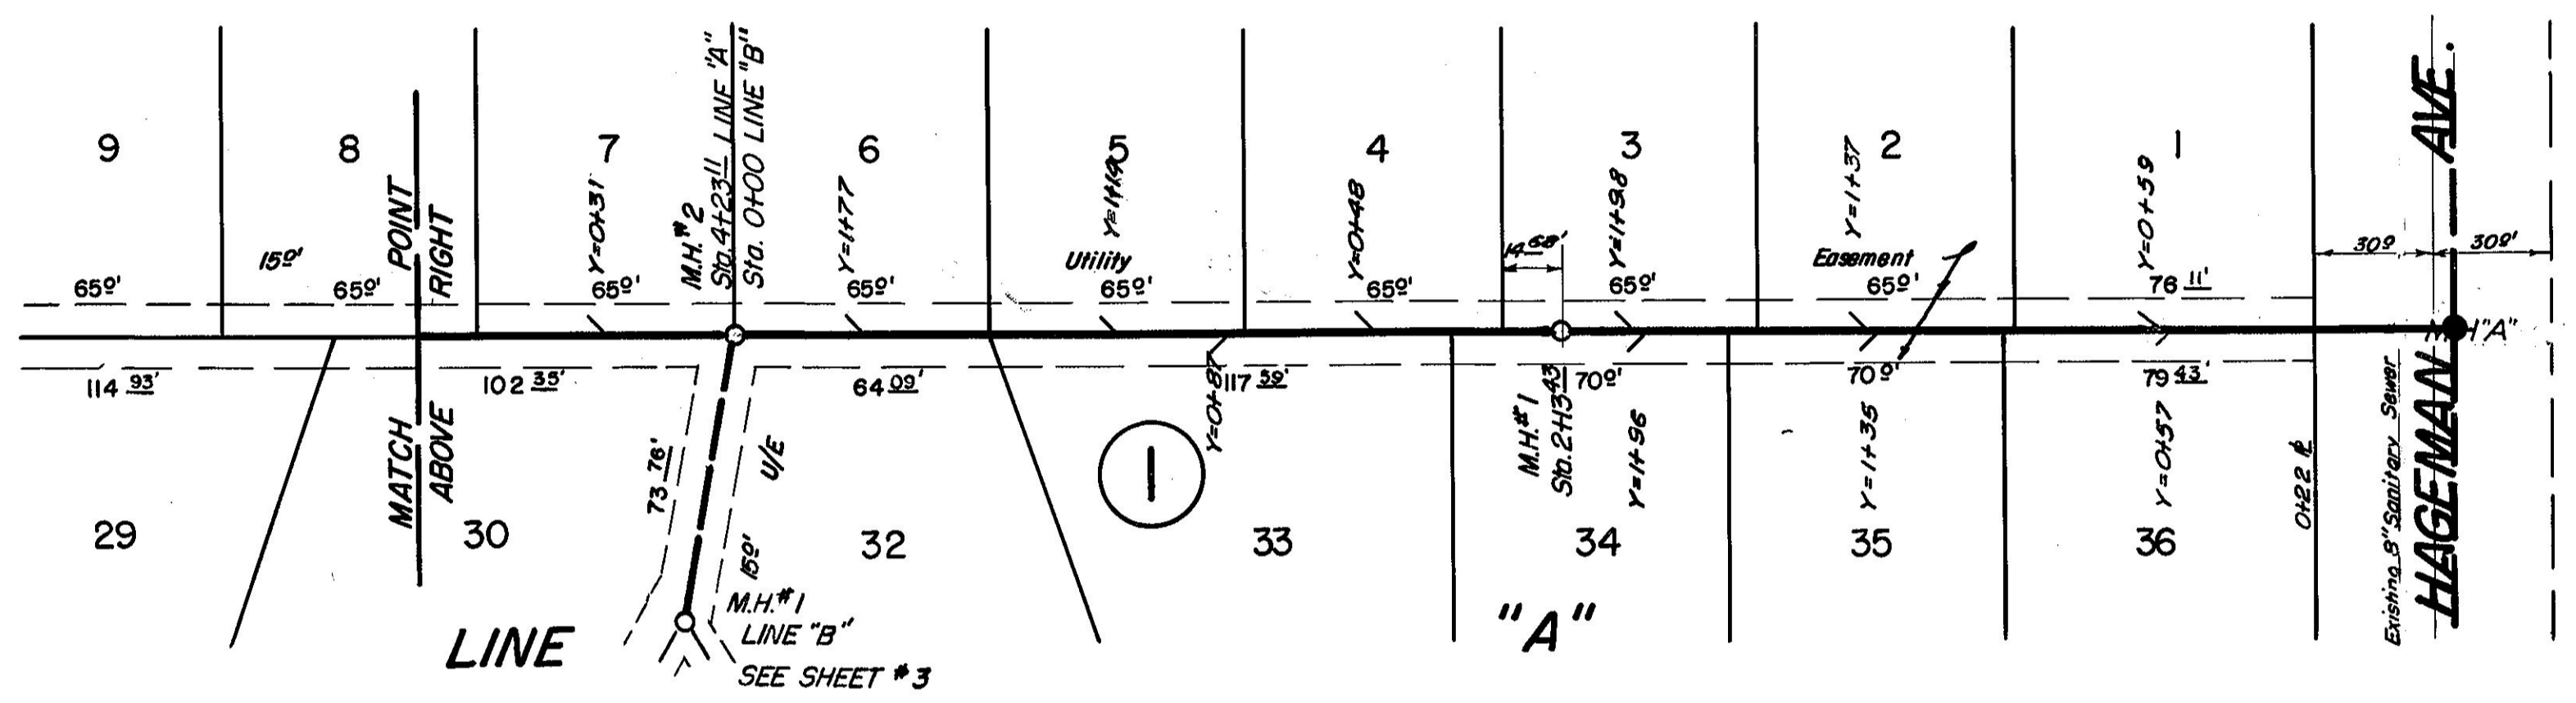

LINE

"A"

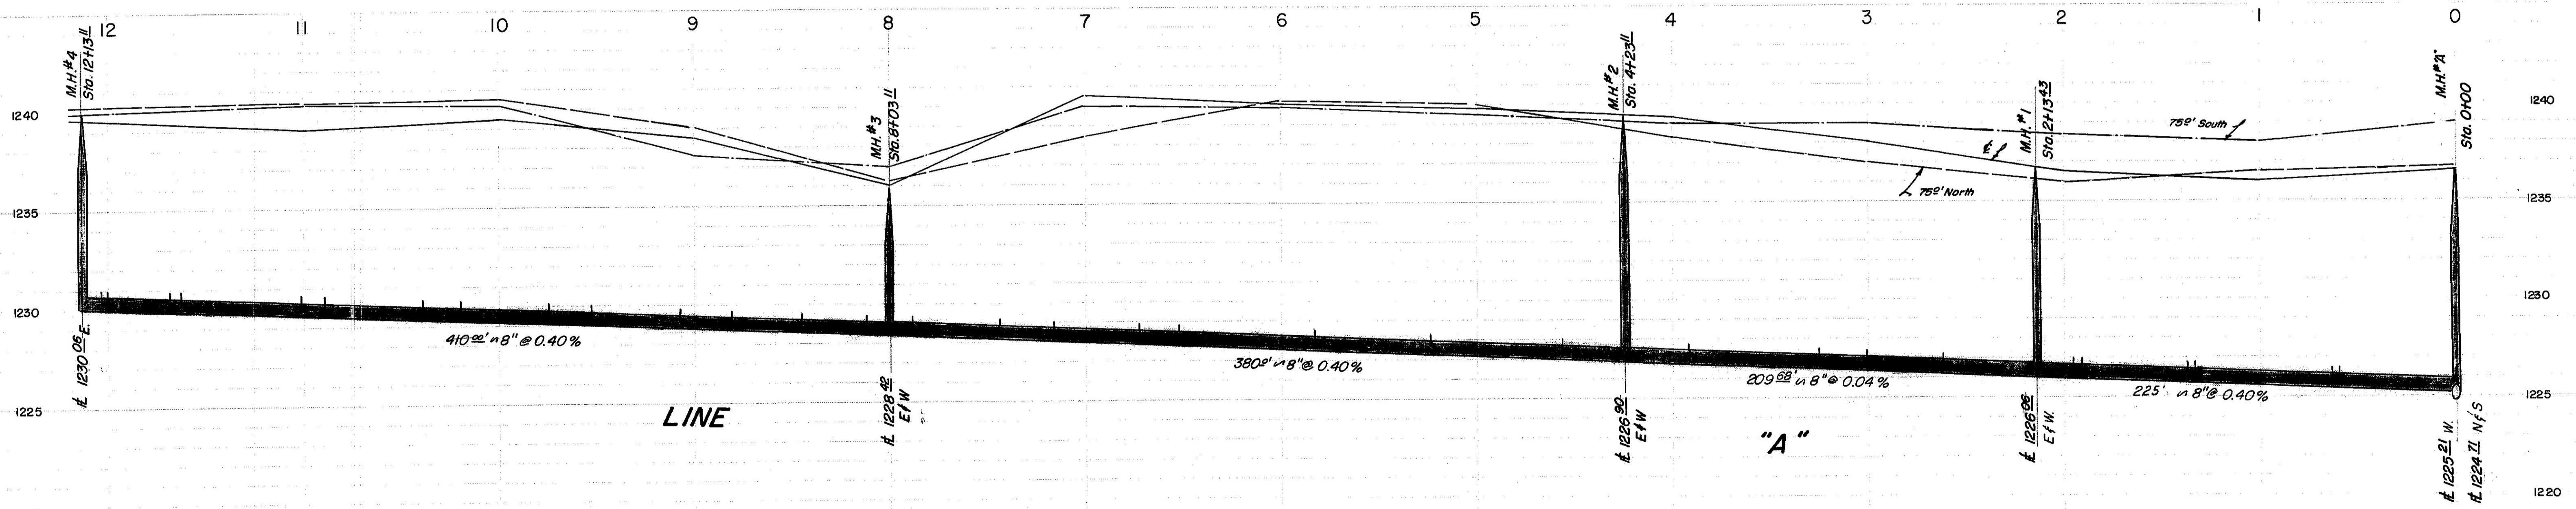

LINE

"A"

"AS BUILT PLAN"  
 Const' By Doerfler & Krapff  
 H.F. Harper, City Engineer  
 July, 1960  
 Salina, Kansas

LINE "A"