



SANITARY SEWER-BLOCK 3, INGERMANSON HEIGHTS 2ND ADD.

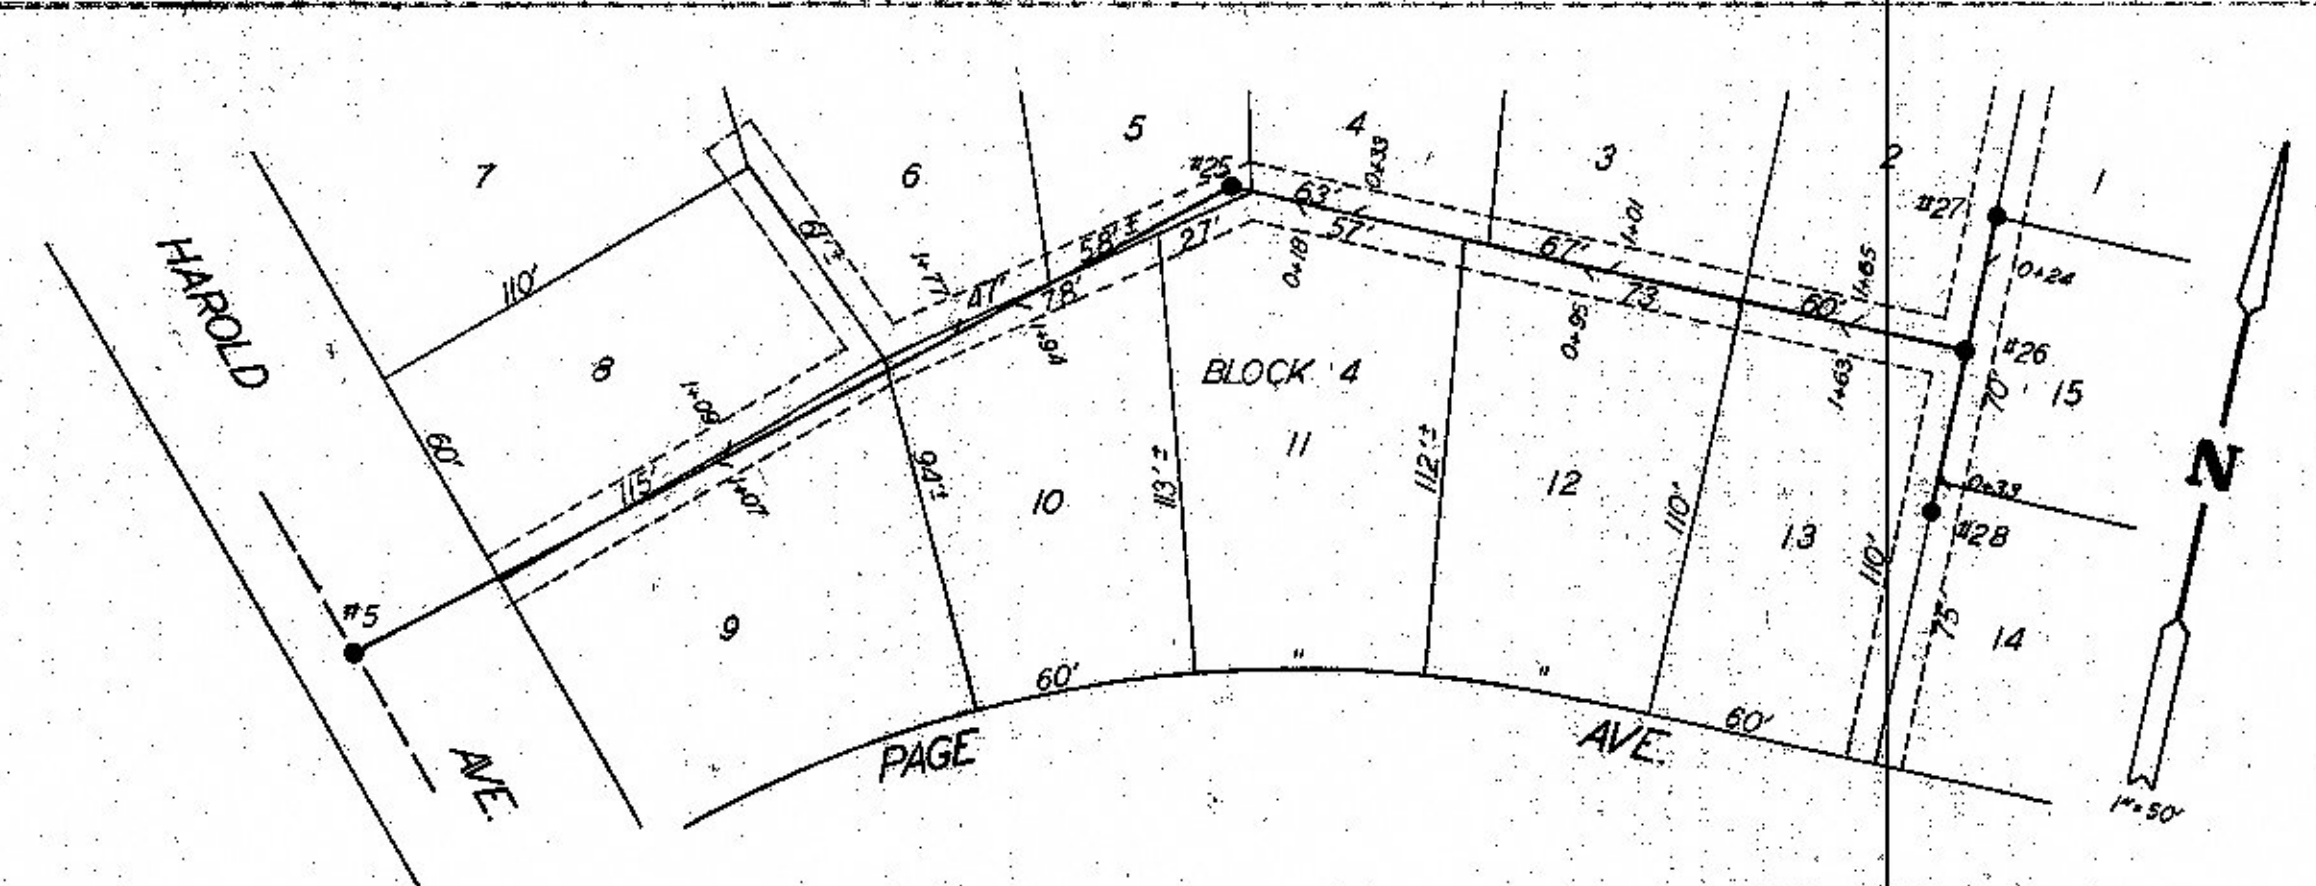


SANITARY SEWER-BLOCK 4, INGERMANSON HEIGHTS 2ND ADD.

DATE: _____
 SURVEYED BY: _____
 CHECKED BY: _____
 NOTE BOOK NO. _____
 ALIGNMENT CHECKED BY: _____
 RT. OF WAY CHECKED BY: _____

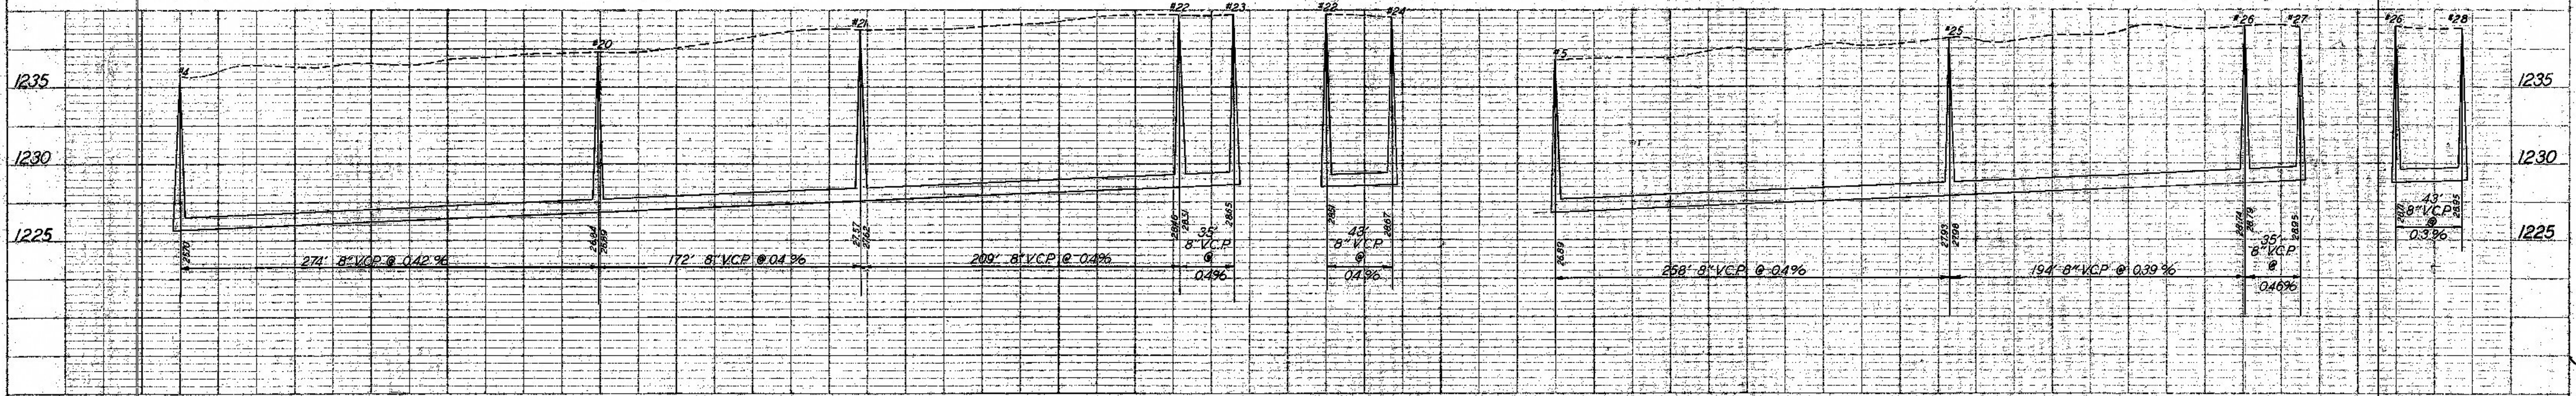

DATE: _____
 SURVEYED BY: _____
 CHECKED BY: _____
 NOTE BOOK NO. _____
 ALIGNMENT CHECKED BY: _____
 RT. OF WAY CHECKED BY: _____

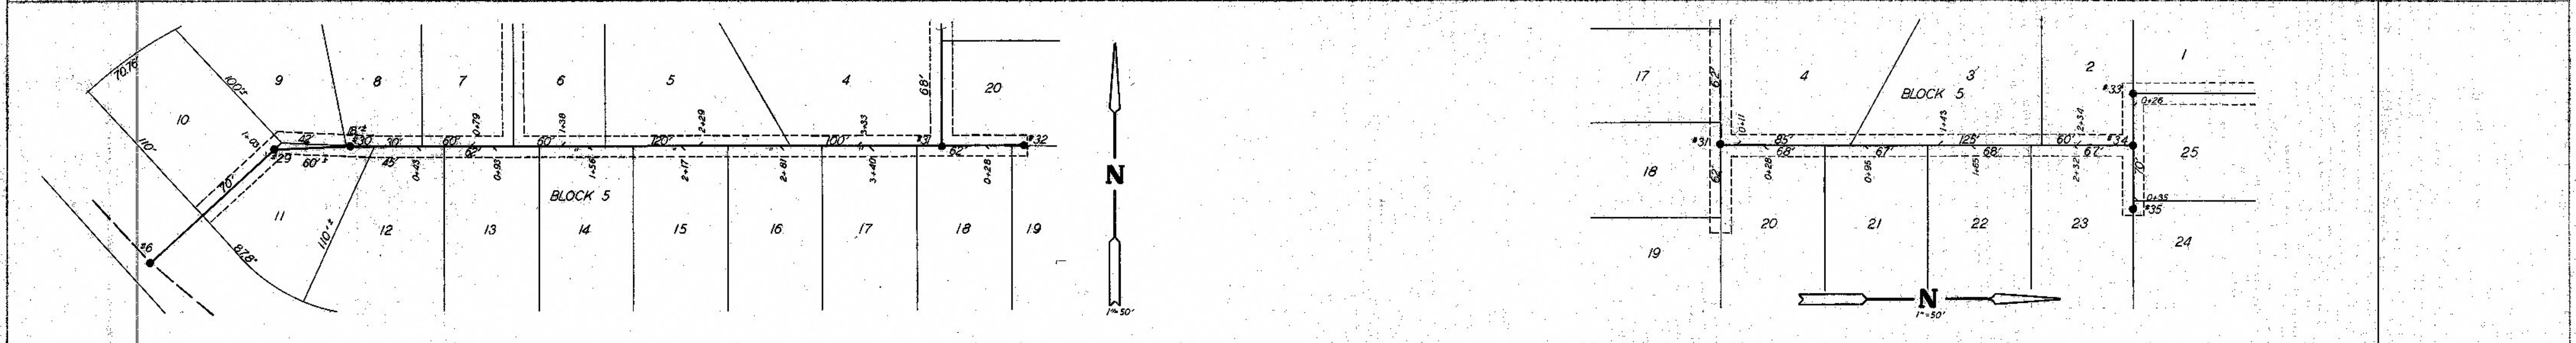

SANITARY SEWER-BLOCK 5 INGERMANSON HEIGHTS 2ND ADD.

