

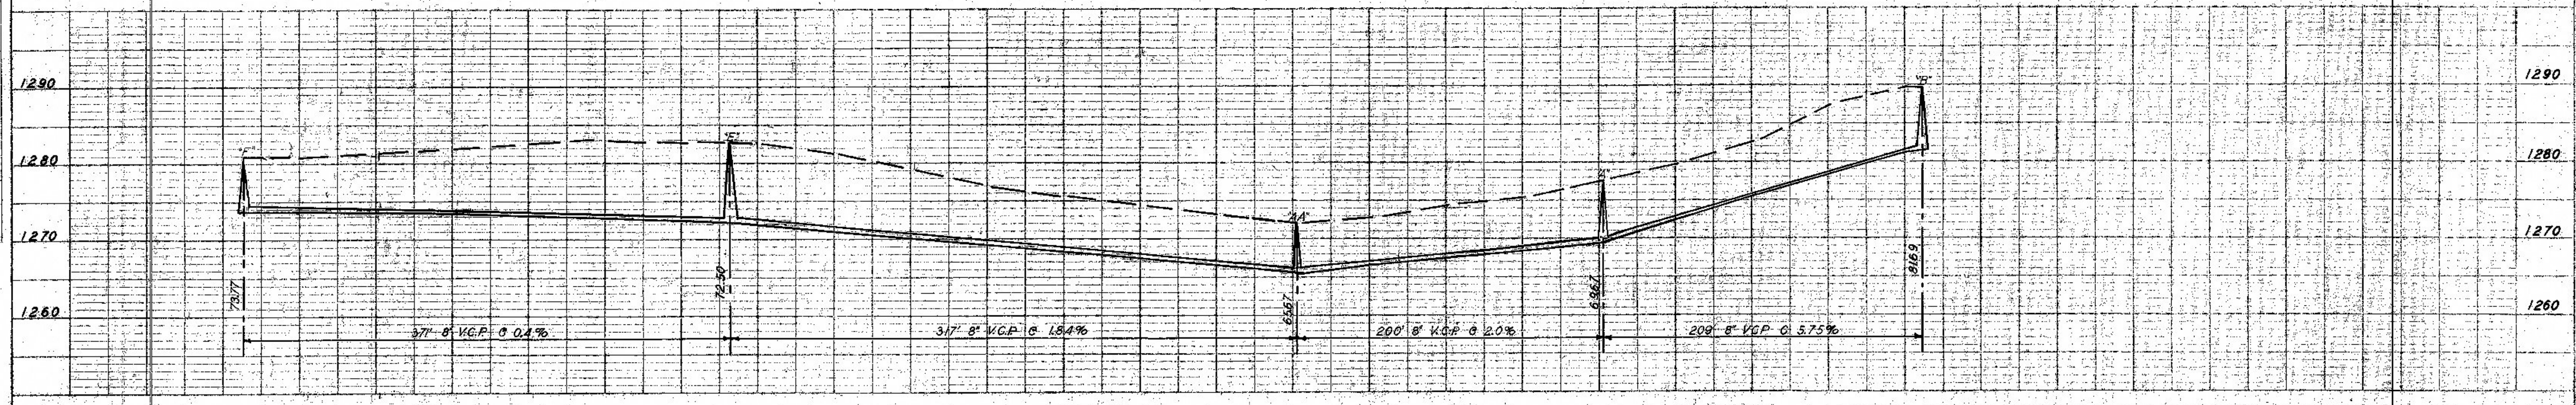



PLAN SURVEYED BY DATE
 PLOTTED BY DATE
 NOTE BOOK ALMOST CHECKED BY DATE
 BY DATE

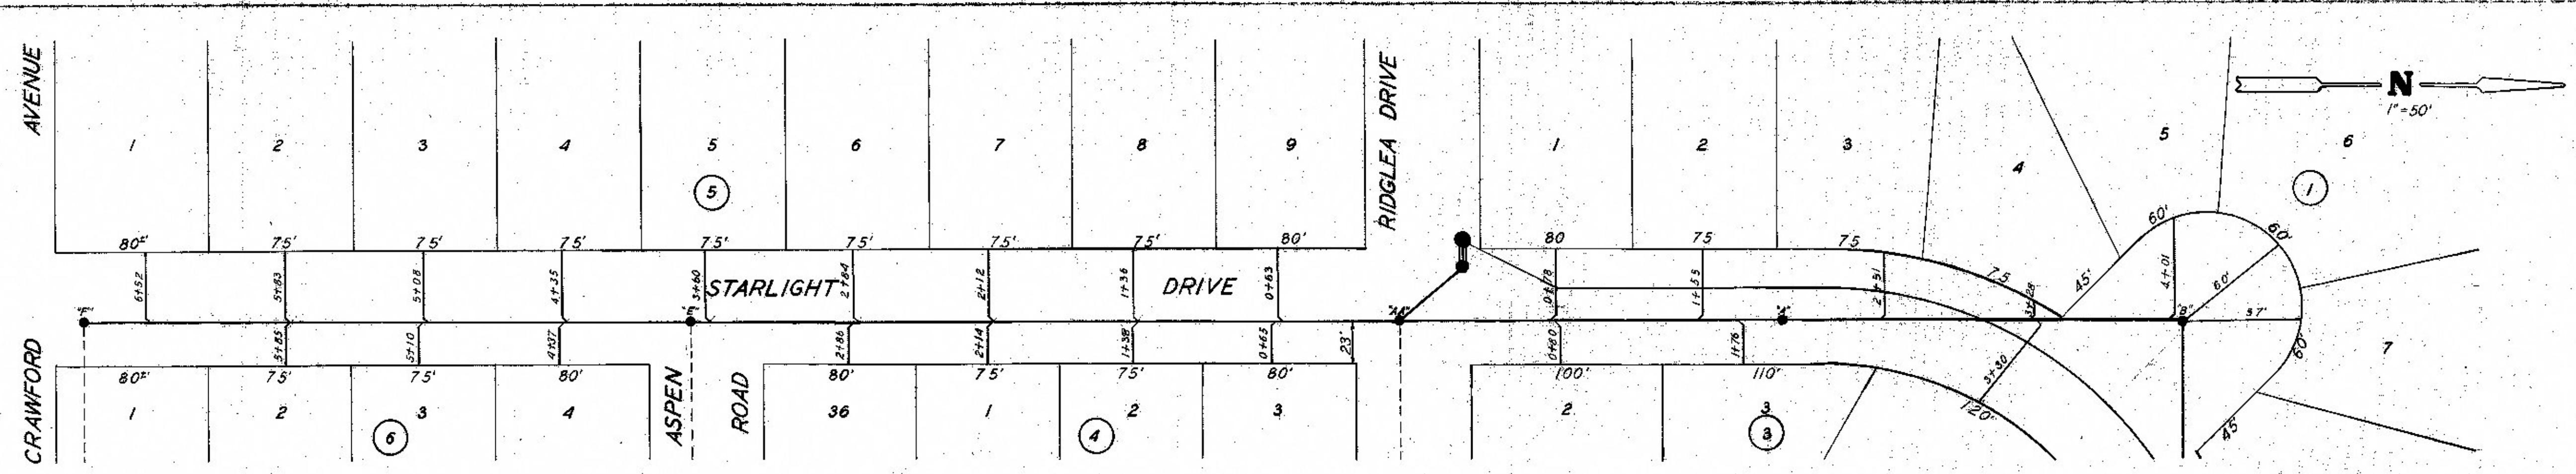

PROFILE SURVEYED BY DATE
 PLOTTED BY DATE
 NOTE BOOK ALMOST CHECKED BY DATE
 BY DATE

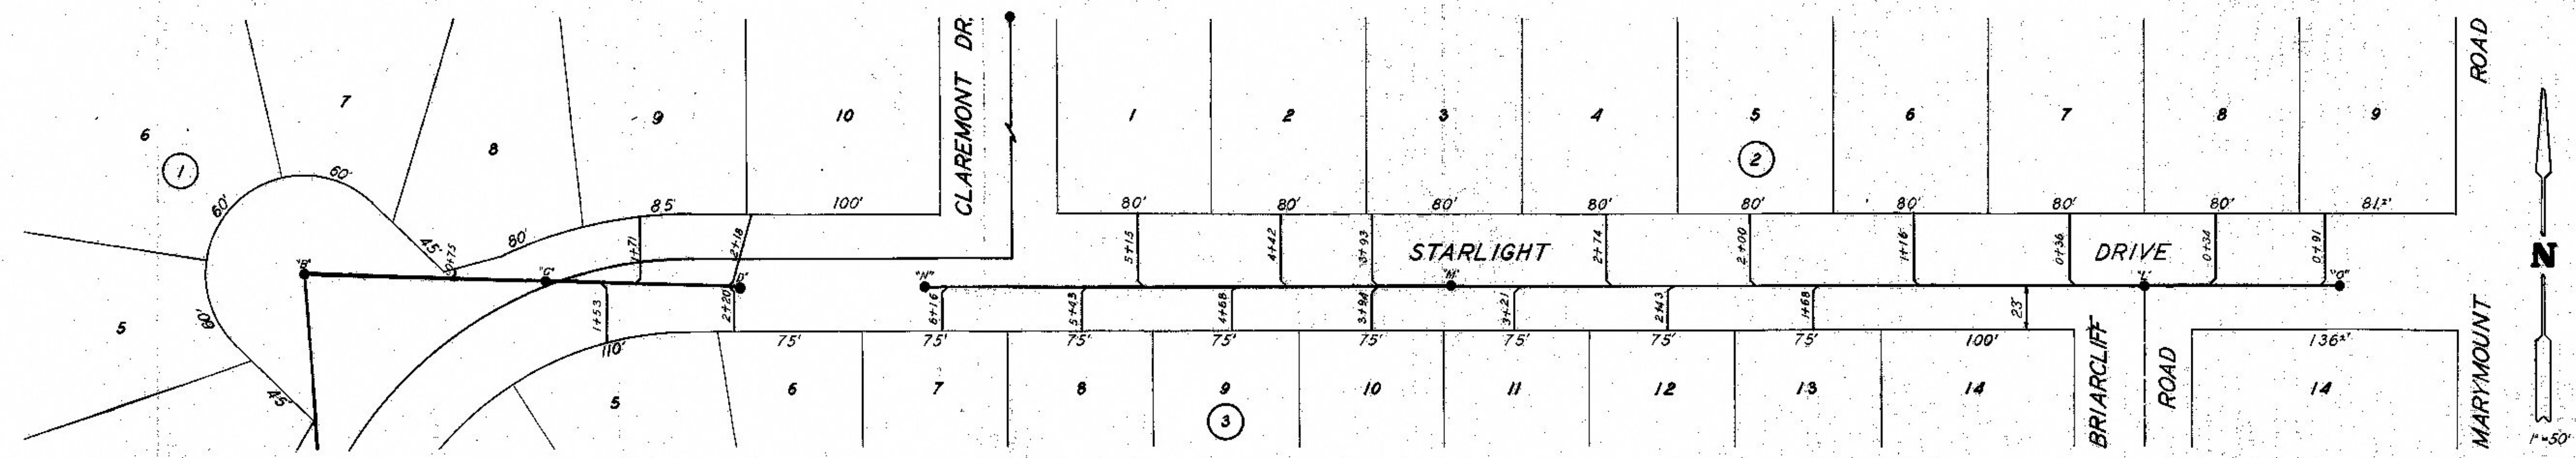

SANITARY SEWER STARLIGHT DRIVE FROM CRAWFORD AVENUE TO MARYMOUNT ROAD LINES A,B,&E

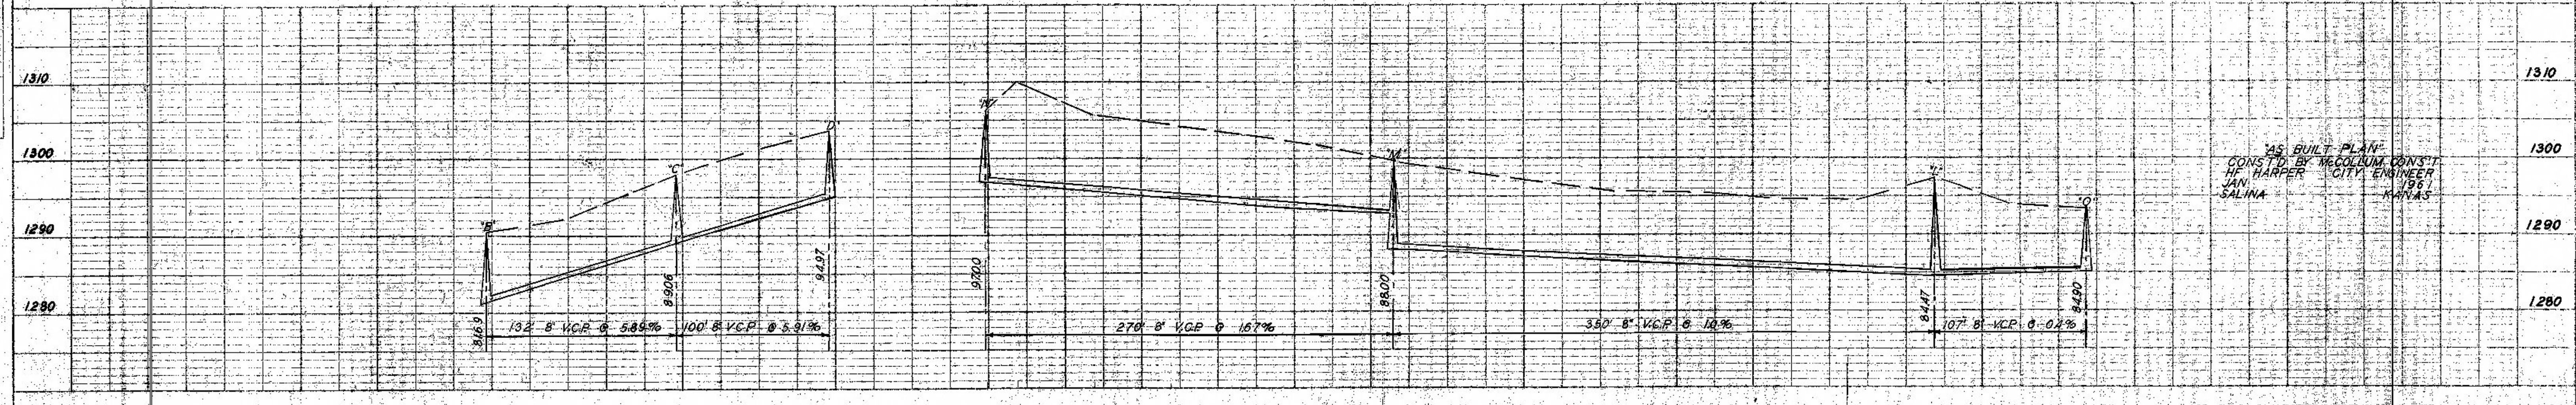

AS BUILT PLAN
 CONST'D BY McCOLLUM CON'S'T
 H.W. HARPER CITY ENGINEER
 JAN SALINA 1961
 KANSAS