

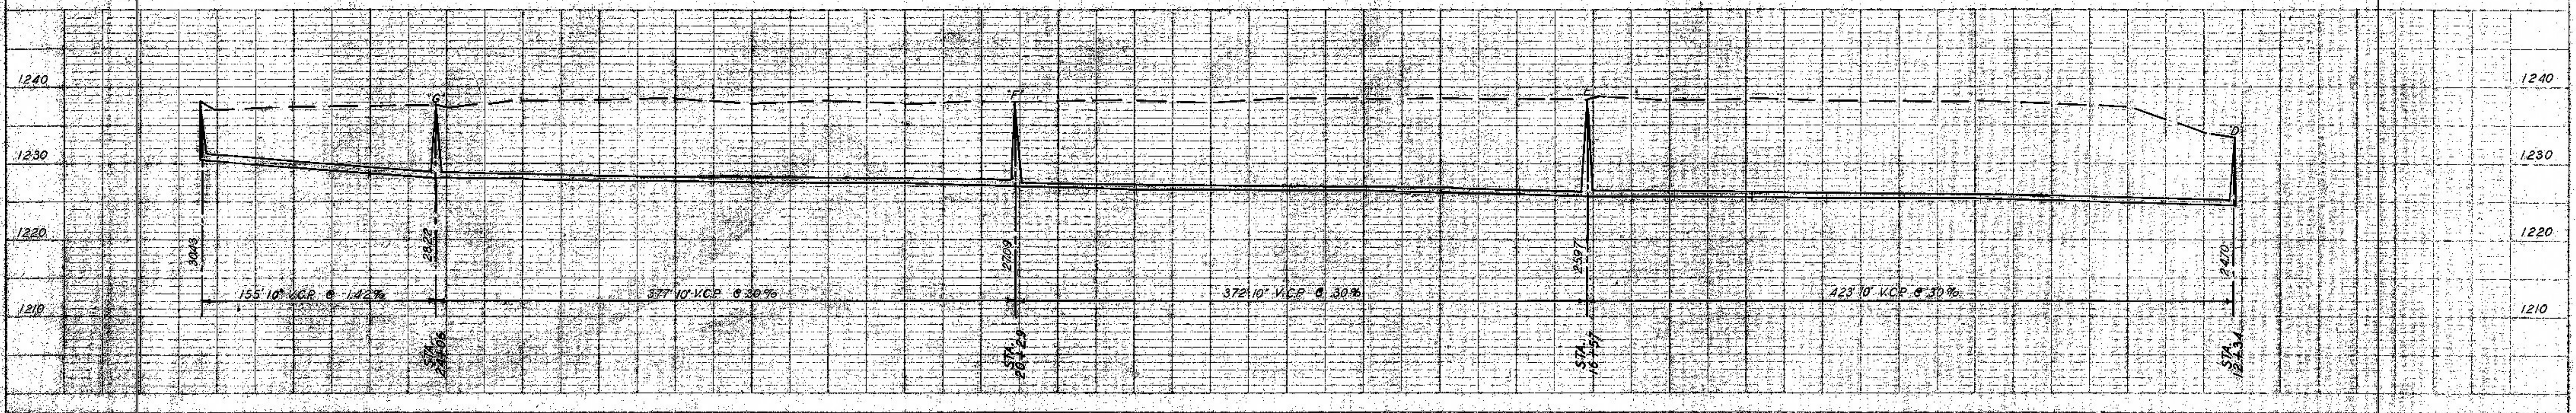
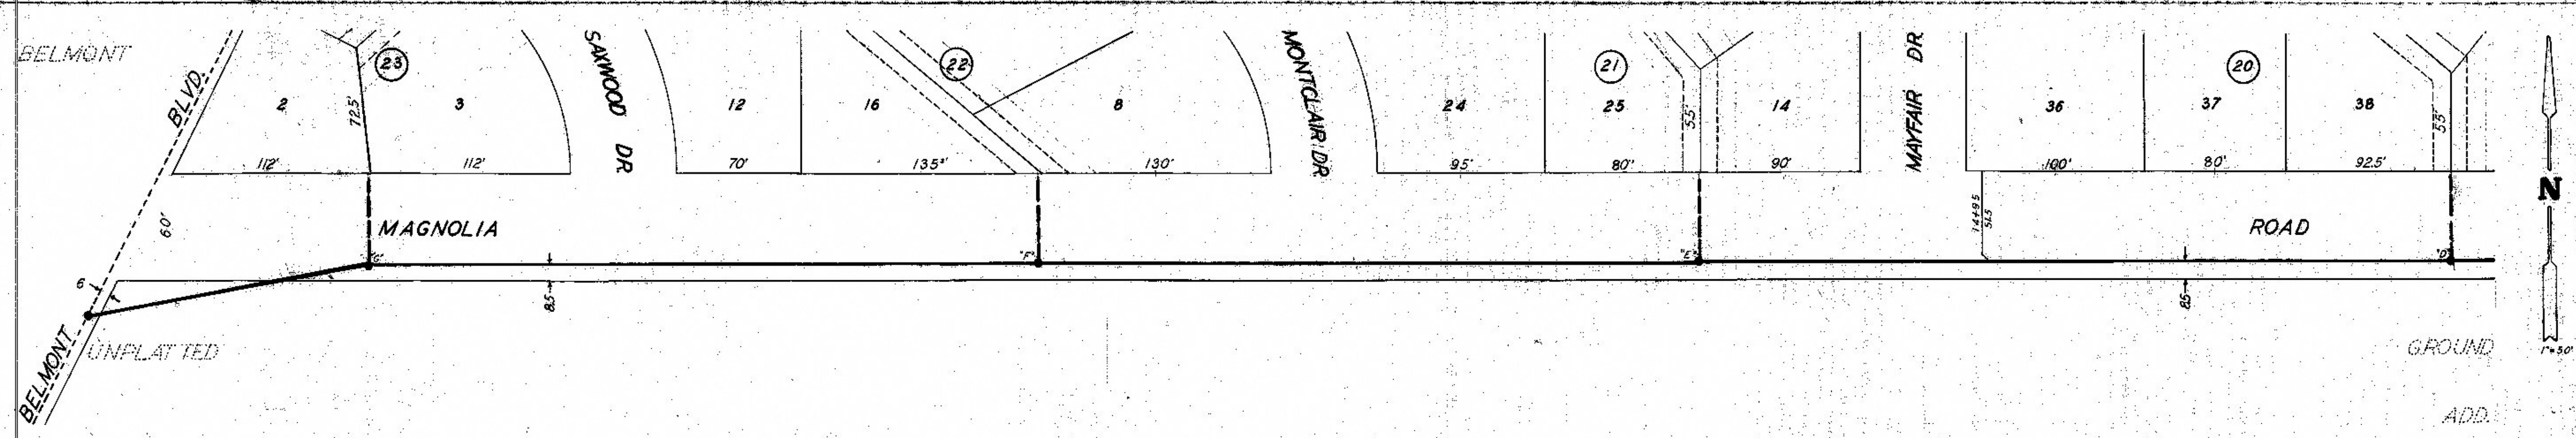


PLAN  
 DRAWN BY: [ ]  
 CHECKED BY: [ ]  
 DATE: [ ]  
 NOTE: BOOK ALIGNED CHECKED BY: [ ]  
 NO. [ ]

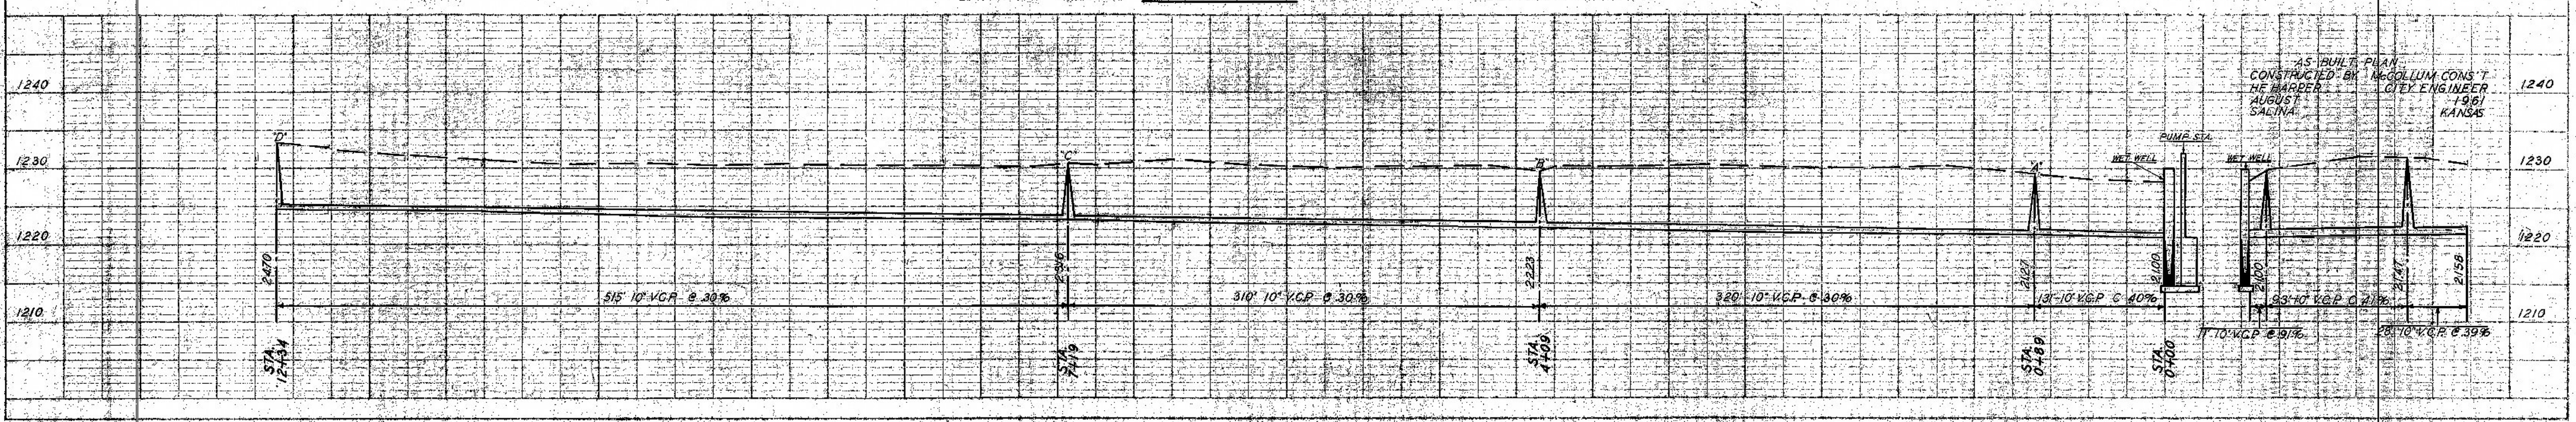

PROFILE  
 DRAWN BY: [ ]  
 CHECKED BY: [ ]  
 DATE: [ ]  
 NOTE: BOOK ALIGNED CHECKED BY: [ ]  
 NO. [ ]

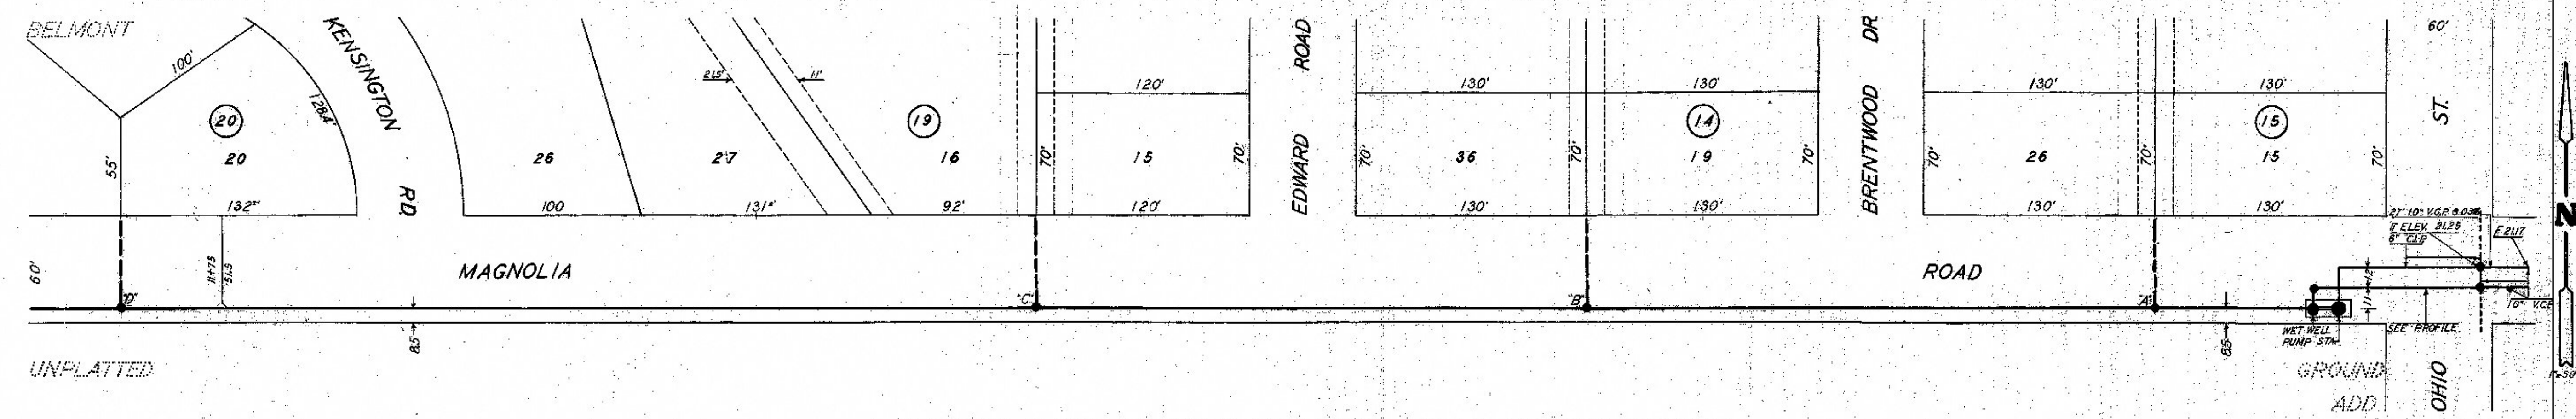

SANITARY SEWER MAGNOLIA ROAD FROM OHIO TO BELMONT MAIN 40"

AS BUILT PLAN  
 CONSTRUCTED BY  
 THE HARPER  
 ENGINEERS  
 1981  
 KANSAS