

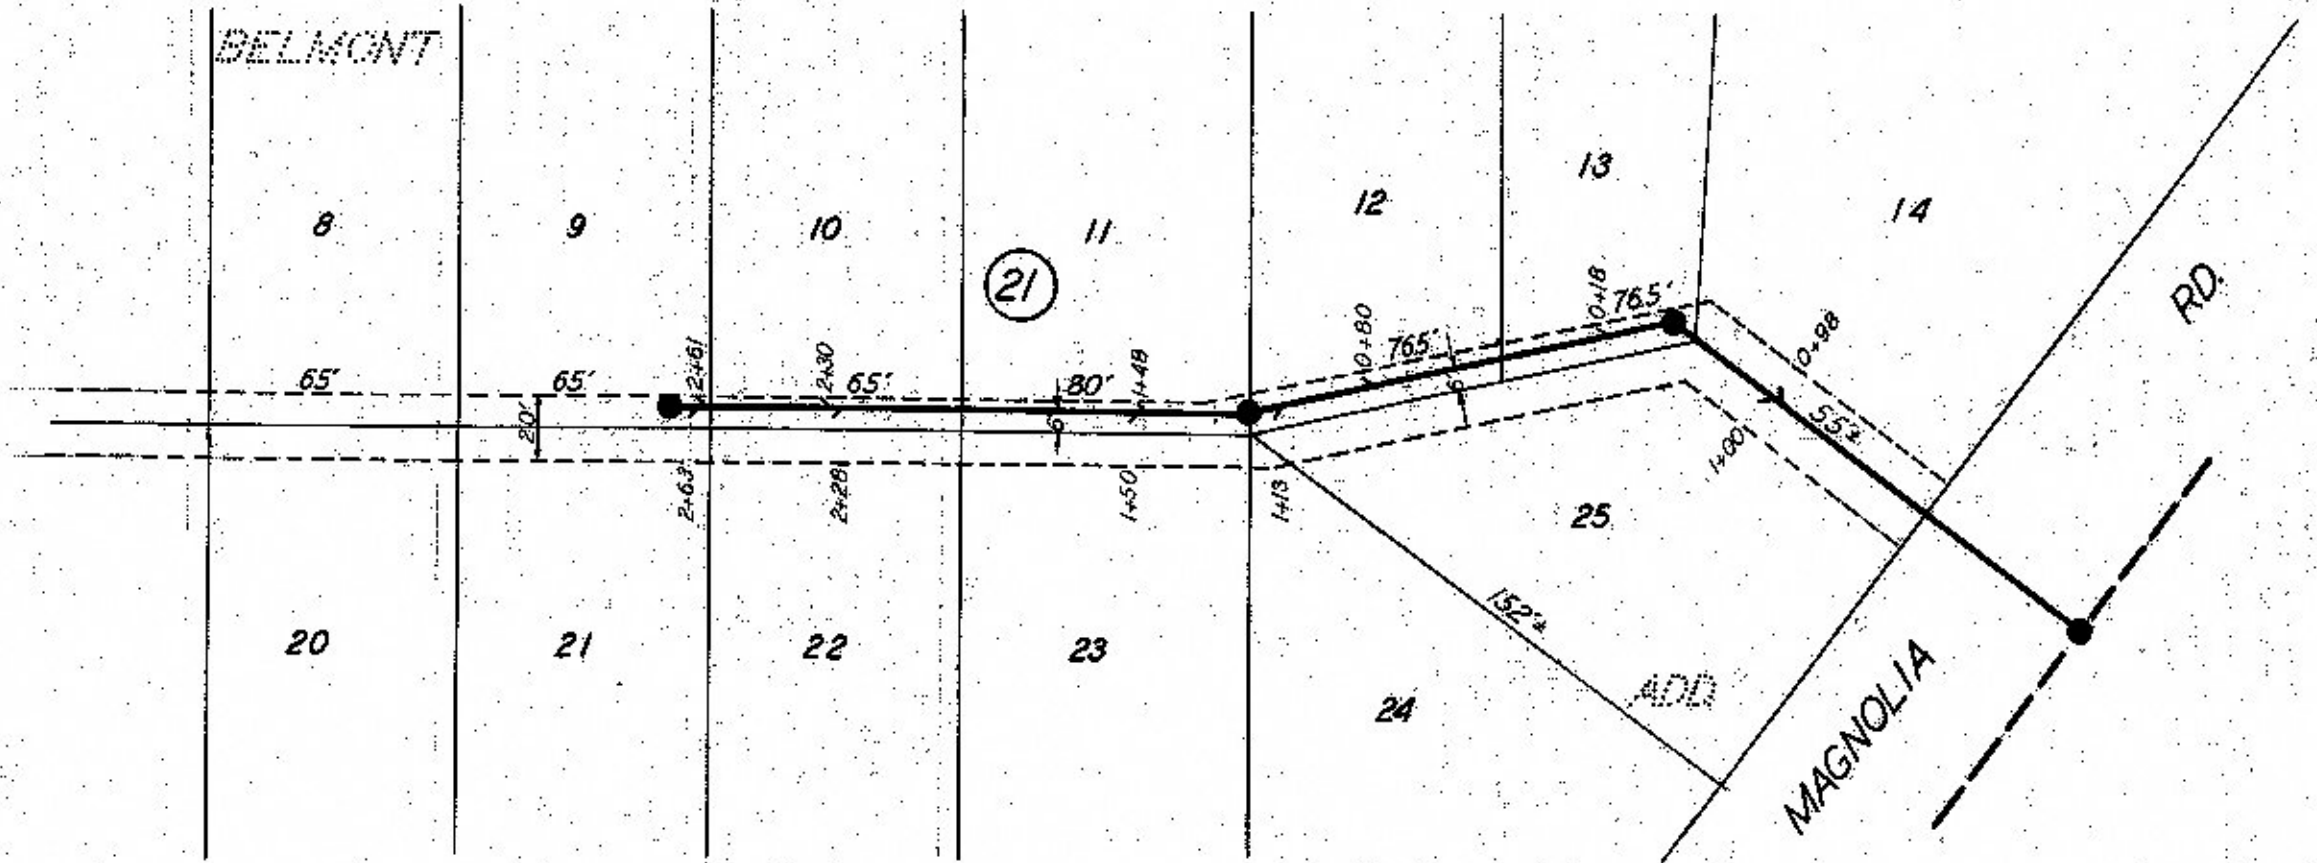


SANITARY SEWER R/W OF MAYFAIR - MAGNOLIA TO LOT 30 BLK 20

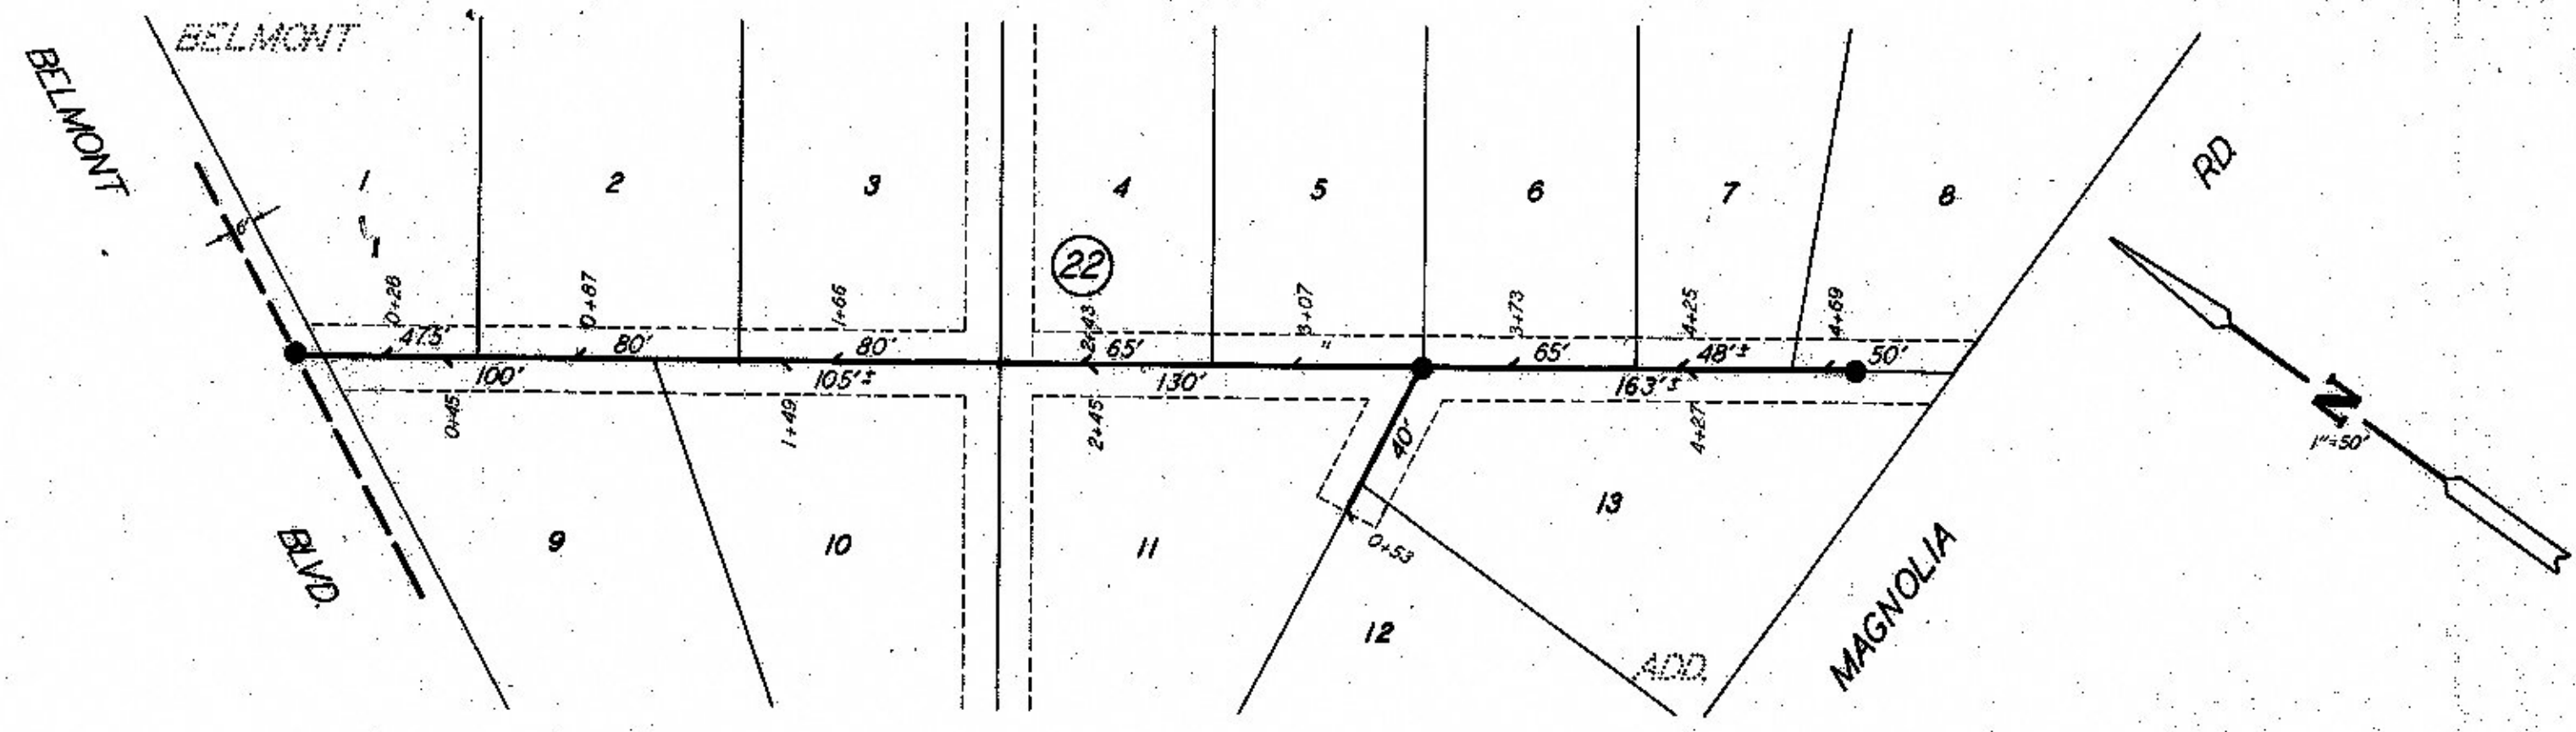


SANITARY SEWER R/W E. OF MONTCLARE - MAGNOLIA TO LOT 9, BLK 21

PLAN  
 SURVEYED BY: \_\_\_\_\_  
 DATE: \_\_\_\_\_  
 NOTE BOOK NO. \_\_\_\_\_  
 PLAN CHECKED BY: \_\_\_\_\_  
 DATE: \_\_\_\_\_  
 FIELD CHECKED BY: \_\_\_\_\_  
 DATE: \_\_\_\_\_

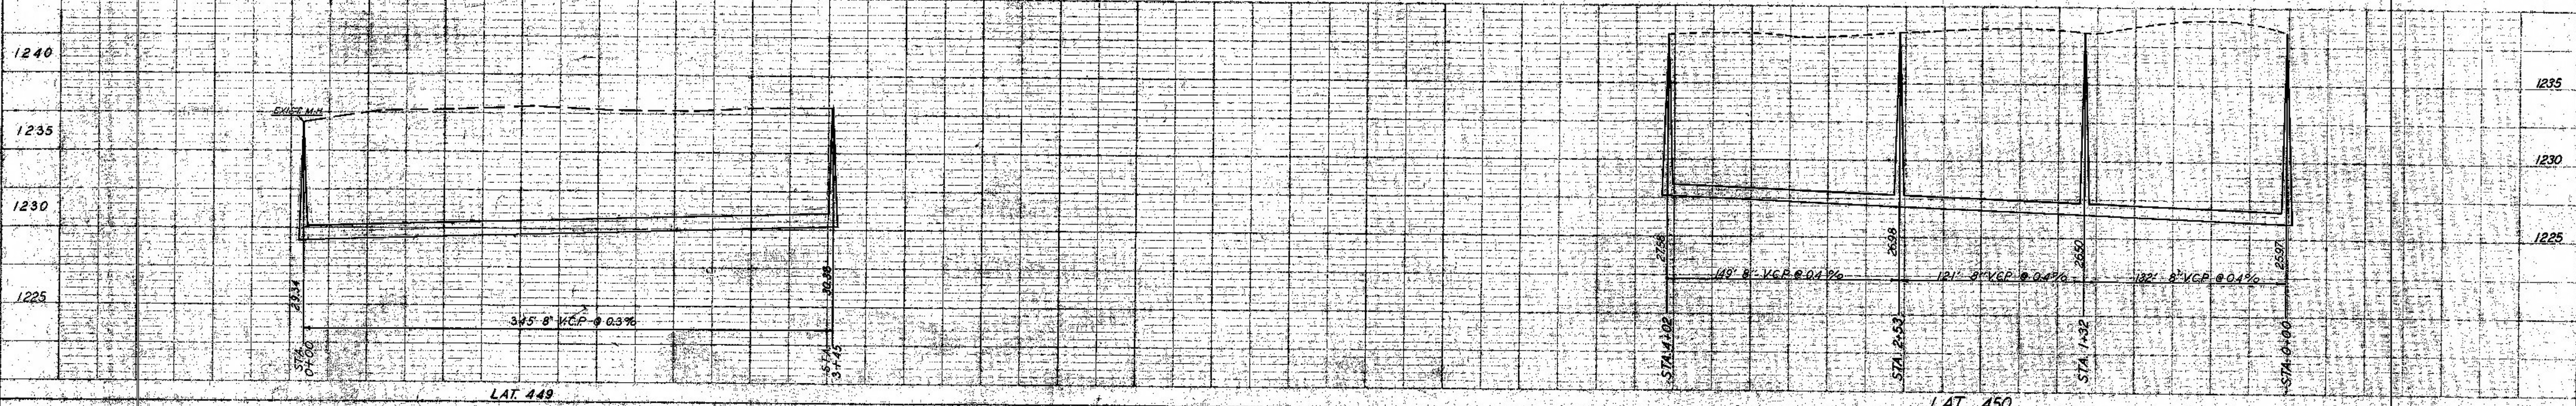


SANITARY SEWER - BLOCK 22, BELMONT ADD.

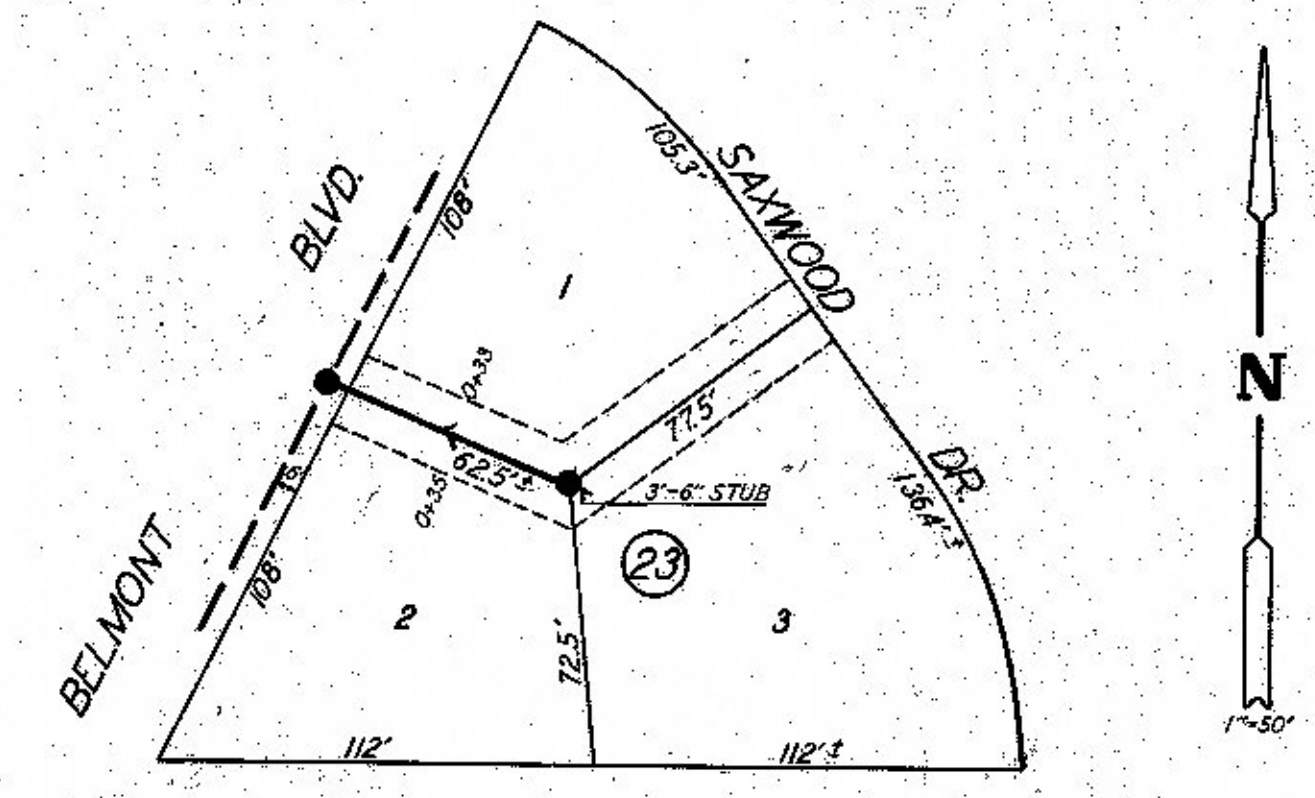

SANITARY SEWER - BLOCK 23 BELMONT ADD.

PROFILE  
 SURVEYED BY: \_\_\_\_\_  
 DATE: \_\_\_\_\_  
 NOTE BOOK NO. \_\_\_\_\_  
 PROFILE CHECKED BY: \_\_\_\_\_  
 DATE: \_\_\_\_\_  
 FIELD CHECKED BY: \_\_\_\_\_  
 DATE: \_\_\_\_\_

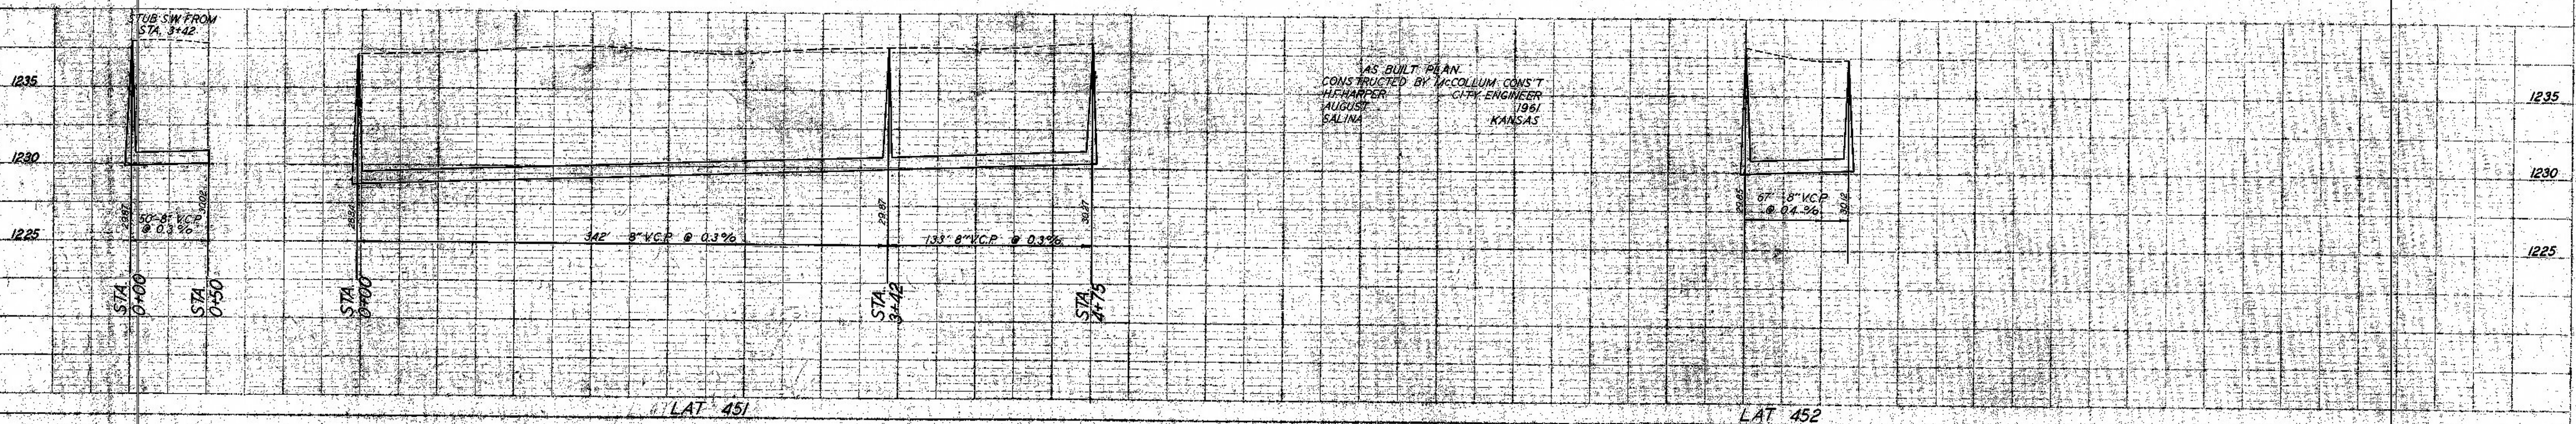

AS BUILT PLAN  
 CONSTRUCTED BY McCOLLUM CONST  
 HARPER CITY ENGINEER  
 AUGUST 1961  
 SALINA KANSAS