




PLAN  
 SURVIVED  
 PLOTTED  
 CHECKED  
 NO. OF WAY CHECKED  
 NO.

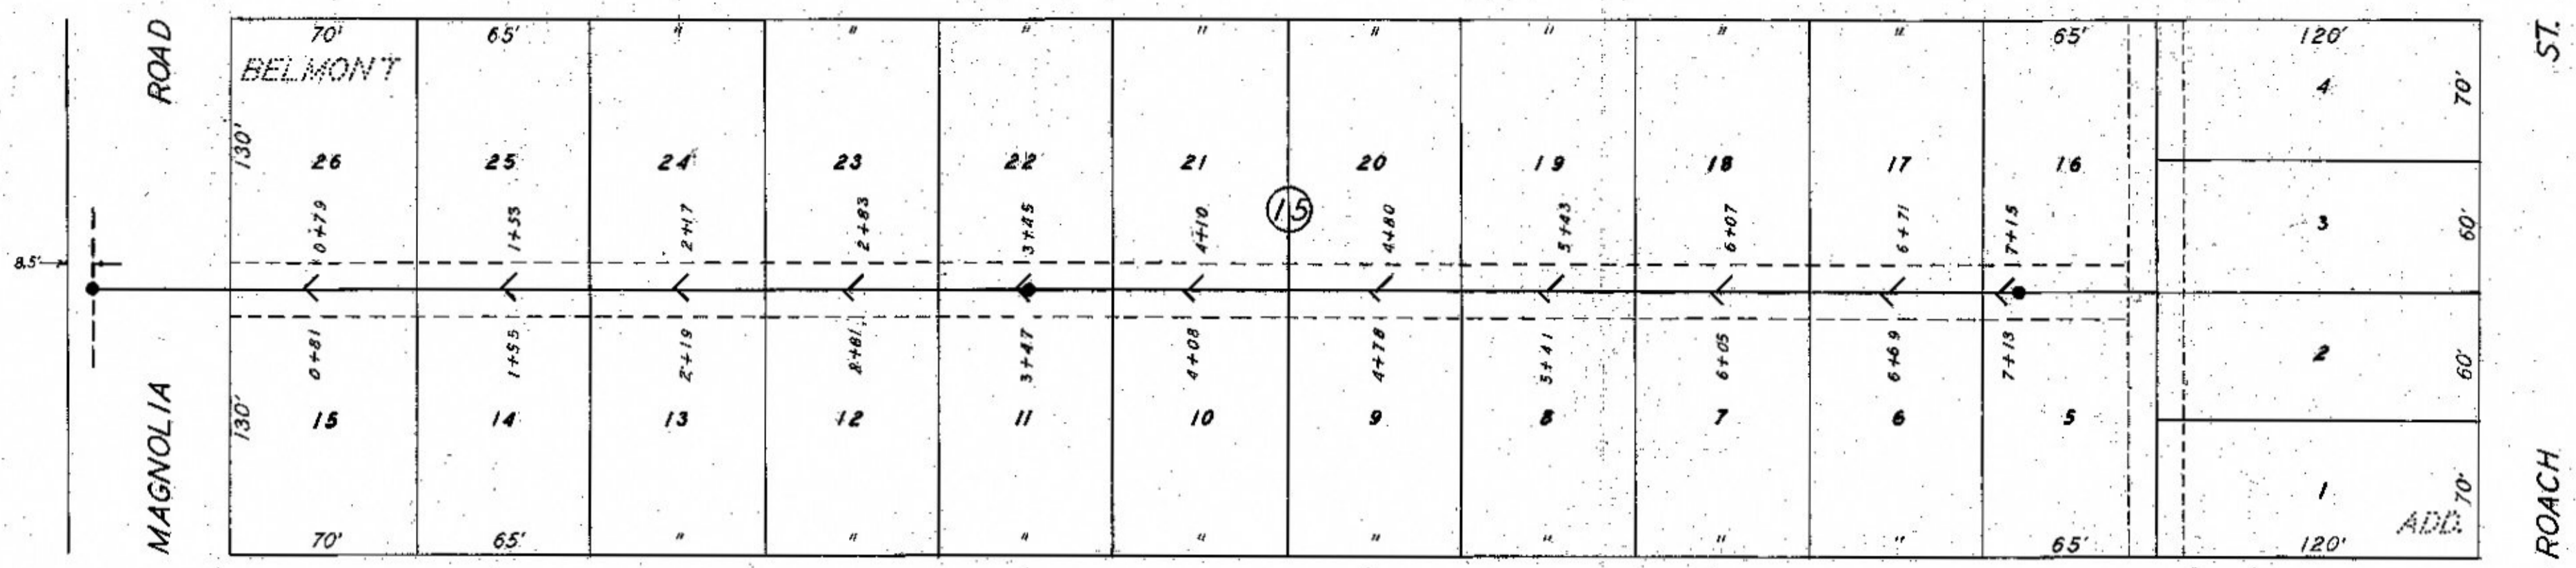


SANITARY SEWER R/W OF BRENTWOOD - MAGNOLIA TO ROACH

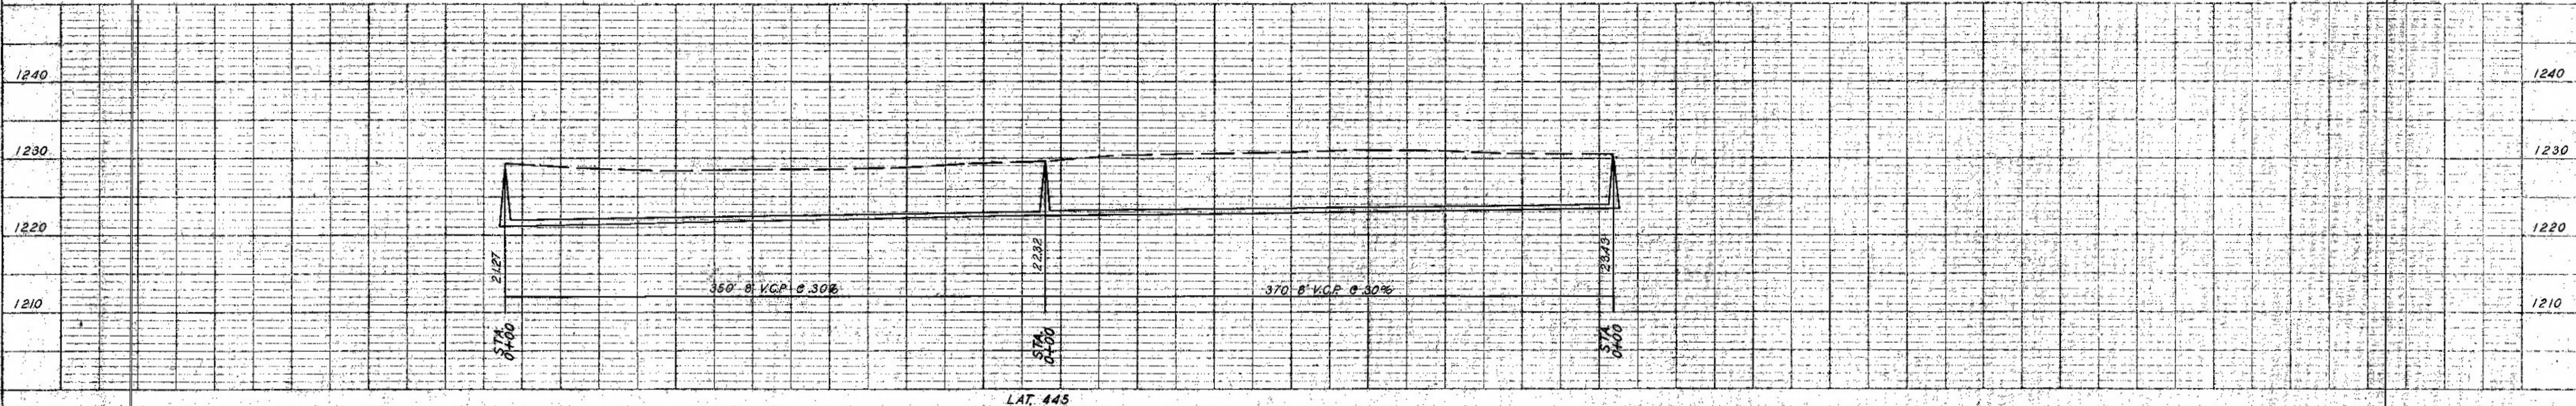

PROFILE  
 SURVIVED  
 PLOTTED  
 CHECKED  
 NO. OF WAY CHECKED  
 NO.

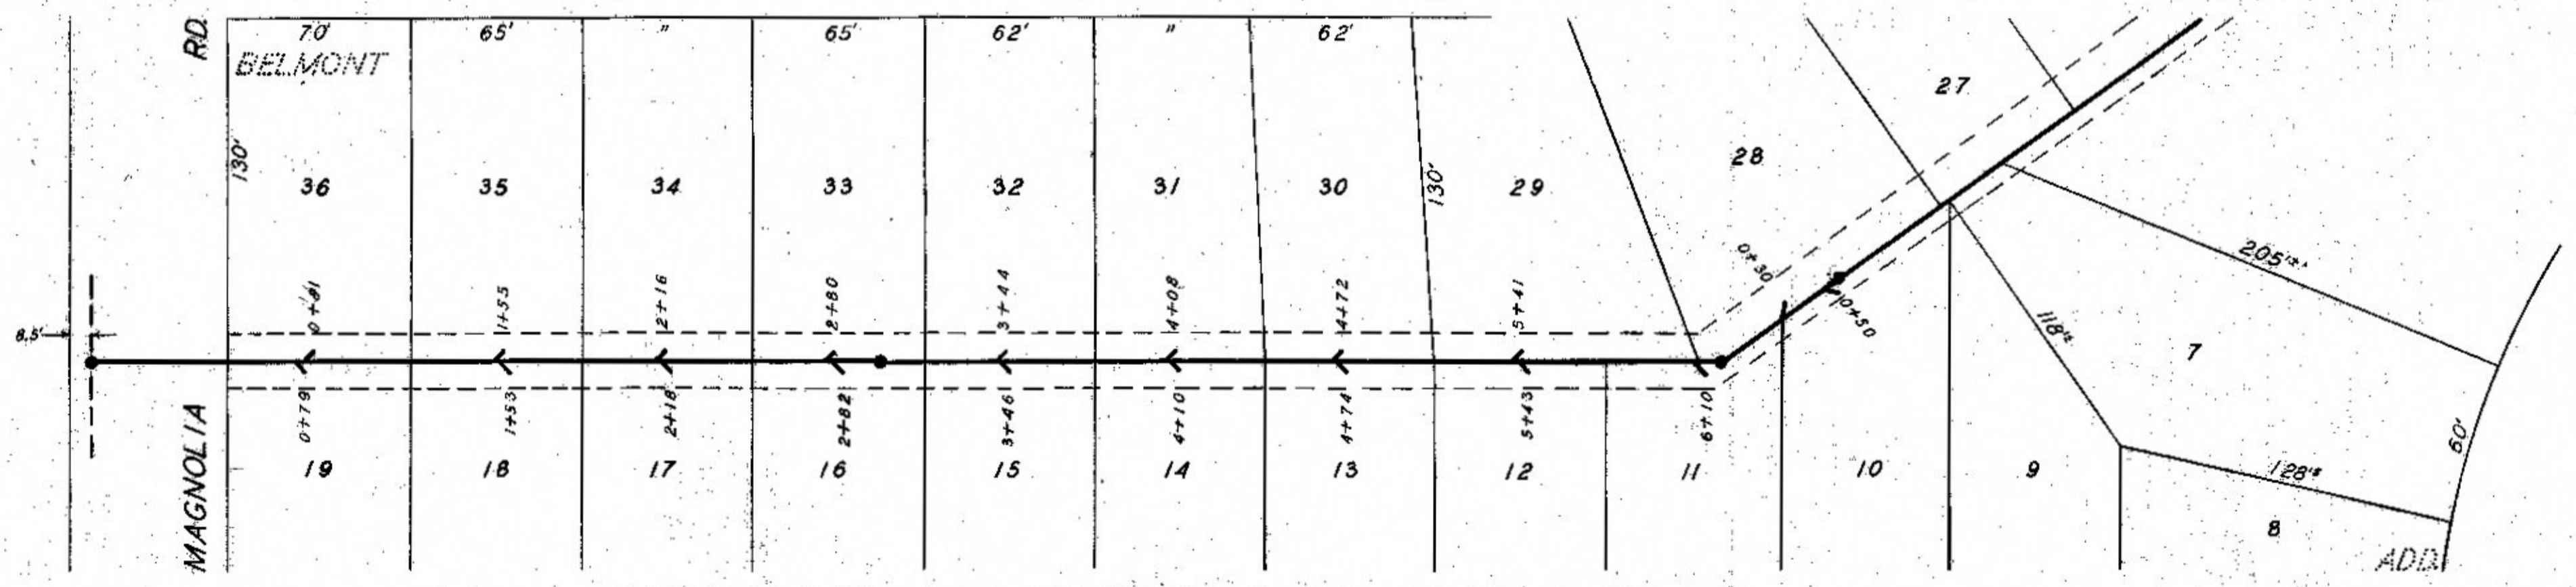

SANITARY SEWER R/W OF EDWARD MAGNOLIA TO LOT 10 BLK 14

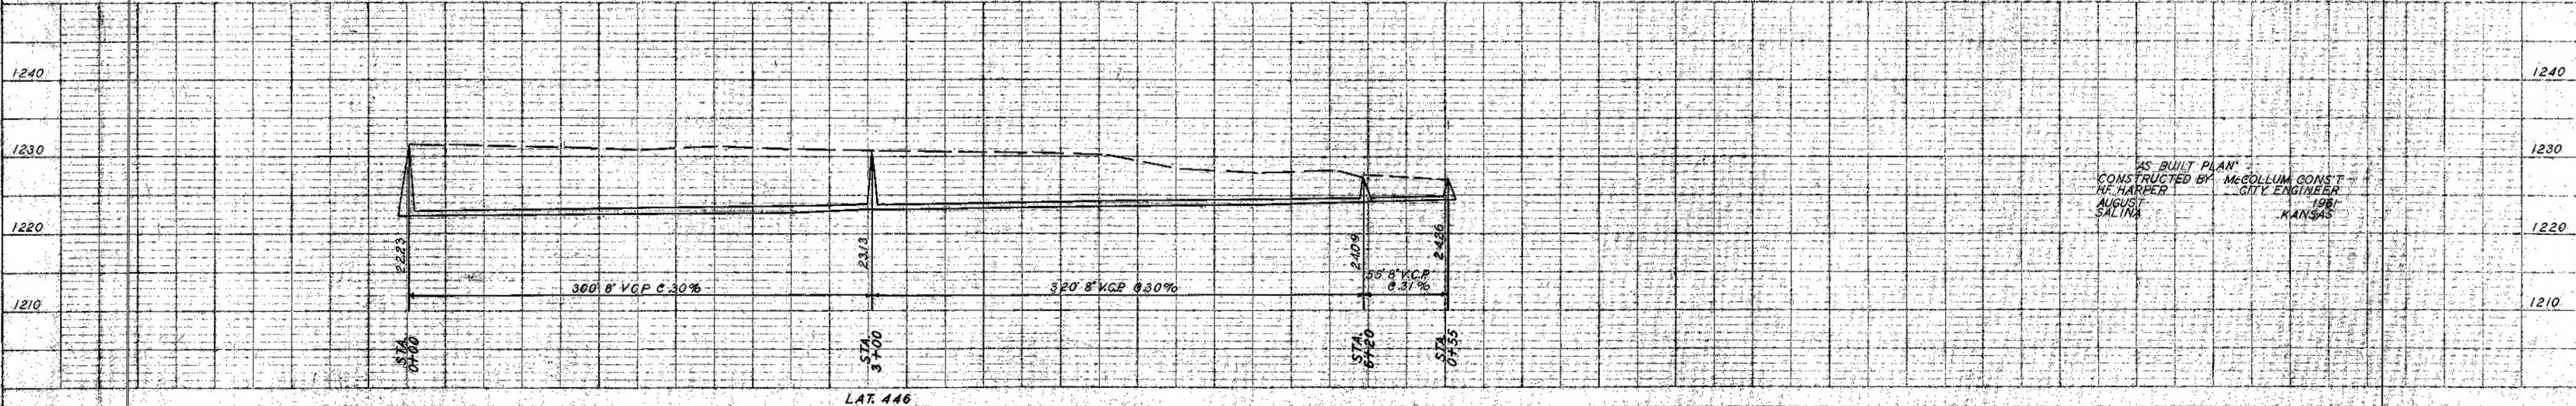

AS BUILT PLAN  
 CONSTRUCTED BY  
 H.F. HARPER  
 AUGUST  
 SALINA  
 McCOLLUM CONST  
 CITY ENGINEER  
 1906  
 KANSAS