

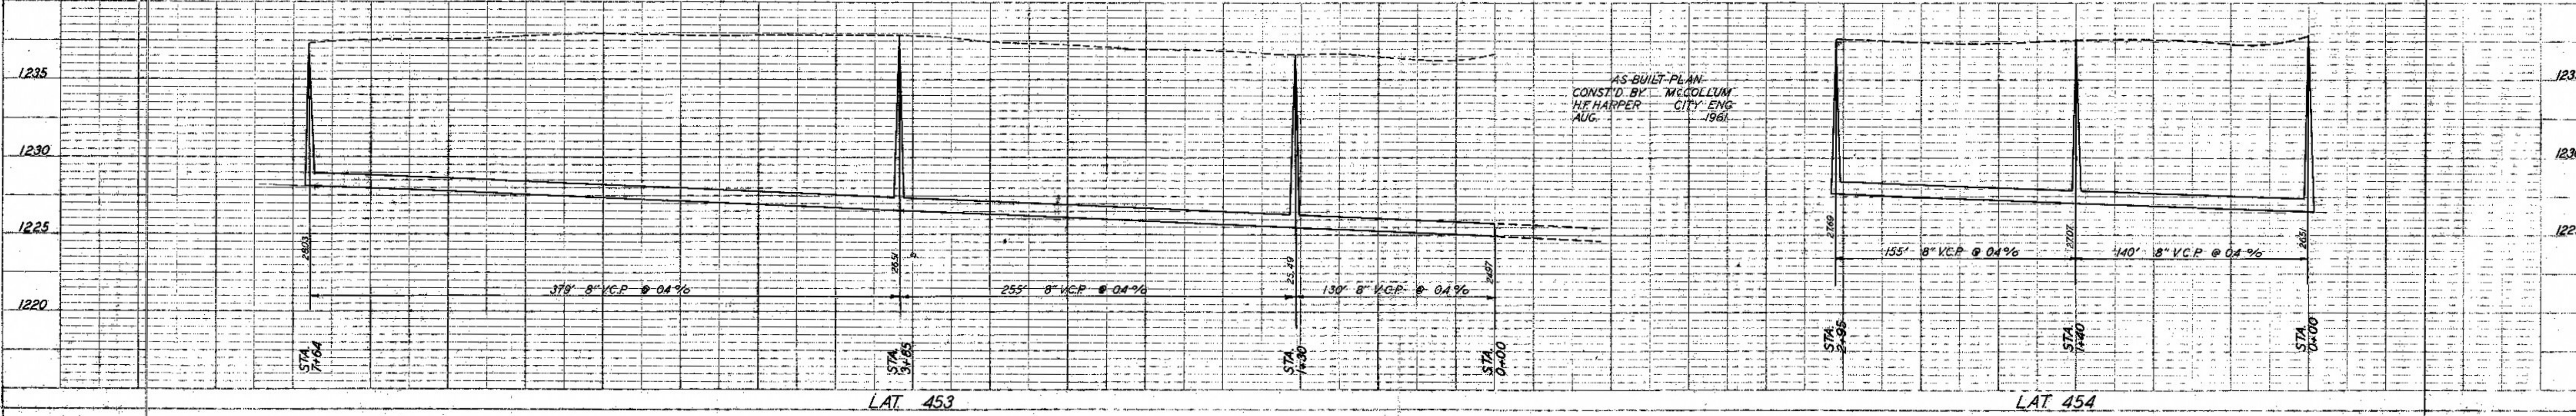


DATE: _____
 BY: _____
 CHECKED: _____
 IN CHARGE: _____

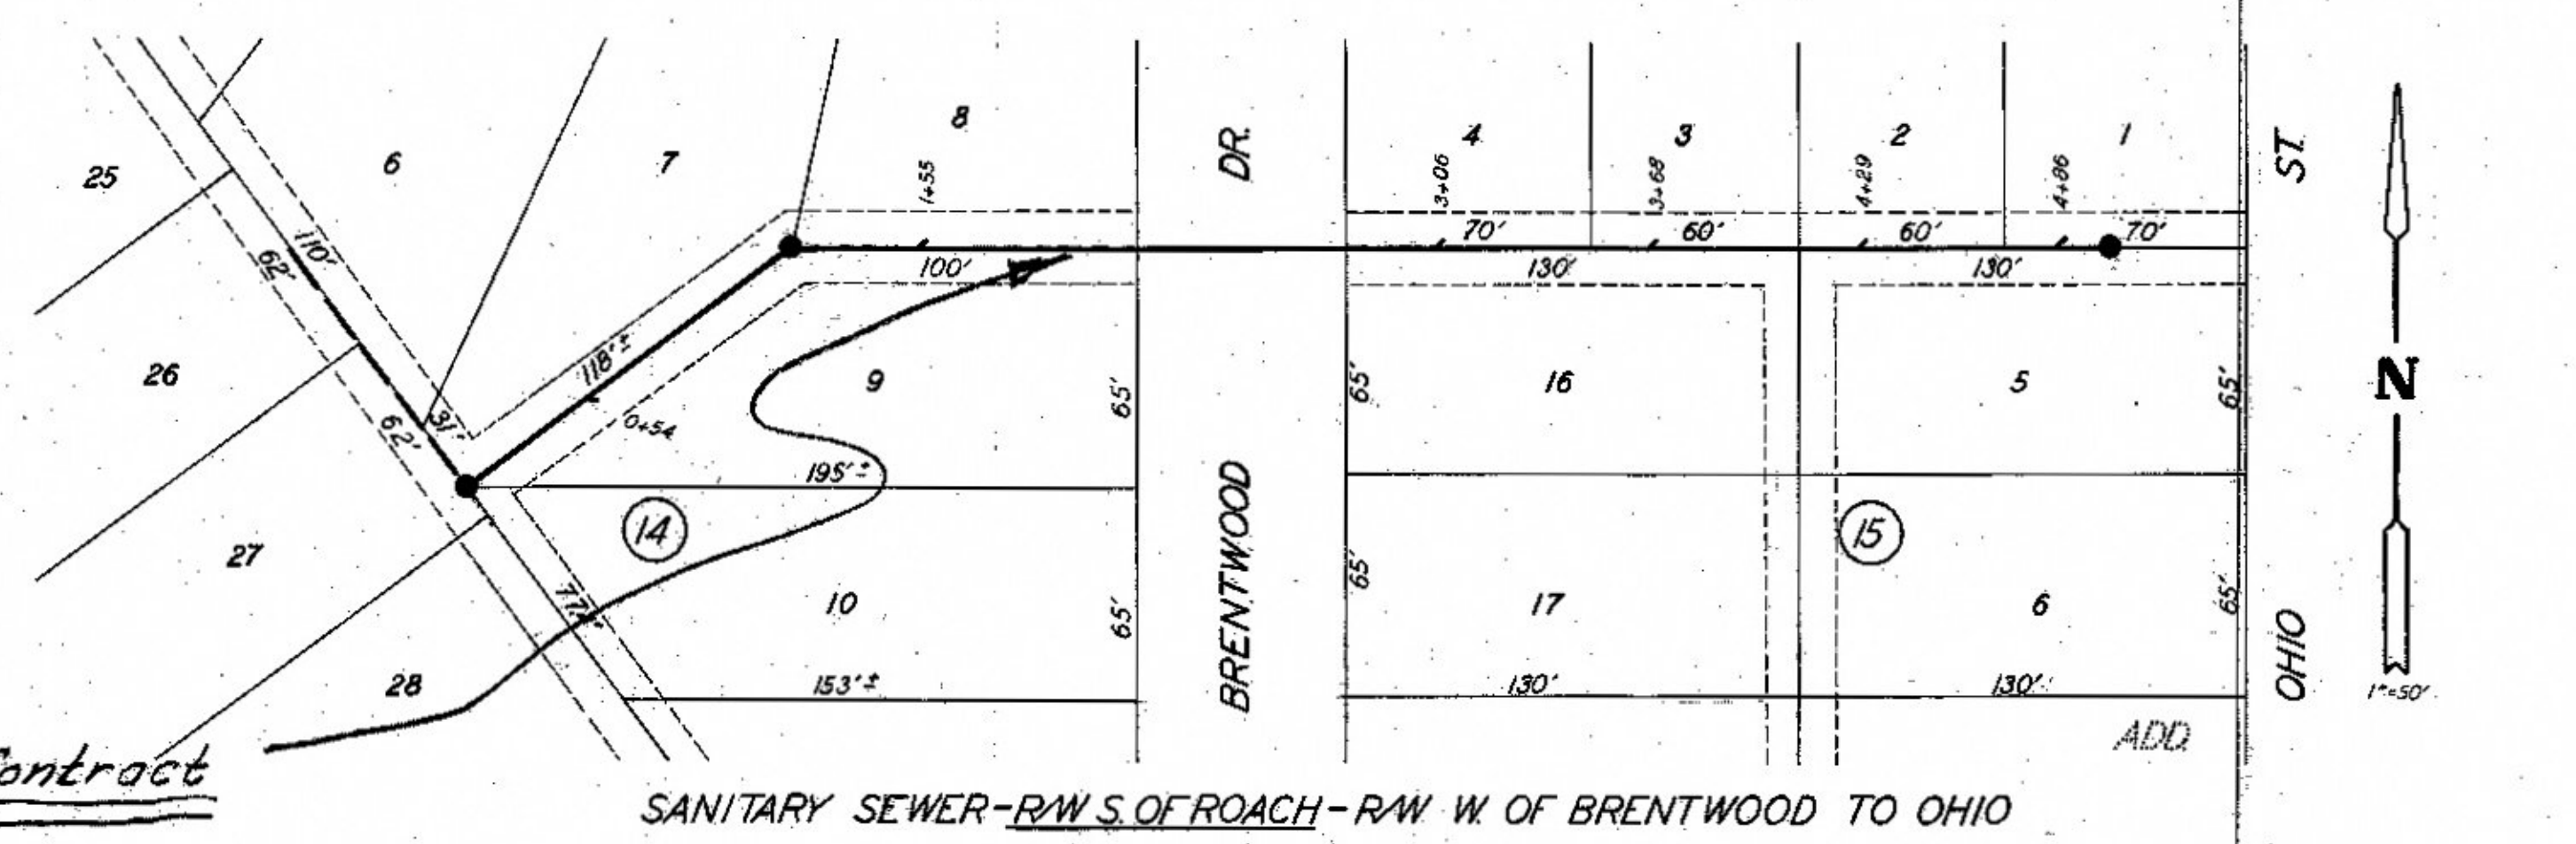

DATE: _____
 BY: _____
 CHECKED: _____
 IN CHARGE: _____

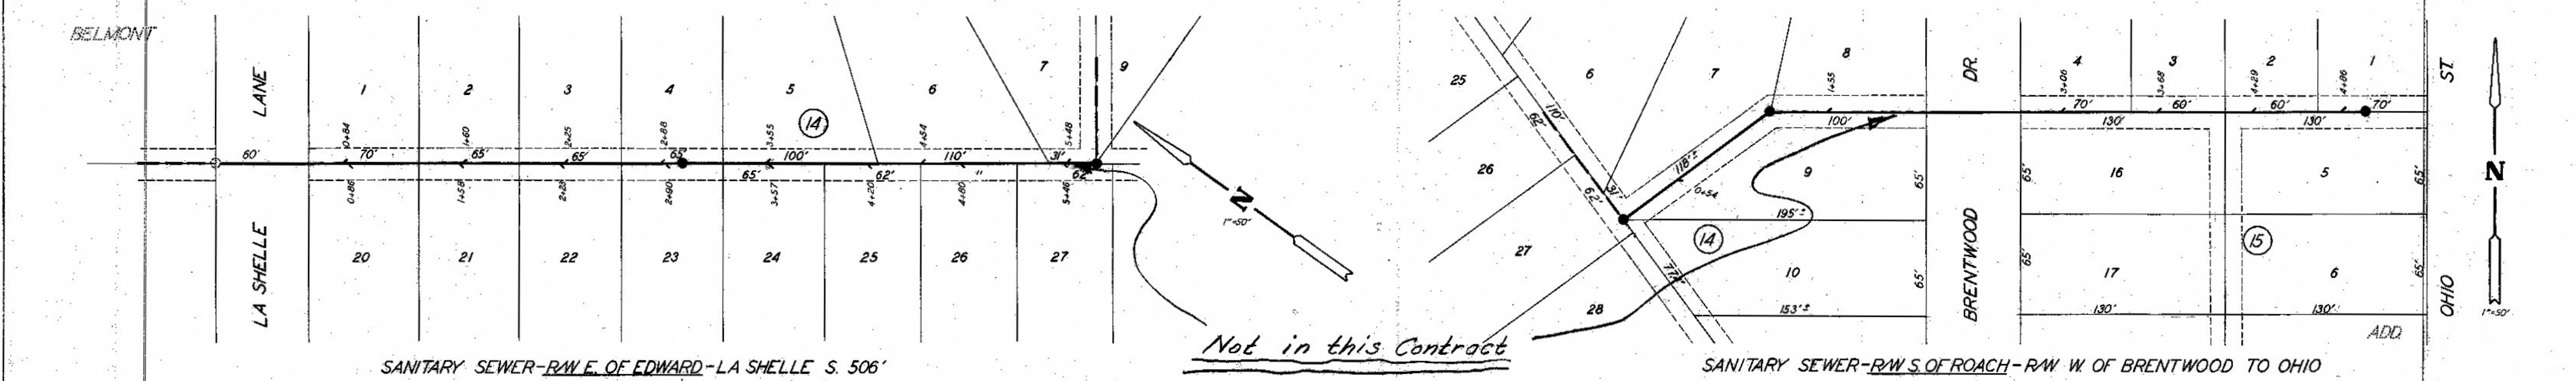

Not in this Contract

