



PLAN
 NO. 1
 DATE 1/1/50
 BY J. H. H. [unclear]
 CHECKED [unclear]
 SUPERVISOR [unclear]
 NOTE: BOOK ALIGNED CHECKED
 ST. OF WAY CHECKED

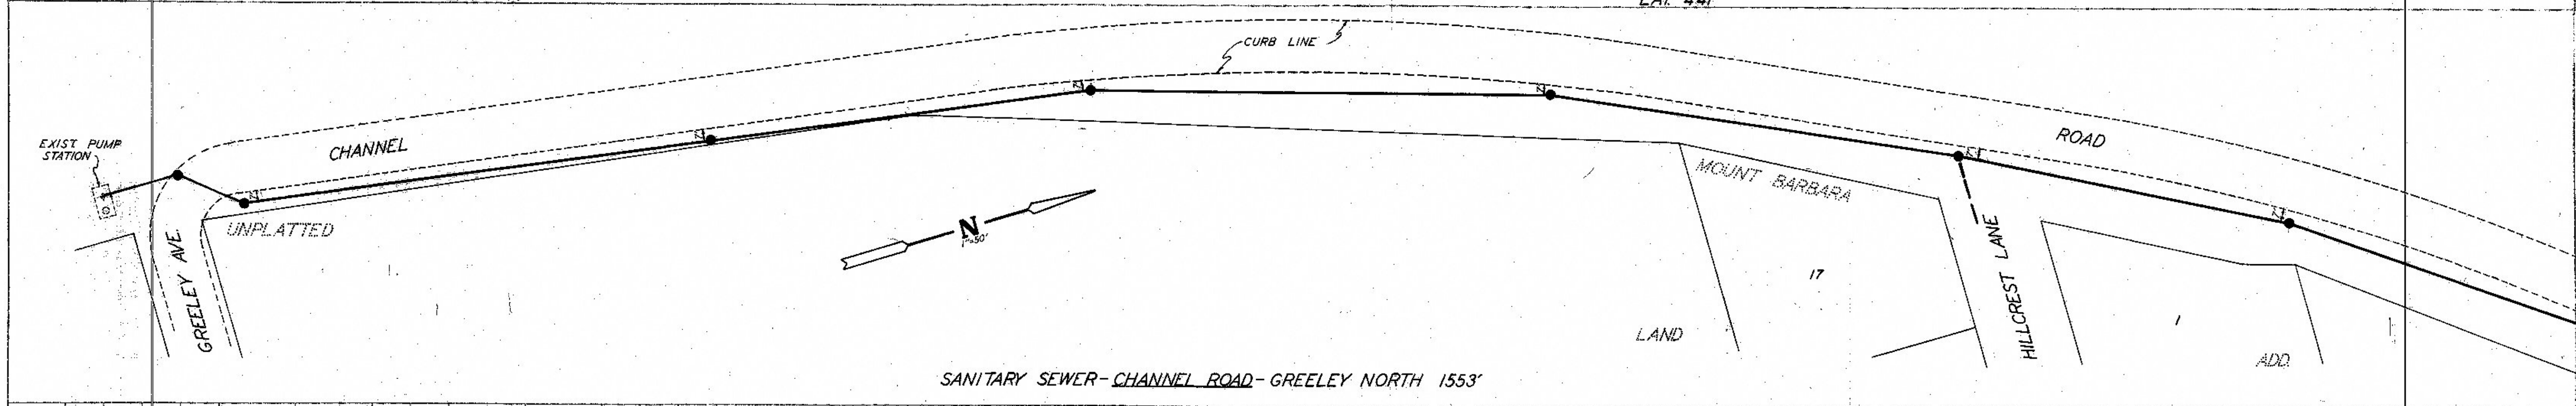

PROFILE
 NO. 1
 DATE 1/1/50
 BY J. H. H. [unclear]
 CHECKED [unclear]
 SUPERVISOR [unclear]
 NOTE: BOOK ALIGNED CHECKED
 ST. OF WAY CHECKED

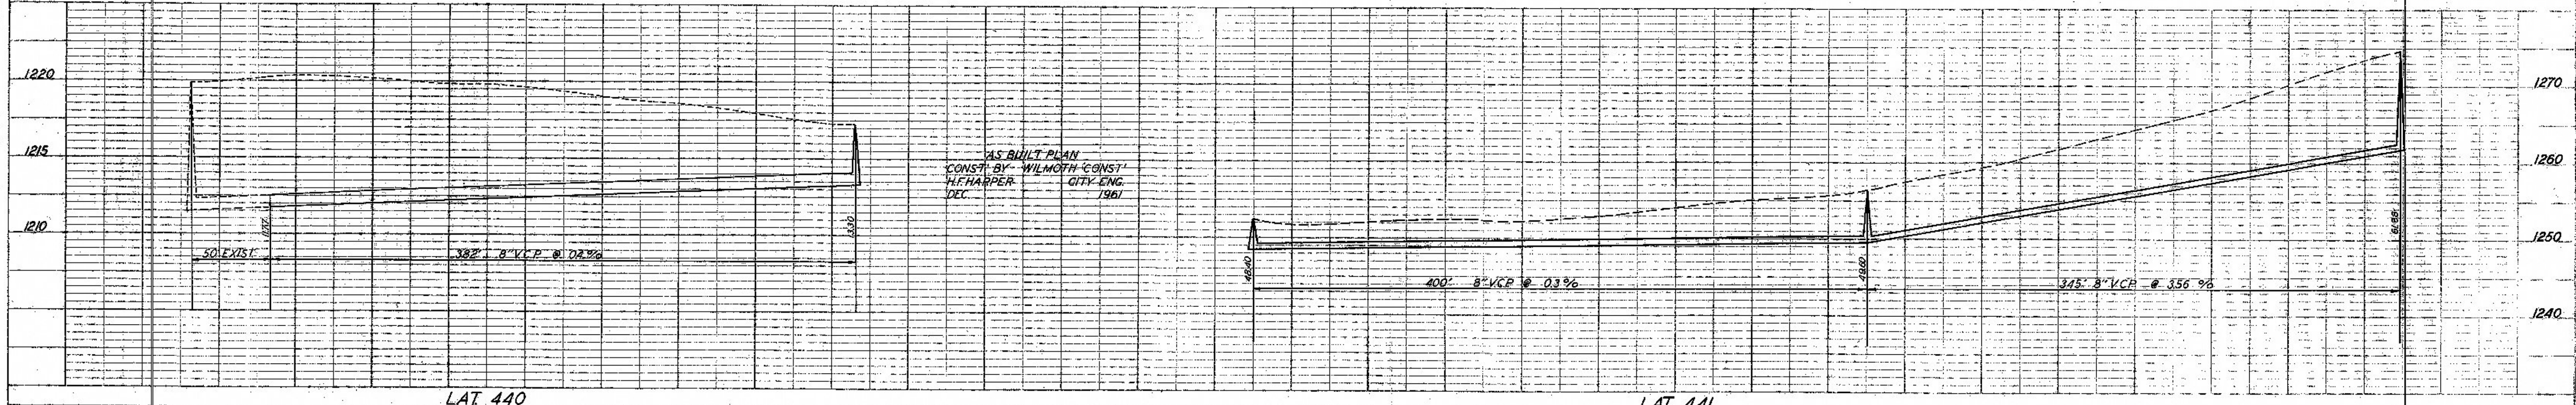