

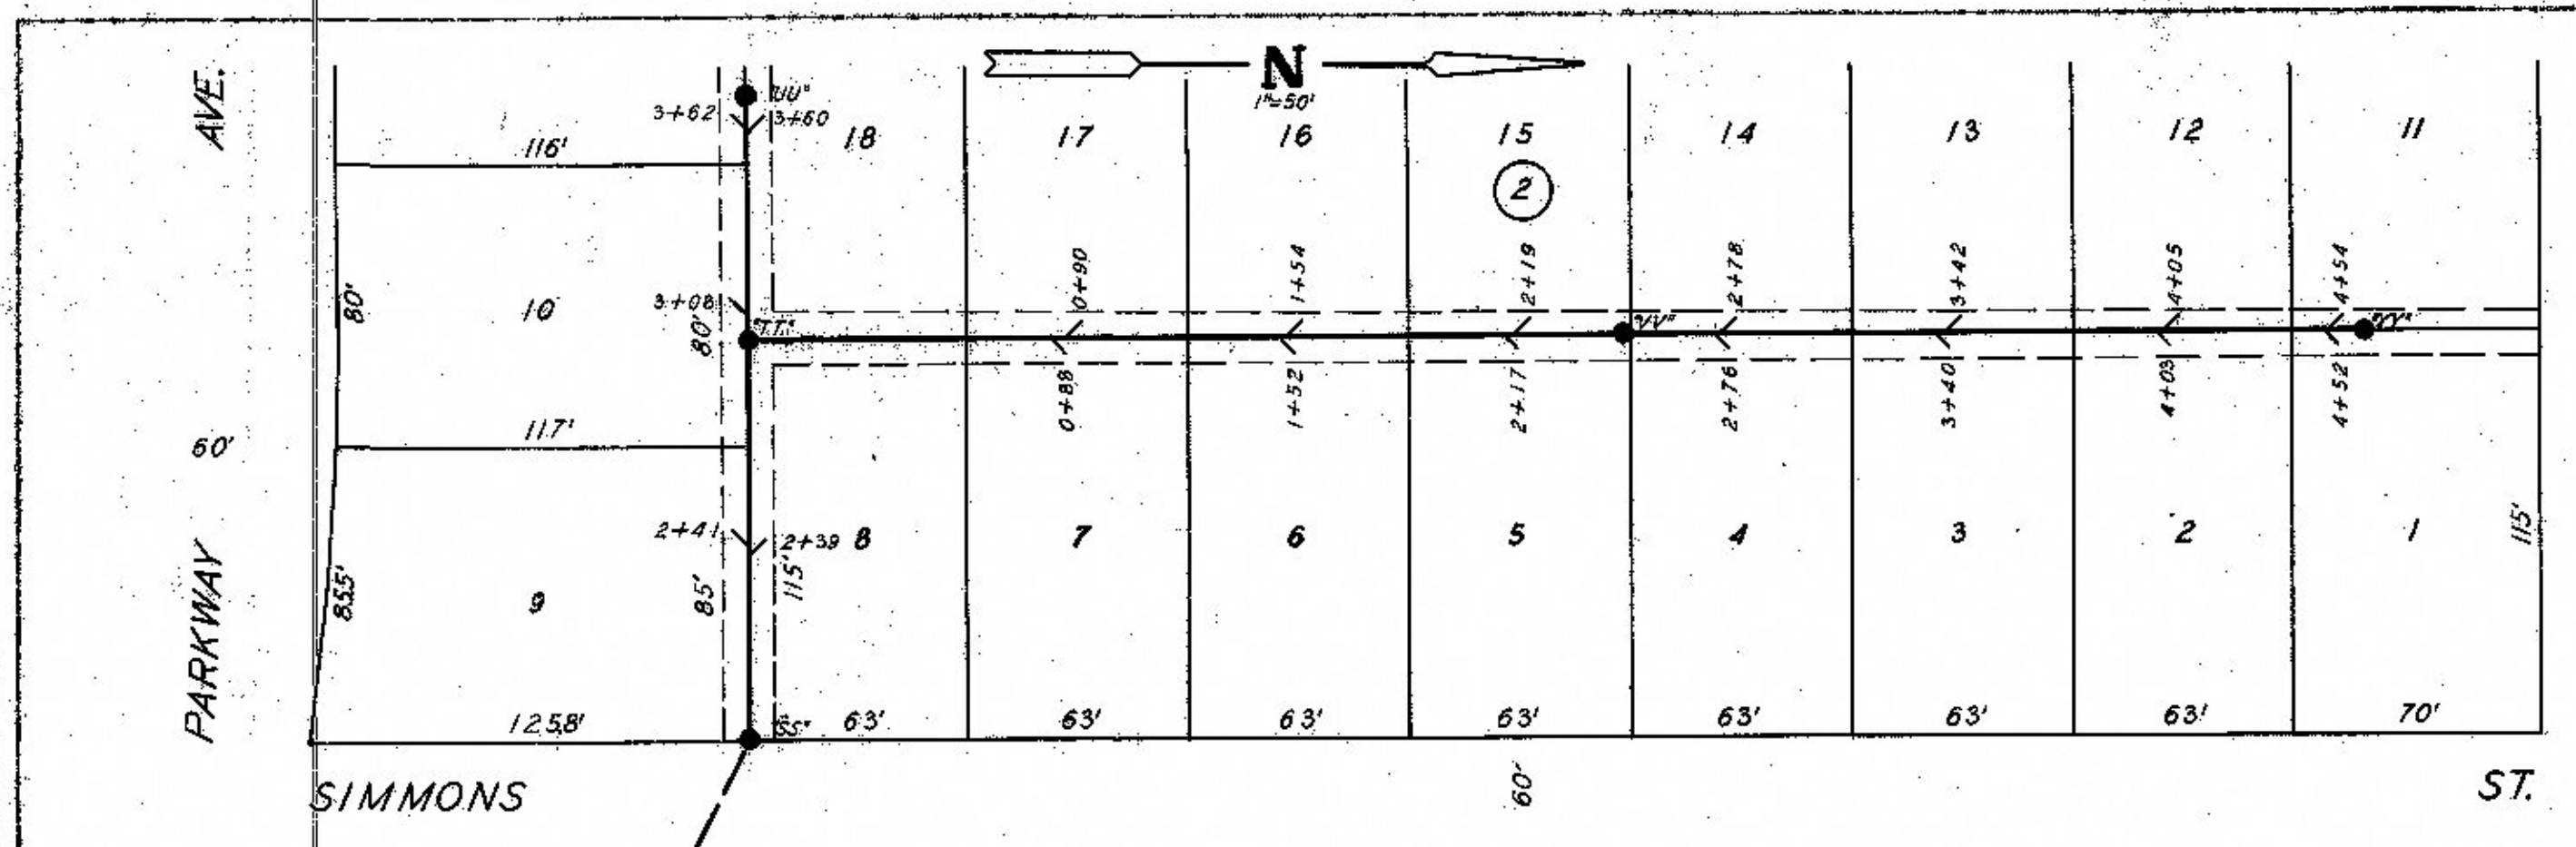


PLAN	DATE
SURVEYED	
DESIGNED	
CHECKED	
BY	
NO.	



PROFILE	DATE
SURVEYED	
DESIGNED	
CHECKED	
BY	
NO.	

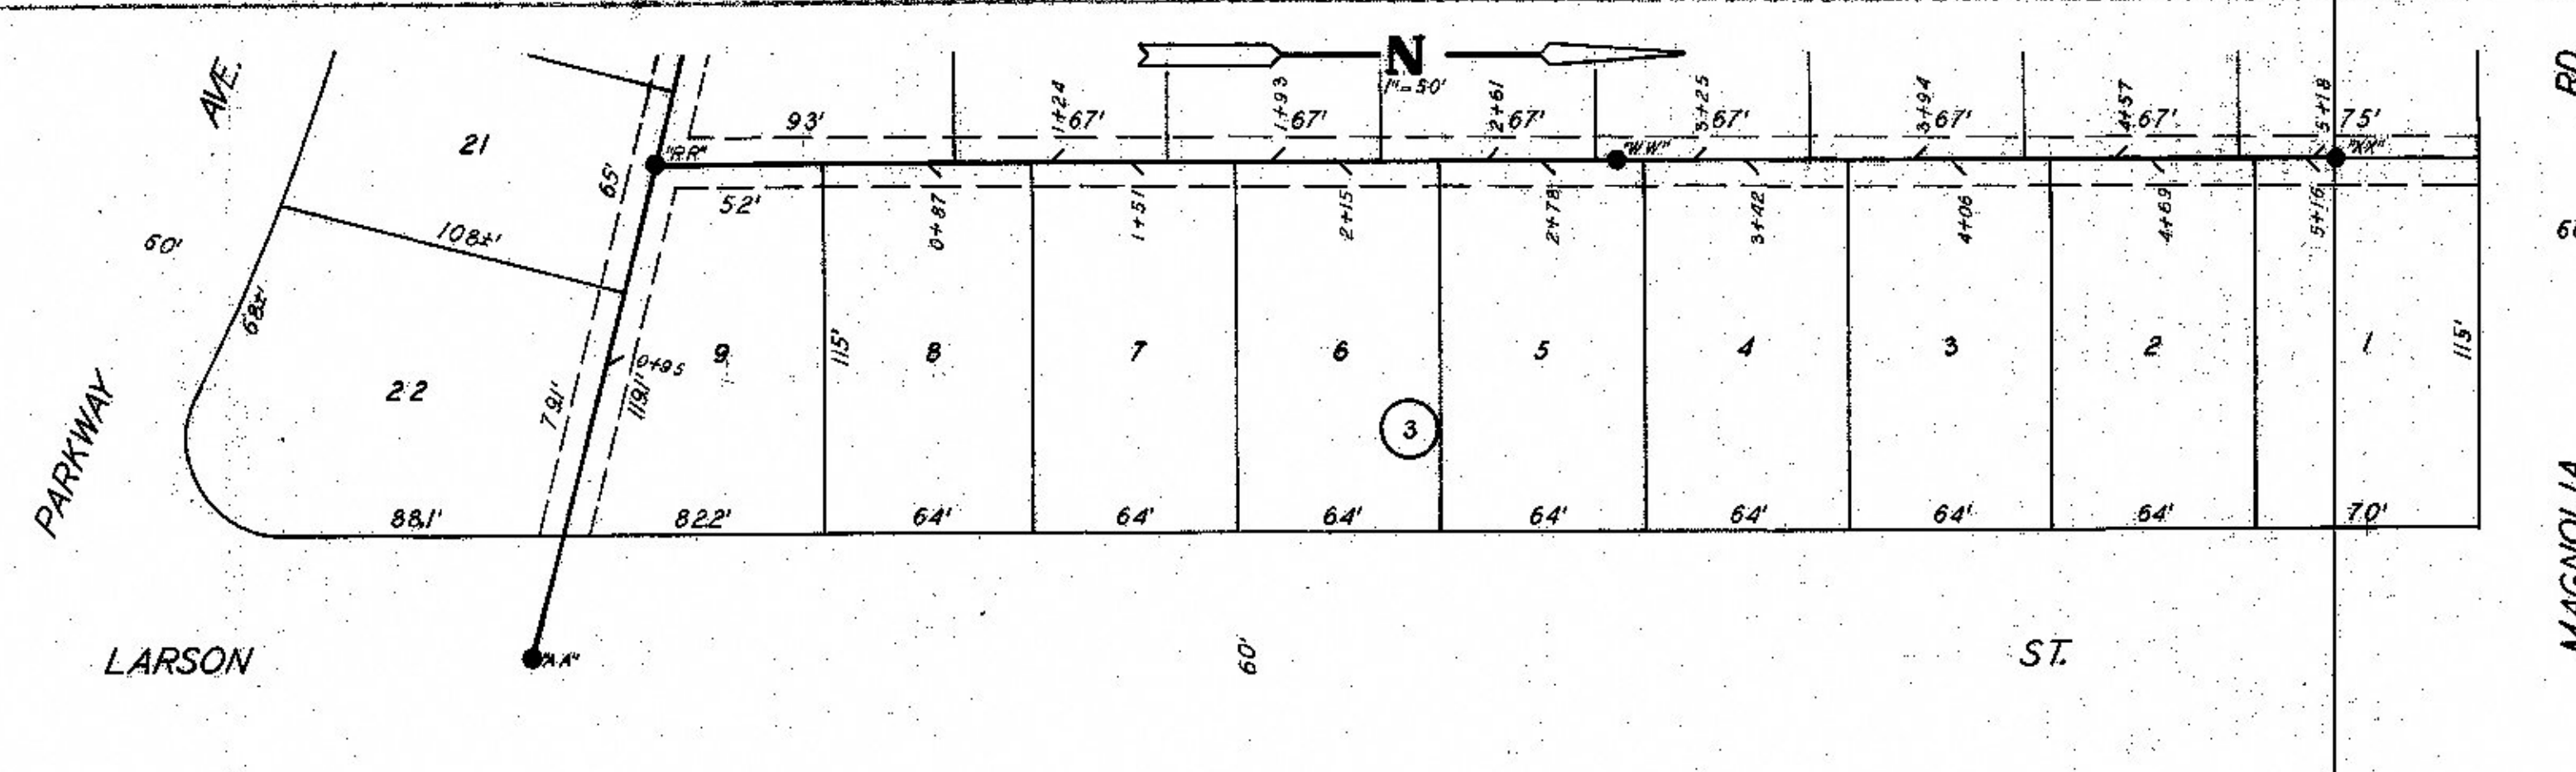



SANITARY SEWER FOR BLOCK 2 KEY ACRES ADD

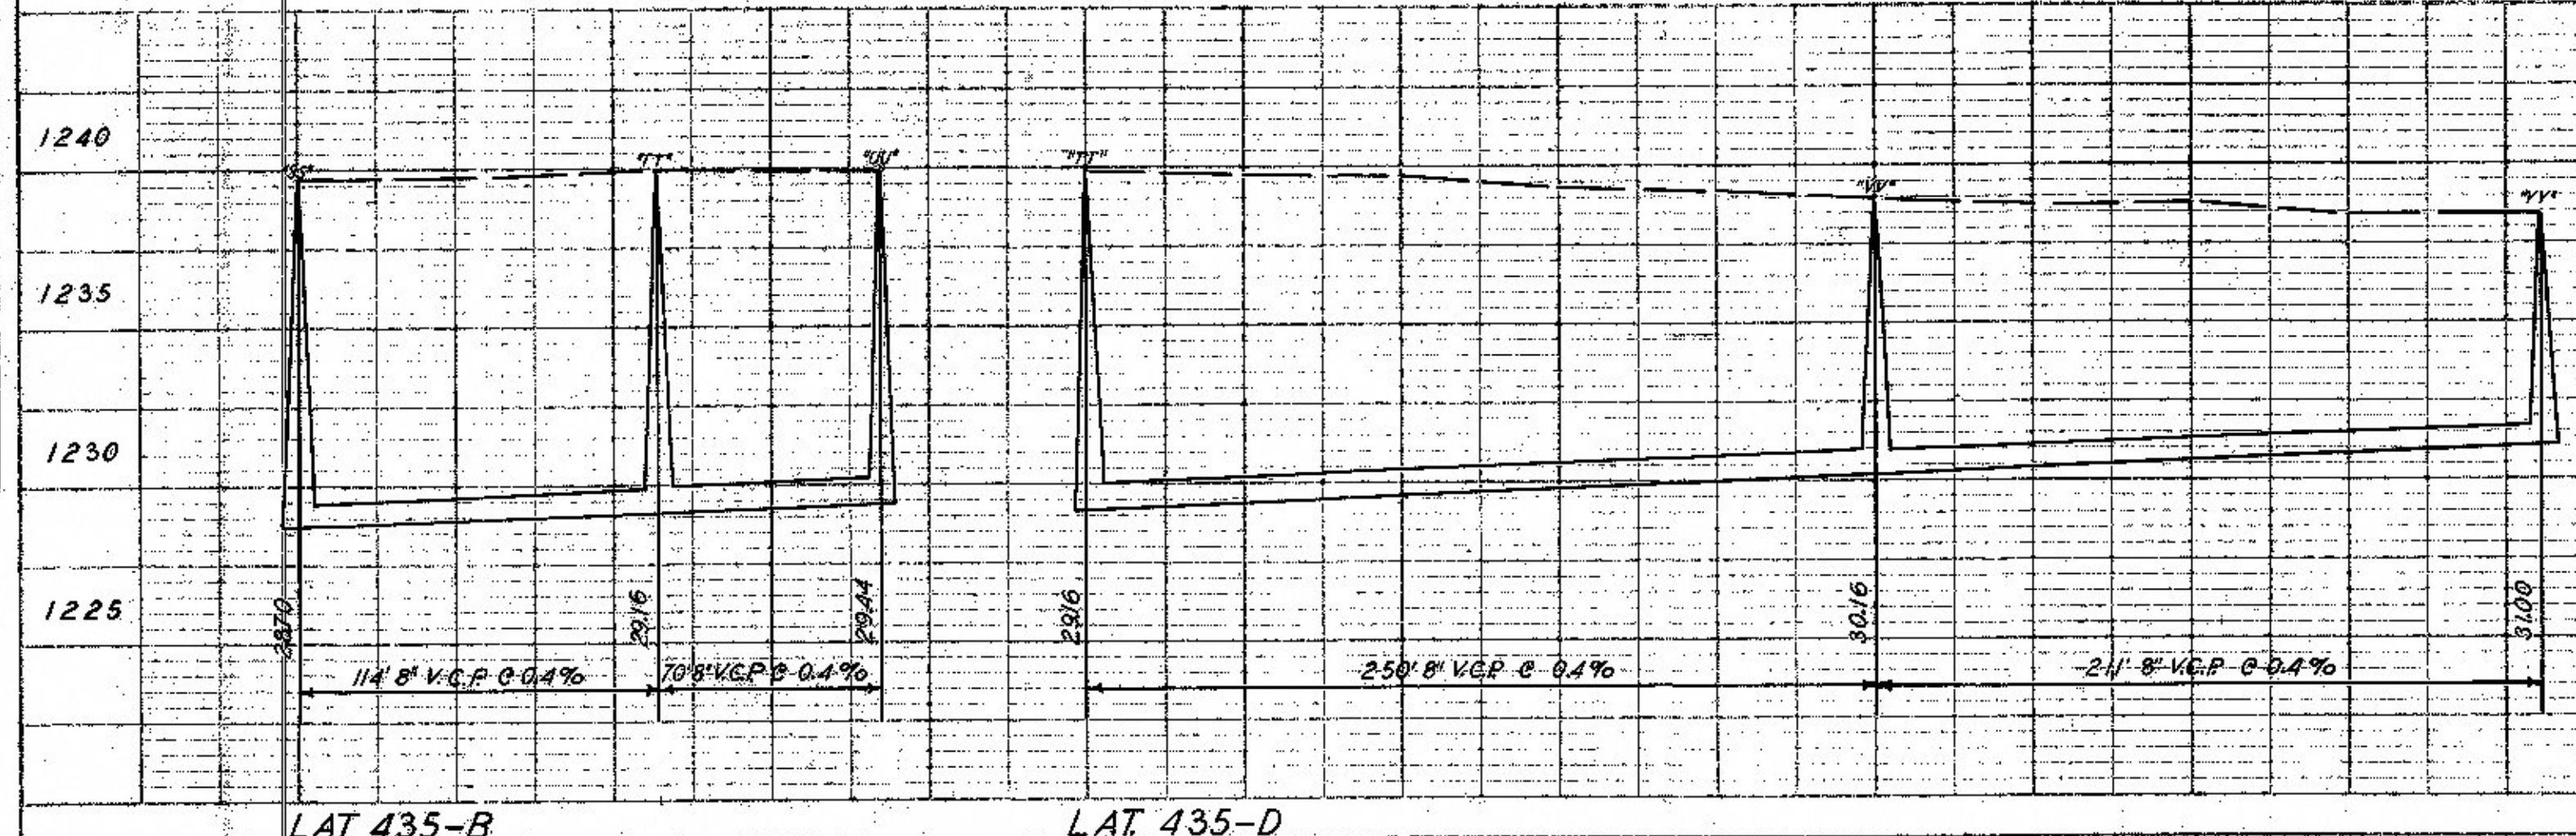



SANITARY SEWER FOR BLOCK 3 KEY ACRES ADD

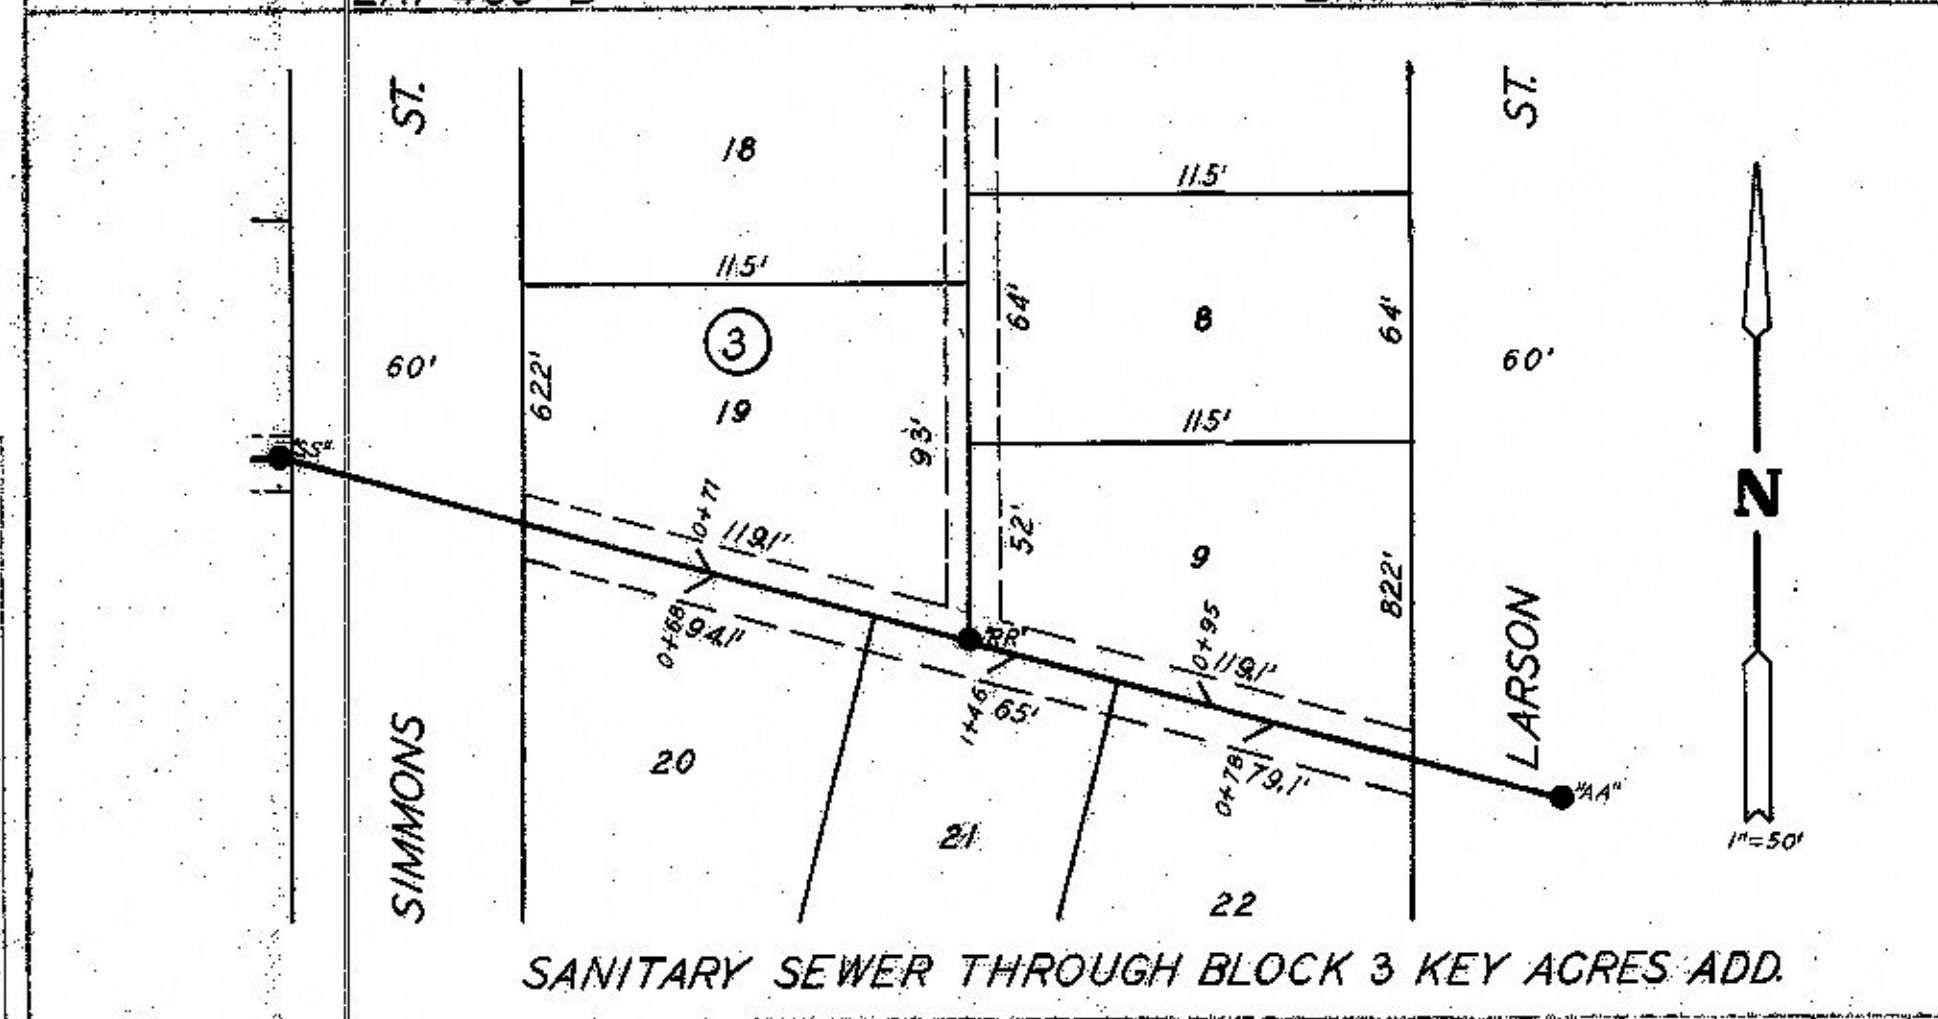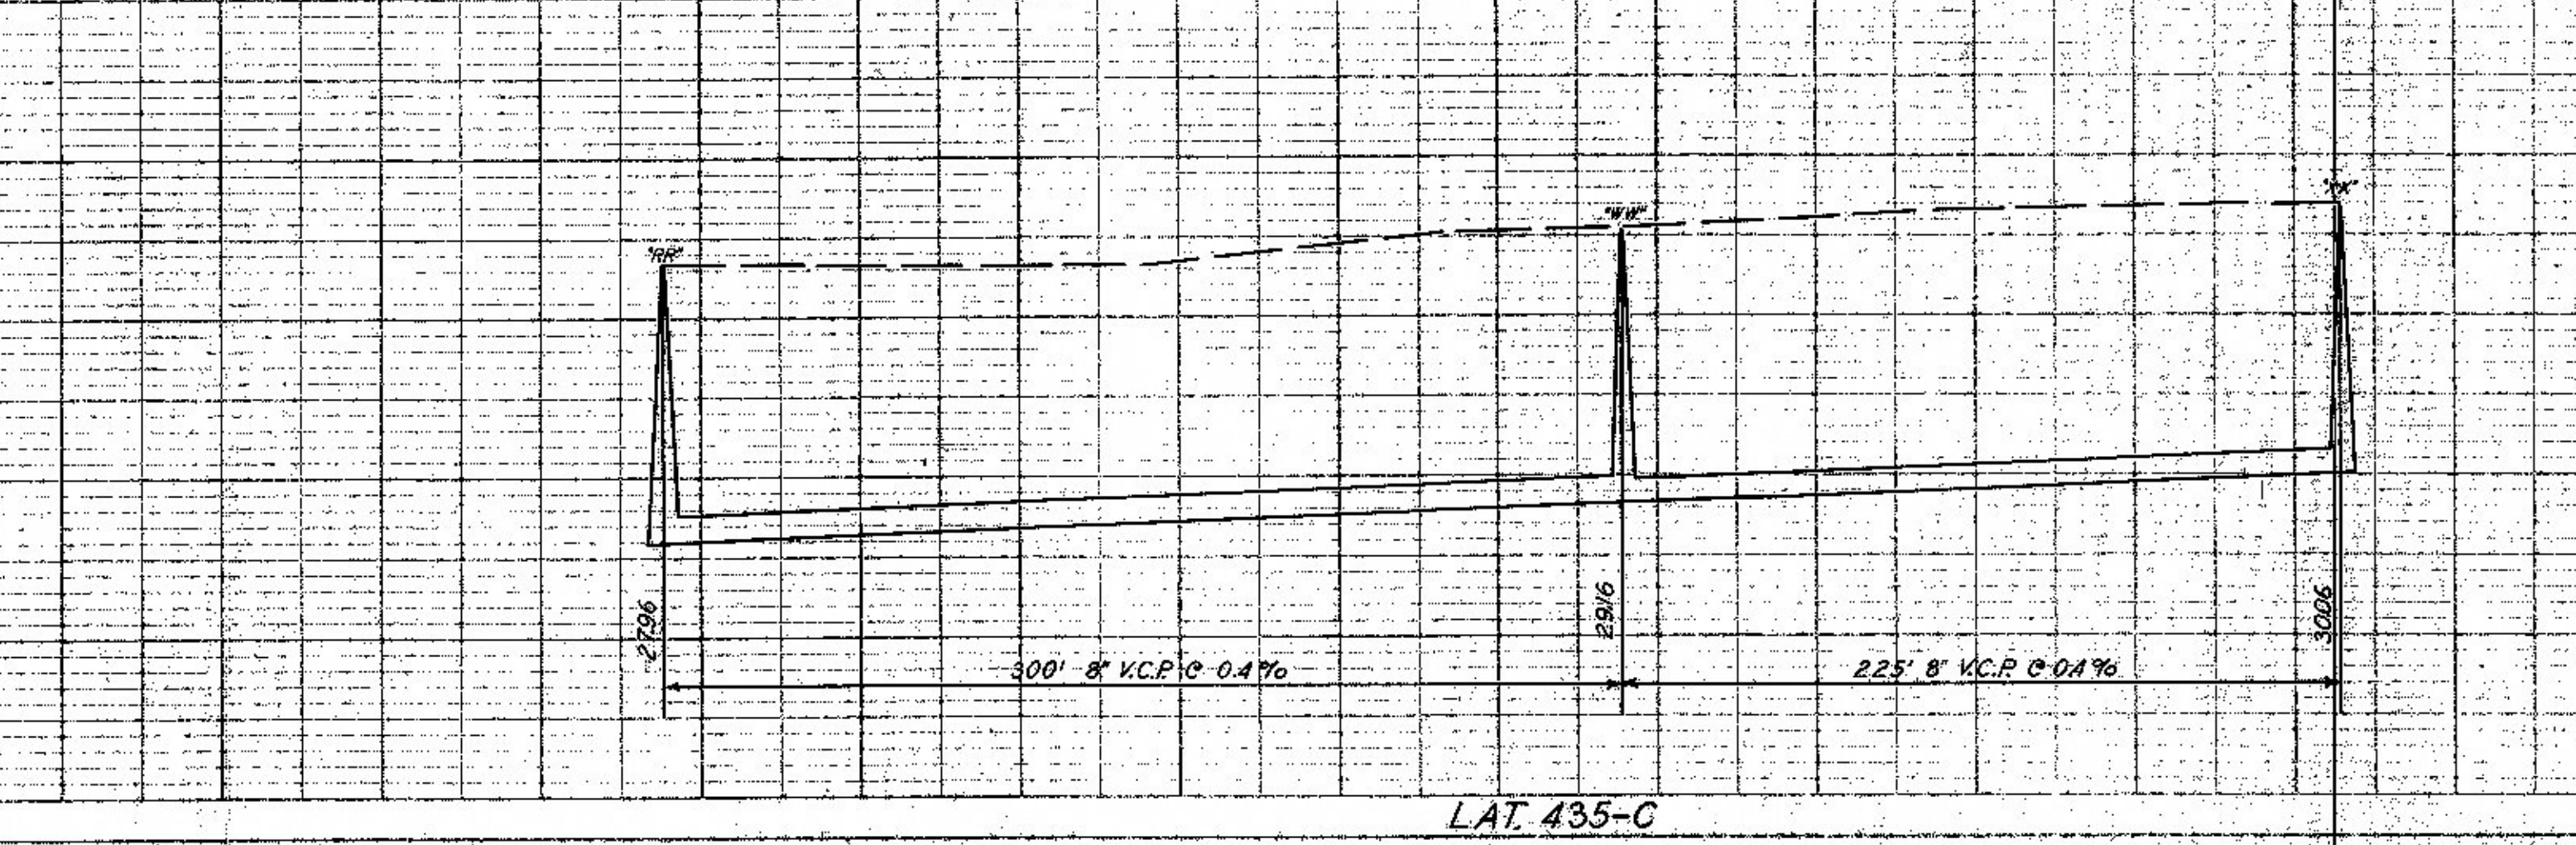


SANITARY SEWER THROUGH BLOCK 3 KEY ACRES ADD

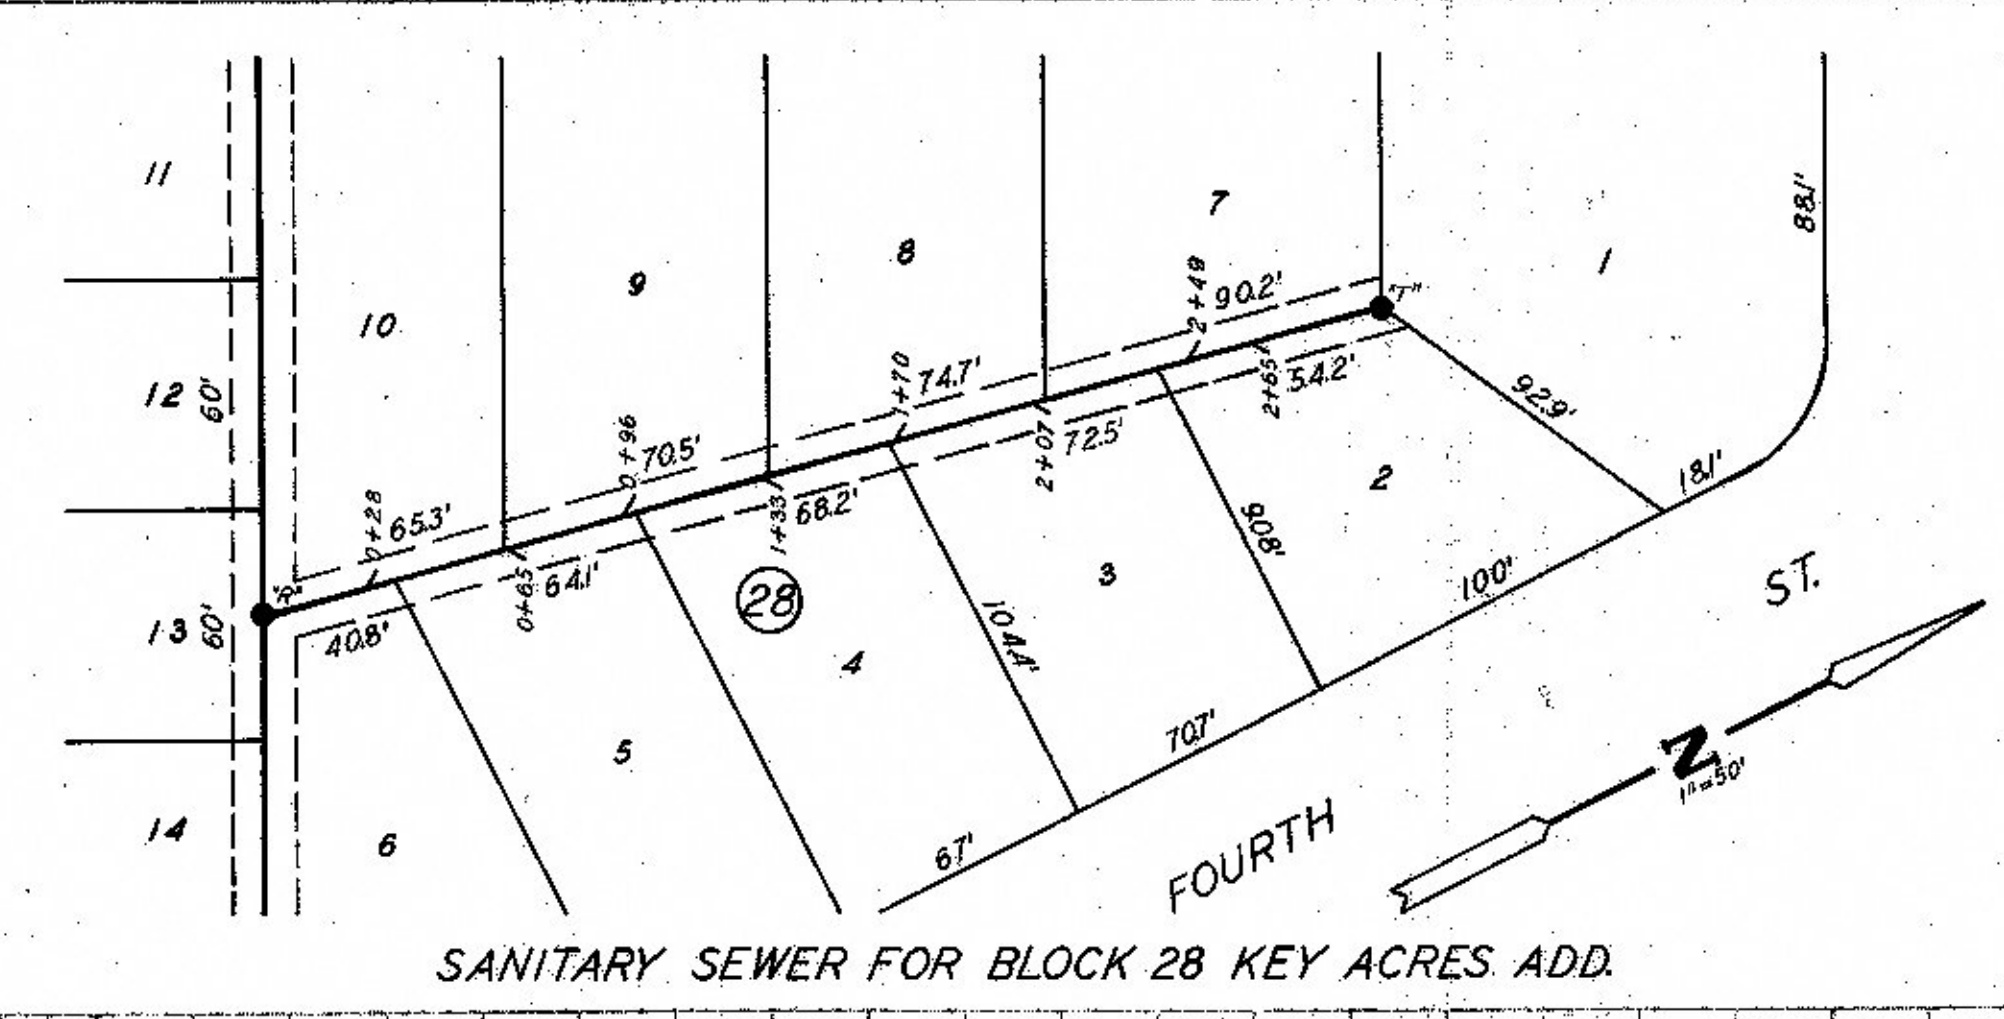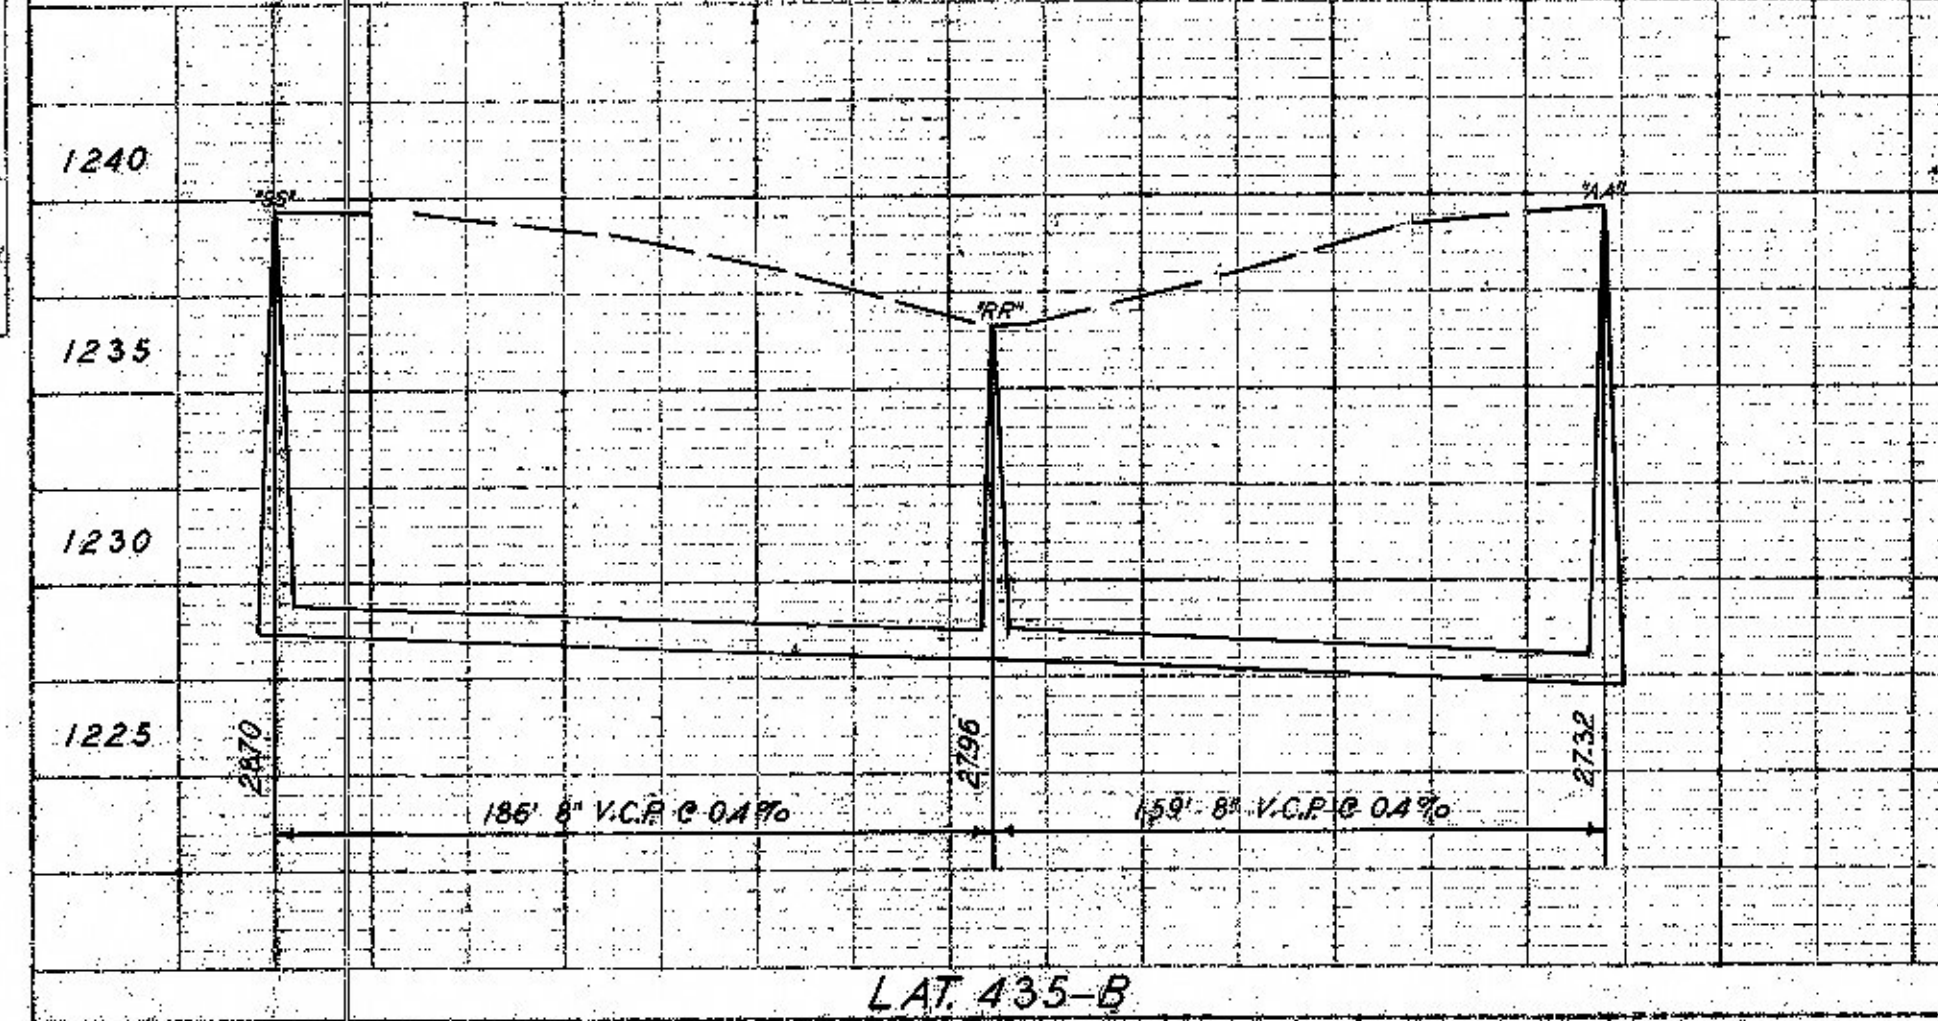

SANITARY SEWER FOR BLOCK 28 KEY ACRES ADD

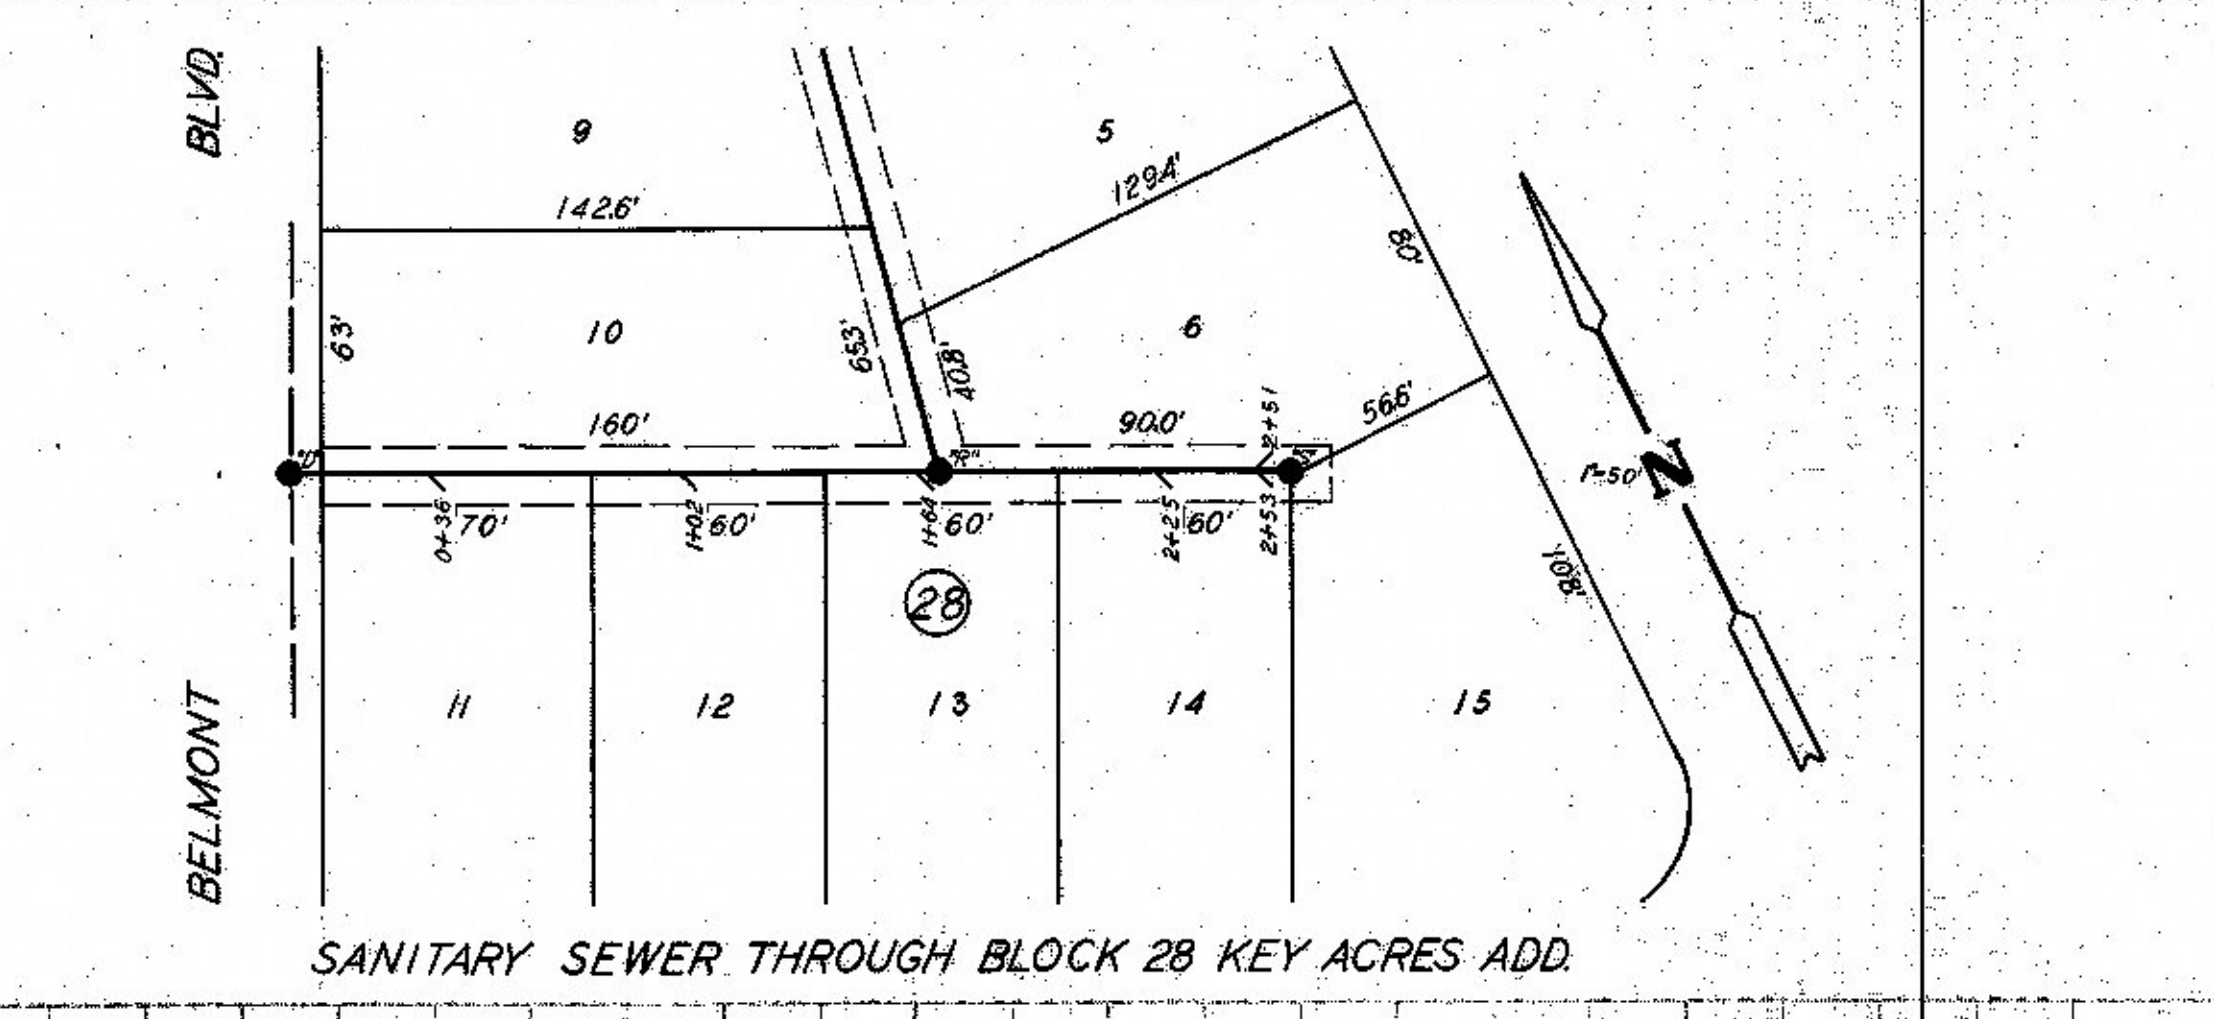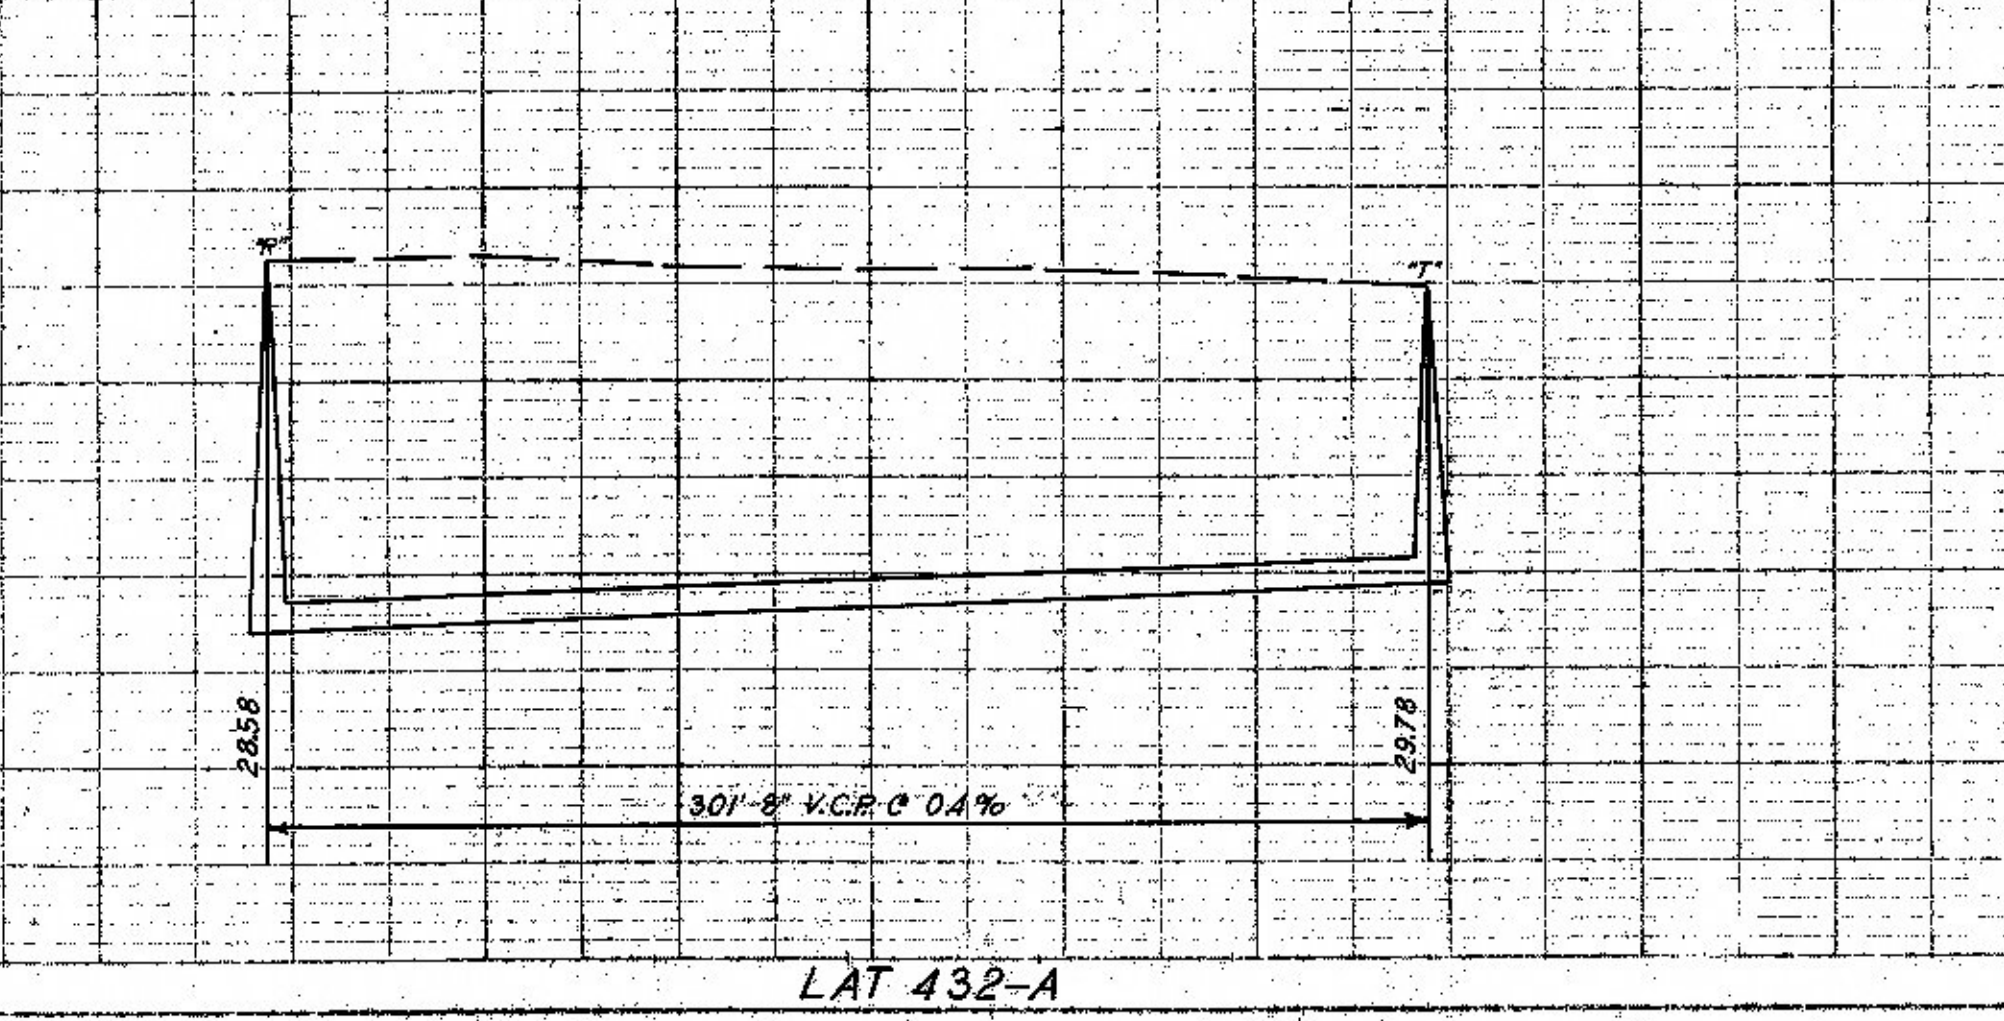

SANITARY SEWER THROUGH BLOCK 28 KEY ACRES ADD

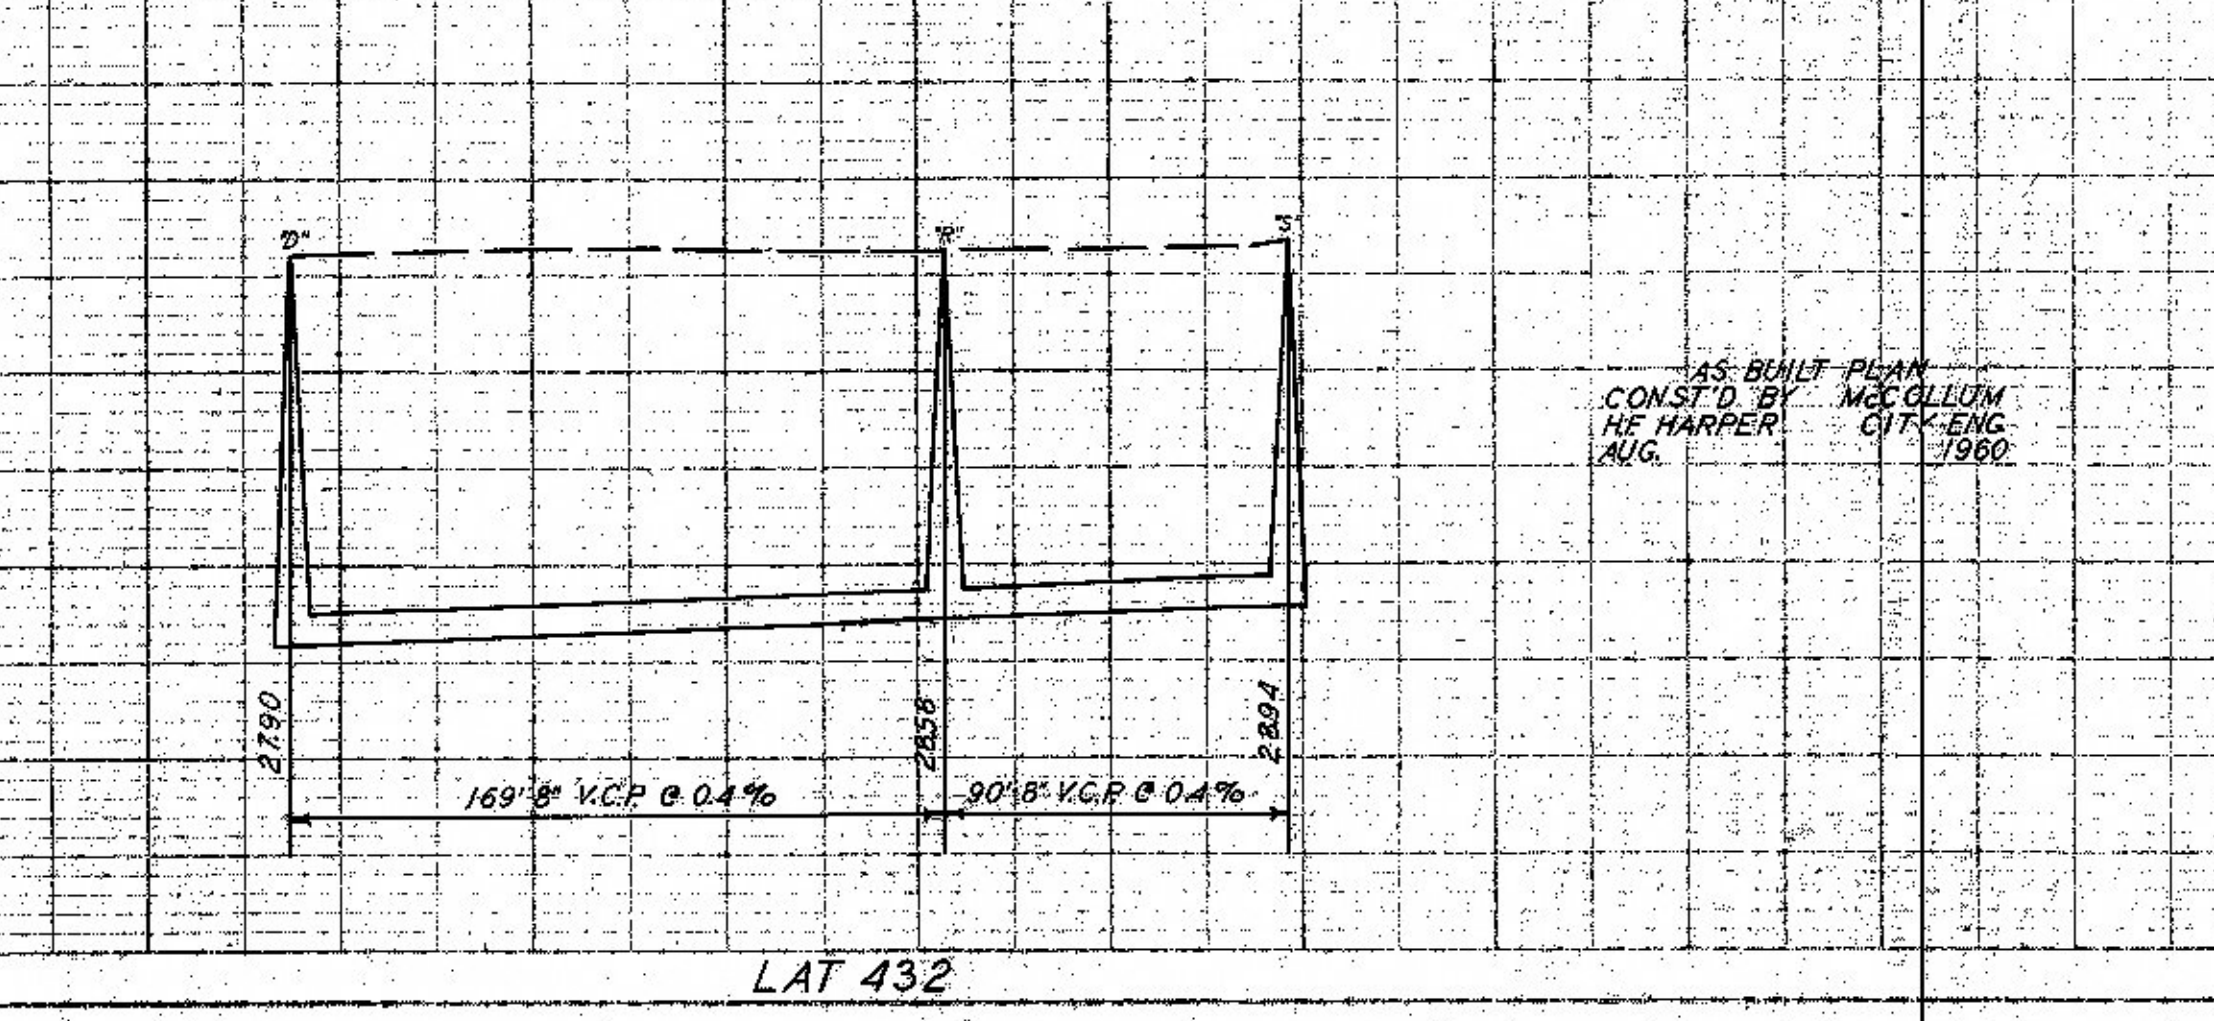

AS-BUILT PLAN  
CONSTR'D BY  
MCGILLUM  
HE HARPER  
CITY-ENG.  
1960  
AUG.