
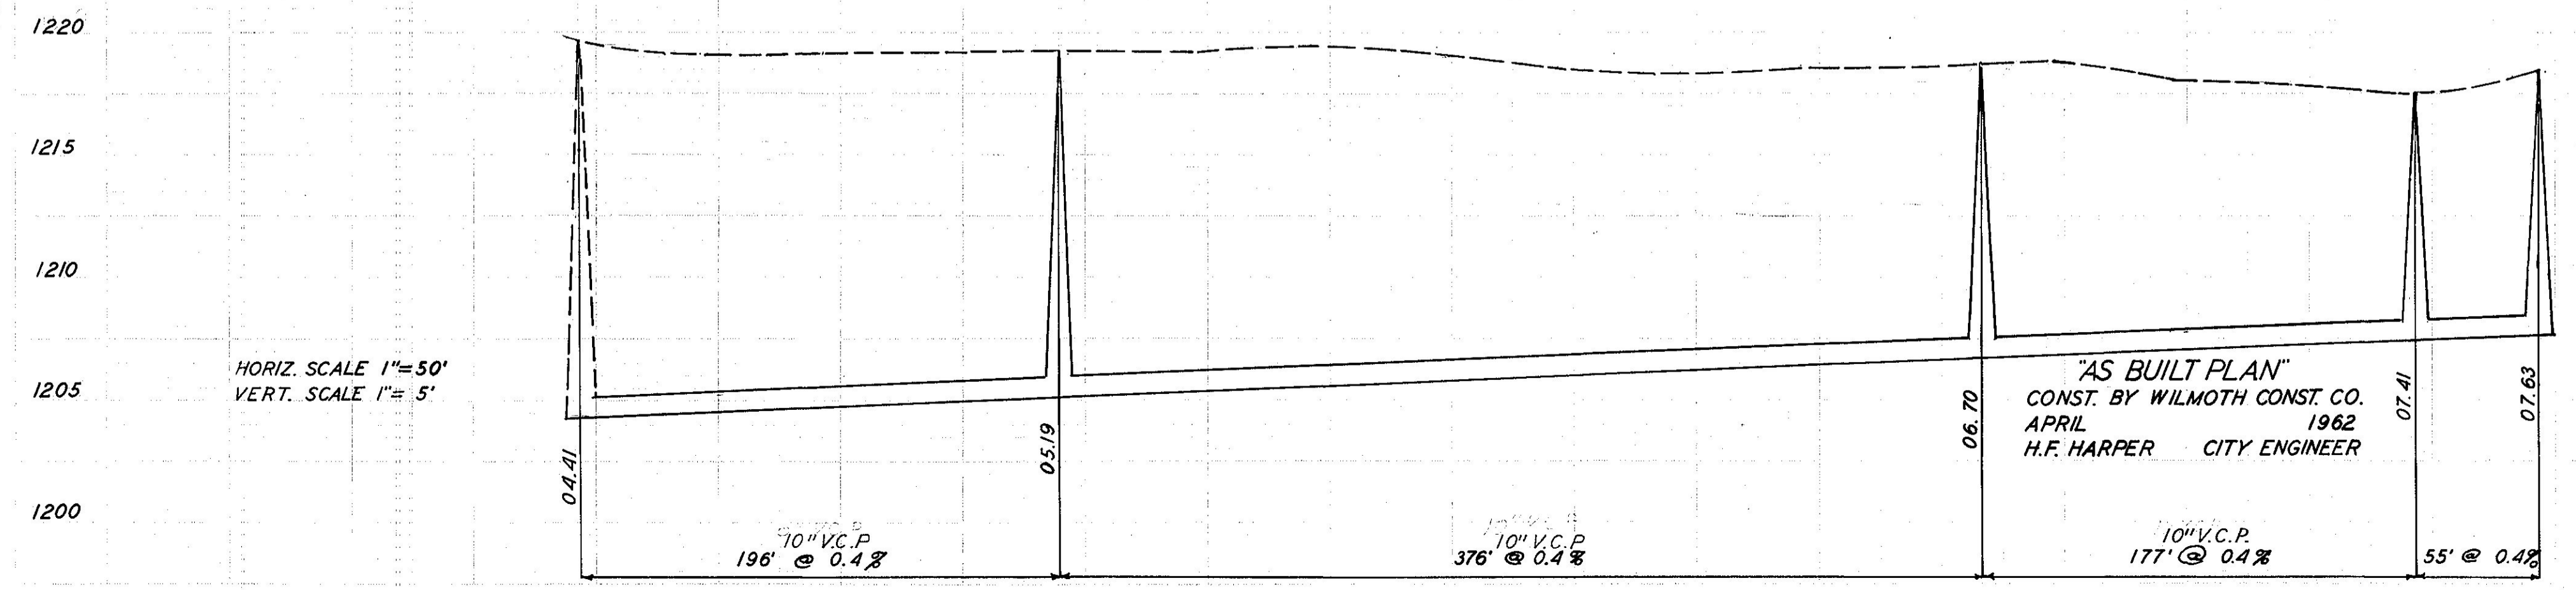


HORIZ. SCALE 1"=50'
VERT. SCALE 1"=5'

LAT. 443

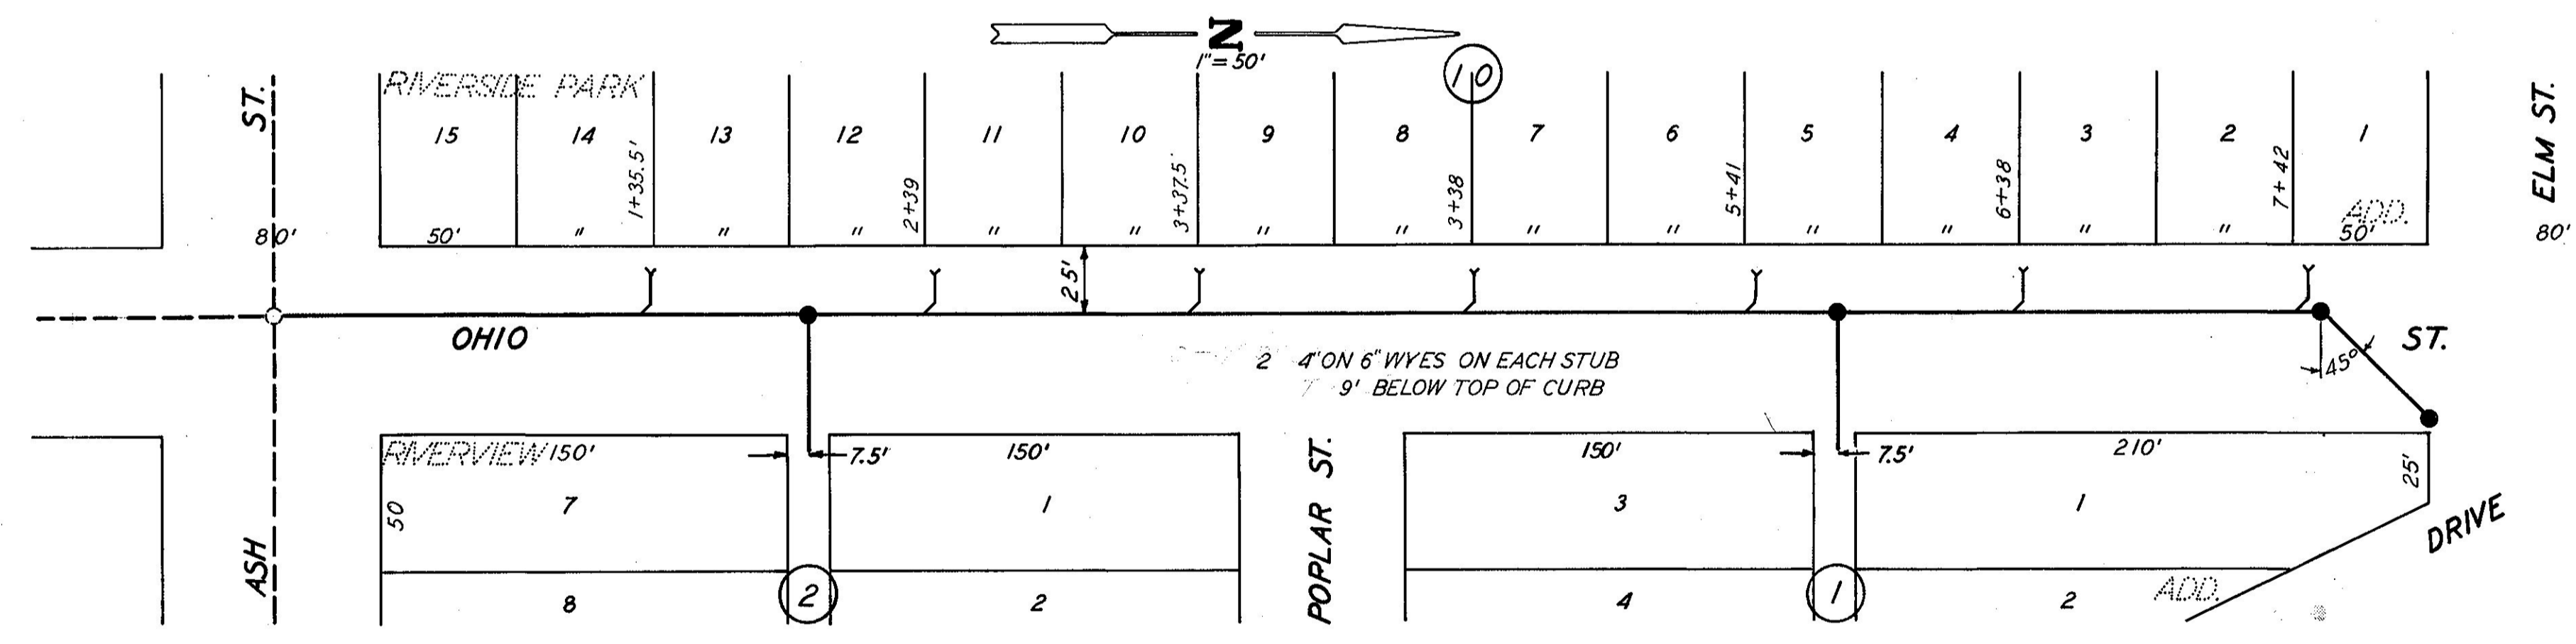

HORIZ. SCALE 1"=50'
VERT. SCALE 1"=5'