


SANITARY SEWER-BLOCK 10 KEY ACRES ADD.

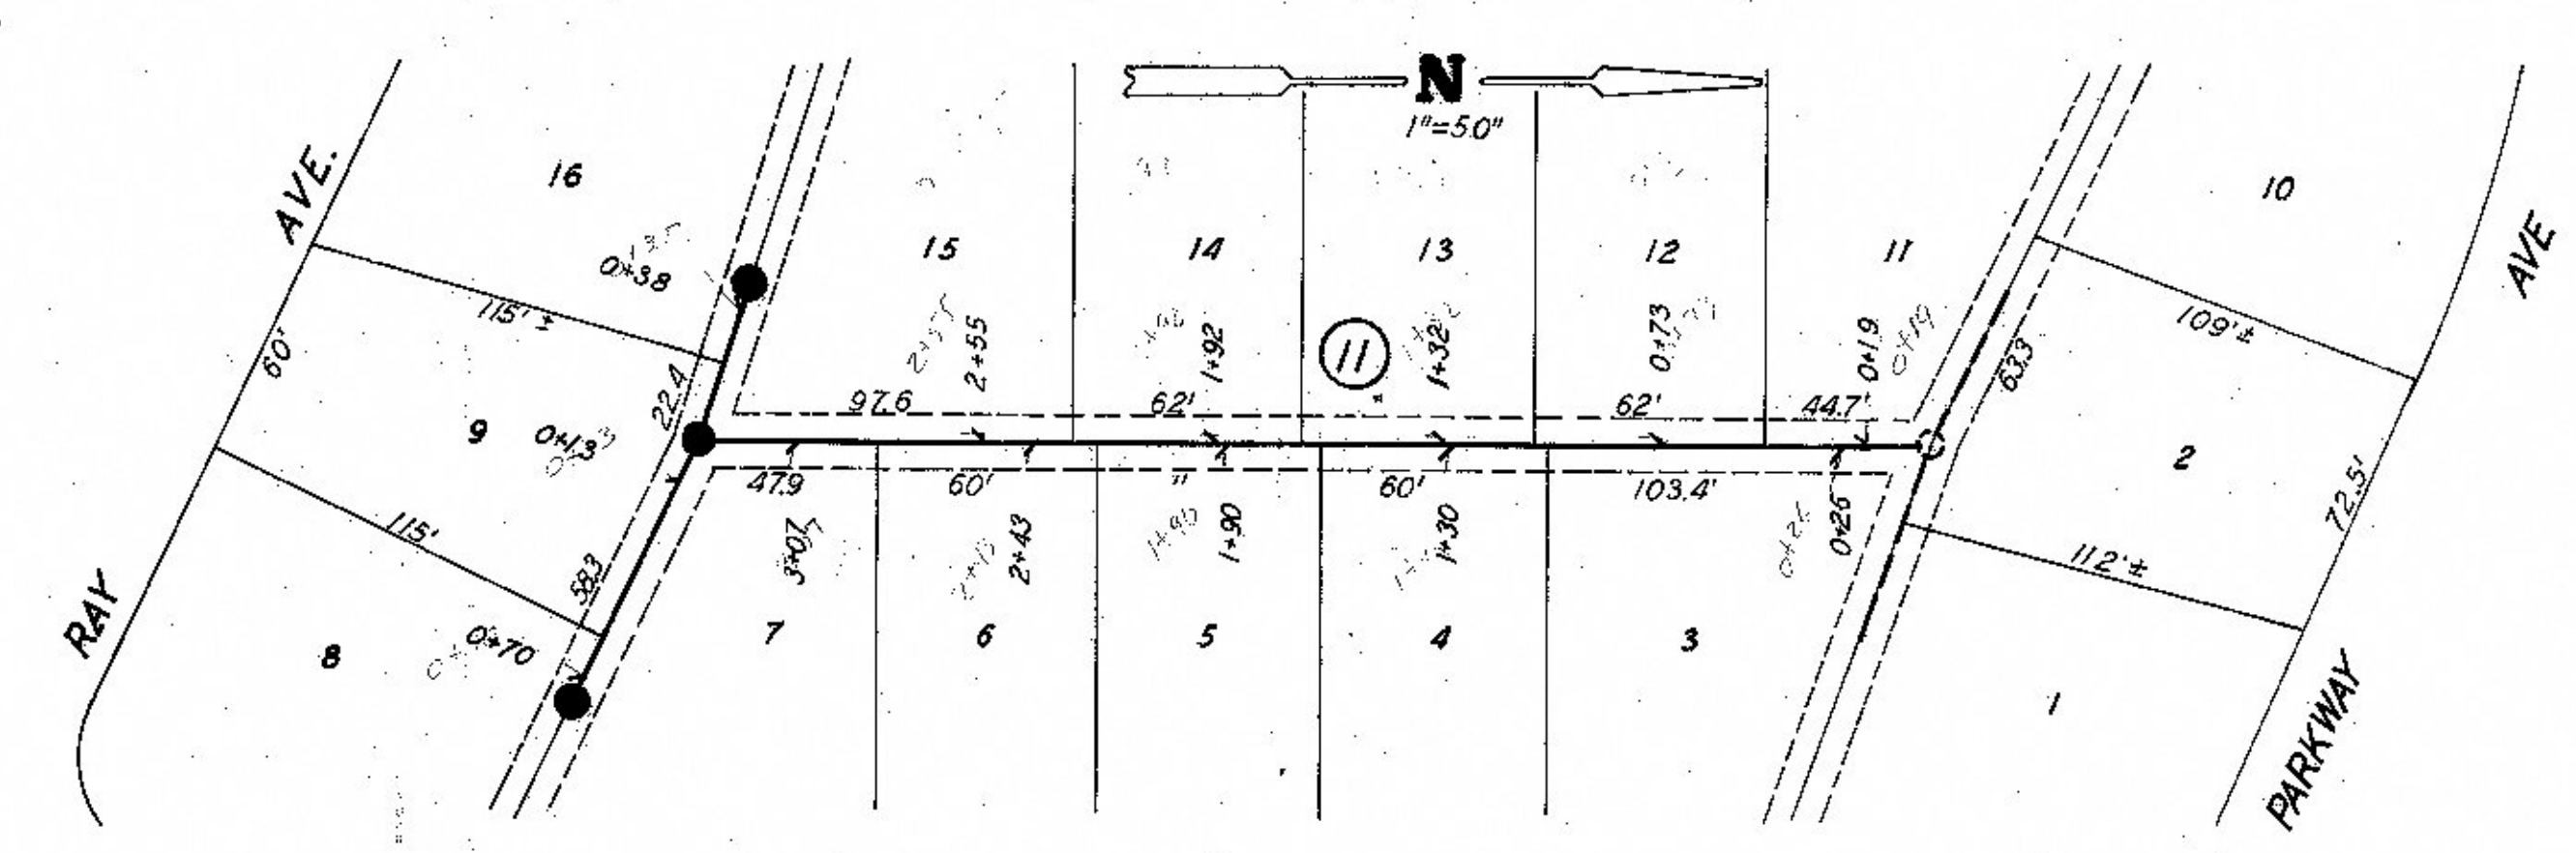


SANITARY SEWER-BLOCK 11 KEY ACRES ADD.

PLAN

DATE	
BY	
NO.	
NO.	


SURVEYED  
 CHECKED  
 NOTE BOOK (ALTERNATE) CHECKED  
 OF WAY CHECKED

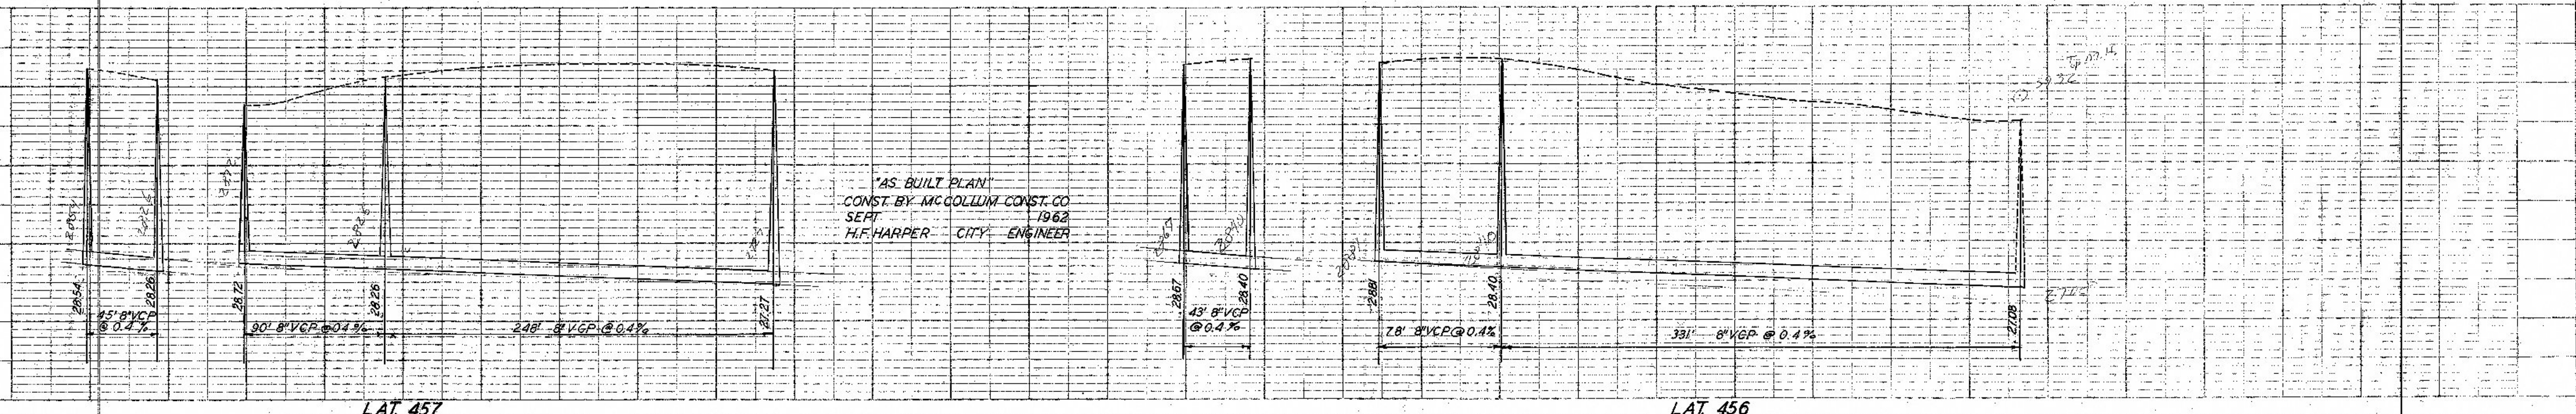


PROFILE

DATE	
BY	
NO.	
NO.	


SURVEYED  
 CHECKED  
 NOTE BOOK  
 OF WAY CHECKED  
 STRUCTURE NOT TO THIS POINT

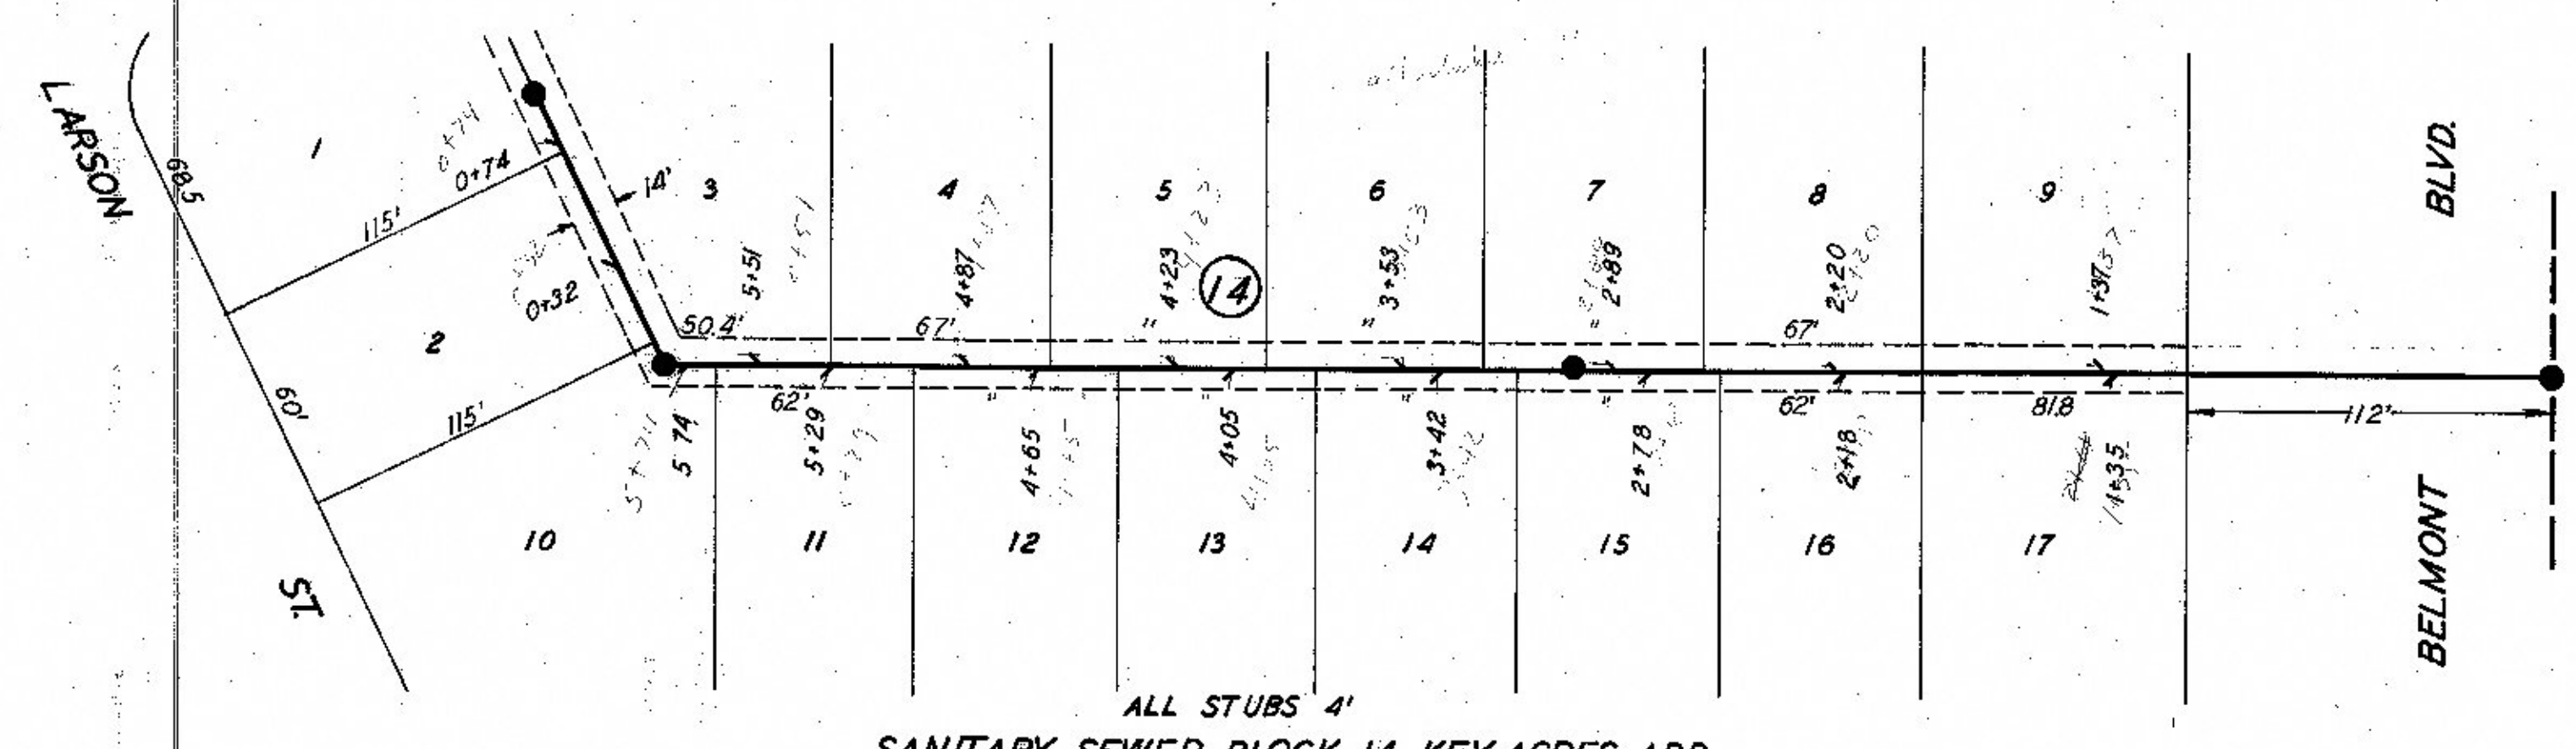

SANITARY SEWER BLOCK 14 KEY ACRES ADD.

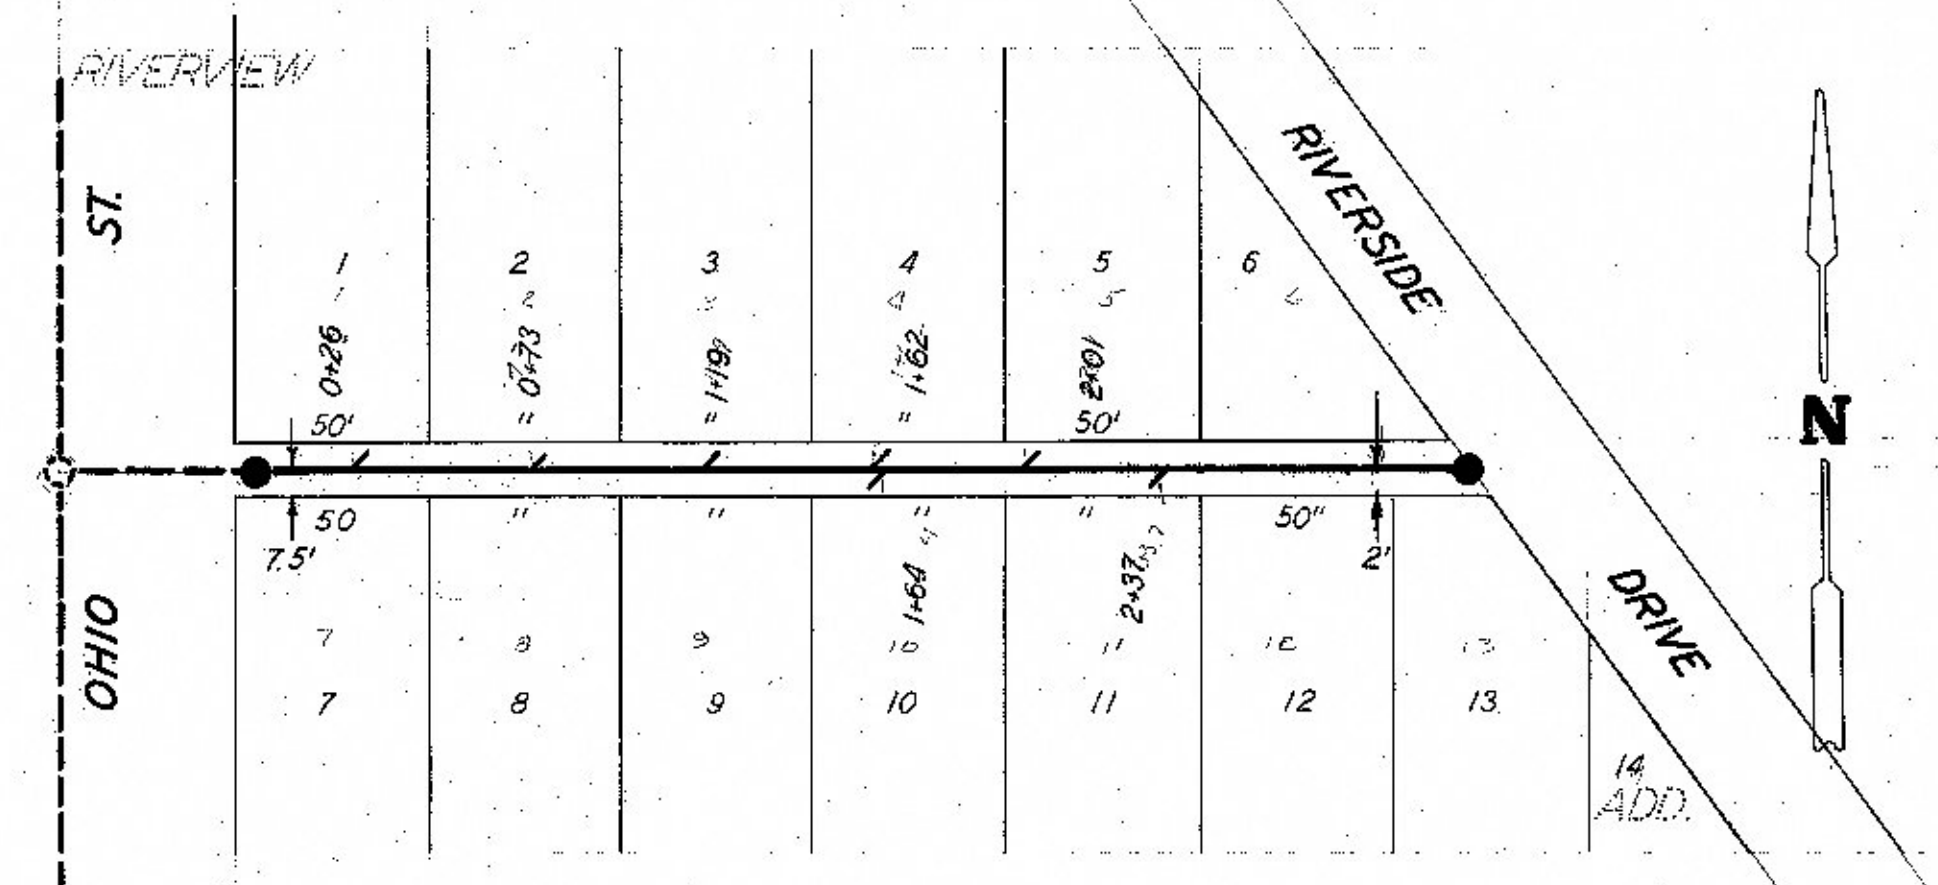

ALLEY NORTH OF ASH OHIO TO RIVERSIDE

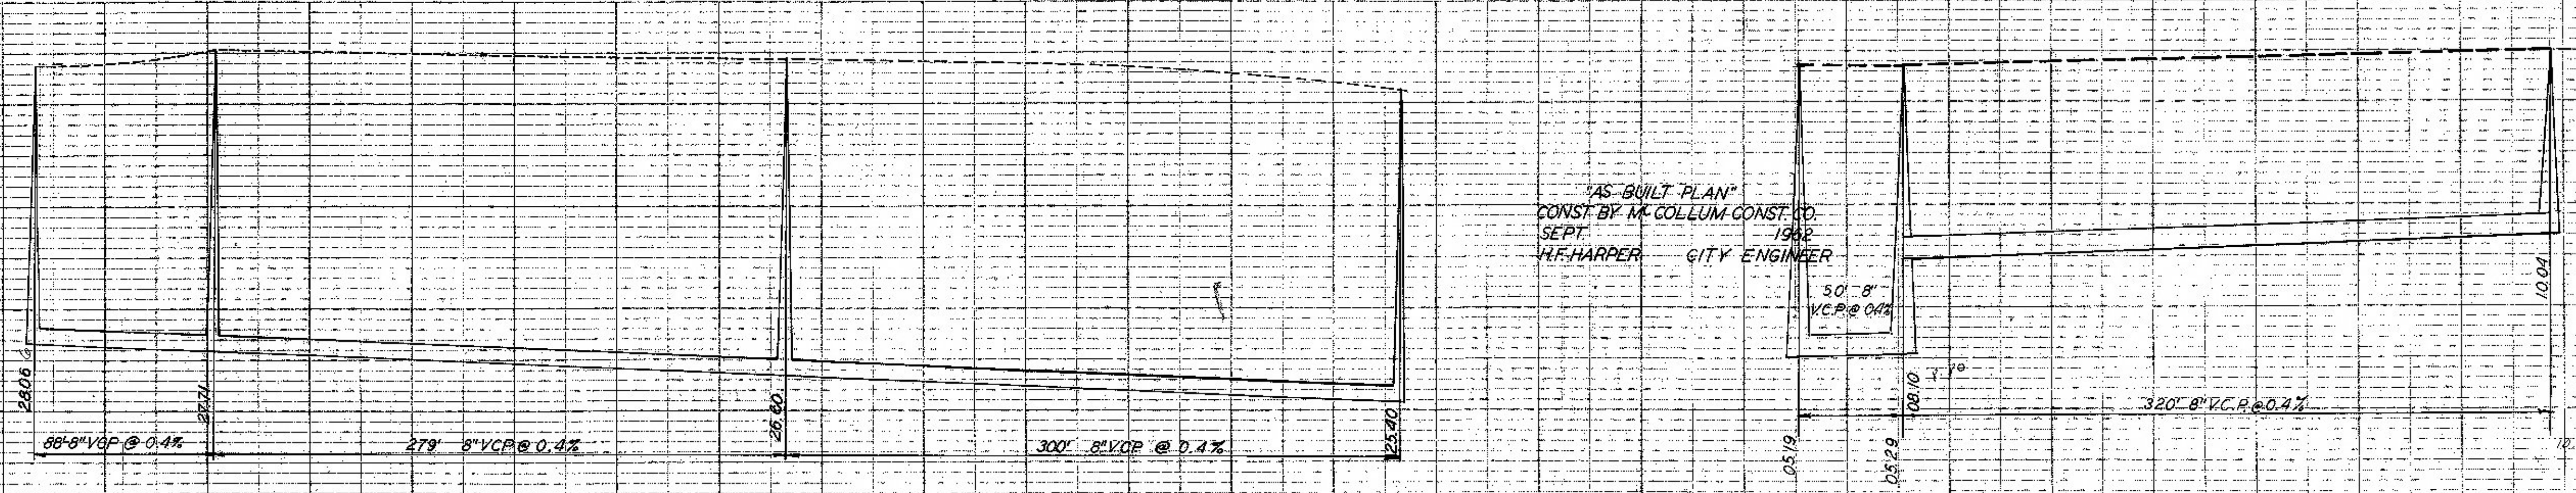

LAT. 455

LAT. NO 472