




ALL WYES SHOWN HAS 3" RISER EXCEPT,
 LOTS 1,8,9,10, BLOCK 13
 LOTS 6,7,8,9,10, BLOCK 16
 LOTS 1,2, BLOCK 17

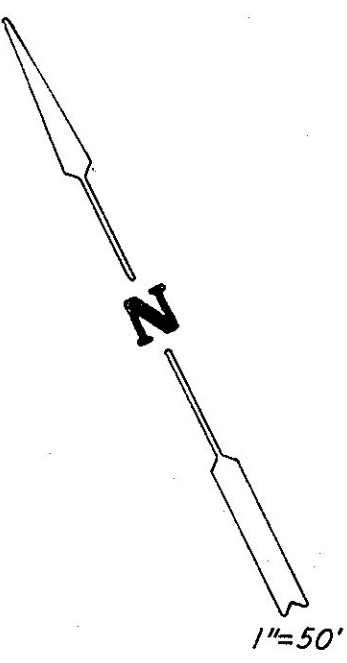

SANITARY SEWER FOR BLOCK 13-16-17 KEY ACRES

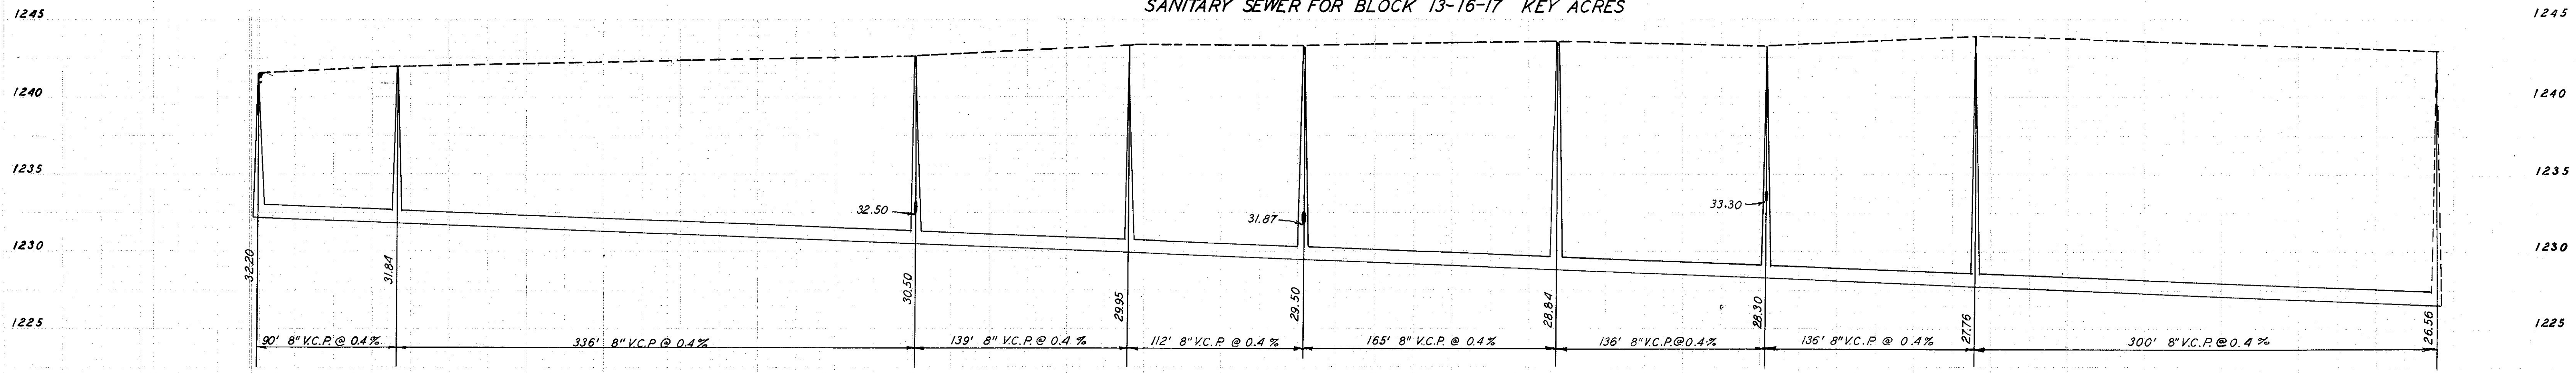

LAT. 460 FOR BLOCKS 13 & 17

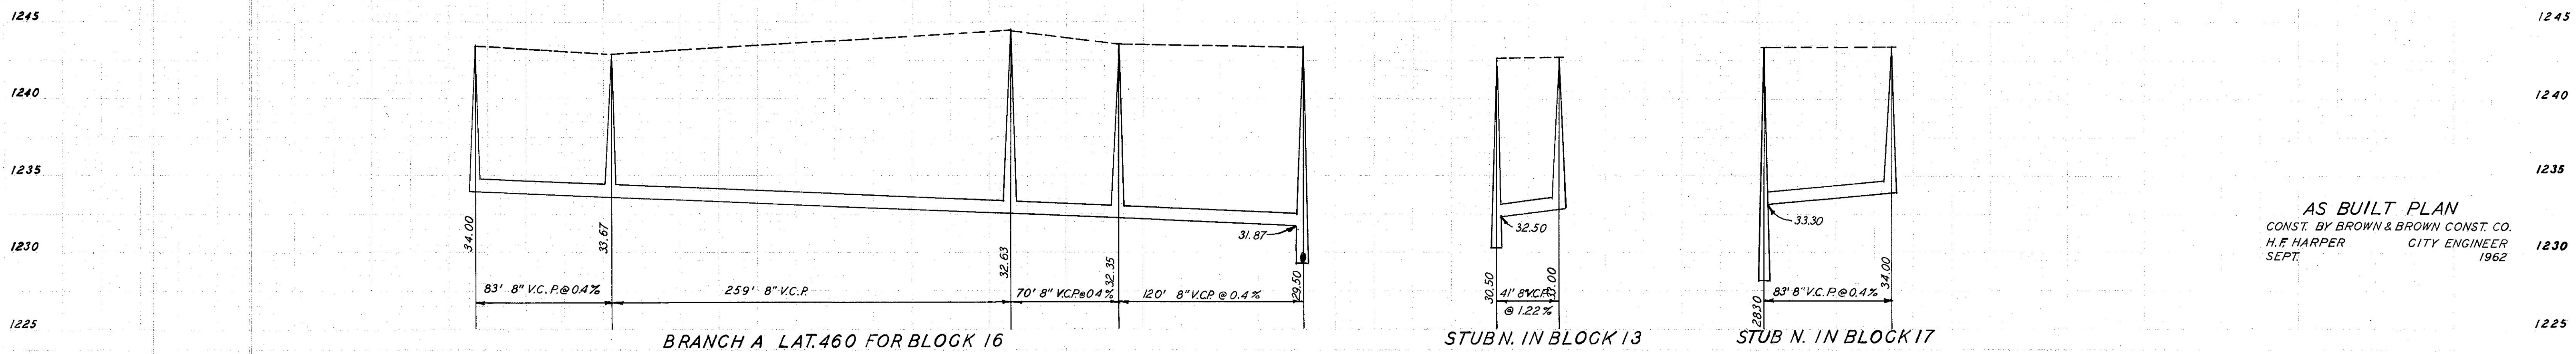

AS BUILT PLAN
 CONST. BY BROWN & BROWN CONST. CO.
 H.F. HARPER CITY ENGINEER
 SEPT. 1962