




SANITARY SEWER-BLOCKS 3 & 4 INDIAN ROCK ADD.

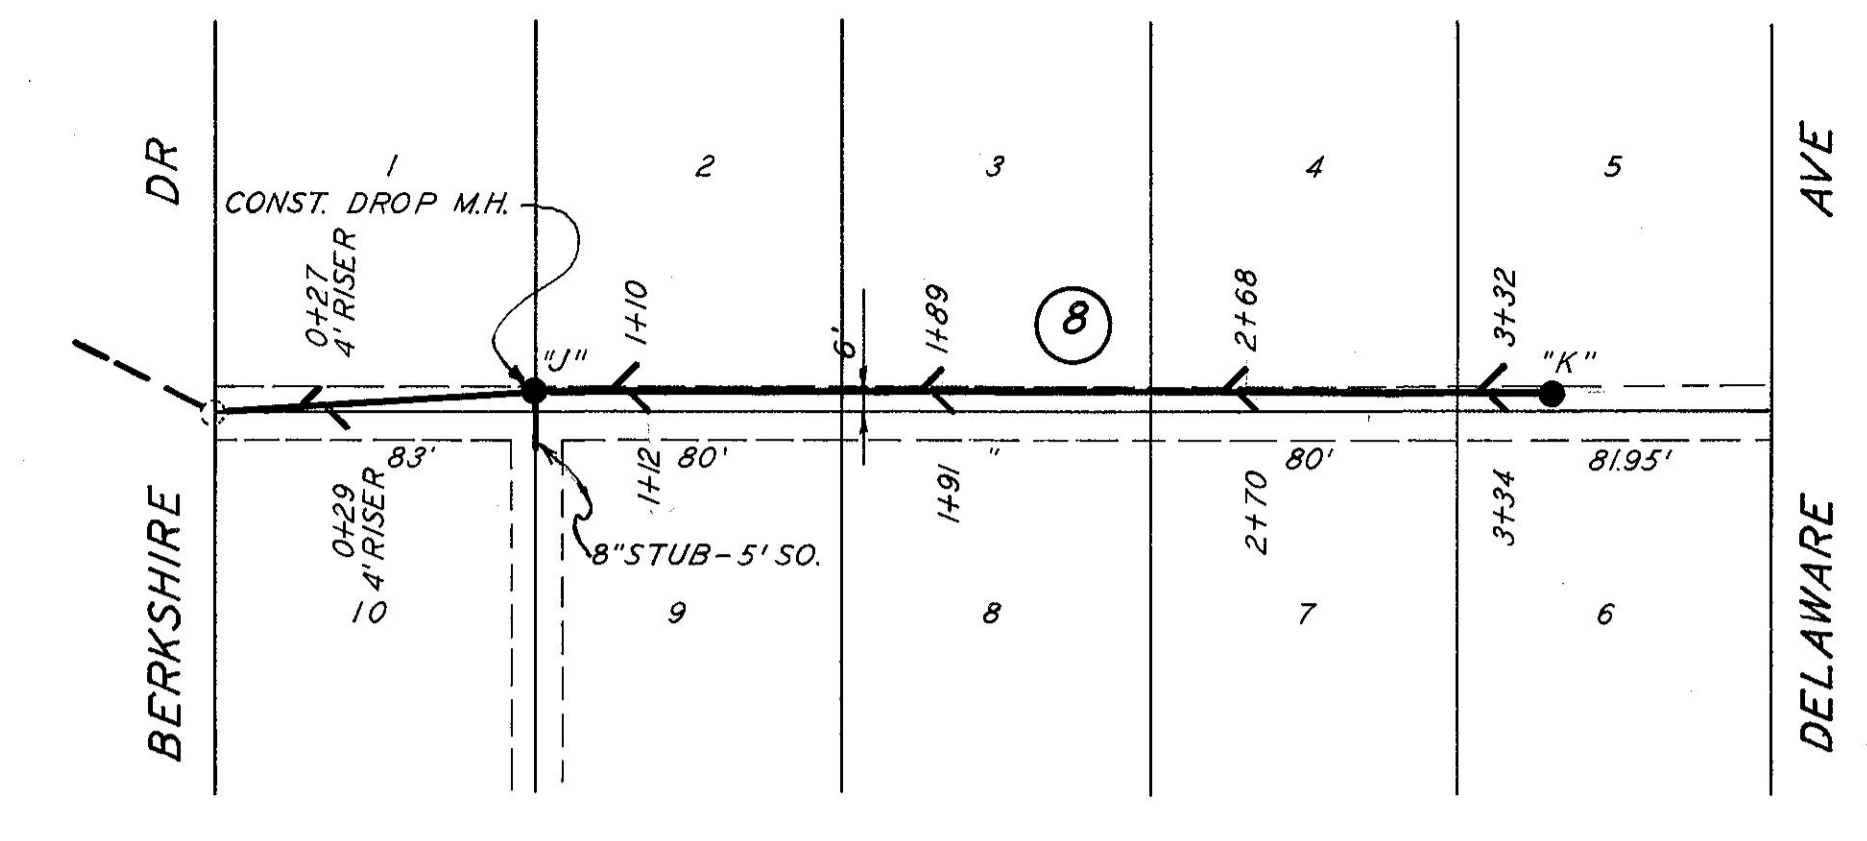


SANITARY SEWER-BLOCK 8

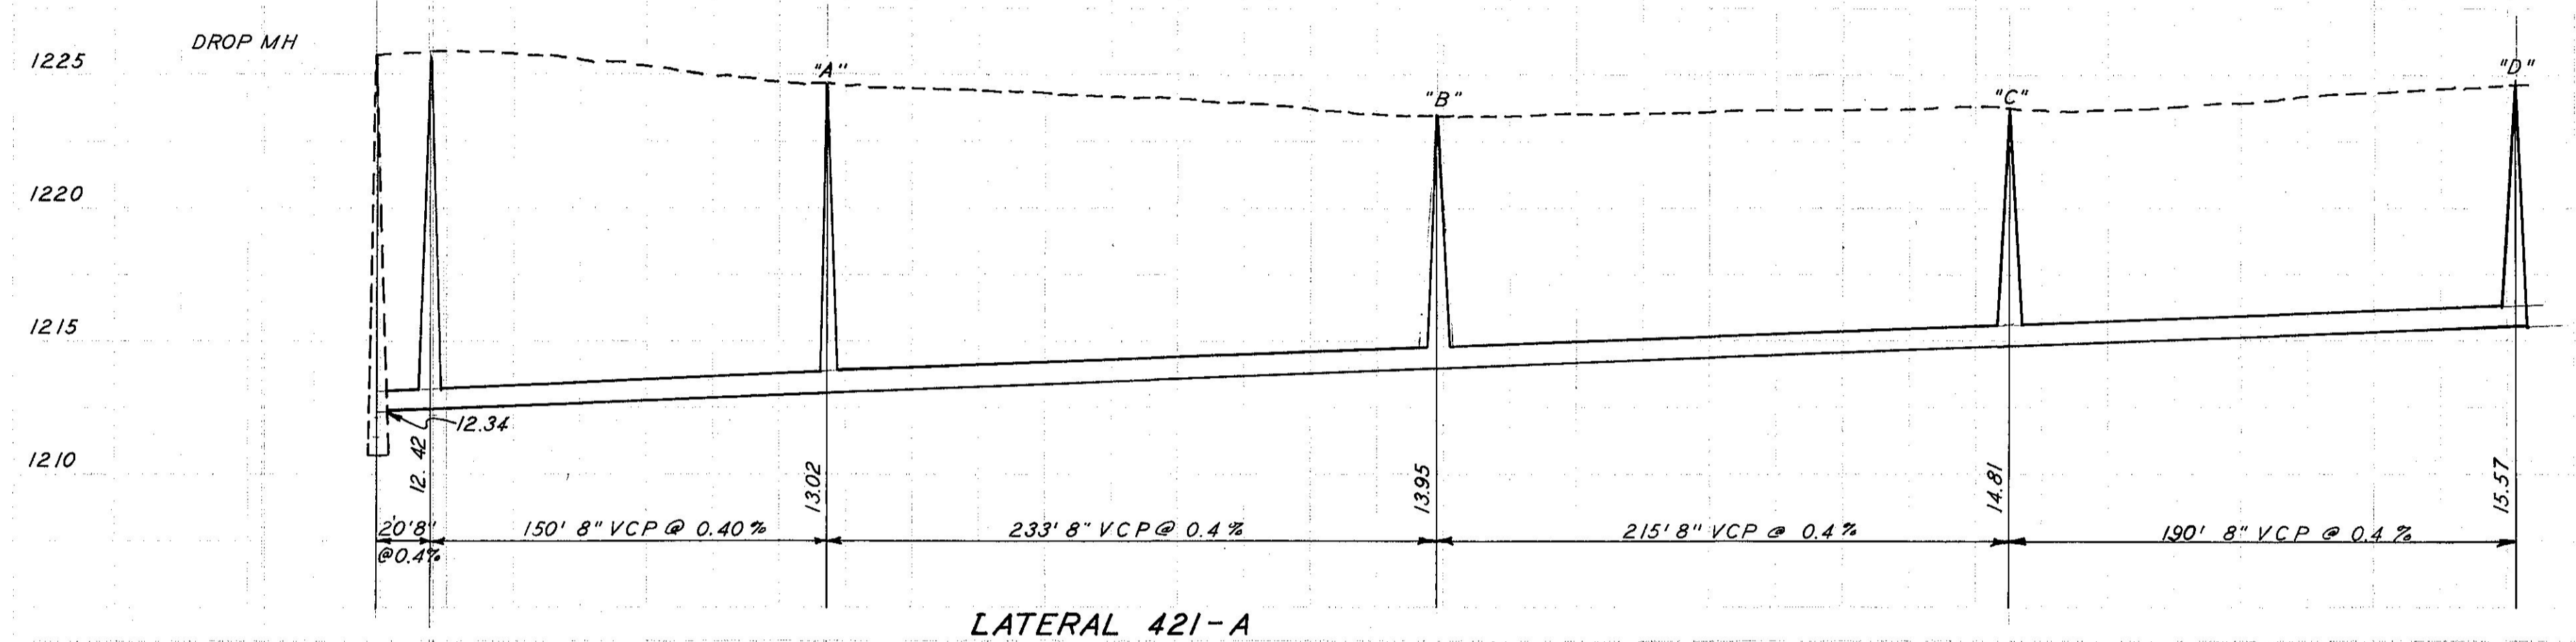


LATERAL 421-A

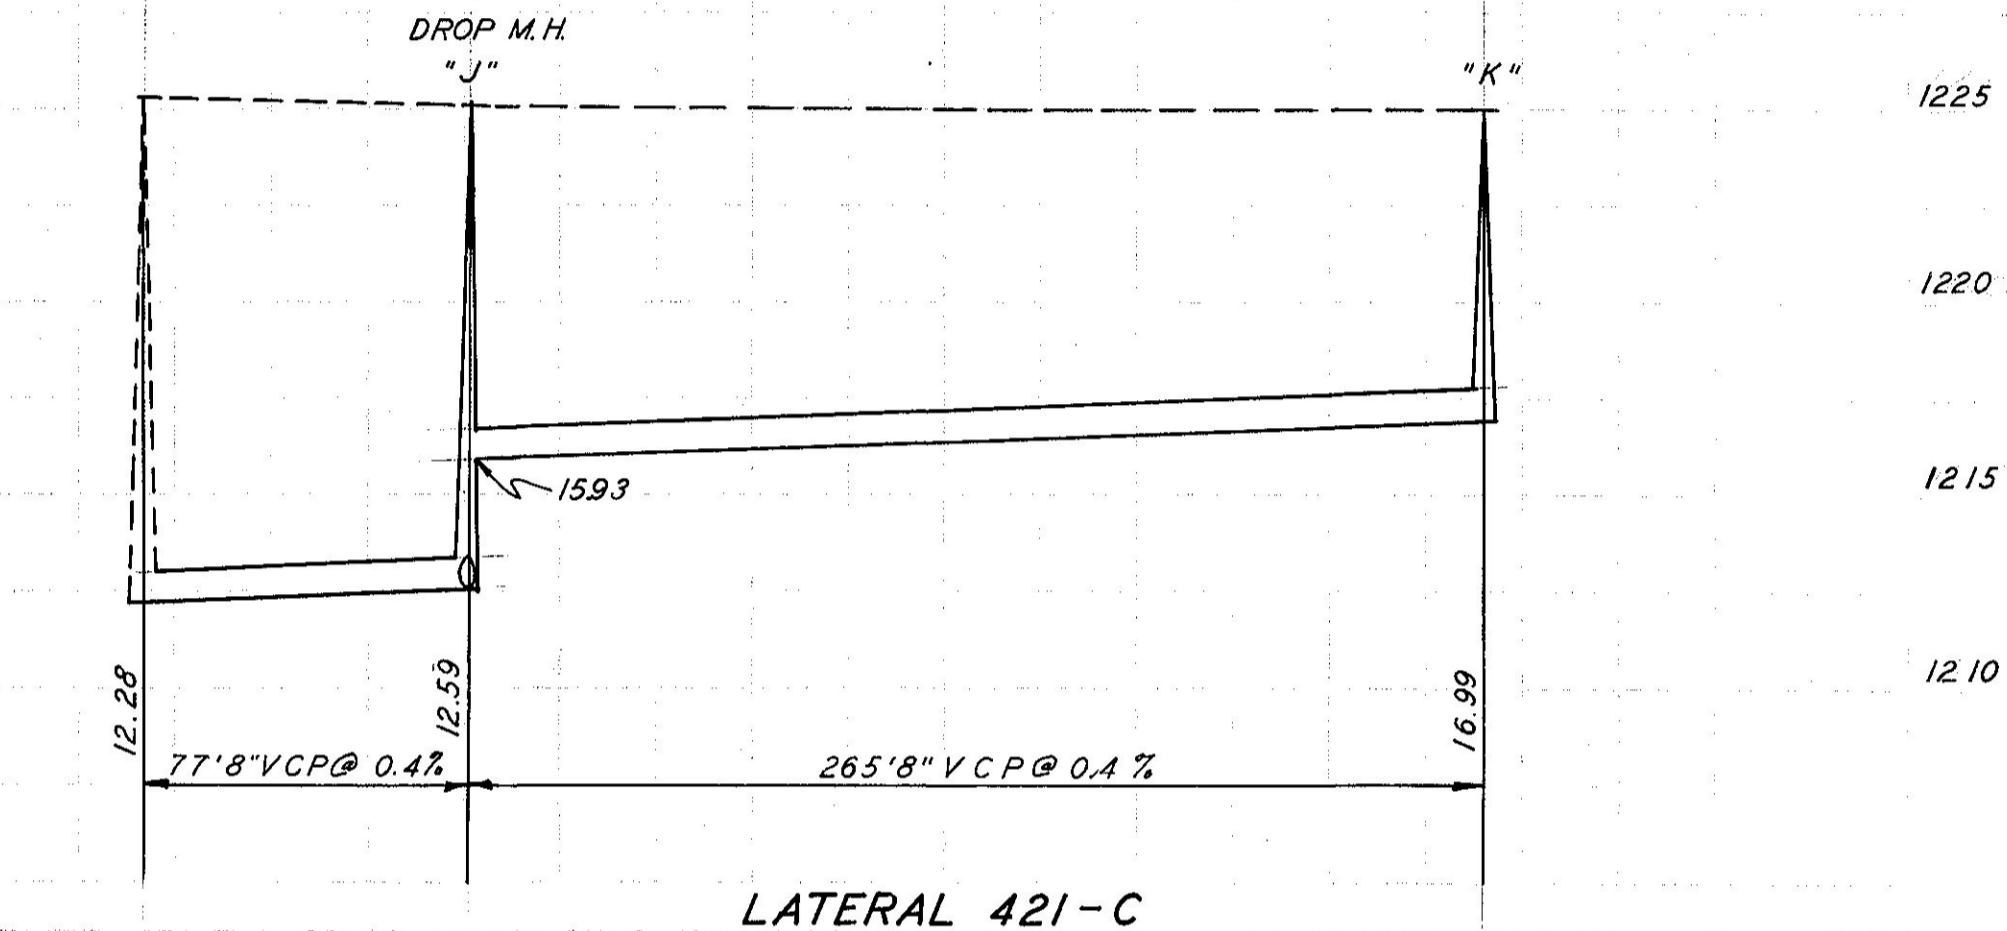


LATERAL 421-C

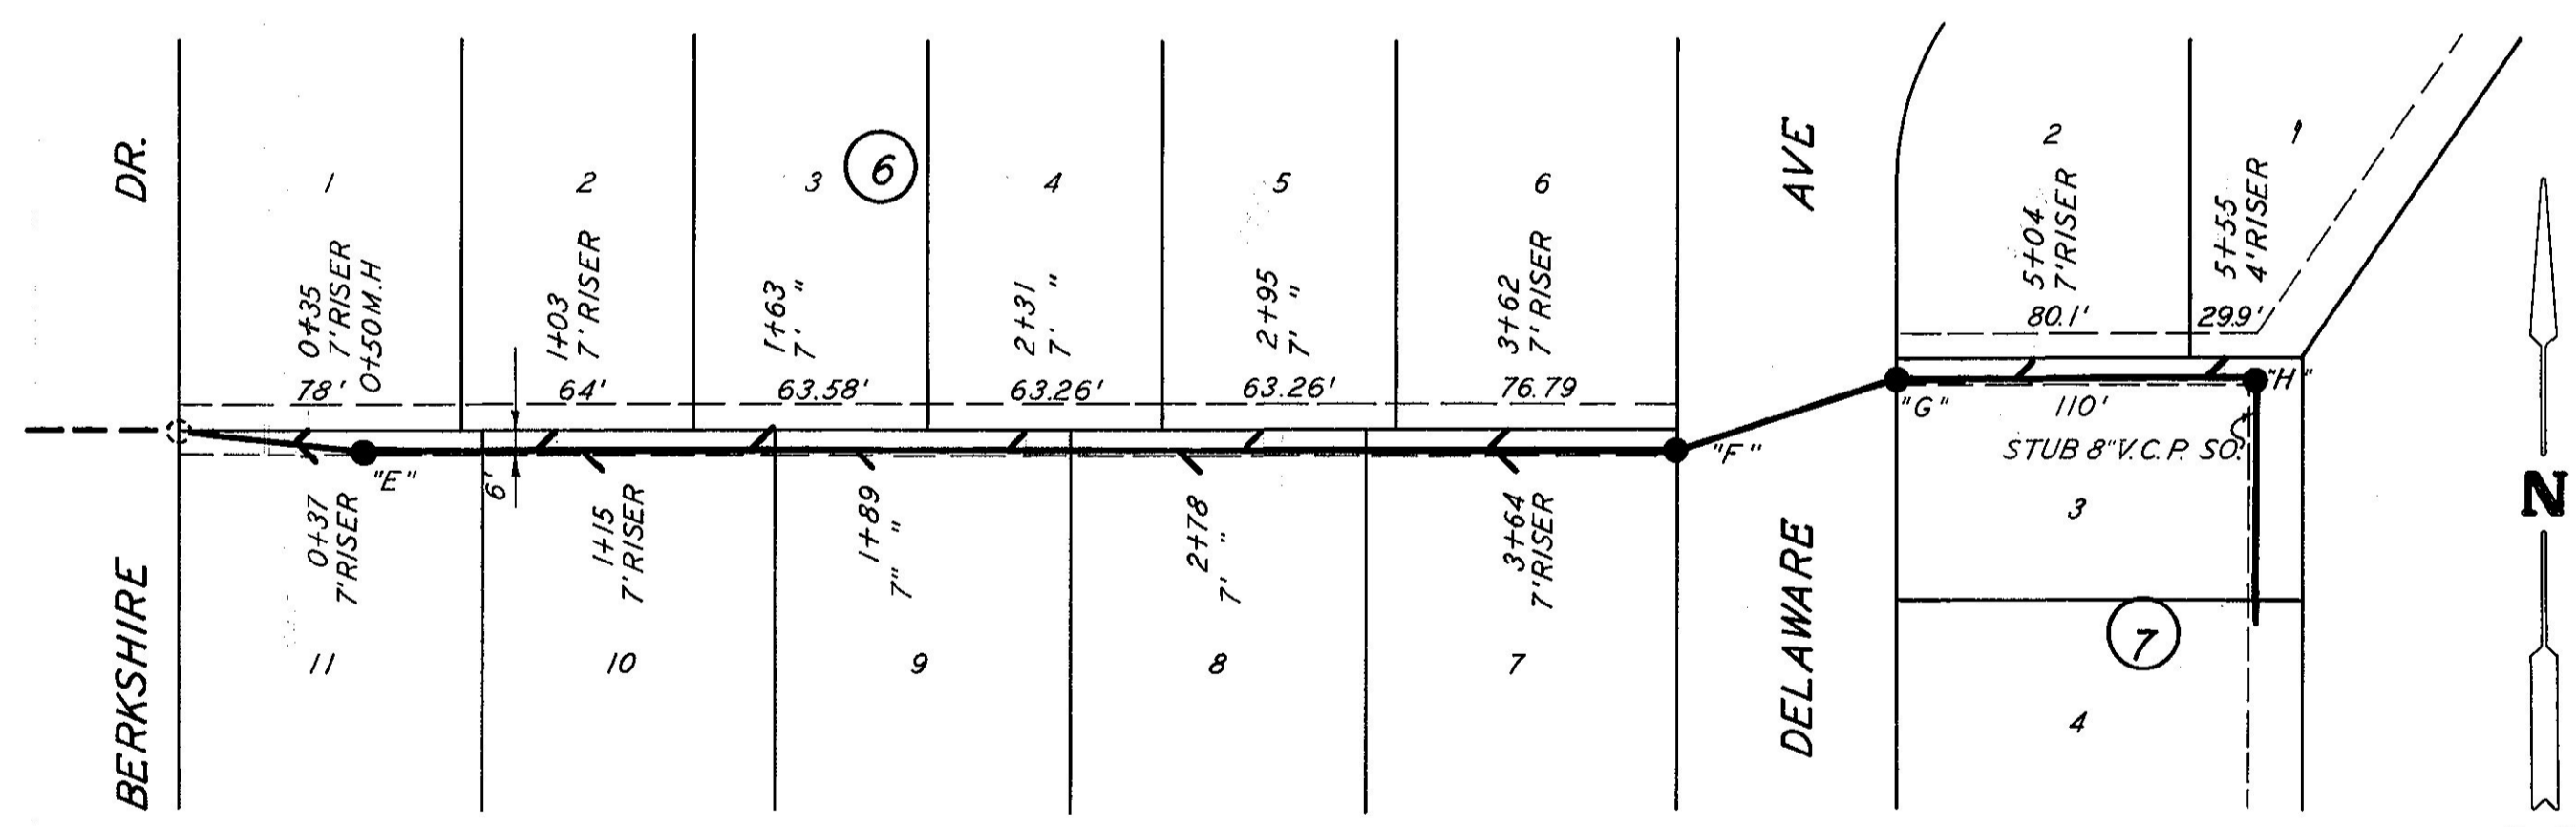


SANITARY SEWER-BLOCKS 6 & 7

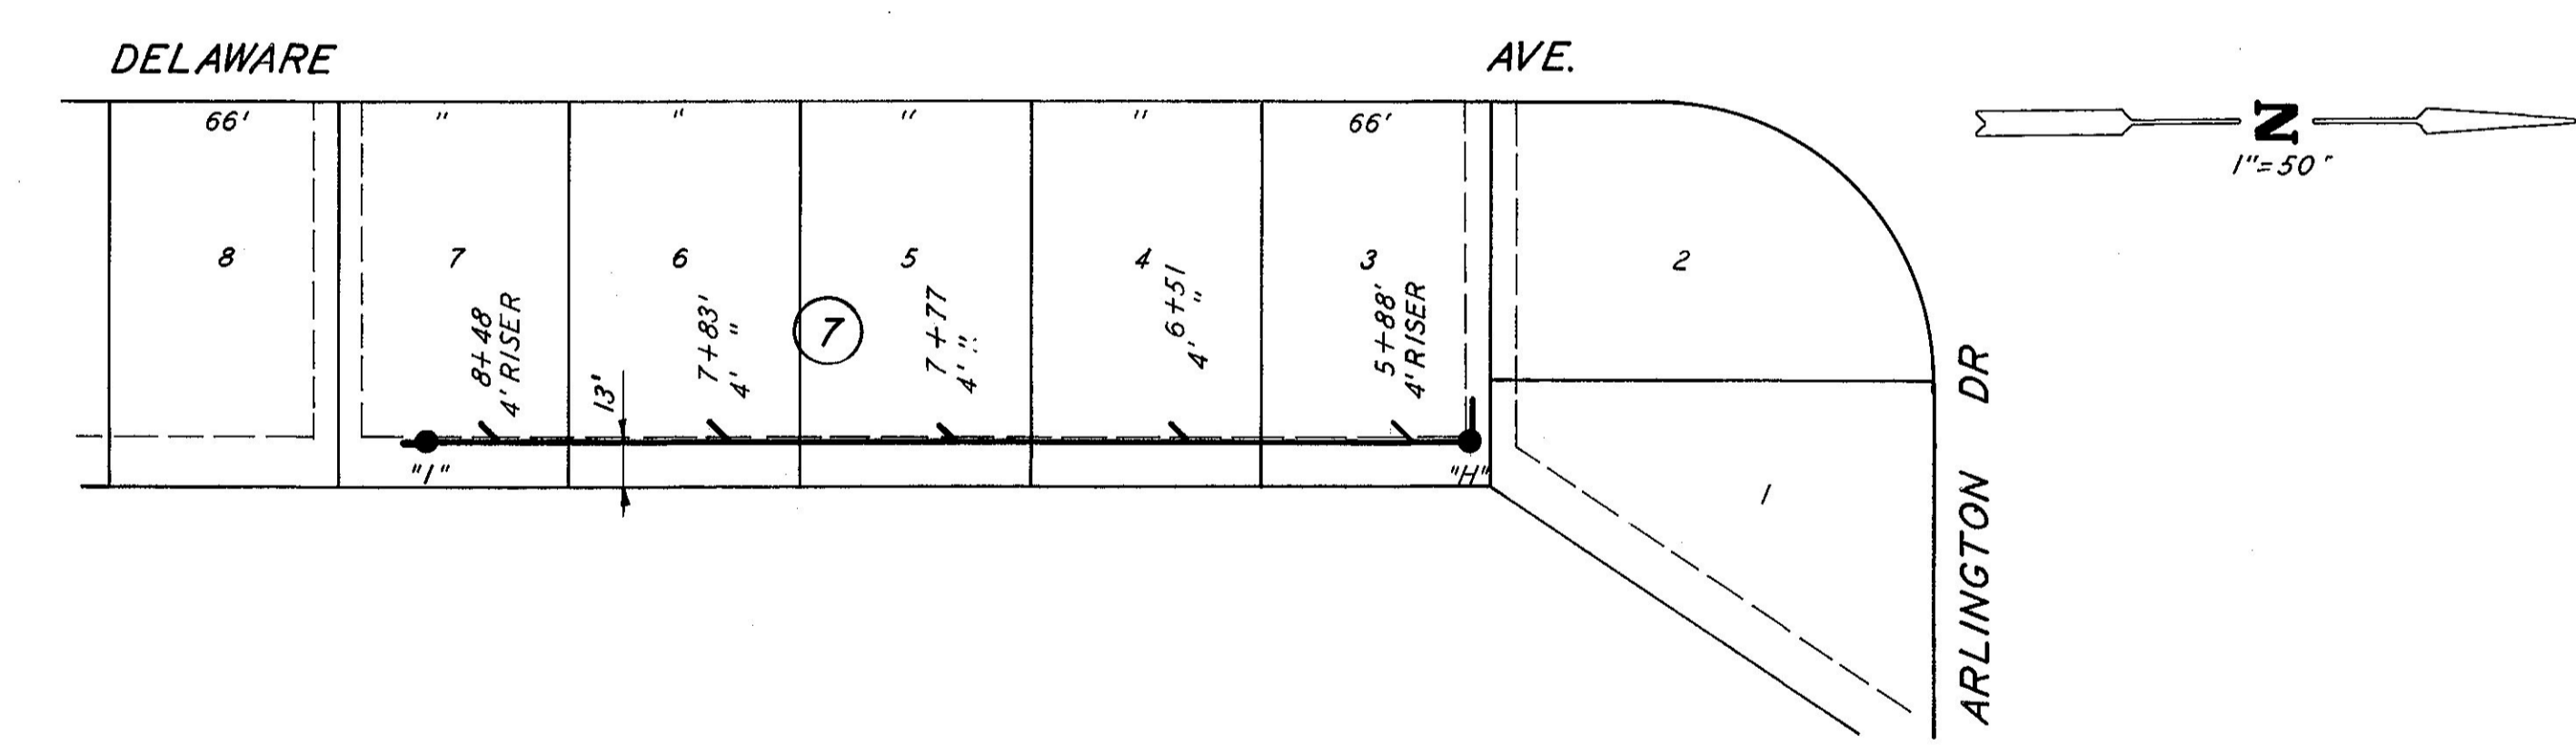

SANITARY SEWER TO SERVE LOTS 1 TO 7 BLOCK 7

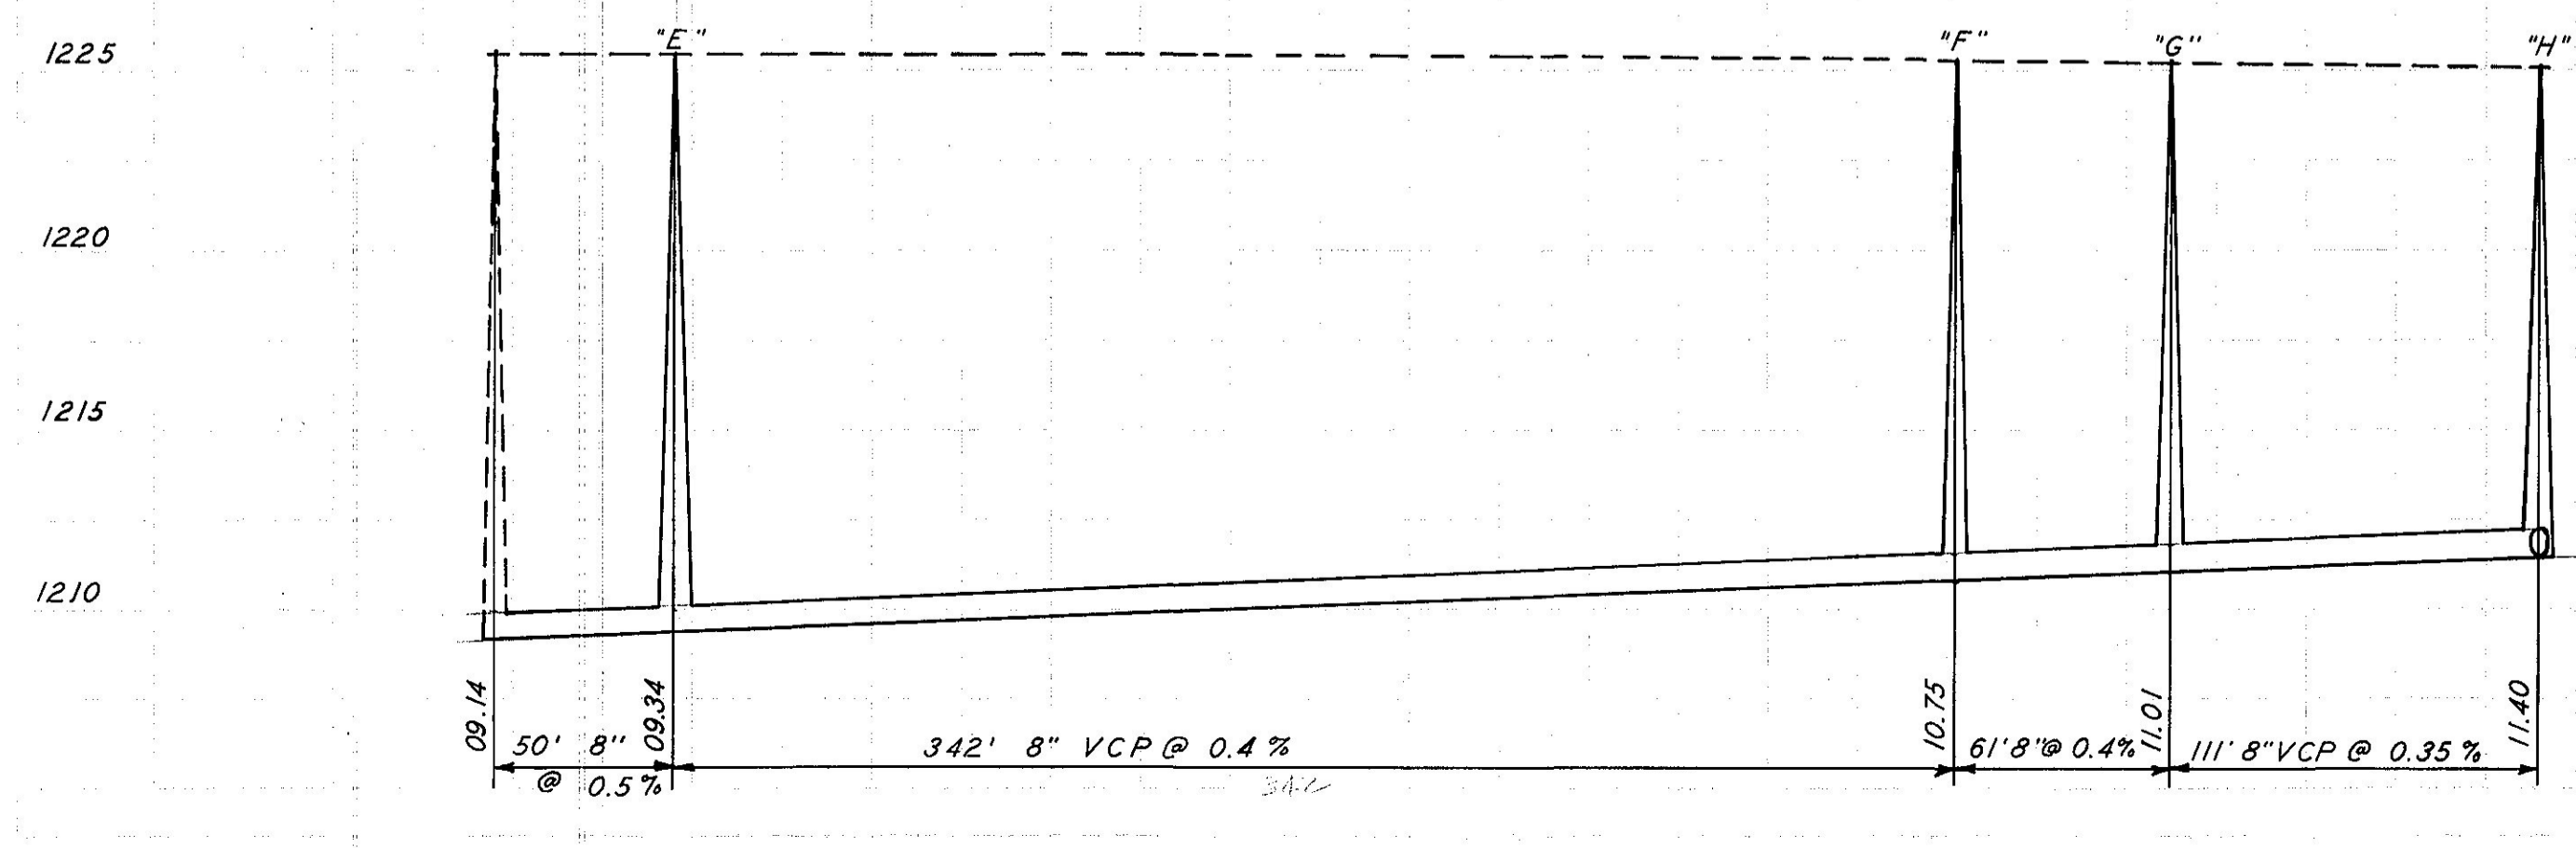

LATERAL 421-B

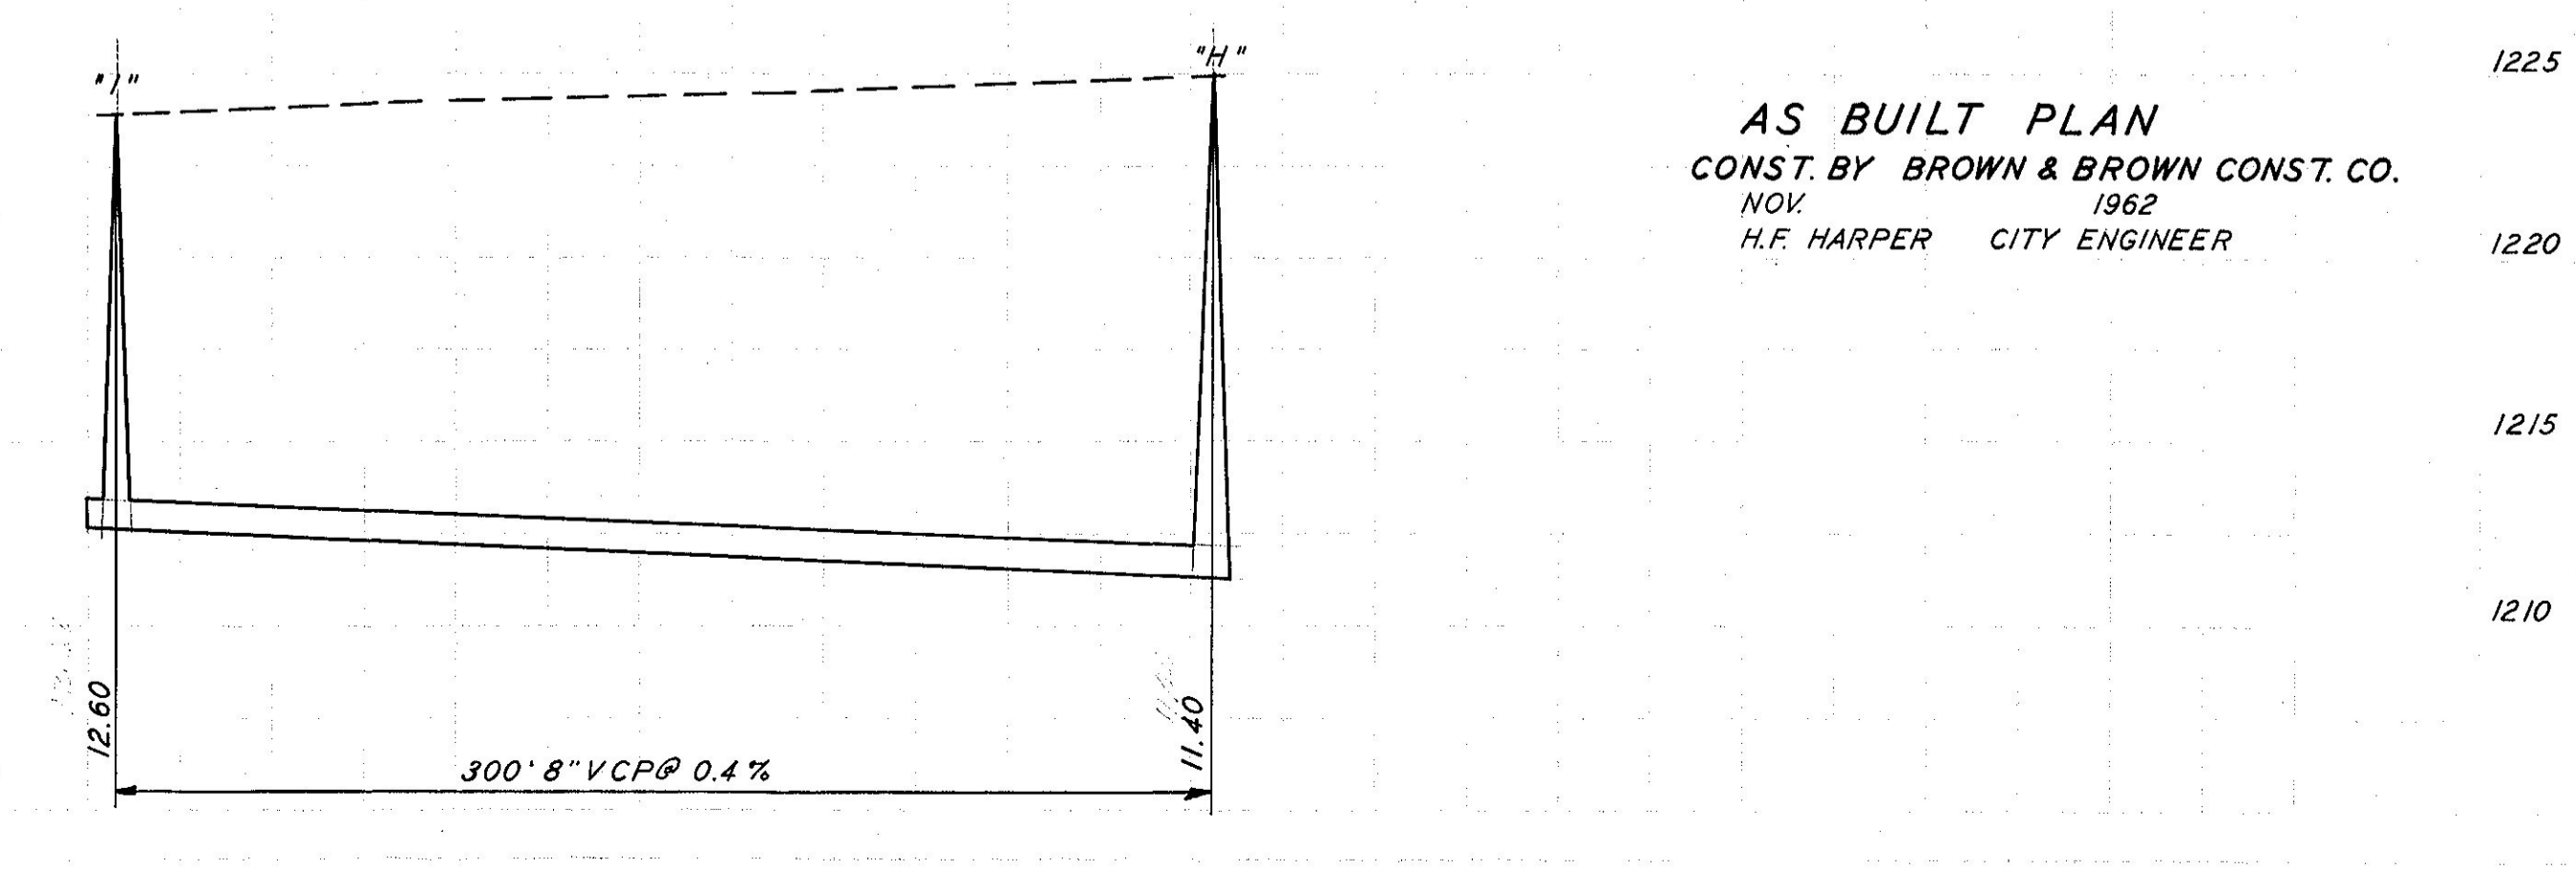

AS BUILT PLAN
 CONST. BY BROWN & BROWN CONST. CO.
 NOV. 1962
 H.F. HARPER CITY ENGINEER