


GENERAL NOTE PERTAINING TO TEST HOLES:
 Exploratory holes have been drilled at the site to assist the Contractor in ascertaining the character of the excavation material to be encountered. The Owner does not guarantee that materials other than those disclosed will not be encountered or that the proportions of the various materials will not vary from those indicated on test hole logs.

TBM - Railroad spike in transformer pole behind House No. 14 Eastborough Road. Elev. 1223.483

AS CONSTRUCTED DRAWING
 DATE: Jan. 63 APPRO. RLC

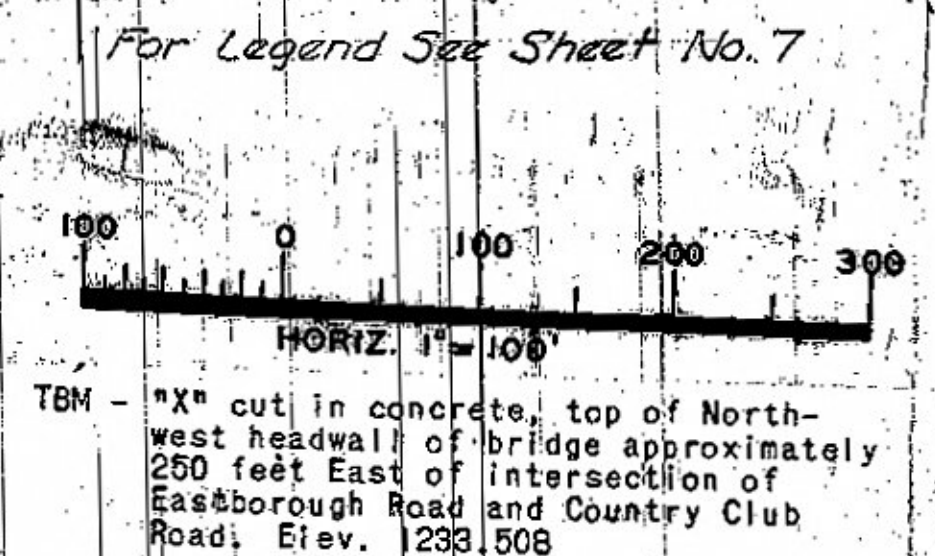

SALINA, KANSAS
SANITARY TOWN LINES
 NORTH FORCE MAIN
 EAST MAIN: STA. 9+99 TO 38+59

WILSON & COMPANY
 ENGINEERS & ARCHITECTS
 SALINA - KANSAS

DATE: April 1961
 FILE NO. 60-17D
 SHEET NO. 11 OF 15

CONTAINS
 1. NORTH FORCE MAIN
 2. EAST MAIN
 3. NORTH STREET PUMPING STATION
 4. SALINA SEWAGE TREATMENT PLANT

TEST HOLE 1
 0'-2 1/2" Black Top Soil
 2 1/2'-5" Silty Clay (Dry)
 5'-10" Silty Clay (Moist)
 April 1961

TEST HOLE 2
 0'-3" Black Top Soil
 3'-6" Brown Silty Clay (Moist)
 6'-10" Green Clay (Moist)
 Water Elev. 1223.0
 April 1961