


TBM - Railroad spike in telephone pole on North side of East Crawford North of Henry W. Baltine House. Approximately 10' East of fence. Elev. 1265.16'

TBM - Railroad spike in telephone pole. Pole is on North side of East Crawford and North Northwest of entrance to sanitary fill approximately 1/4 mile East of intersection of East Crawford and Marymount Road. Elev. 1271.216'


TBM - "m" cut in top of Northwest corner of slab of the Northeast curb drain at intersection of East Crawford and Marymount Road. Elev. 1283.331'

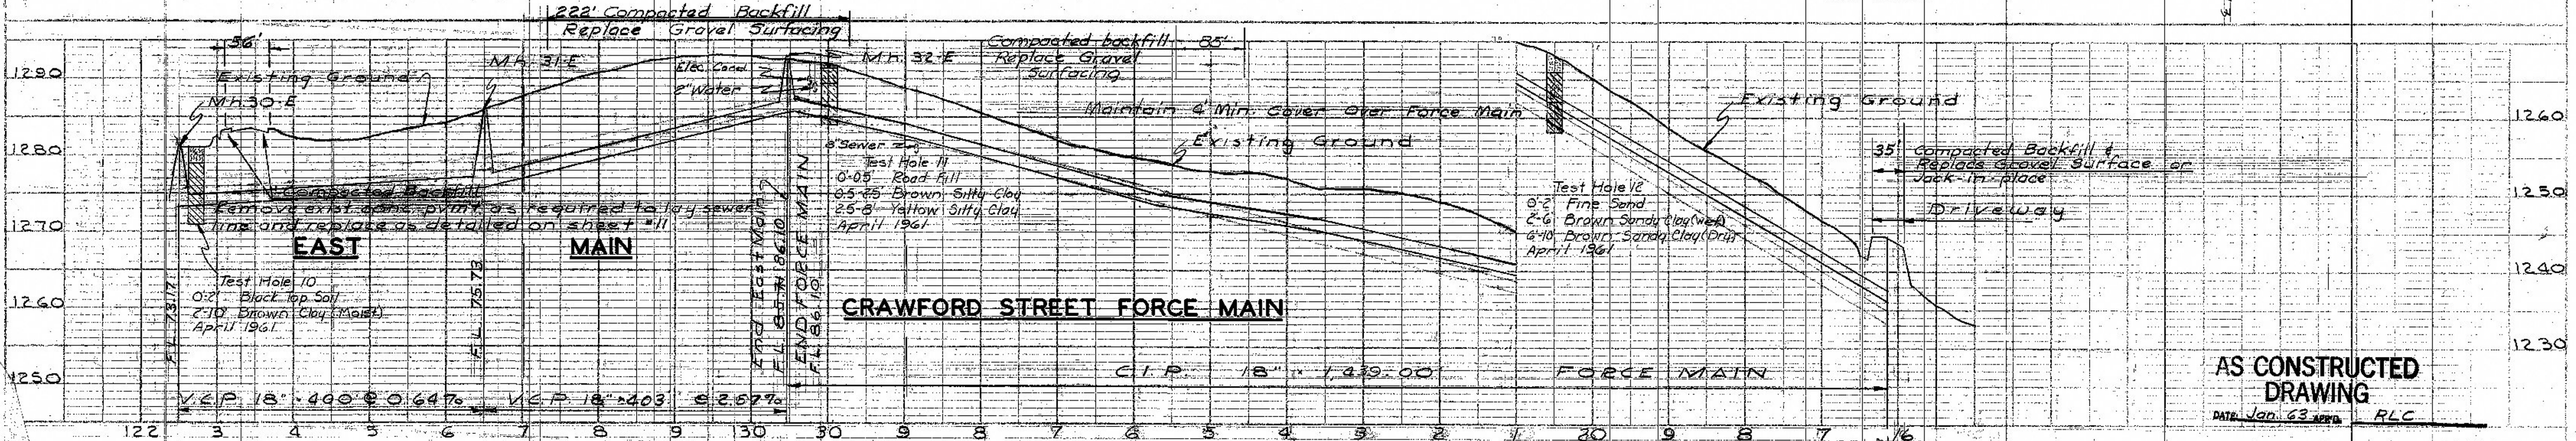

**AS CONSTRUCTED DRAWING**  
DATE: Jan. 63  
RLC

Drawing Revised 9 Apr. 62 DLS

TBM - On fire hydrant. "m" cut in top of North shoulder of East Crawford across from the Northwest corner of Roselawn Memorial Park. Elev. 1282.546'

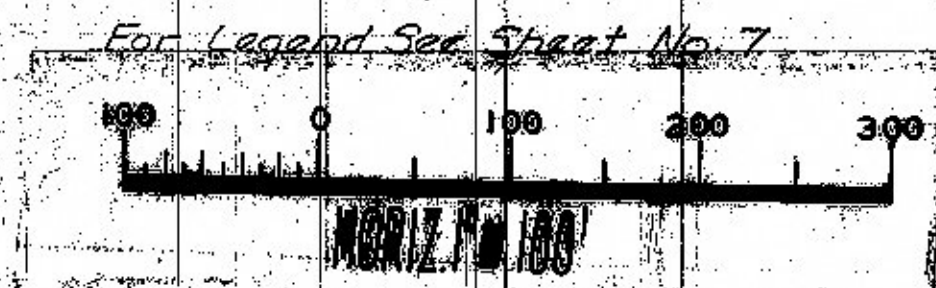

SALINA, KANSAS SANITARY TRUNK LINES EAST MAIN: STA. 96+81 to 130+43 CRAWFORD STREET FORCE MAIN STA. 16+13 to 36+52		DATE: April 1961 FILE NO.: 60-170 SHEET NO. 6 OF 15
		<b>WILSON &amp; COMPANY</b> ENGINEERS SALINA - KANSAS