


TBM - Step spike in fence post approximately twenty feet East of intersection of two fences. Approximately 5/16 mile East of intersection of East Republic and Ohio Street. Elev. 1224.47

TBM - Step spike in fence post six feet South of intersection of two fences. Approximately 1/4 mile East of intersection of E. Jewell and Ohio Street. Elev. 1229.691

TBM - Railroad spike in sixth telephone pole East of intersection of East Cloud and Ohio Street. First telephone pole West of R.L. Reed residence. Elev. 1229.996

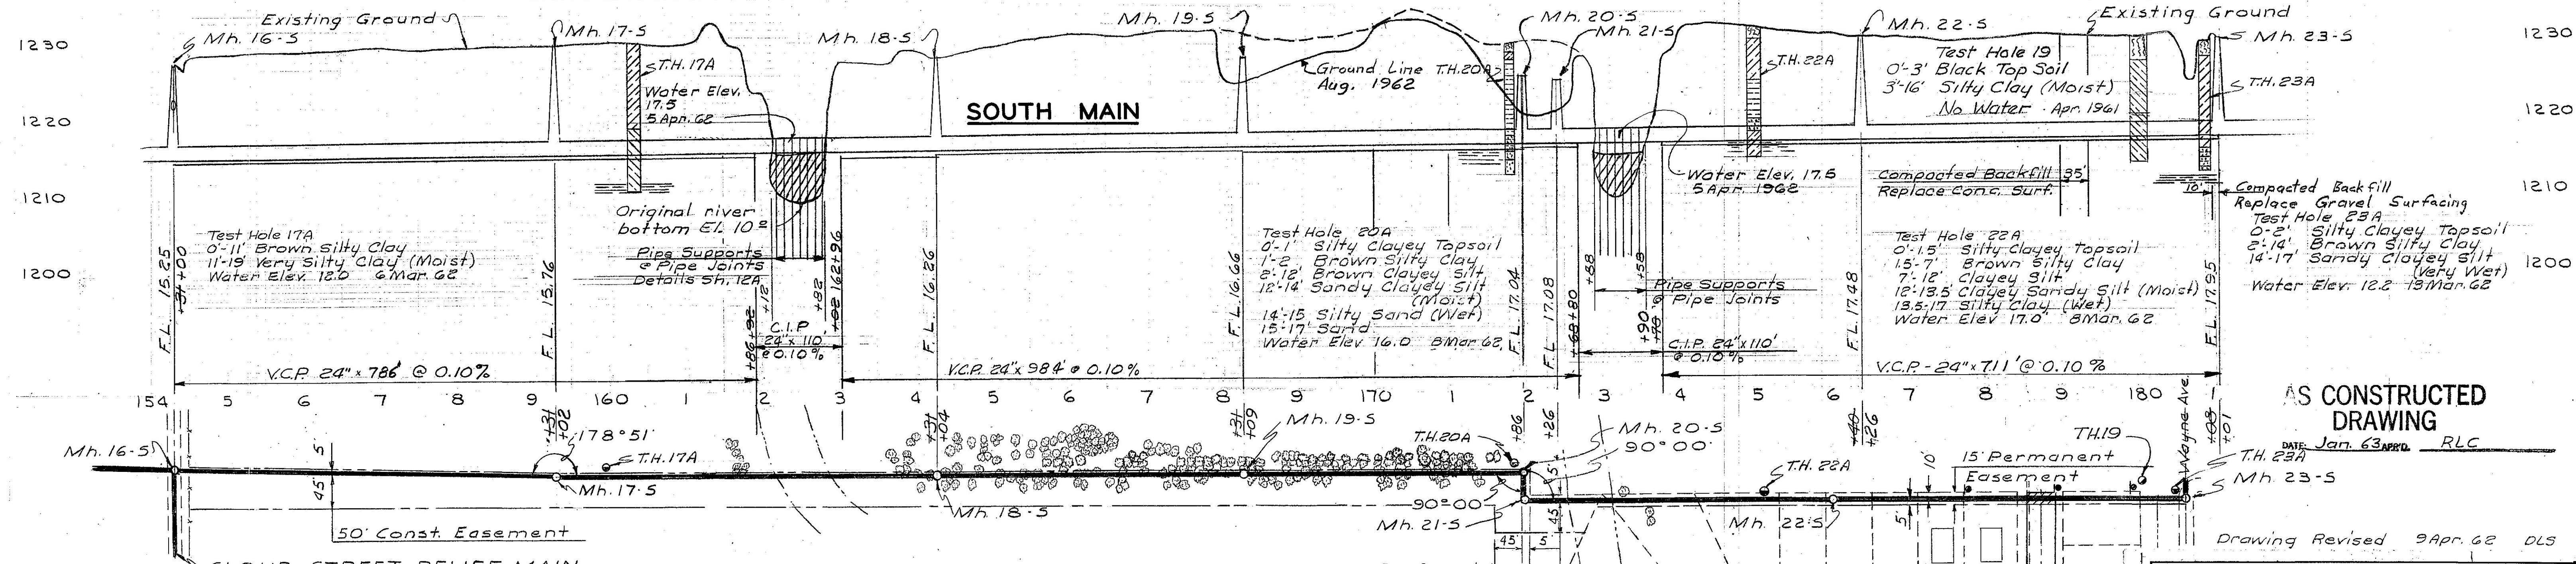

A.L. GARINGER

AS CONSTRUCTED DRAWING

DATE: Jan. 63 APPRO. RLC

Drawing Revised 9 Apr. 62 DLS

TBM - 3/8" silver bar in a seventy-five inch tree on South bank of river bank. On East edge of drainage ditch. Approximately 1/4 mile East of Ohio St. and 3/16 mile North of Wayne Street. Elev. 1231.576

TBM - Railroad spike driven in telephone pole 1/4 mile East of intersection of Ohio St., Wayne St., & Belmont Blvd. Elev. 1231.311

SALINA, KANSAS SANITARY TRUNK LINES SOUTH MAIN: STA. 126+50 TO 181+00		DATE: April 1961
		FILE NO. 60-17D
WILSON & COMPANY ENGINEERS & ARCHITECTS SALINA - KANSAS		SHEET NO. 8 OF 15