

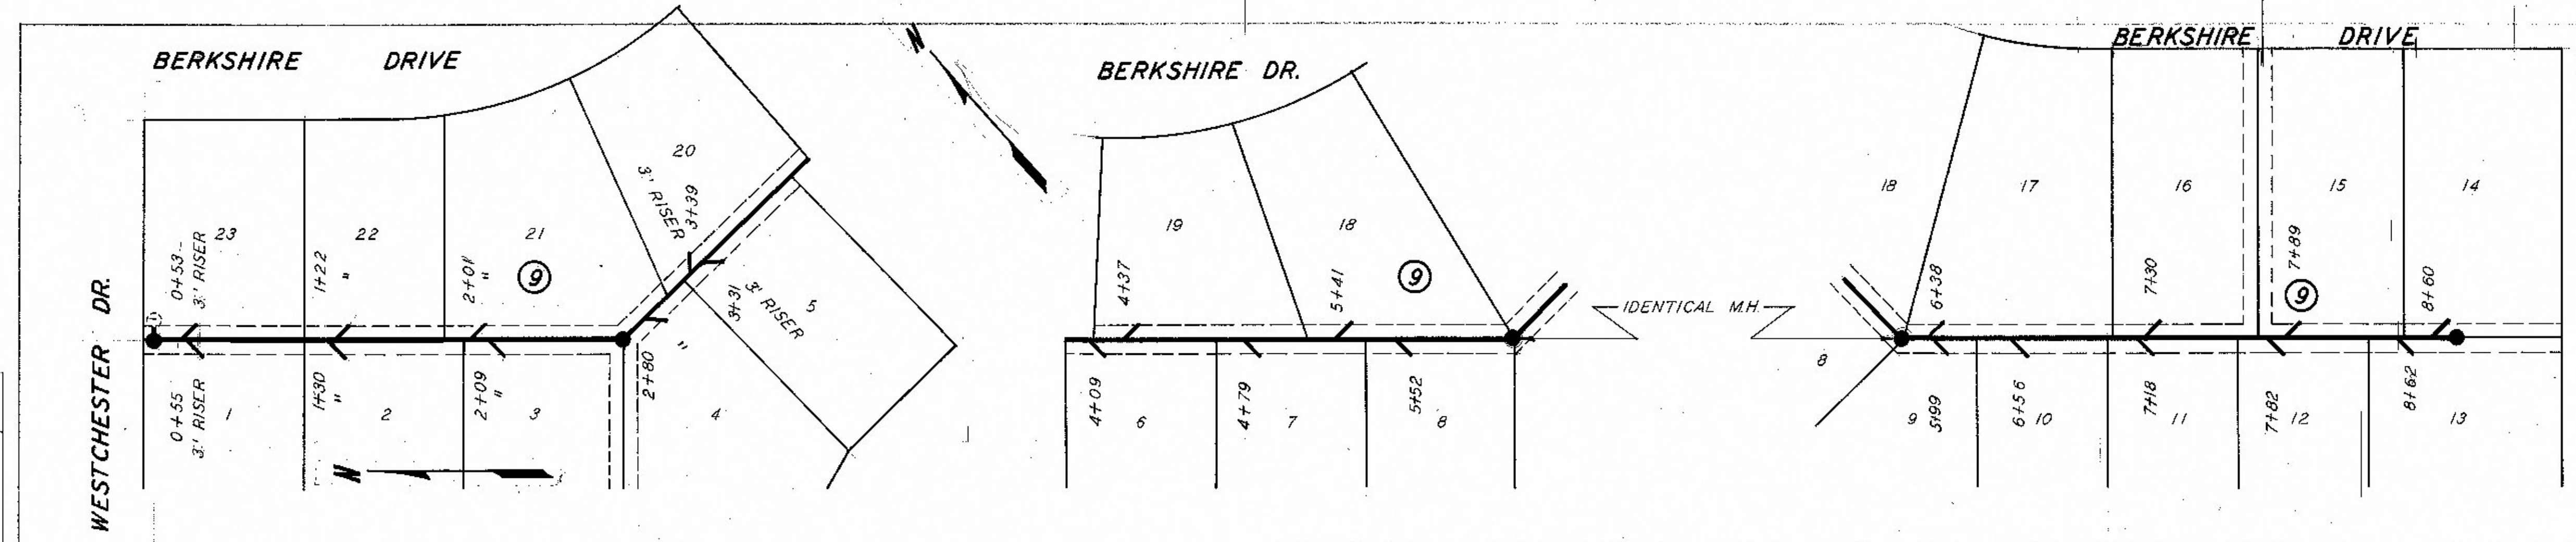
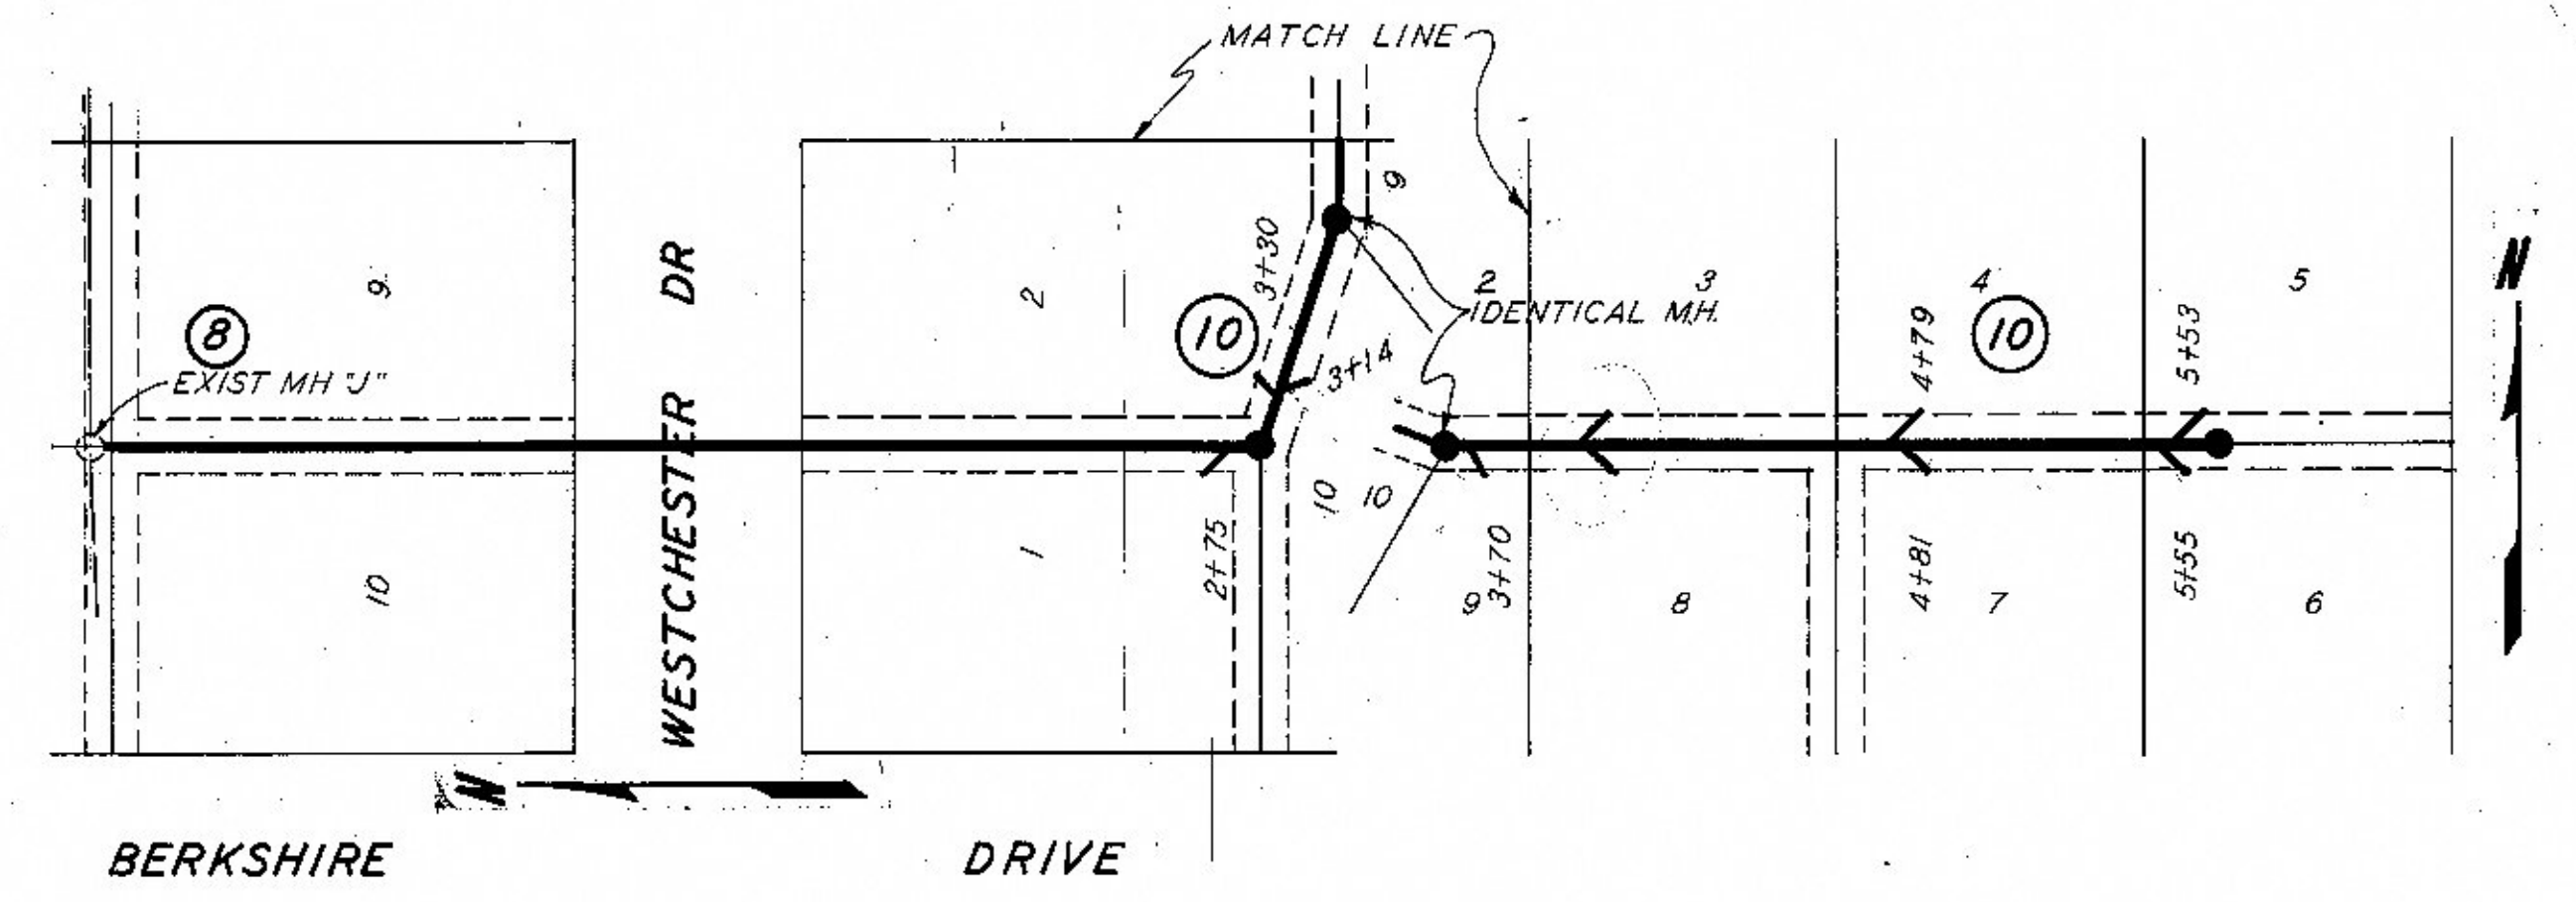


AS-BUILT
CONST. BY: CONSTRUCTION INDUSTRIES
JAN. 1963

SO. DELAWARE

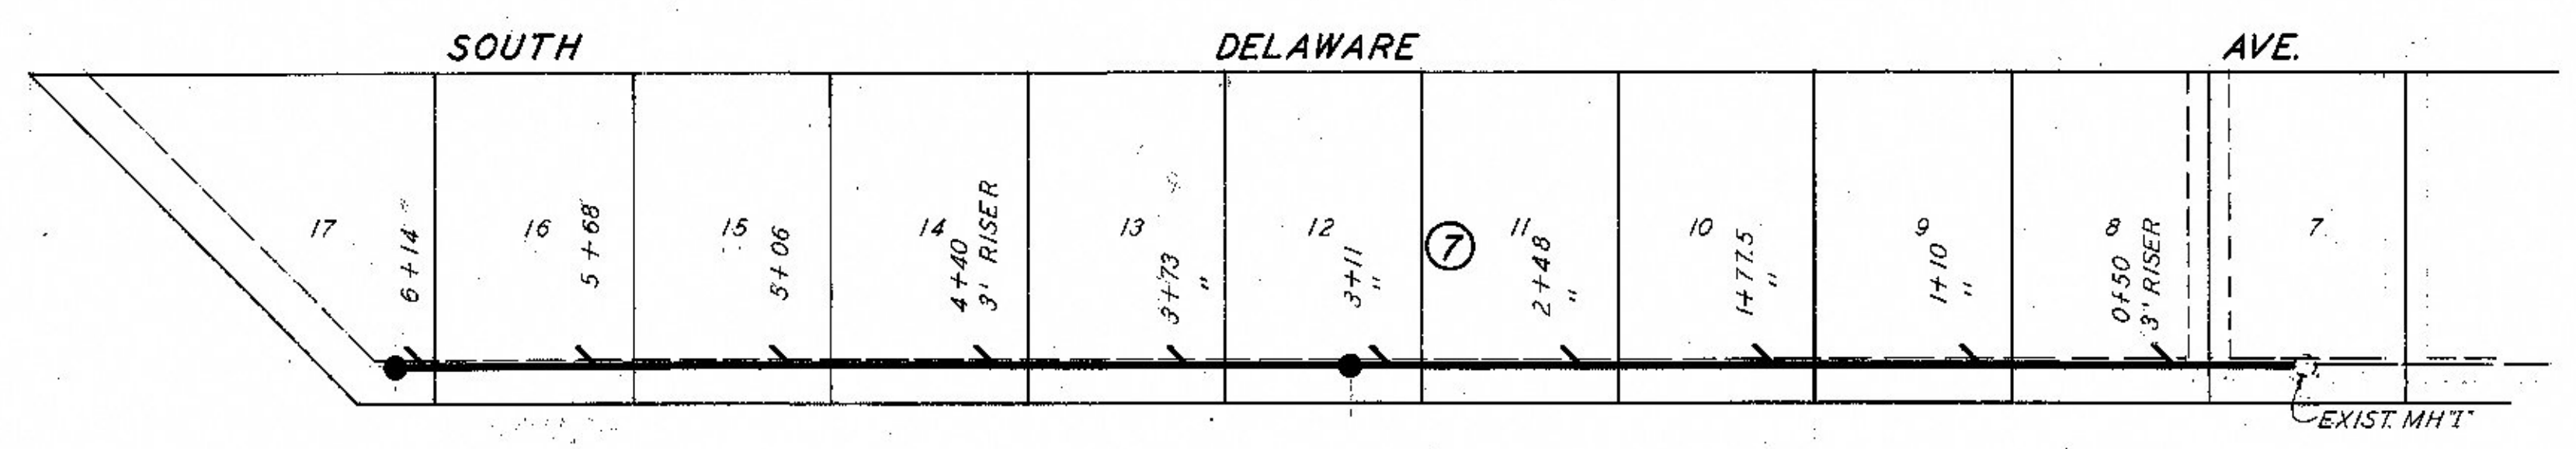

PLAN	SURVEYED	DATE
	PLOTTED	BY
	CHECKED	
	BY	
	NO. OF MAN CHECKED	
	NO.	

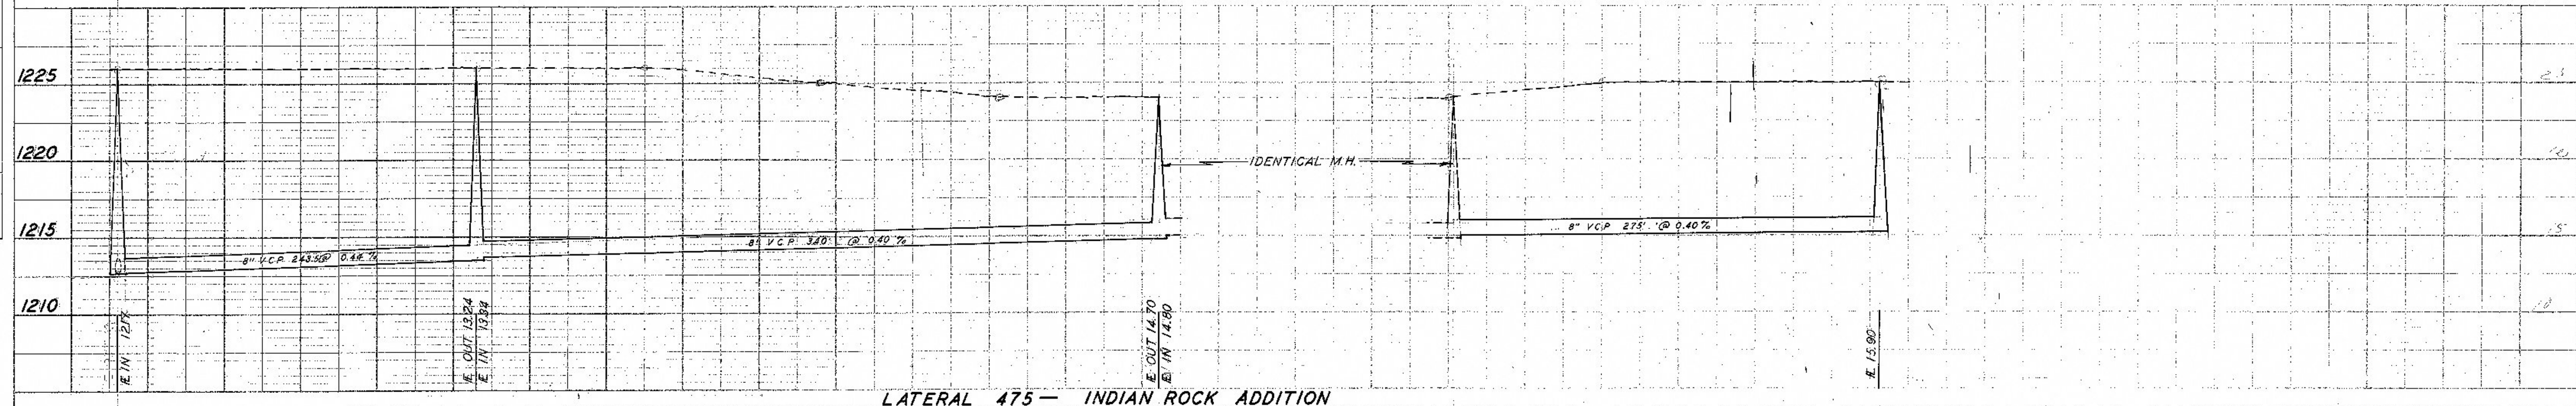

PROFILE	SURVEYED	DATE
	PLOTTED	BY
	CHECKED	
	BY	
	NO. OF MAN CHECKED	
	NO.	

