


PLAN  
 SHEET NO. 1  
 PROJECT NO. 100-100-100  
 DATE: 8/1/63

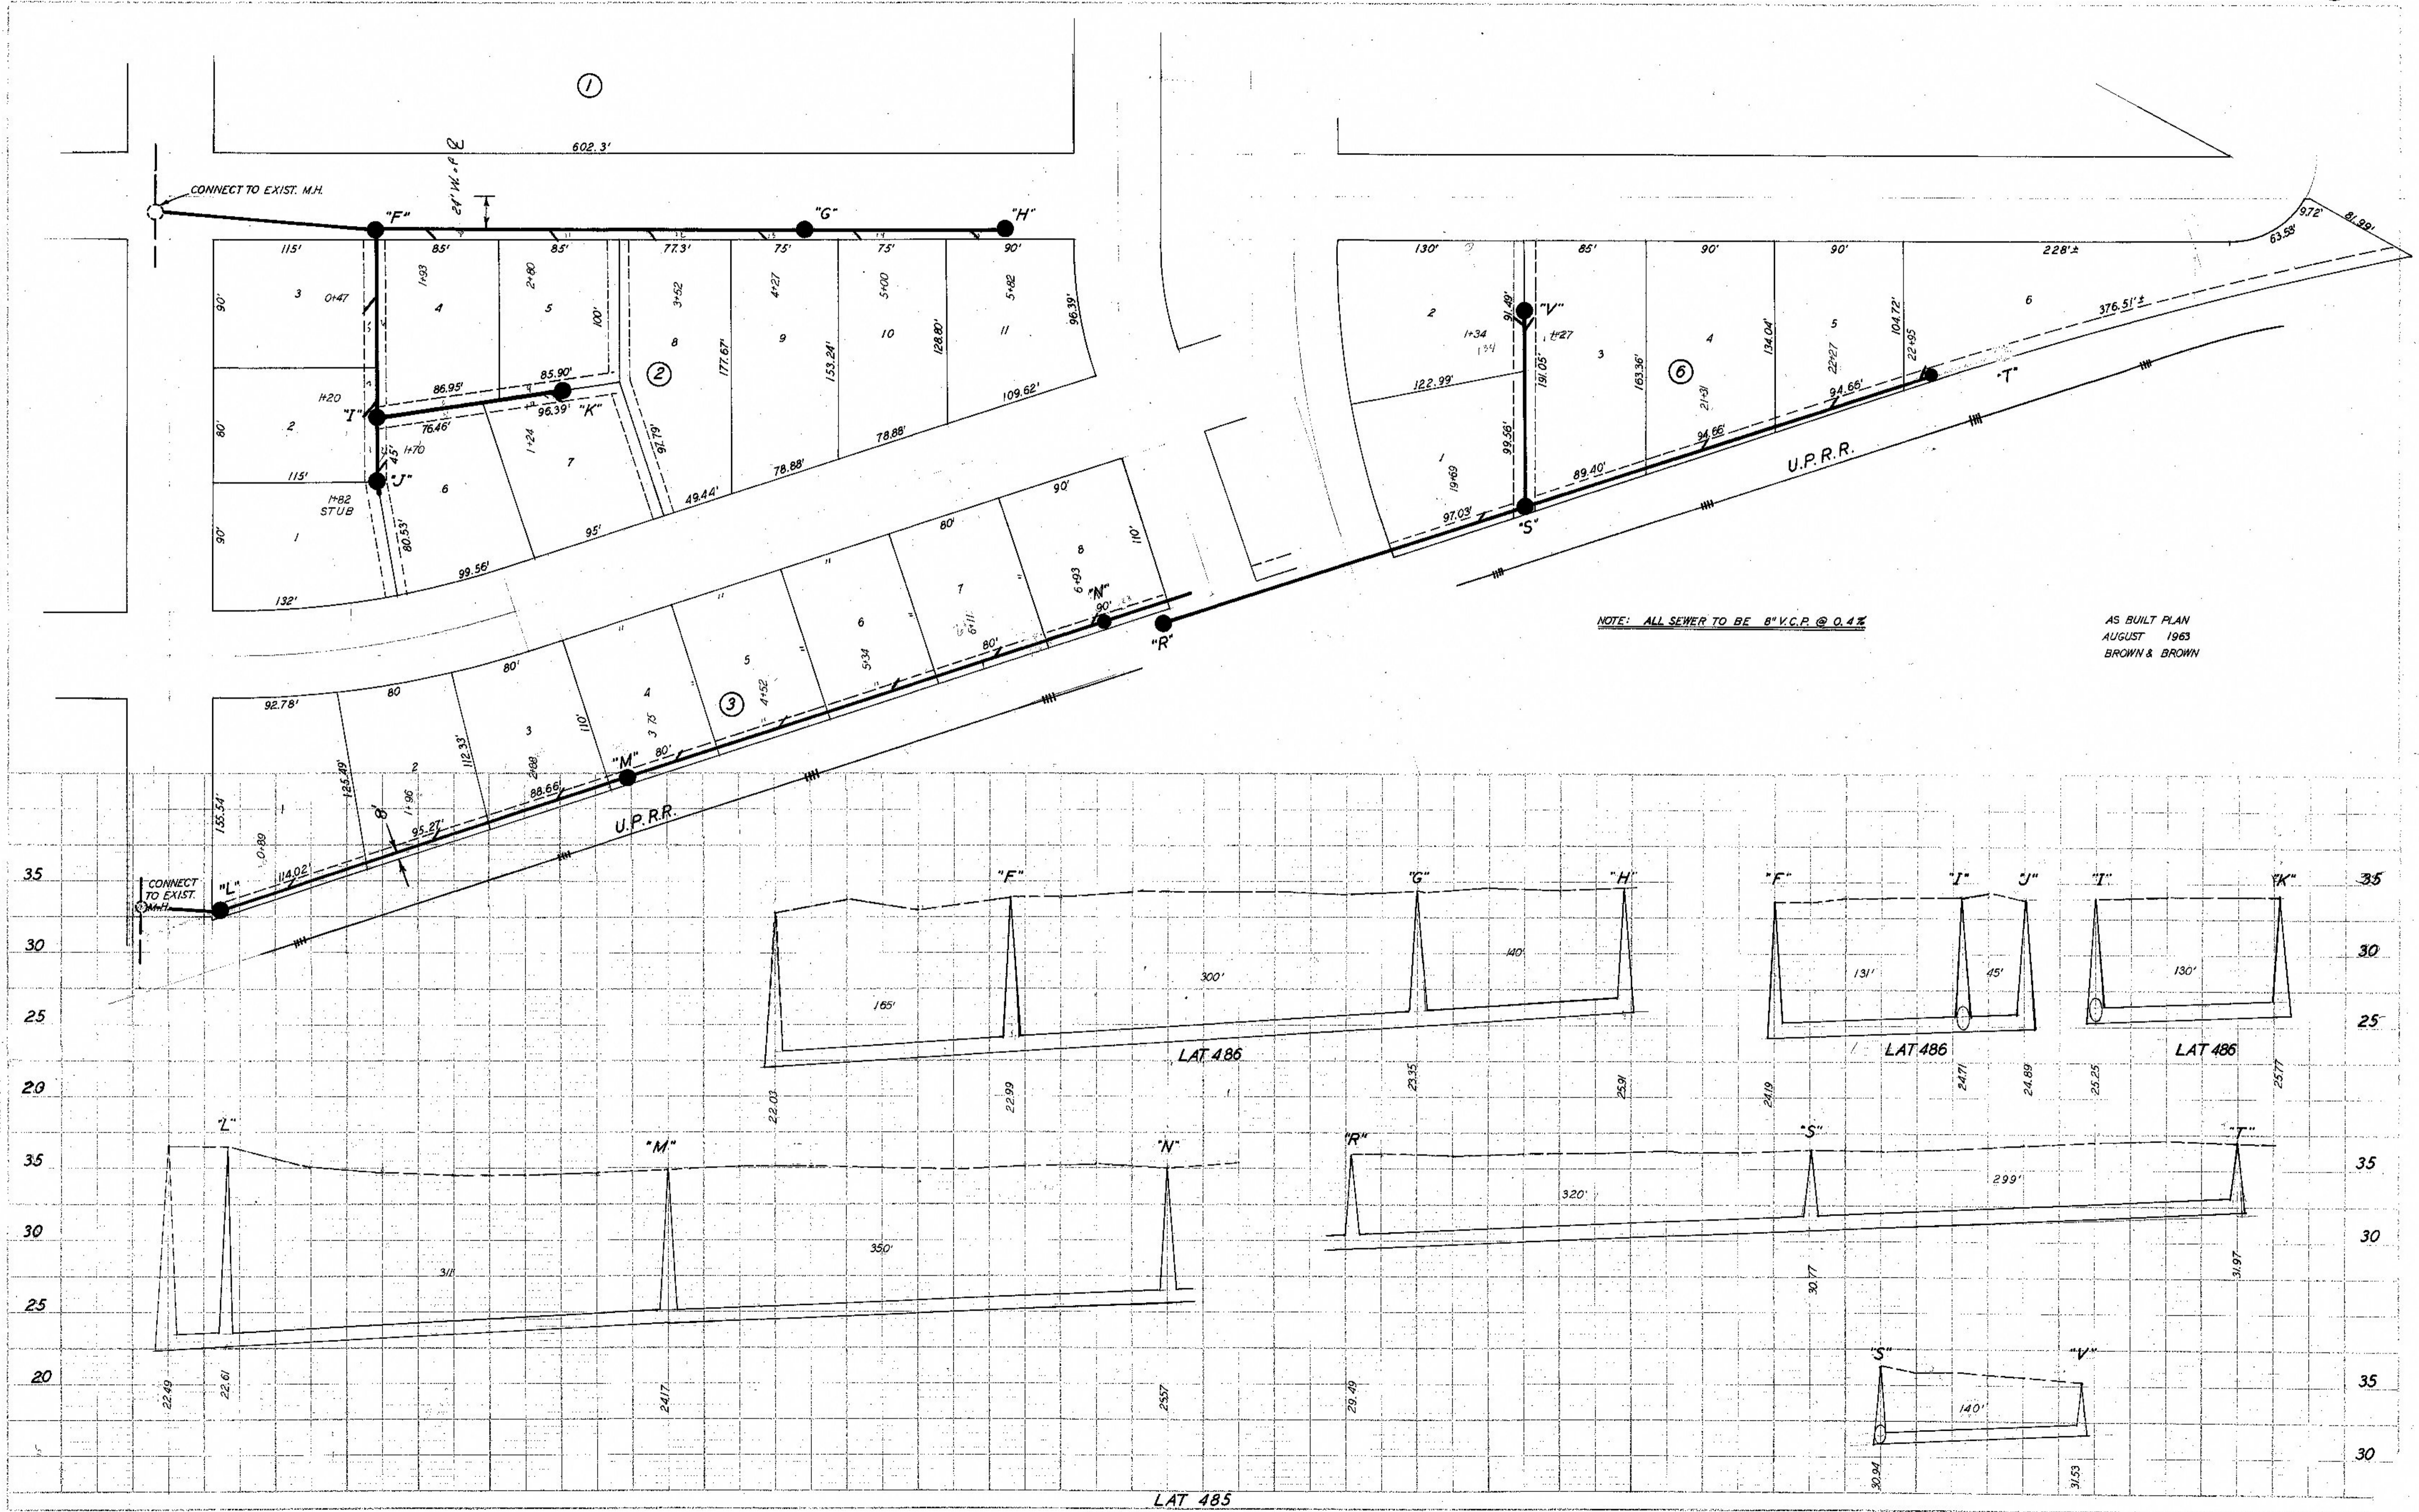

NOTE: ALL SEWER TO BE 8" V.C.P. @ 0.4%

AS BUILT PLAN  
 AUGUST 1963  
 BROWN & BROWN