
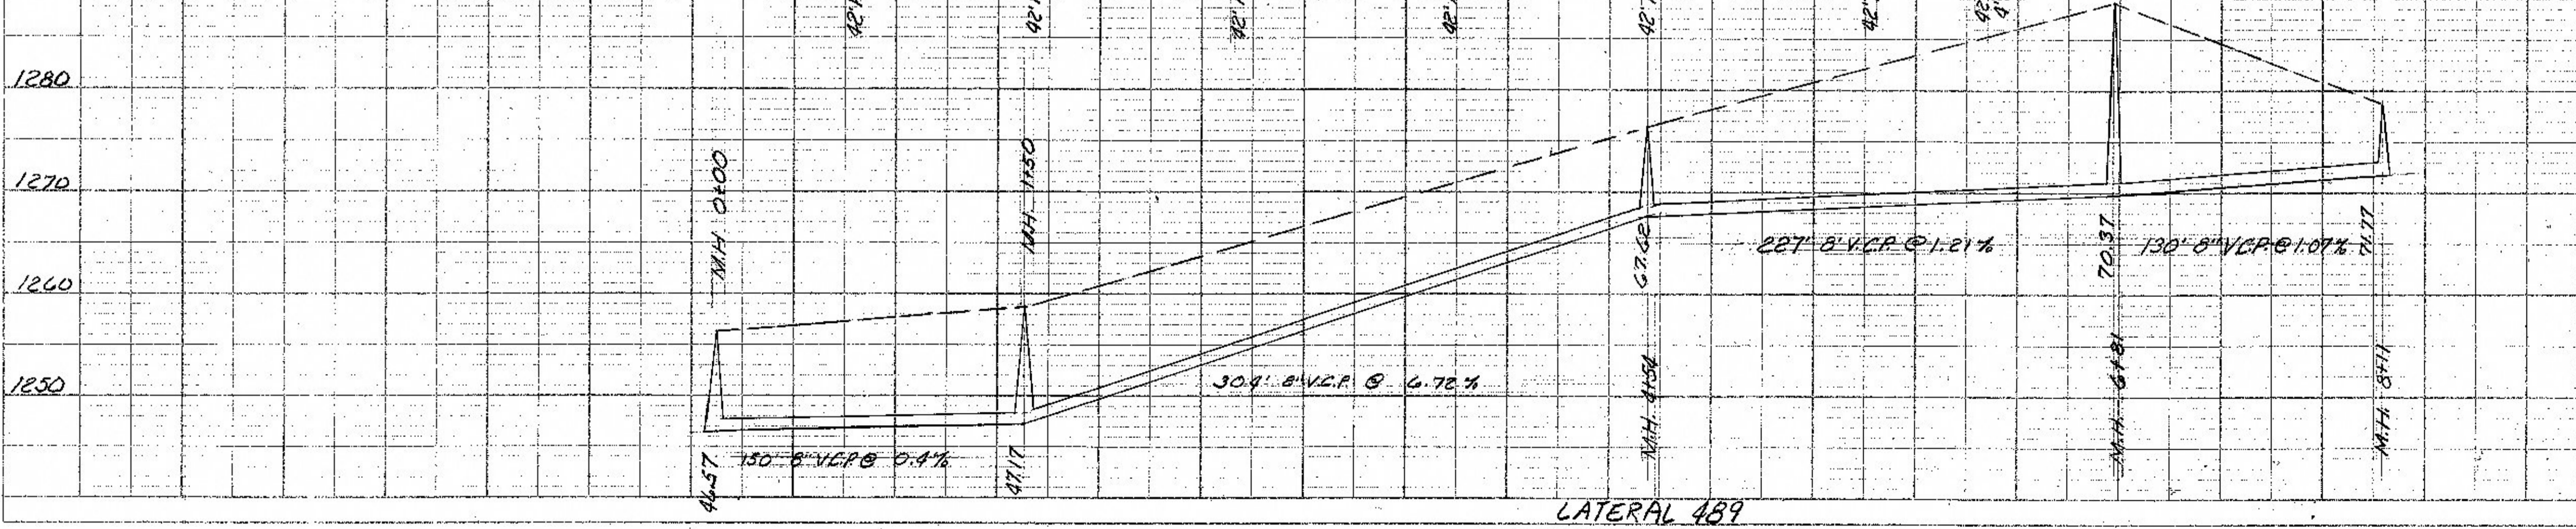
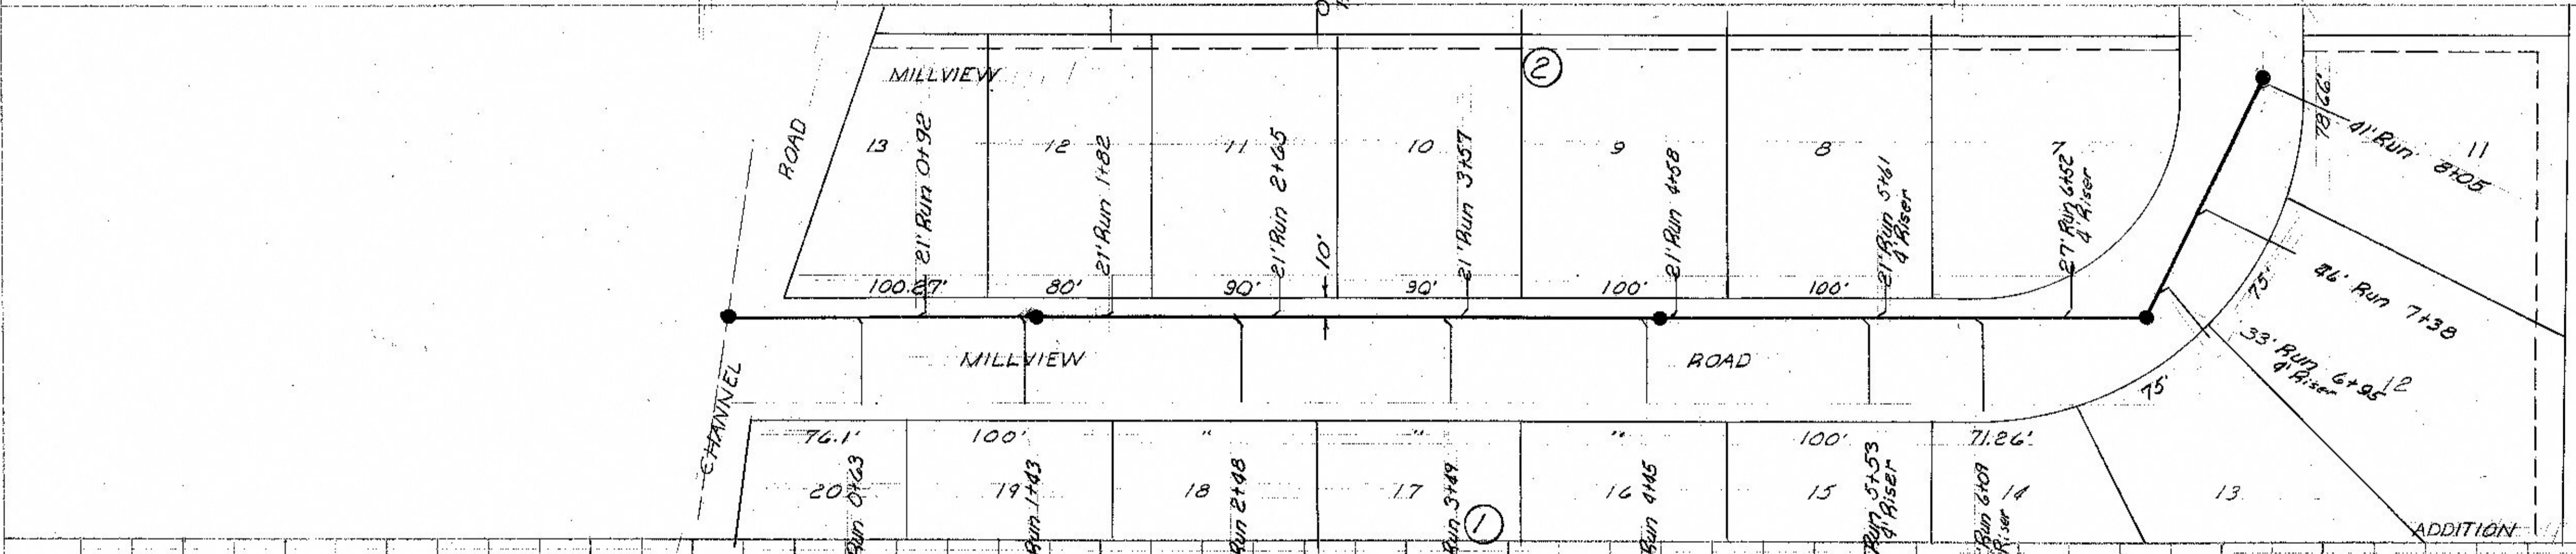
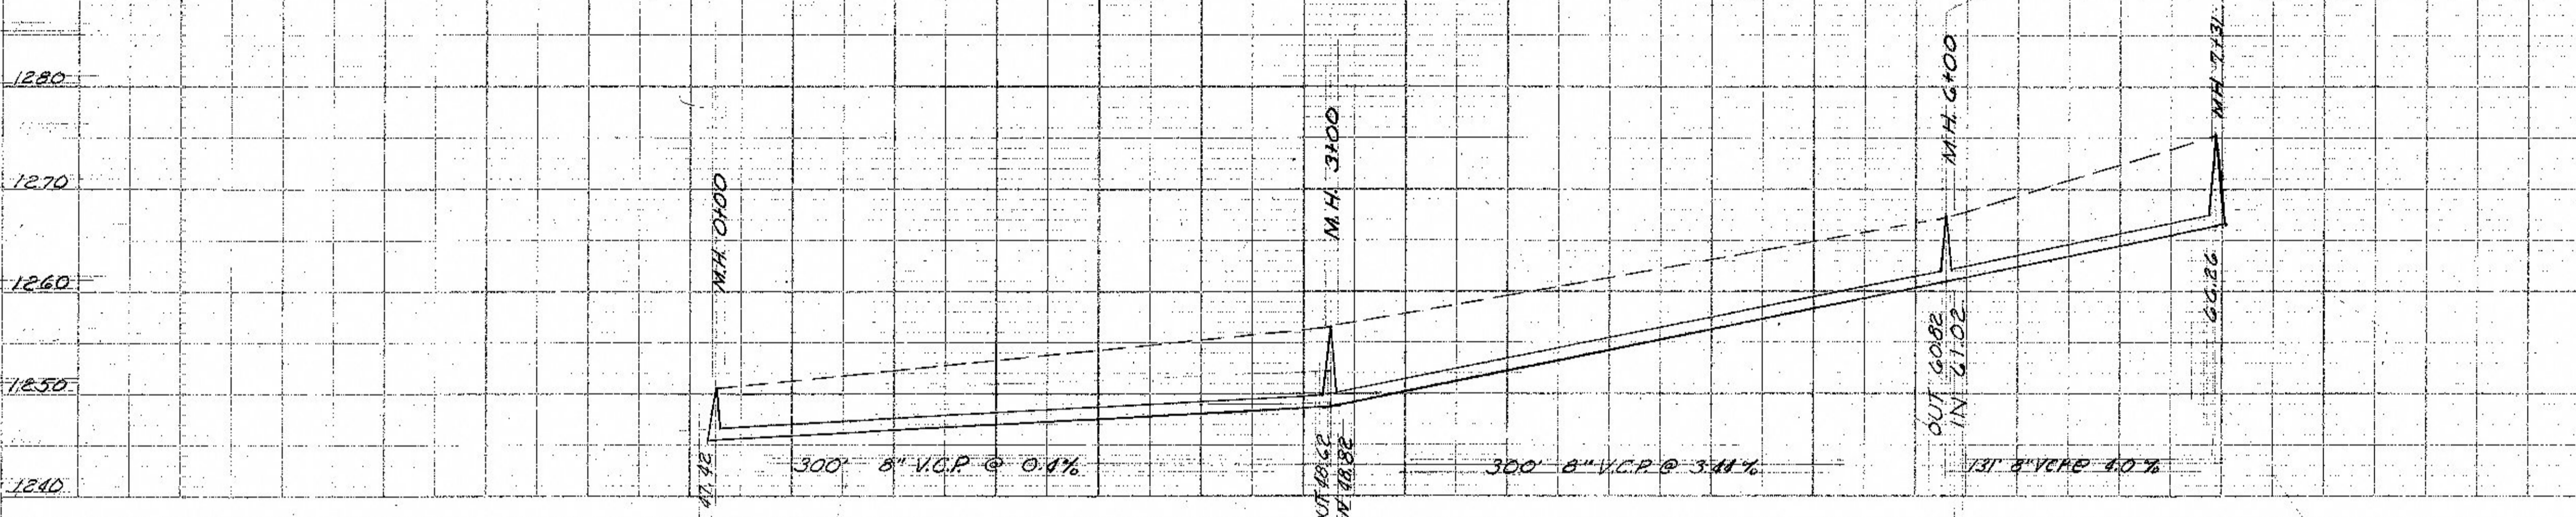


DATE _____ BY _____
 PLAN SURVEYED _____
 PLOTTED _____
 CHECKED _____
 REVISIONS _____

DATE _____ BY _____
 PROFILE SURVEYED _____
 PLOTTED _____
 CHECKED _____
 REVISIONS _____

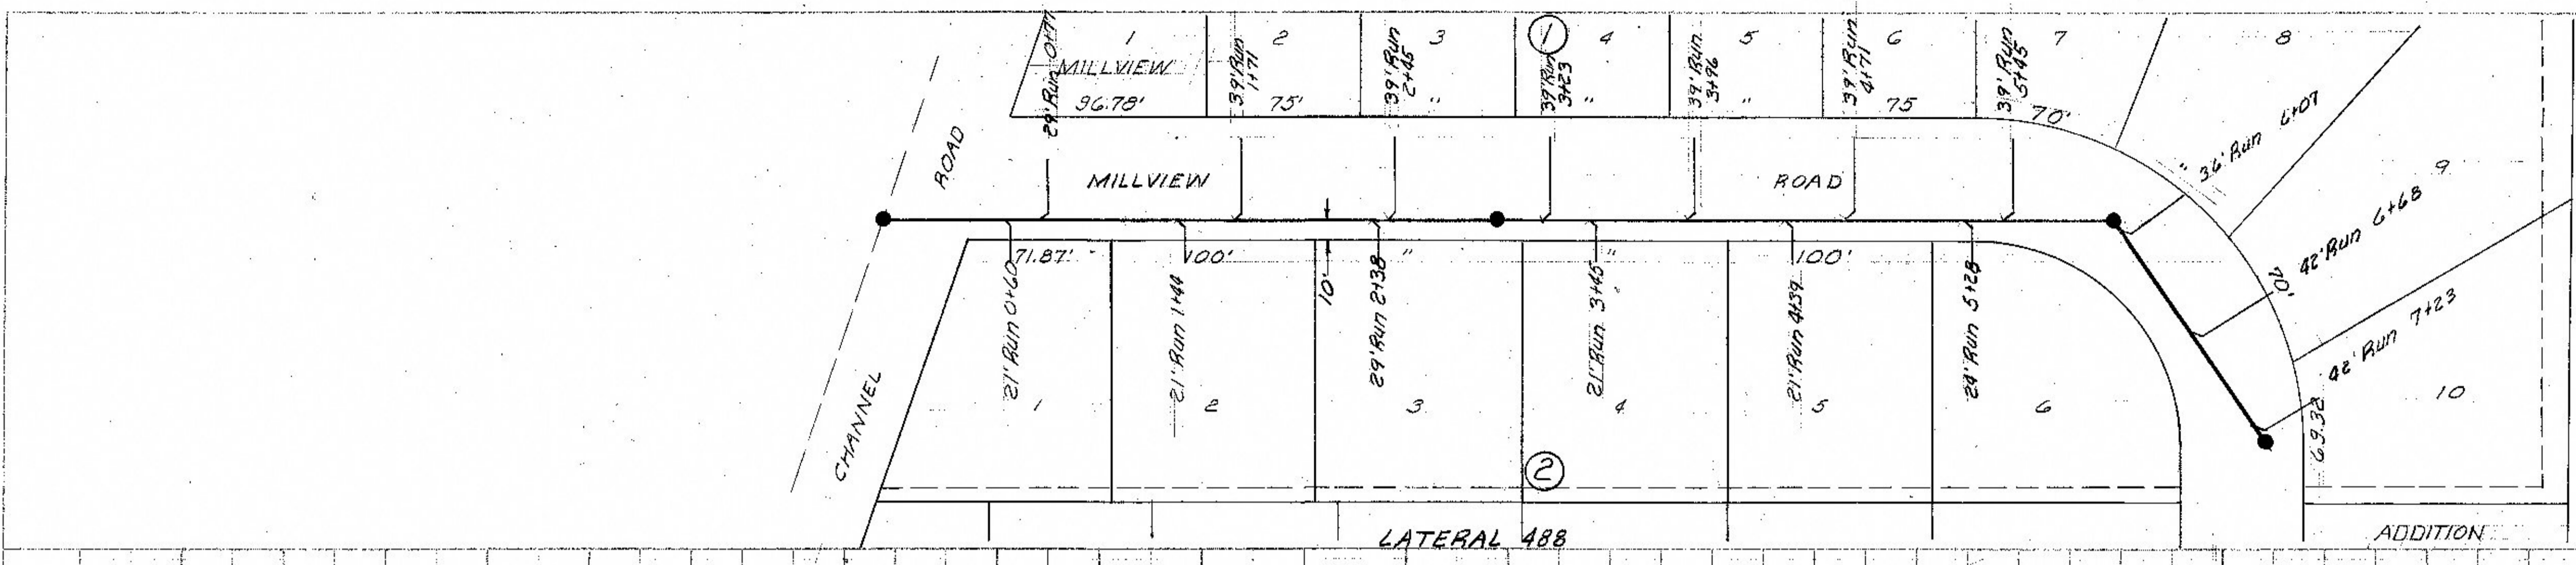

LATERAL 489
 PLATE 2-191 PLAN - PROFILE 0.1" = 1' HORIZ. STANDARD
 100' = 1" VERT. SCALE AND FINISHED IN 1" = 1" V. SCALE
 ENGINEER: WILHELM, C. D.

"As-Built Plan"
 Brown & Brown Const. Co.
 January 1964