



PLAN	DATE
BY	
CHECKED	
APPROVED	
DATE	

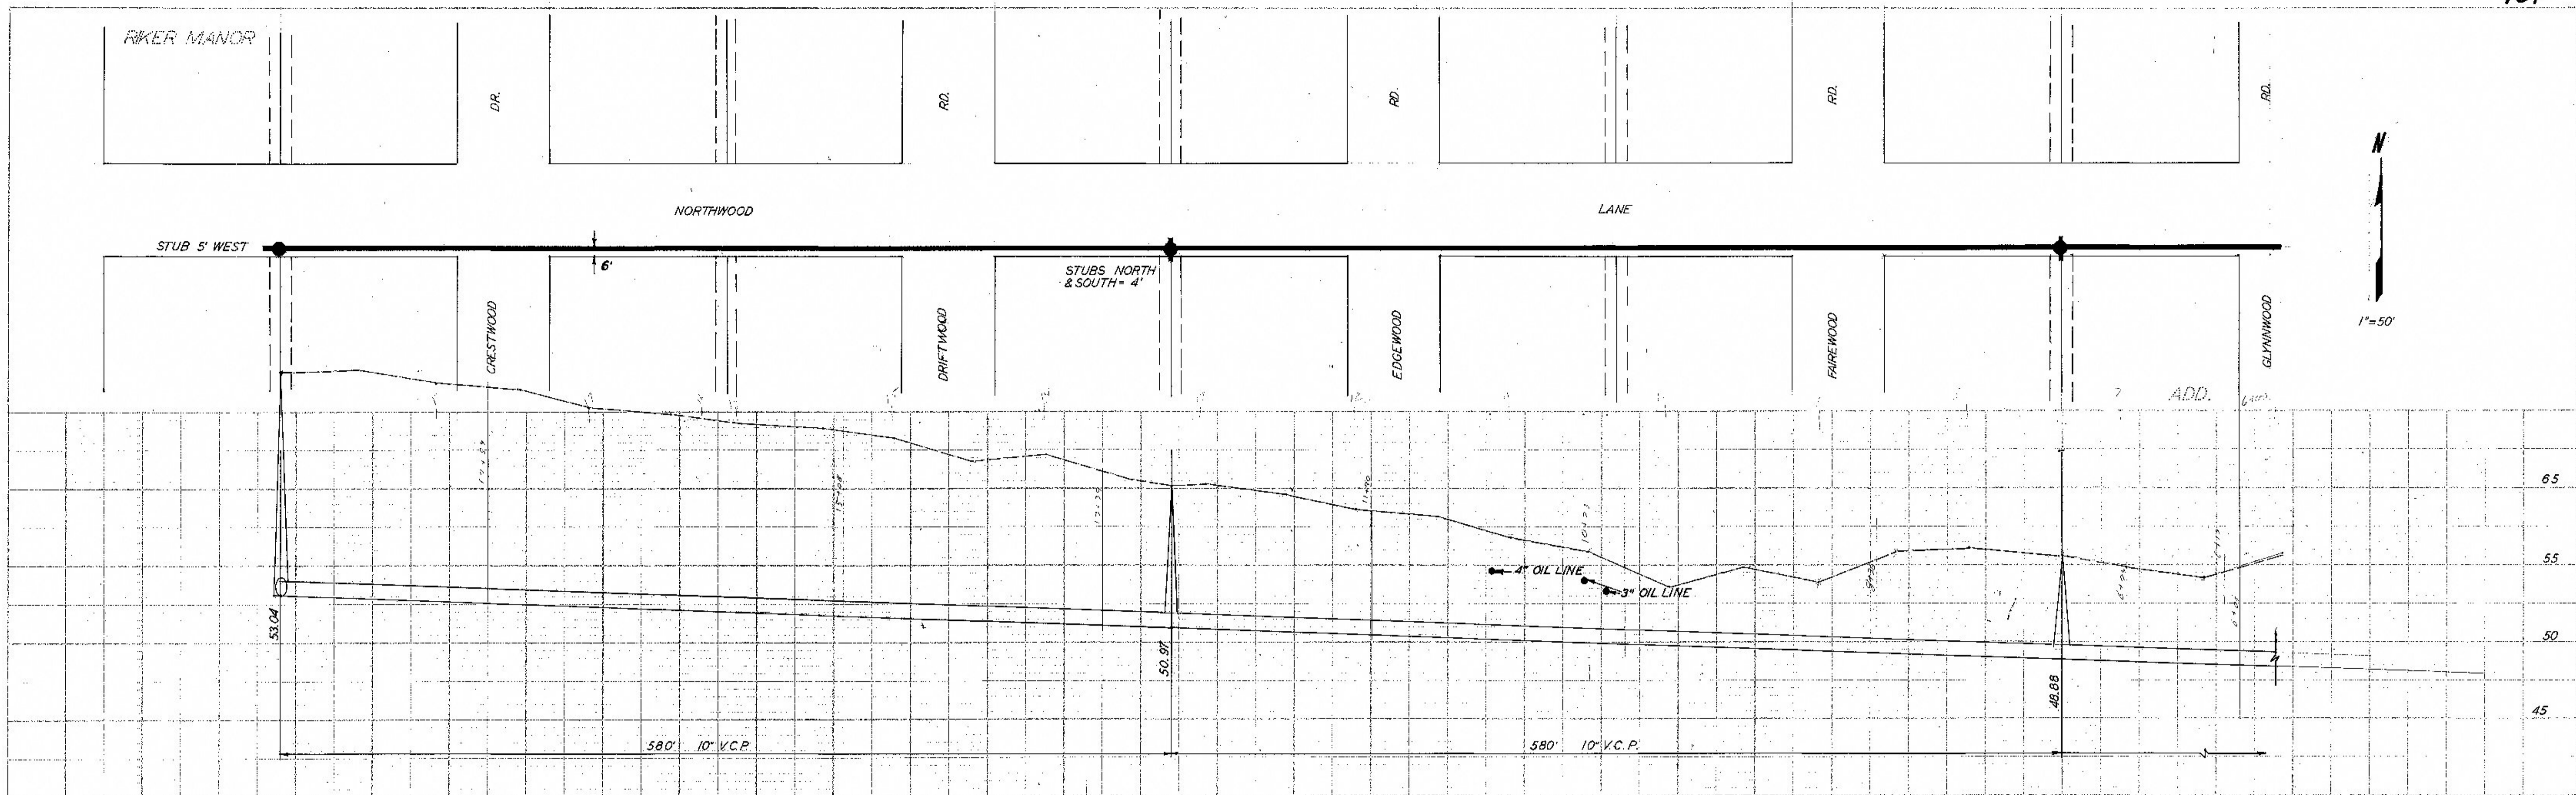

PROFILE	DATE
BY	
CHECKED	
APPROVED	
DATE	

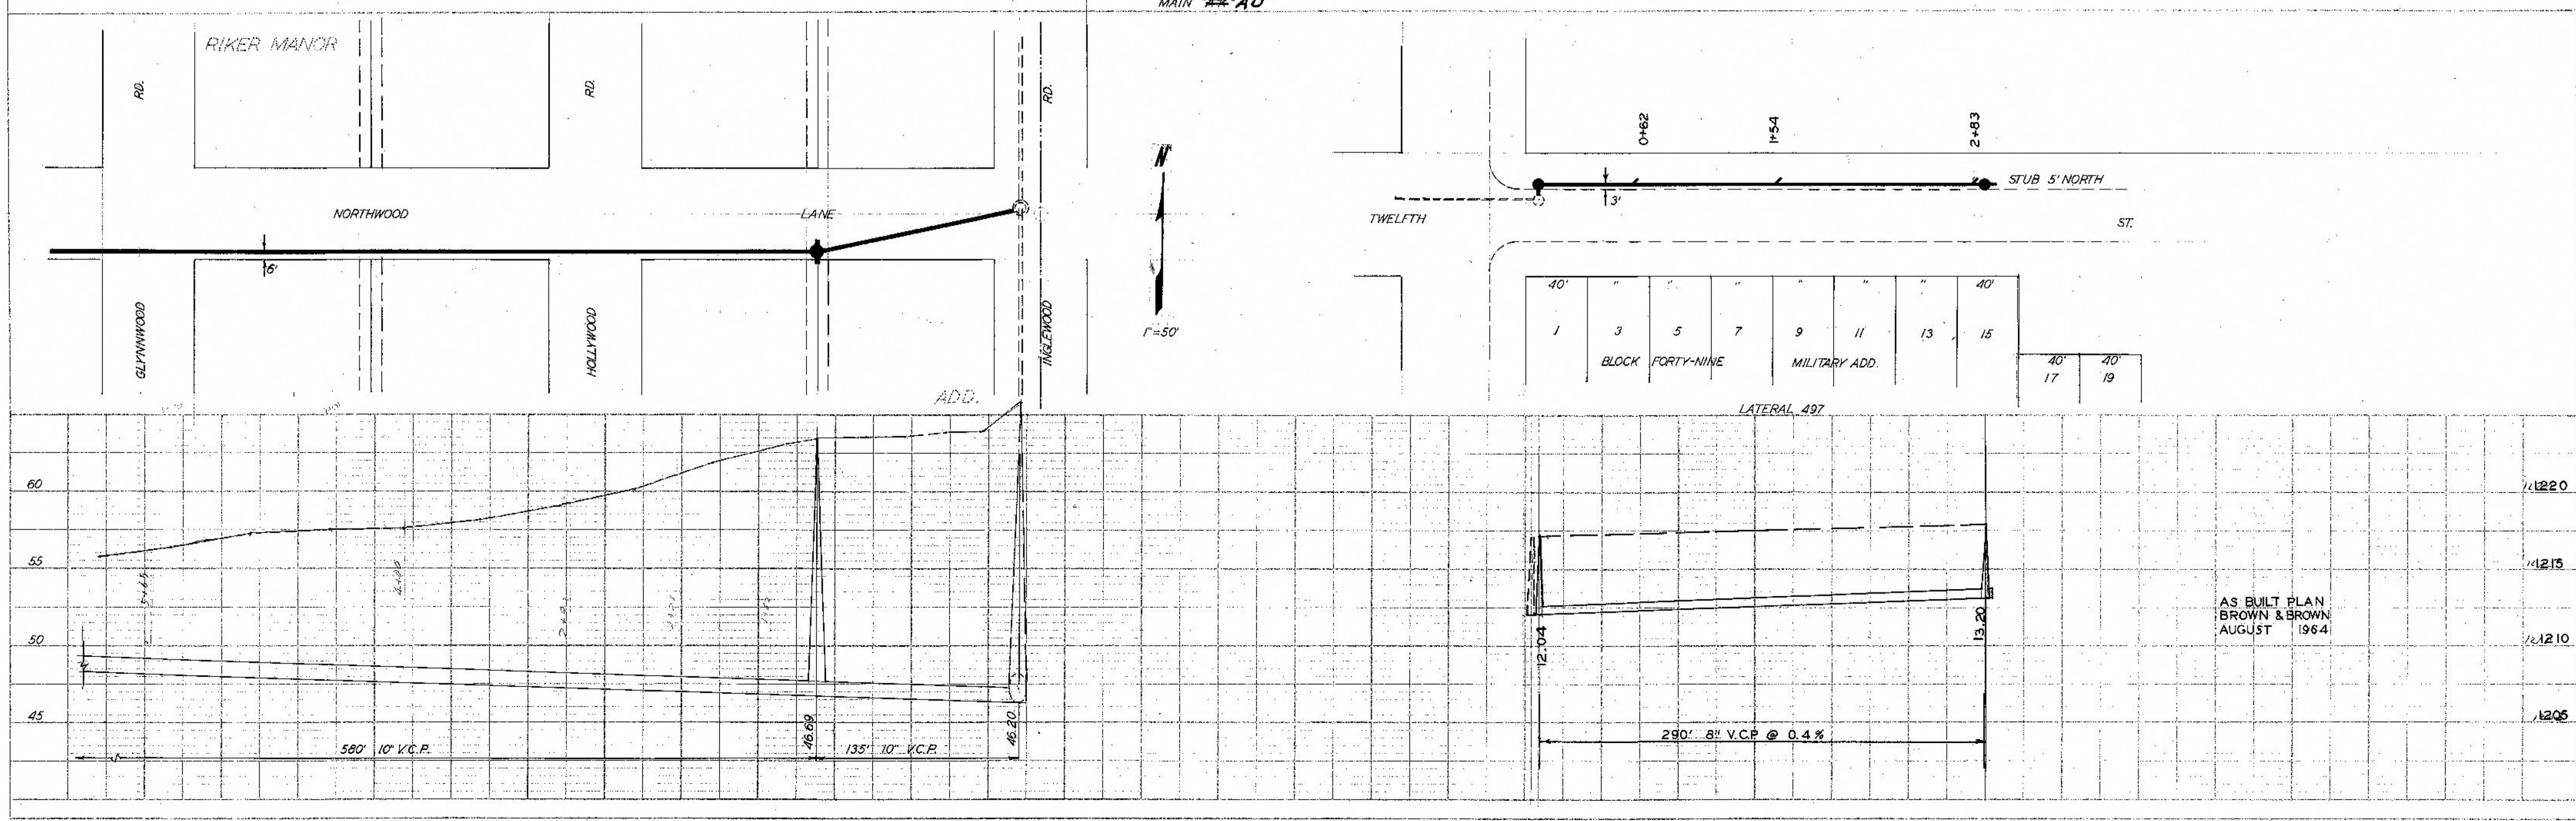

AS BUILT PLAN
BROWN & BROWN
AUGUST 1964