
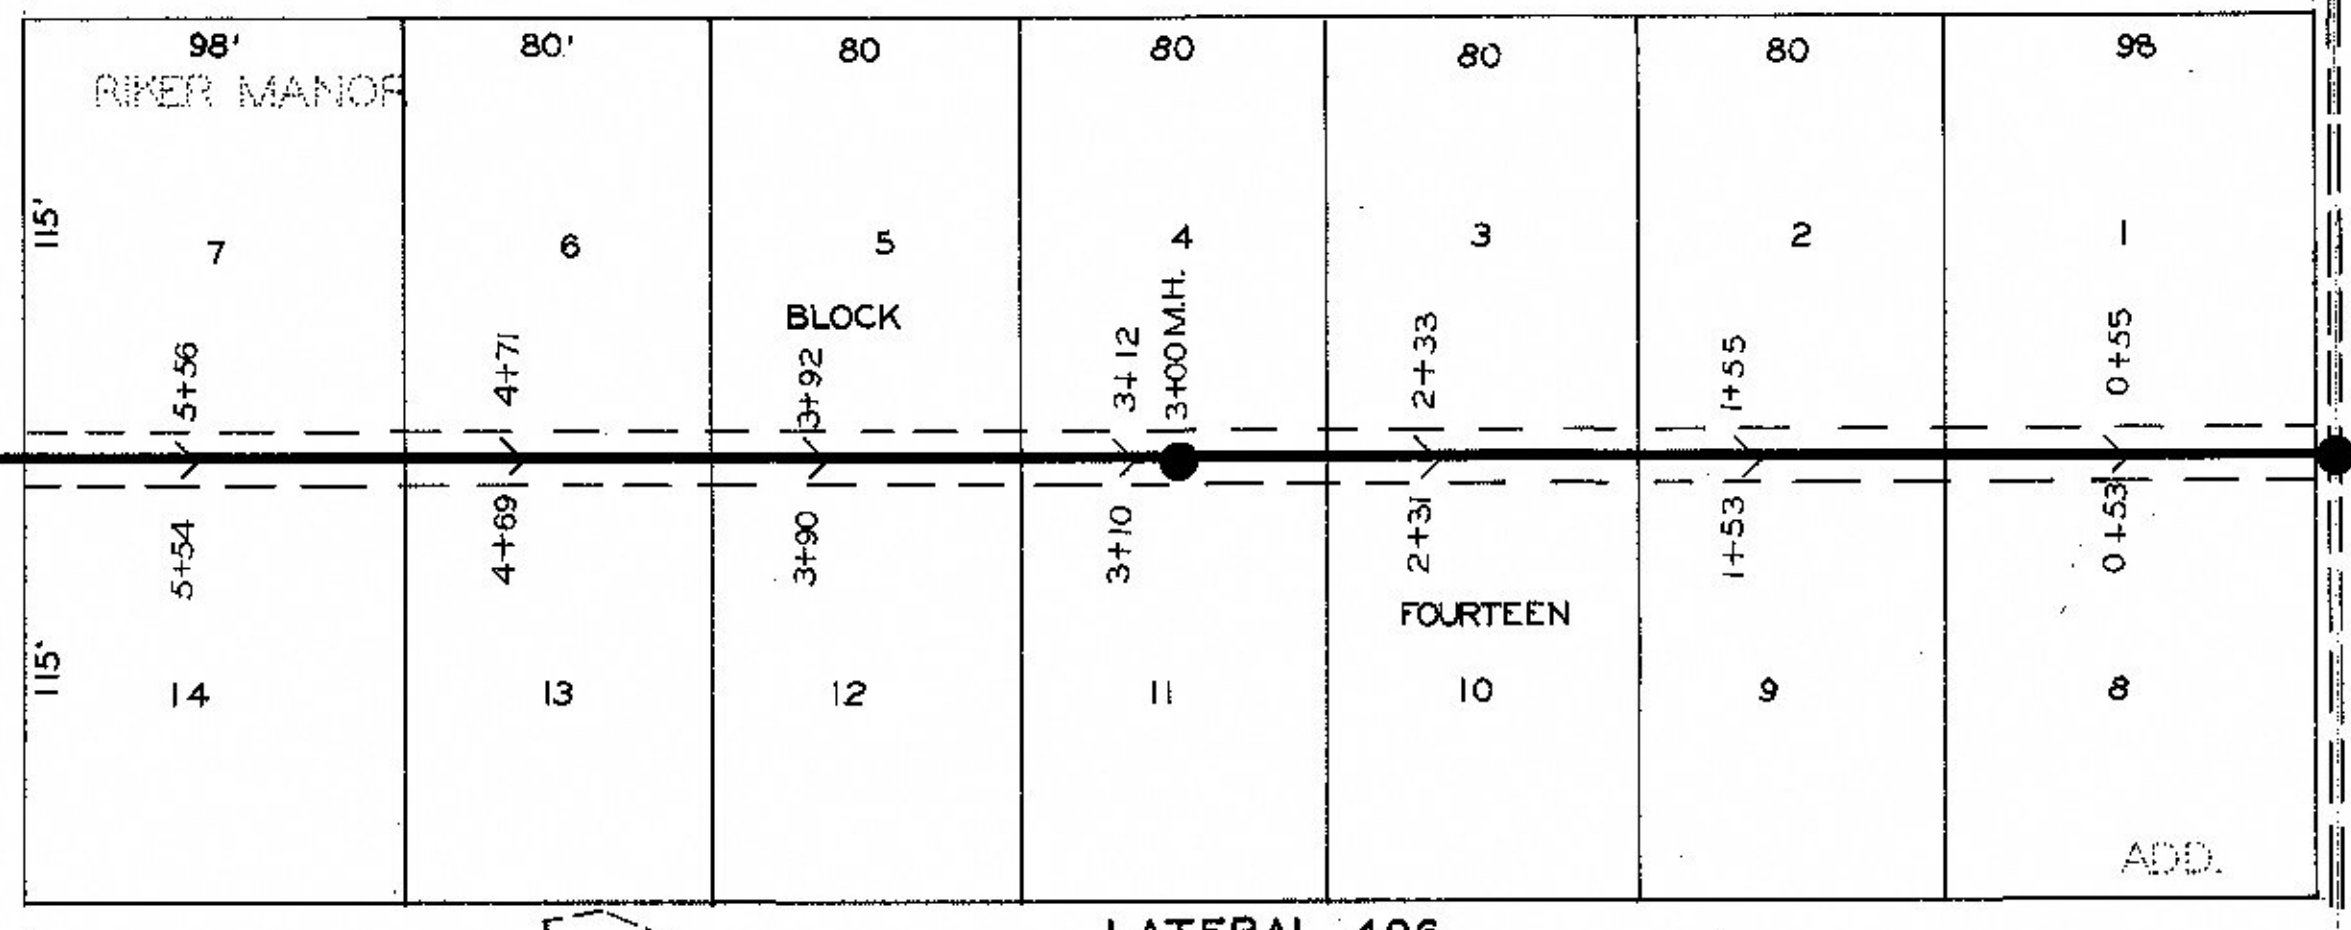


PLAN SURVEYED BY DATE
 PLOTTED BY
 NOTE BOOK NO. DATE
 RT. OF WAY CHECKED
 NO. STRUCTURE NOTATIONS CH. NO.



PROFILE SURVEYED BY DATE
 PLOTTED BY
 NOTE BOOK NO. DATE
 STRUCTURE NOTATIONS CH. NO.

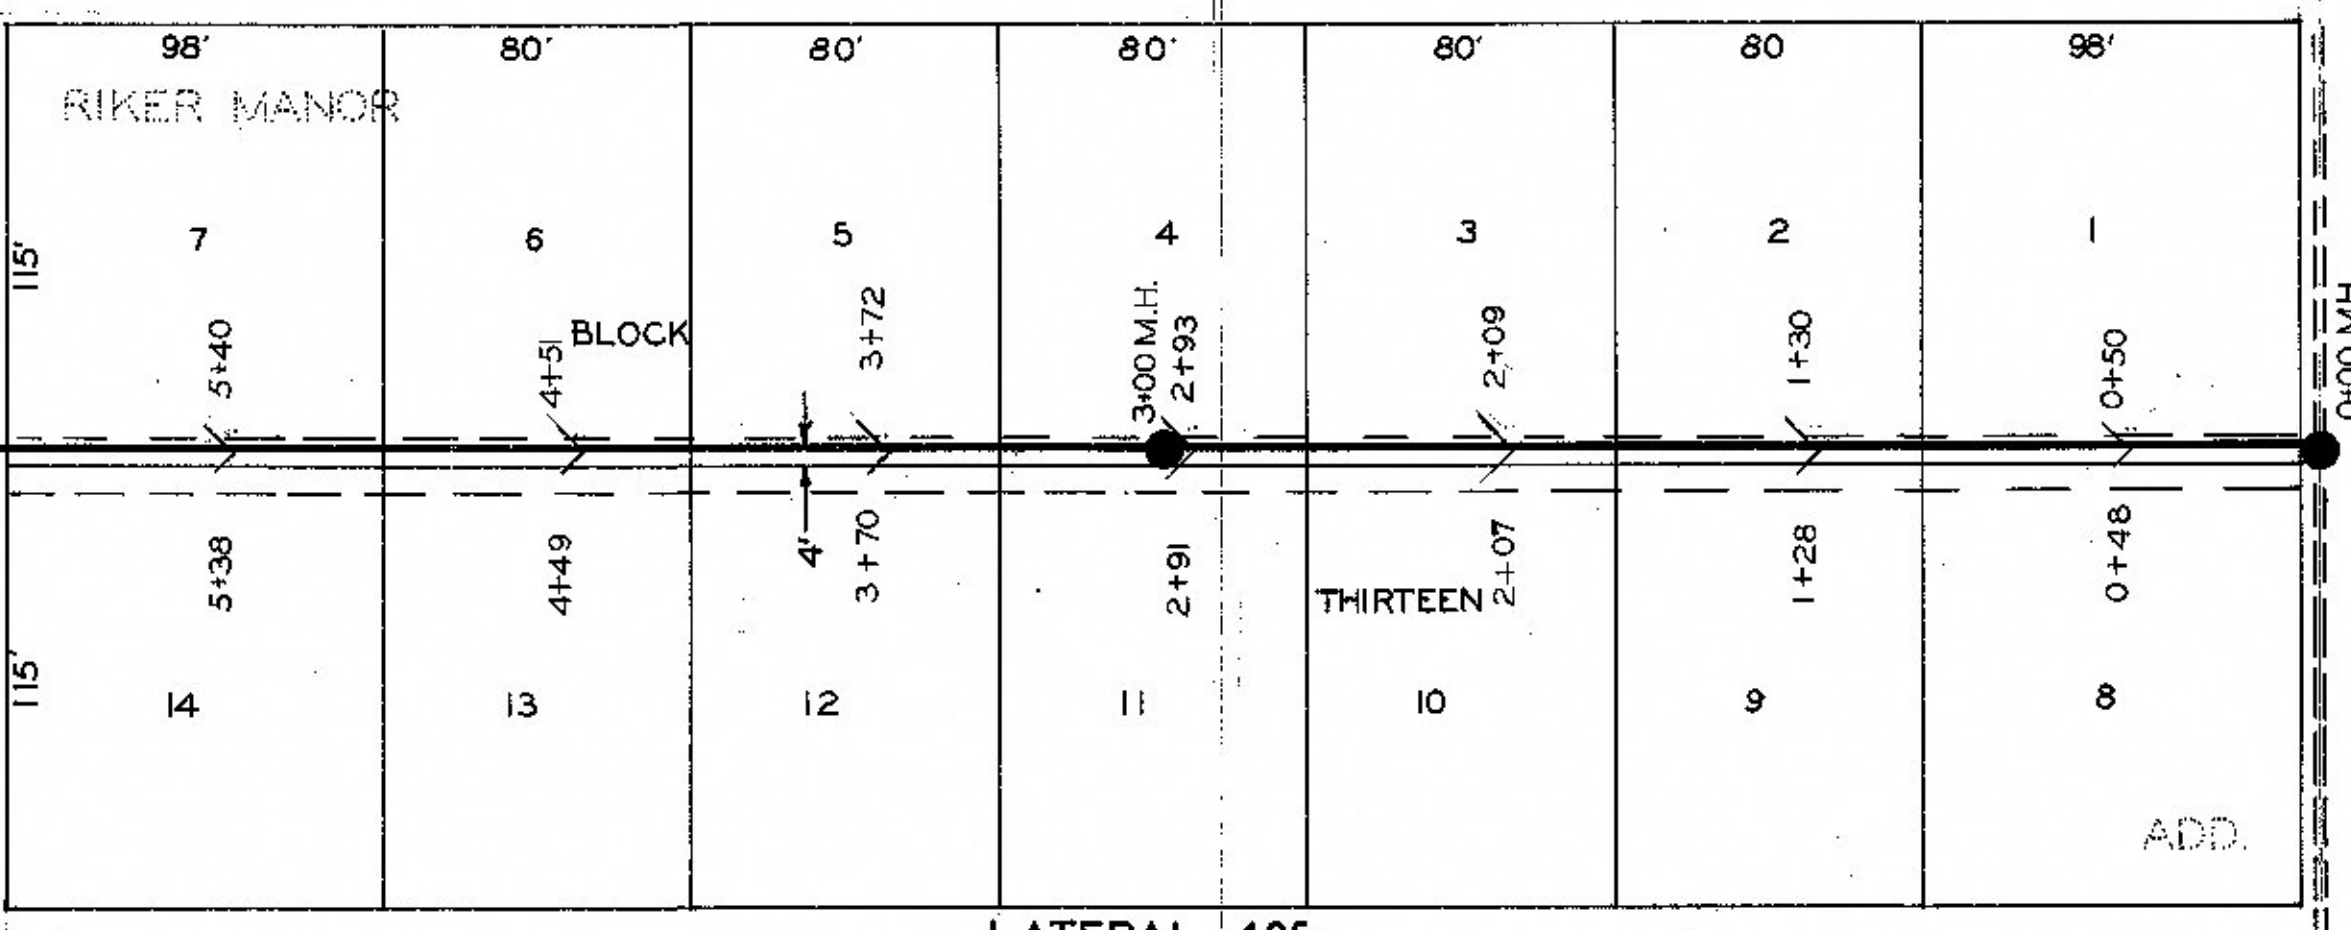

AS BUILT PLAN
 BROWN & BROWN INC.
 JANUARY 1965

LATERAL 495

LATERAL 496

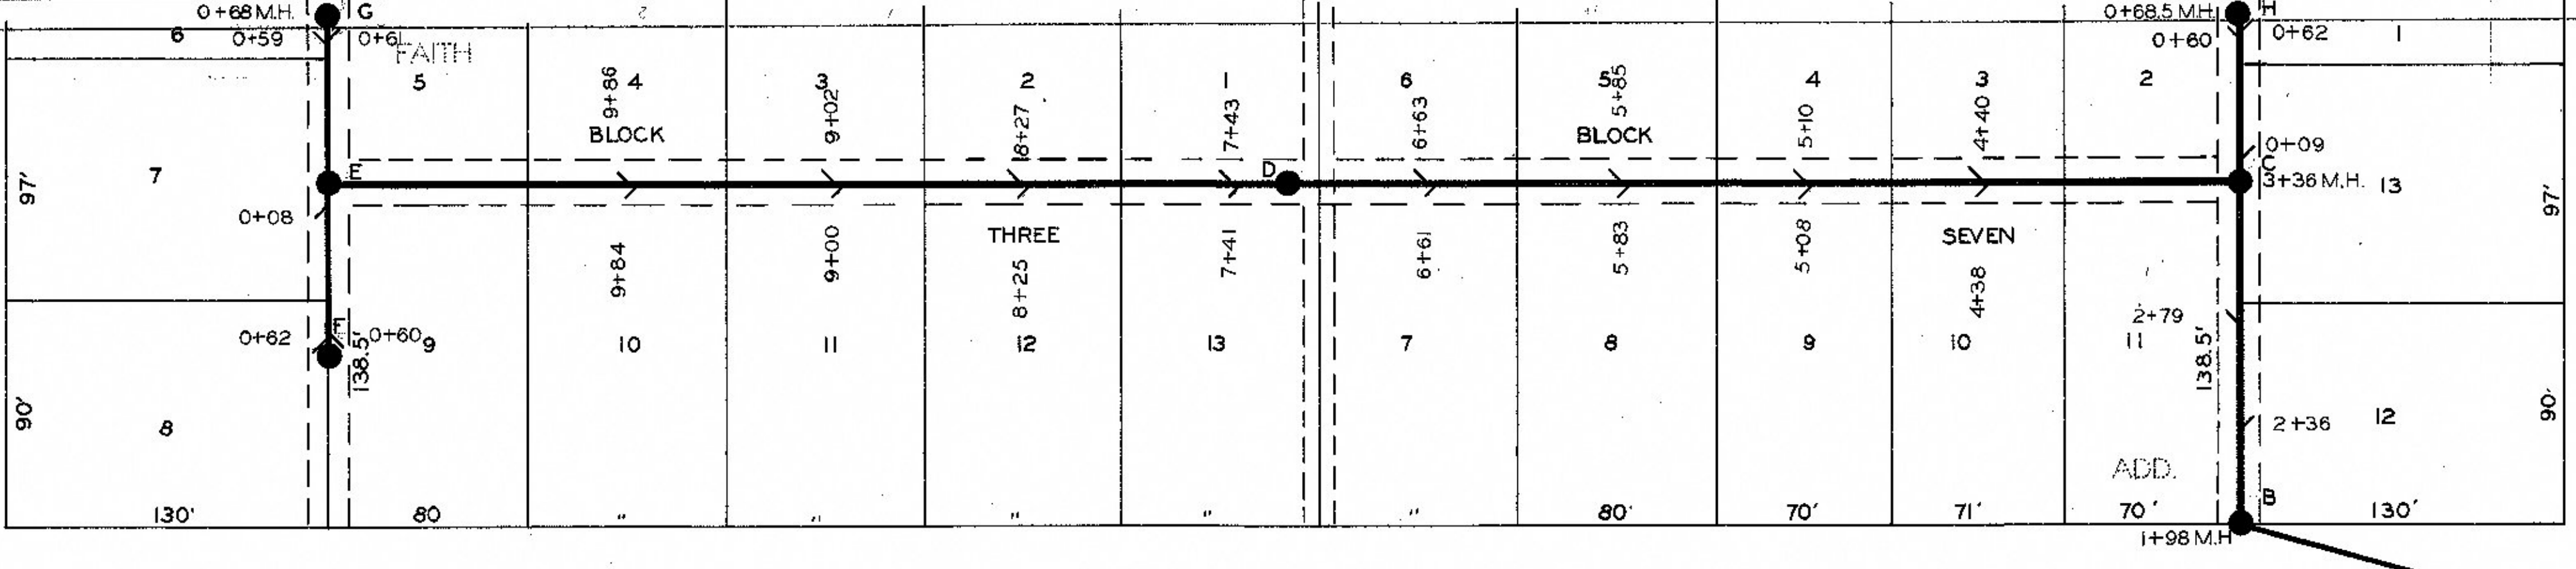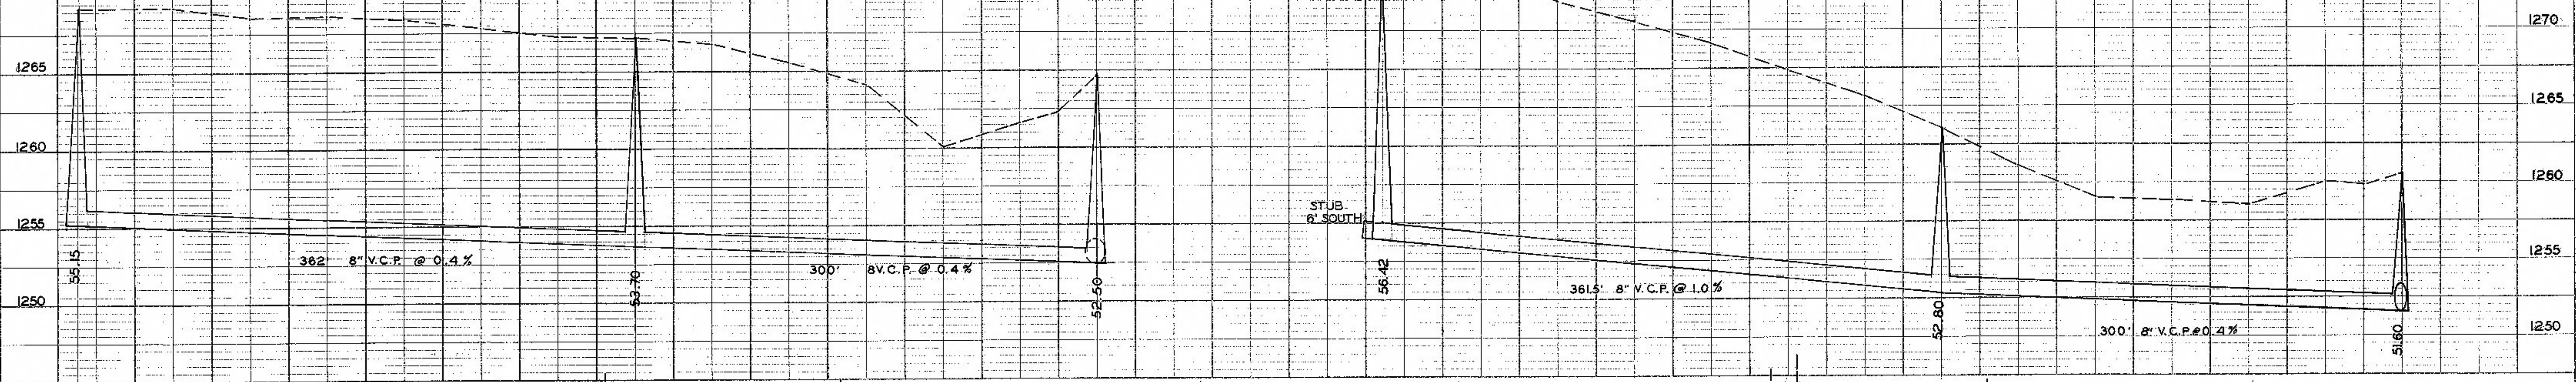

AS BUILT PLAN
 BROWN & BROWN INC.
 JANUARY 1965

LATERAL 490

