
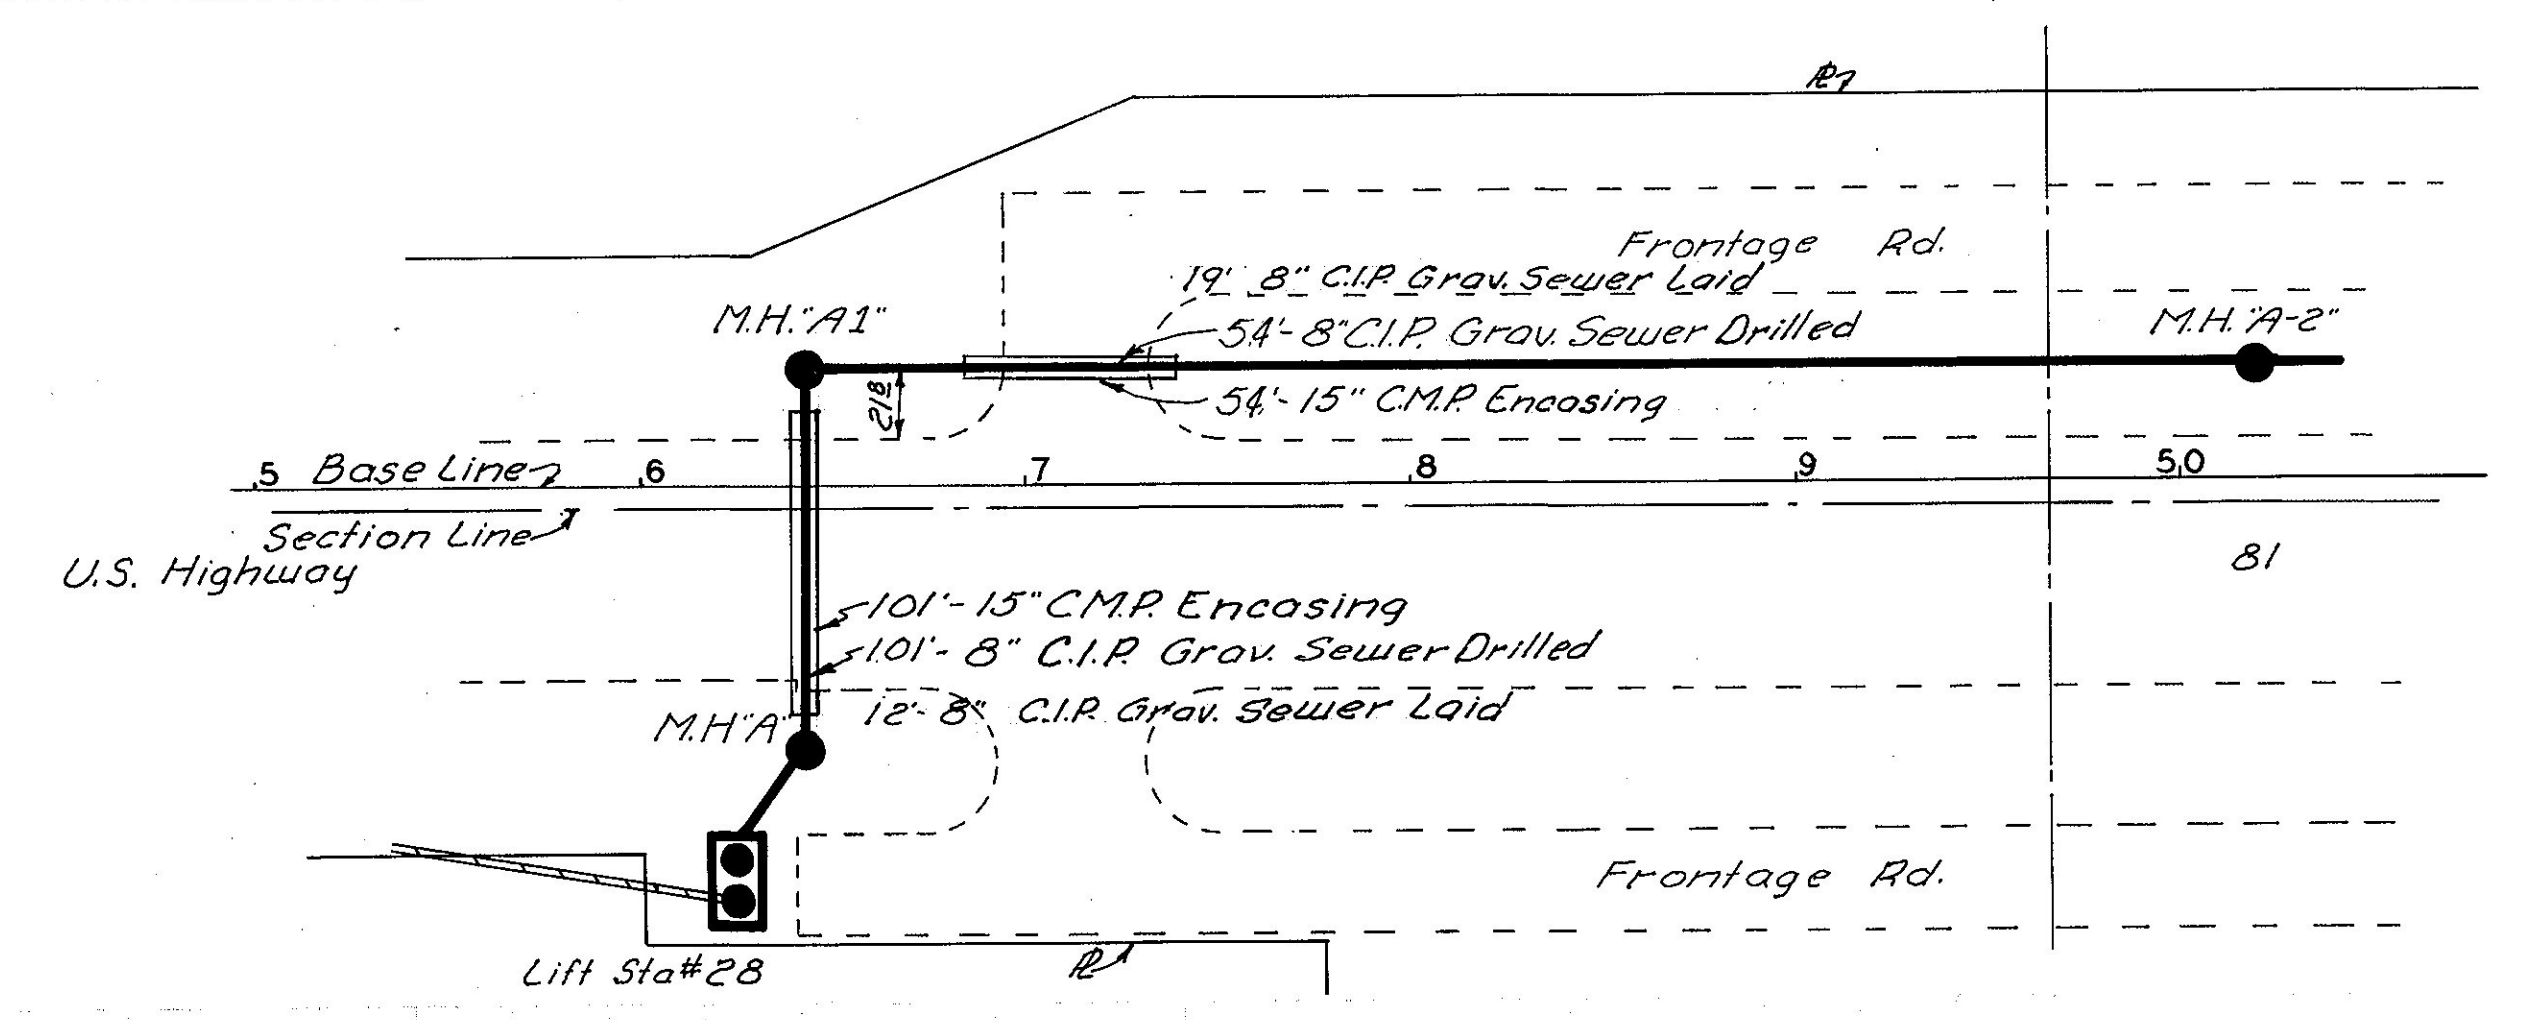


1220

1210

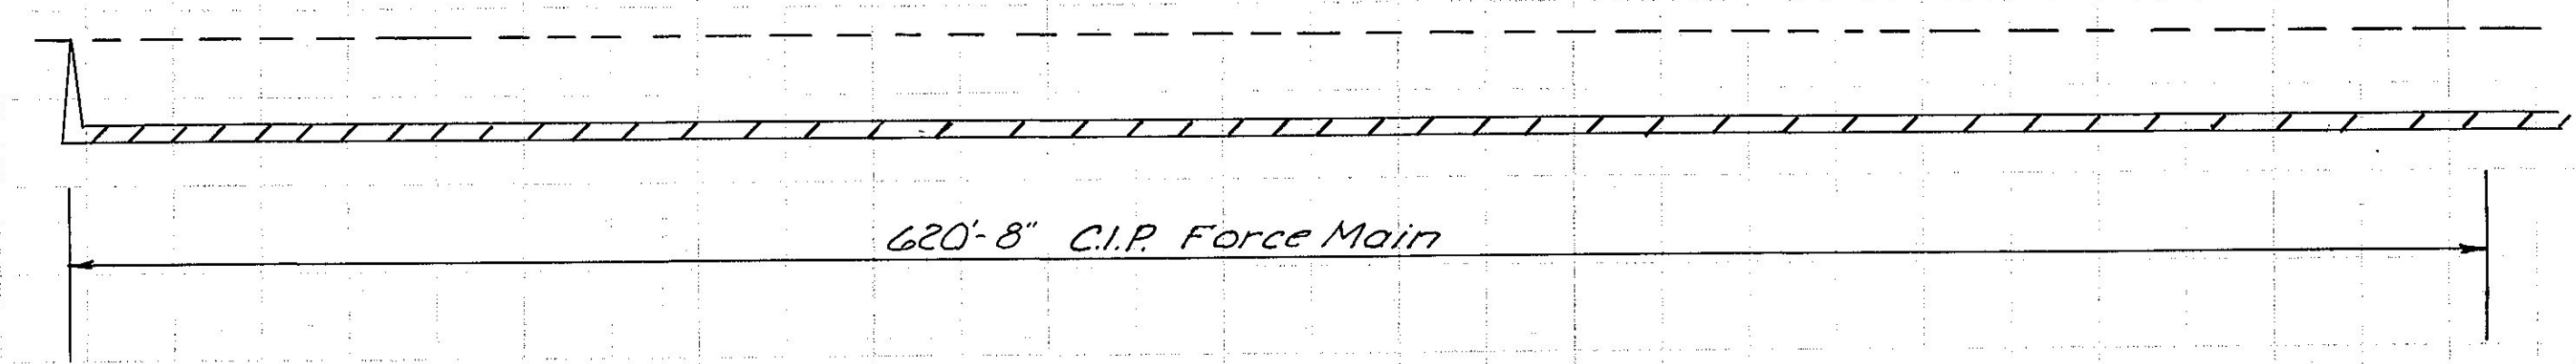

1230

1220

1210

1200

