


"AS BUILT PLAN"
 BUILT BY BROWN & BROWN
 NOVEMBER 1965

LATERAL 501

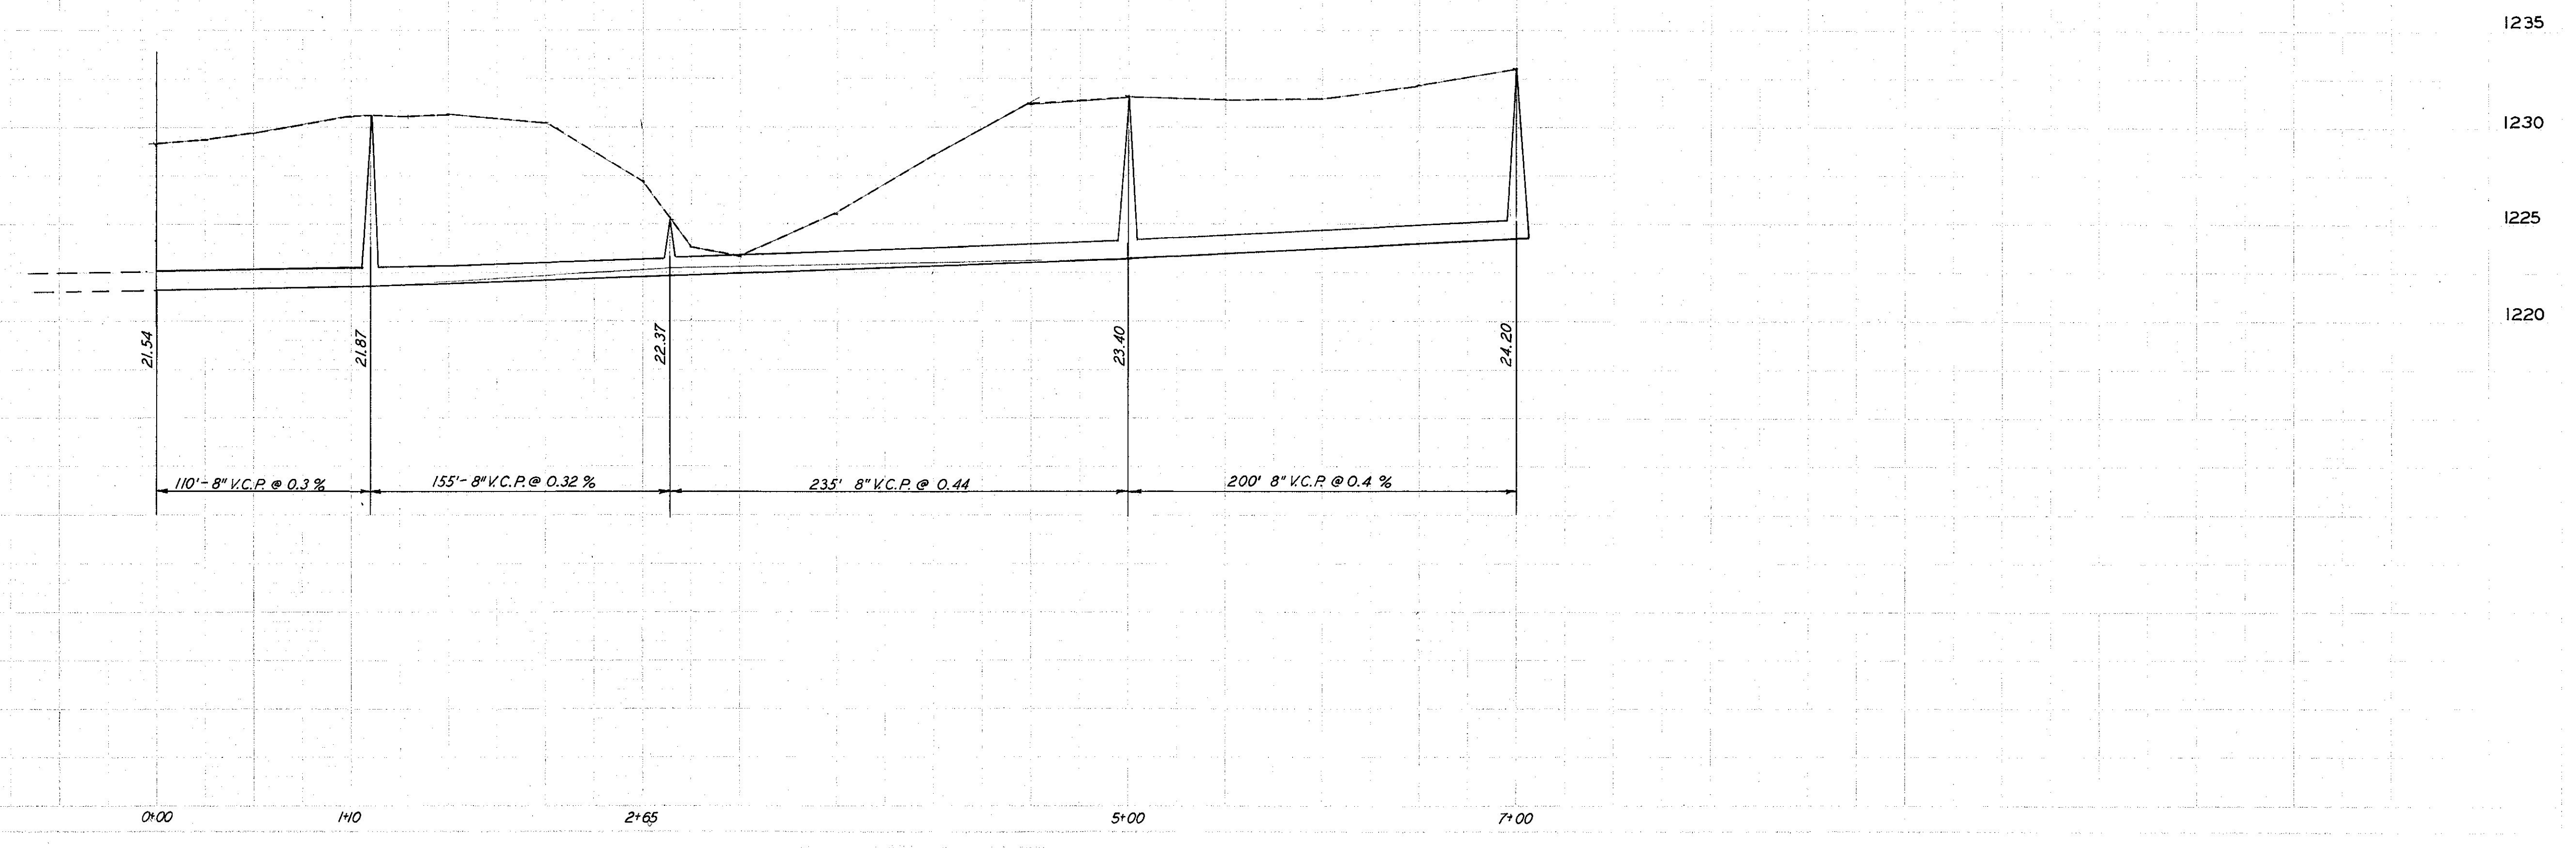

RRT Jan 66