

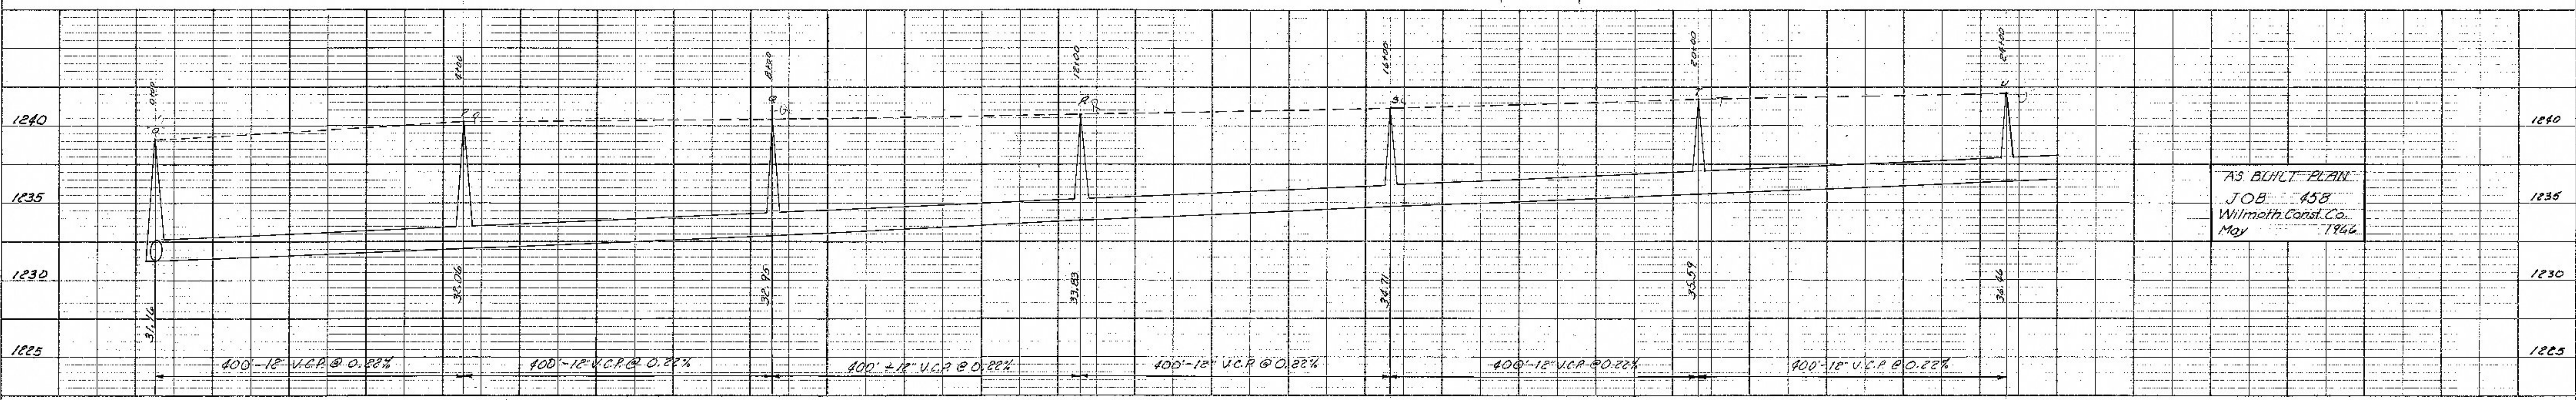
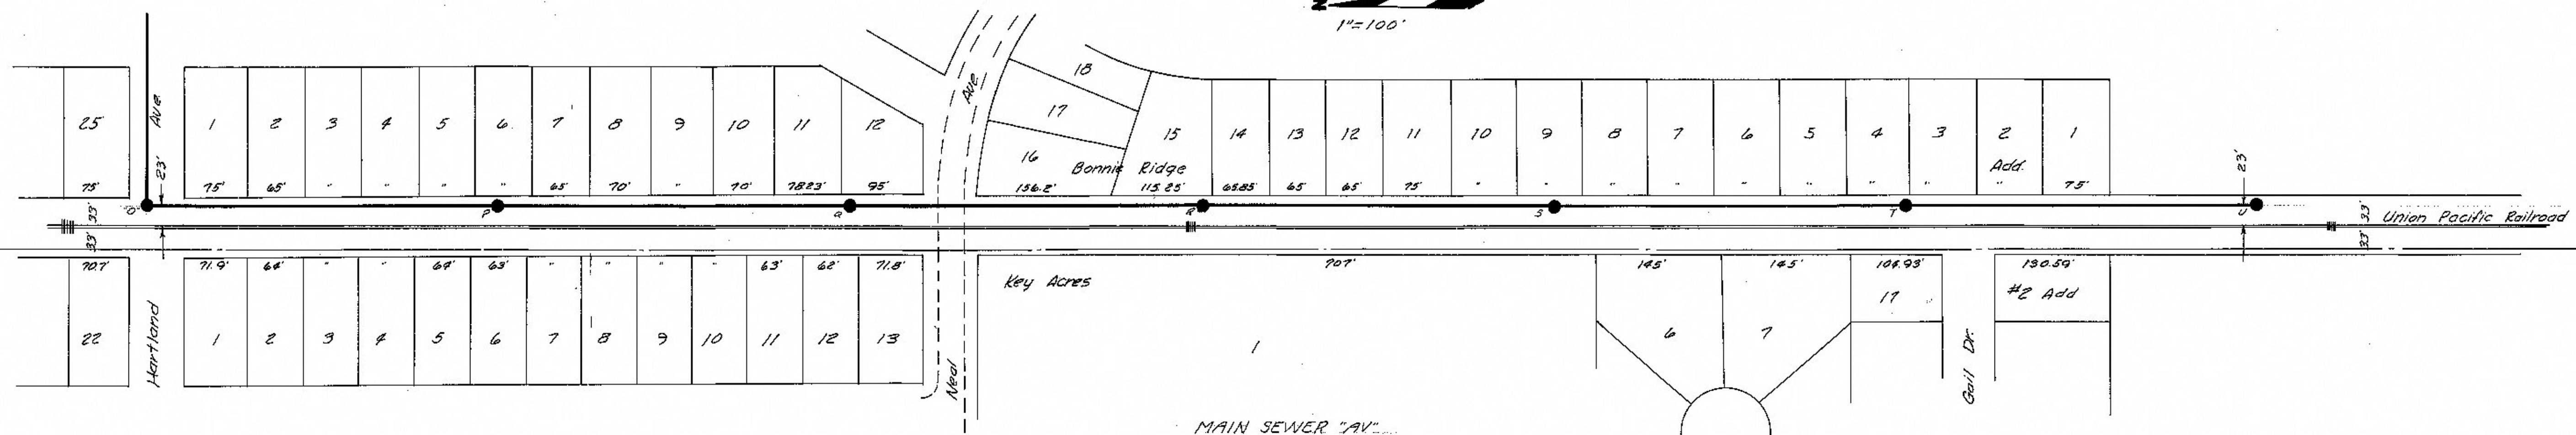


1"=100'

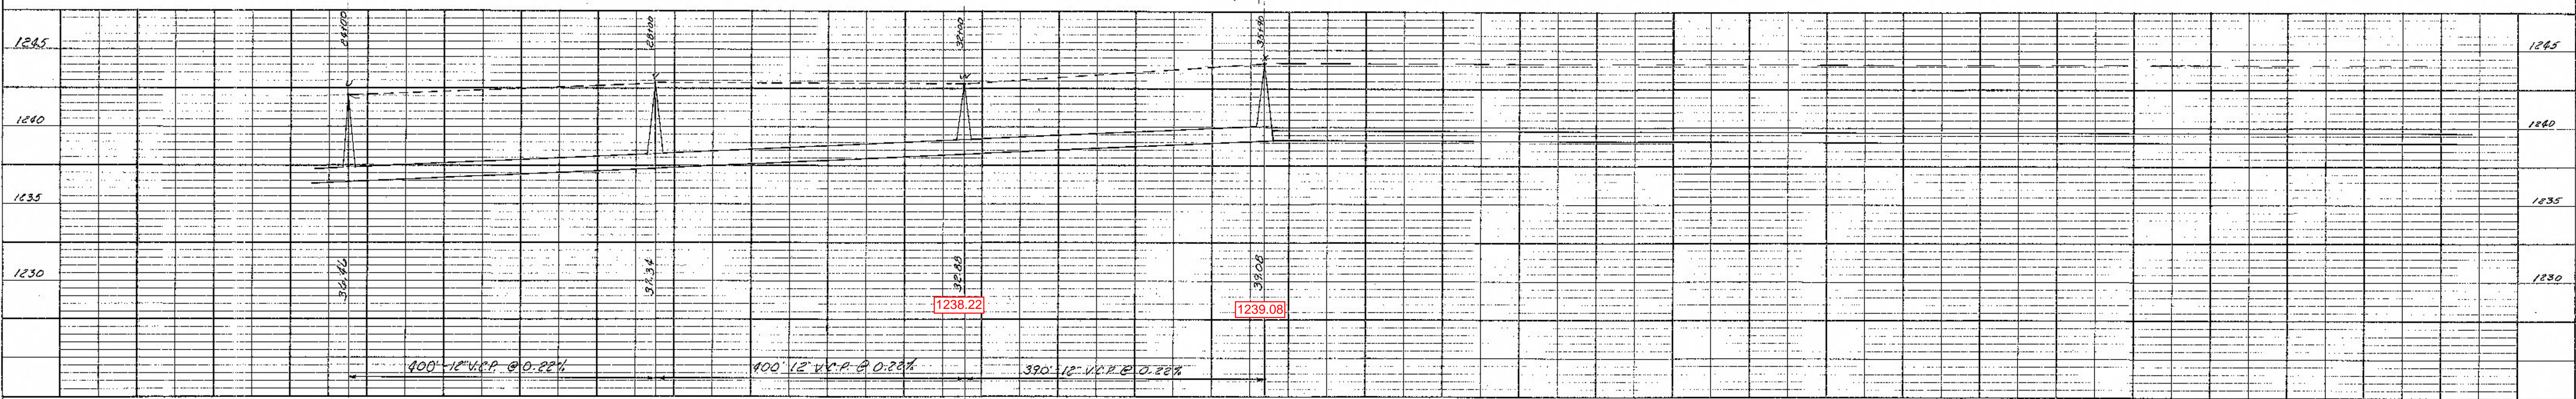

AS BUILT PLAN
JOB 458
Willmeth Const. Co.
May 1964

1"=100'

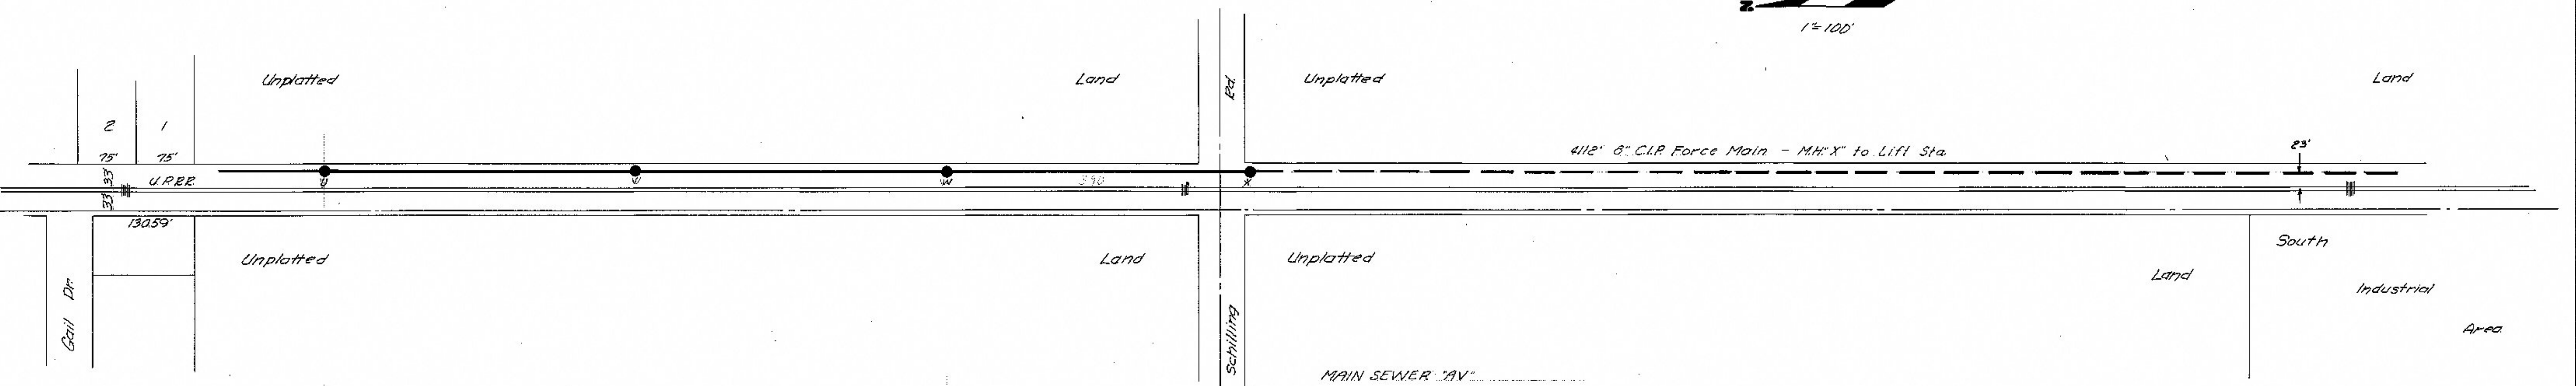

PLAN
SURVEYED BY: []
PLOTTED BY: []
NOTE BOOK NO. []
DATE []

PROFILE
SURVEYED BY: []
PLOTTED BY: []
NOTE BOOK NO. []
DATE []