



MAIN SEWER "AV"

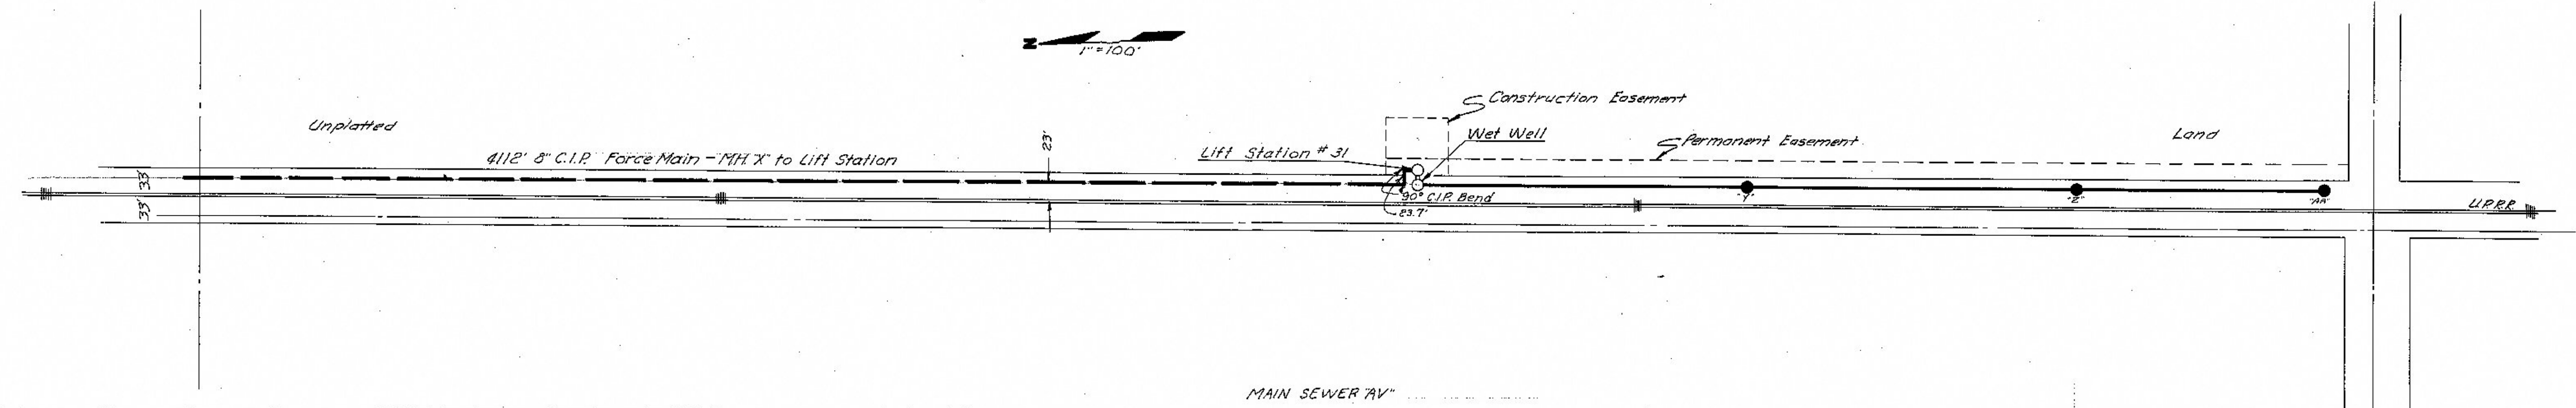

MAIN SEWER "AV"

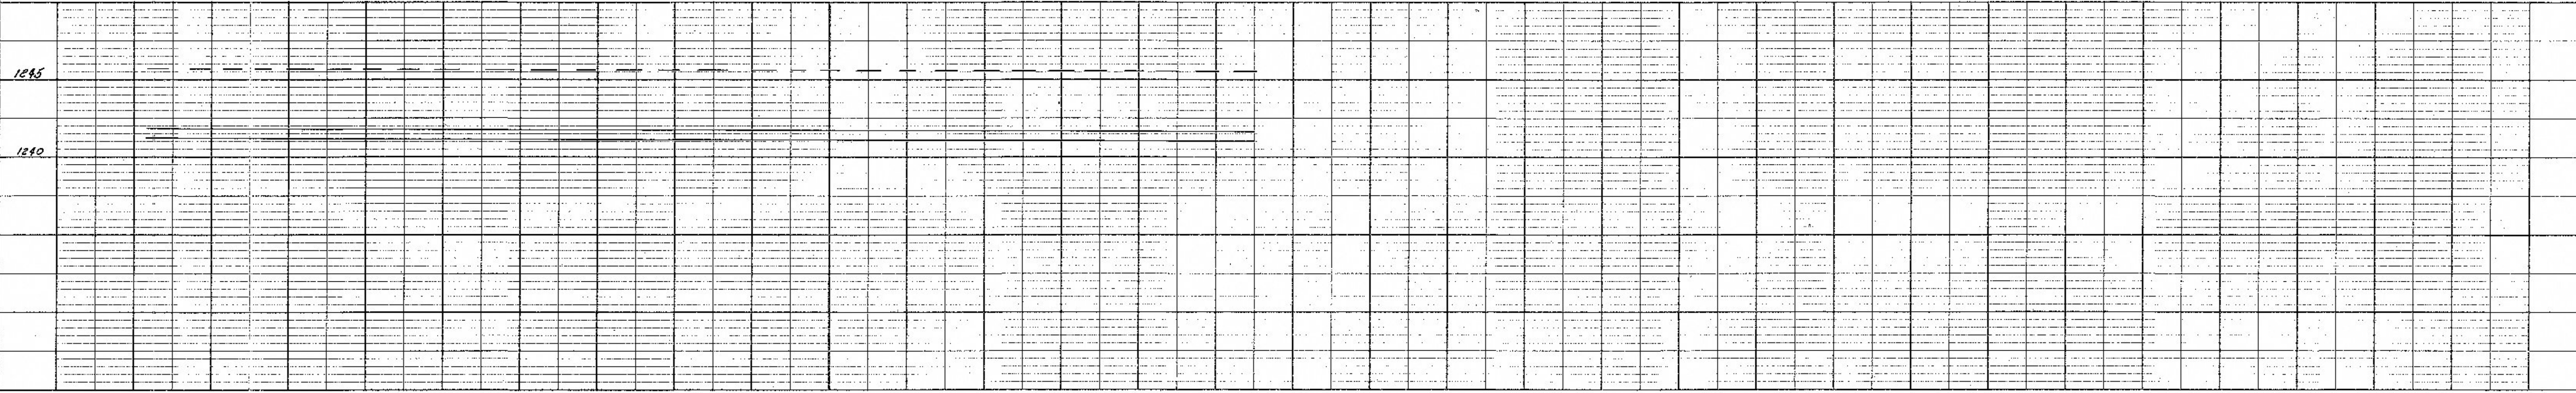