


LATERAL 504 BLOCK 3 SCHIPPEL ADD.

PLAN
SCALE: AS SHOWN
NOTE: BOOK INSTRUMENT CHECKED
BY: M.S. NOTES
DATE: 12/11/11

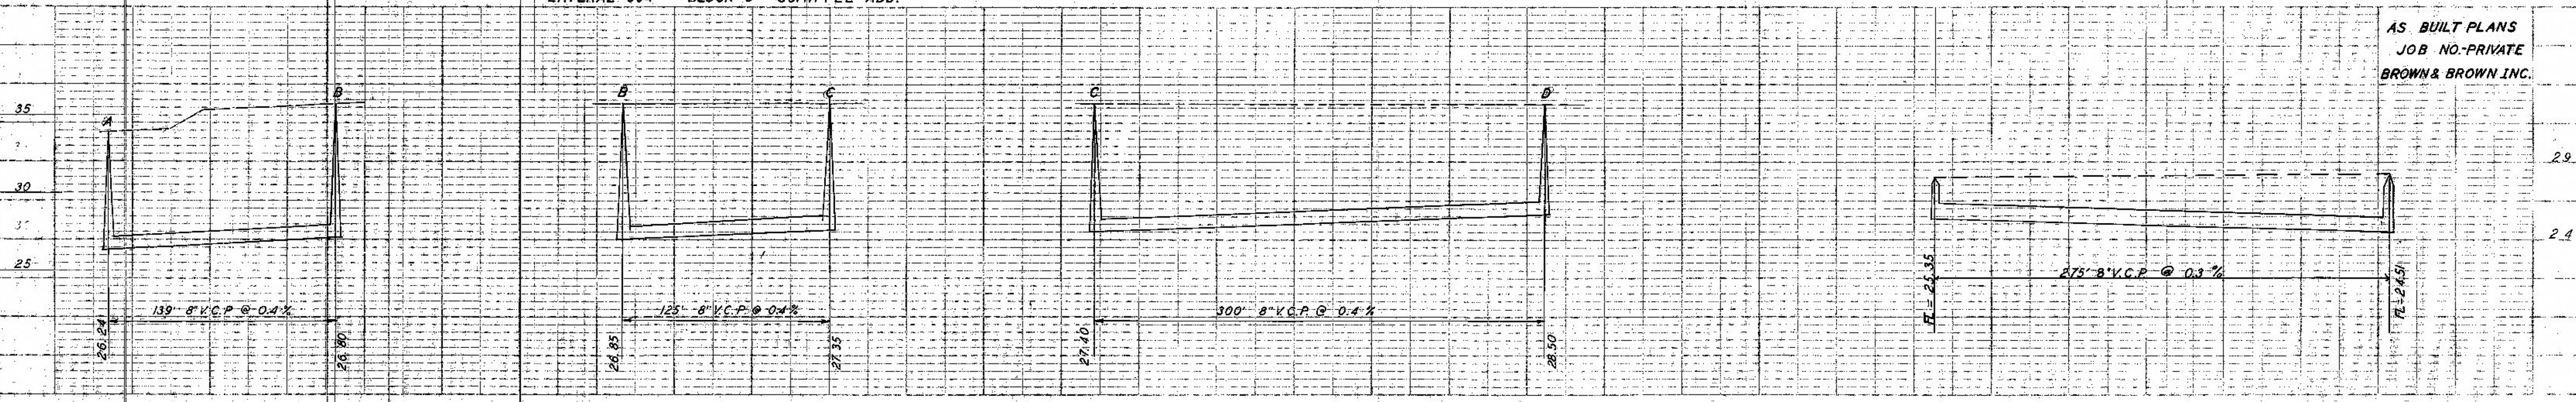

AS BUILT PLANS
JOB NO-PRIVATE
BROWN & BROWN INC.

PROFILE
SCALE: AS SHOWN
NOTE: BOOK INSTRUMENT CHECKED
BY: M.S. NOTES
DATE: 12/11/11