



PLAN	SURVEYED	DATE
	PLOTTED	BY
	NOTE BOOK	NO.
	ALIGNED CHECKED	DATE
	BY	

PROFILE	SURVEYED	DATE
	PLOTTED	BY
	NOTE BOOK	NO.
	GRADES CHECKED	DATE
	BY	

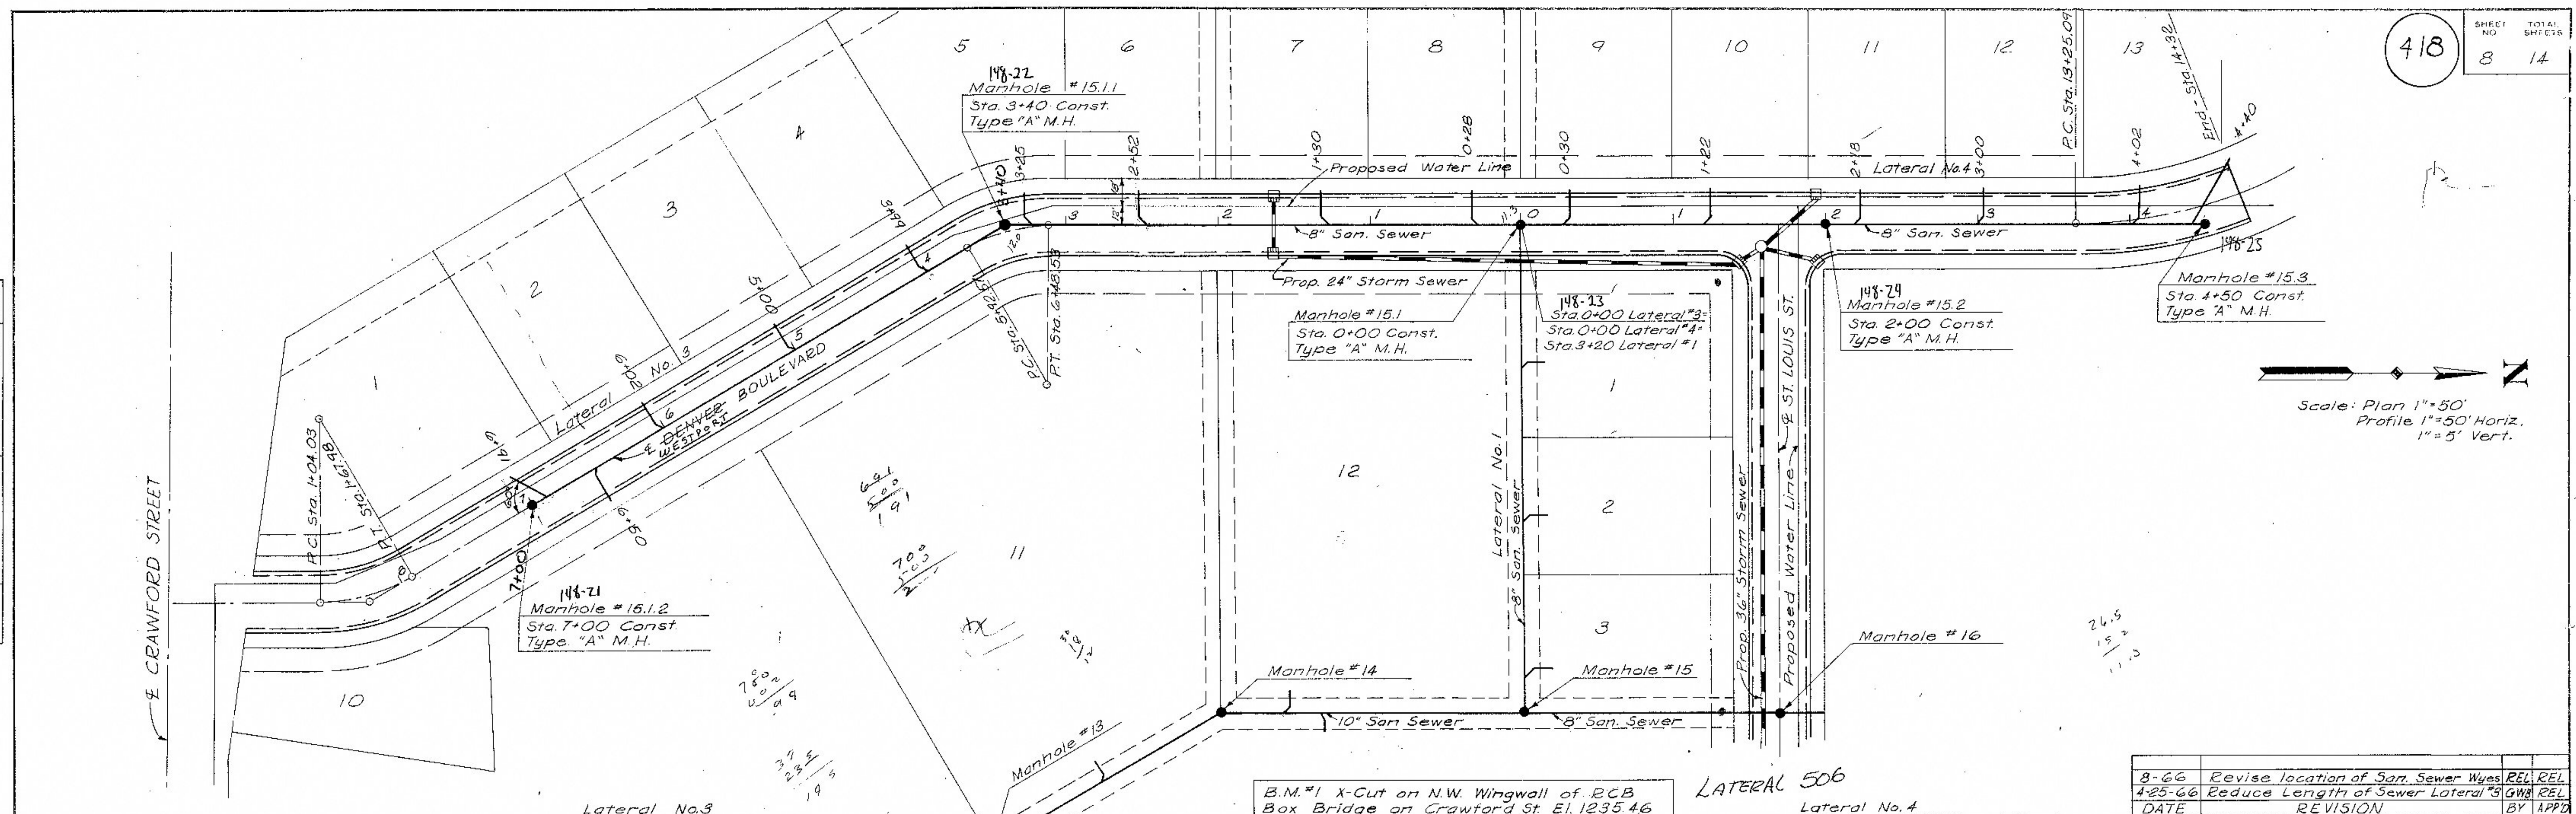

Scale: Plan 1"=50'  
Profile 1"=50' Horiz.  
1"=5' Vert.

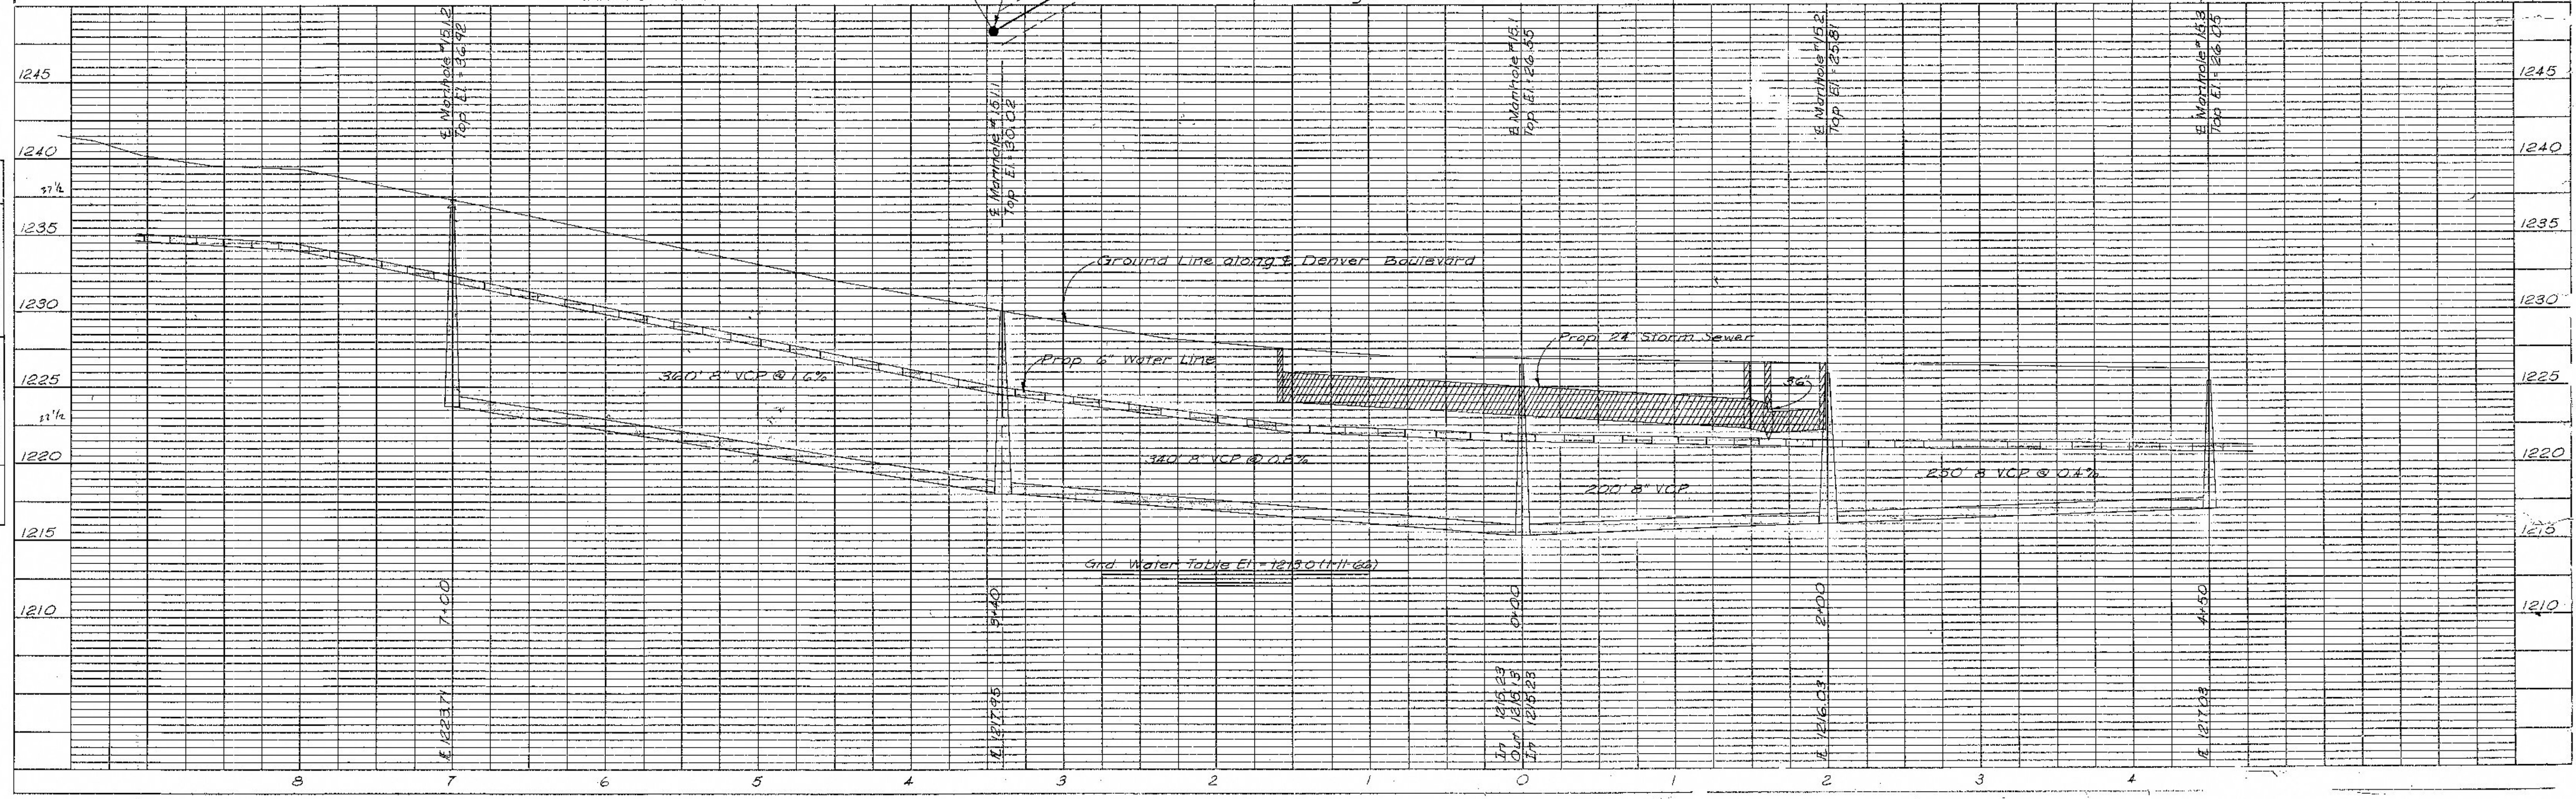

DATE	REVISION	BY	APP'D
8-66	Revise location of San. Sewer Wyes	REL	REL
4-25-66	Reduce Length of Sewer Lateral #3	GWB	REL