



PLAN	SURVEYED	DATE
NOTE BOOK NO.	PLOTTED	BY
	ALIGNMENT CHECKED	
	RC. OF WAY CHECKED	

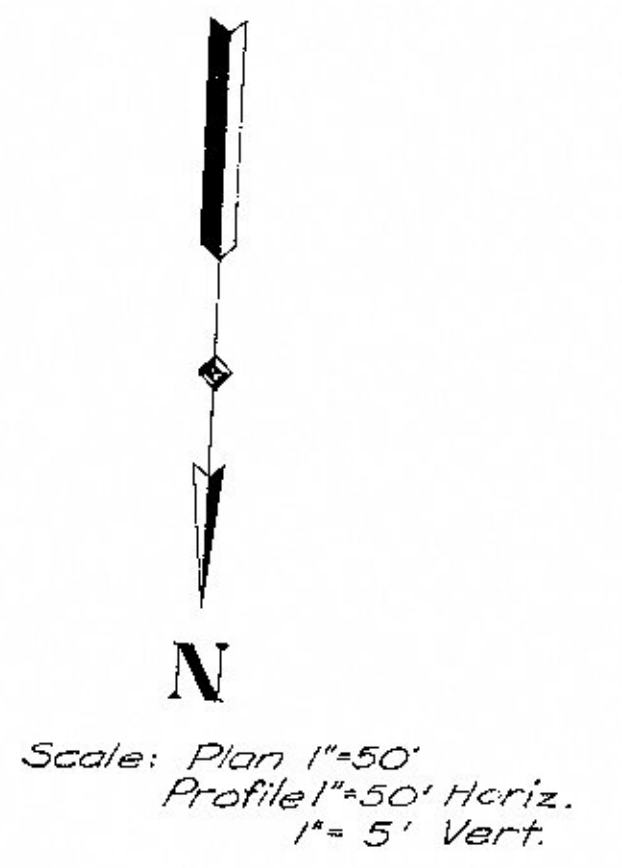

PROFILE	SURVEYED	DATE
NOTE BOOK NO.	PLOTTED	BY
	GRADE CHECKED	
	STRUCTURE NOTATIONS CRKL.	

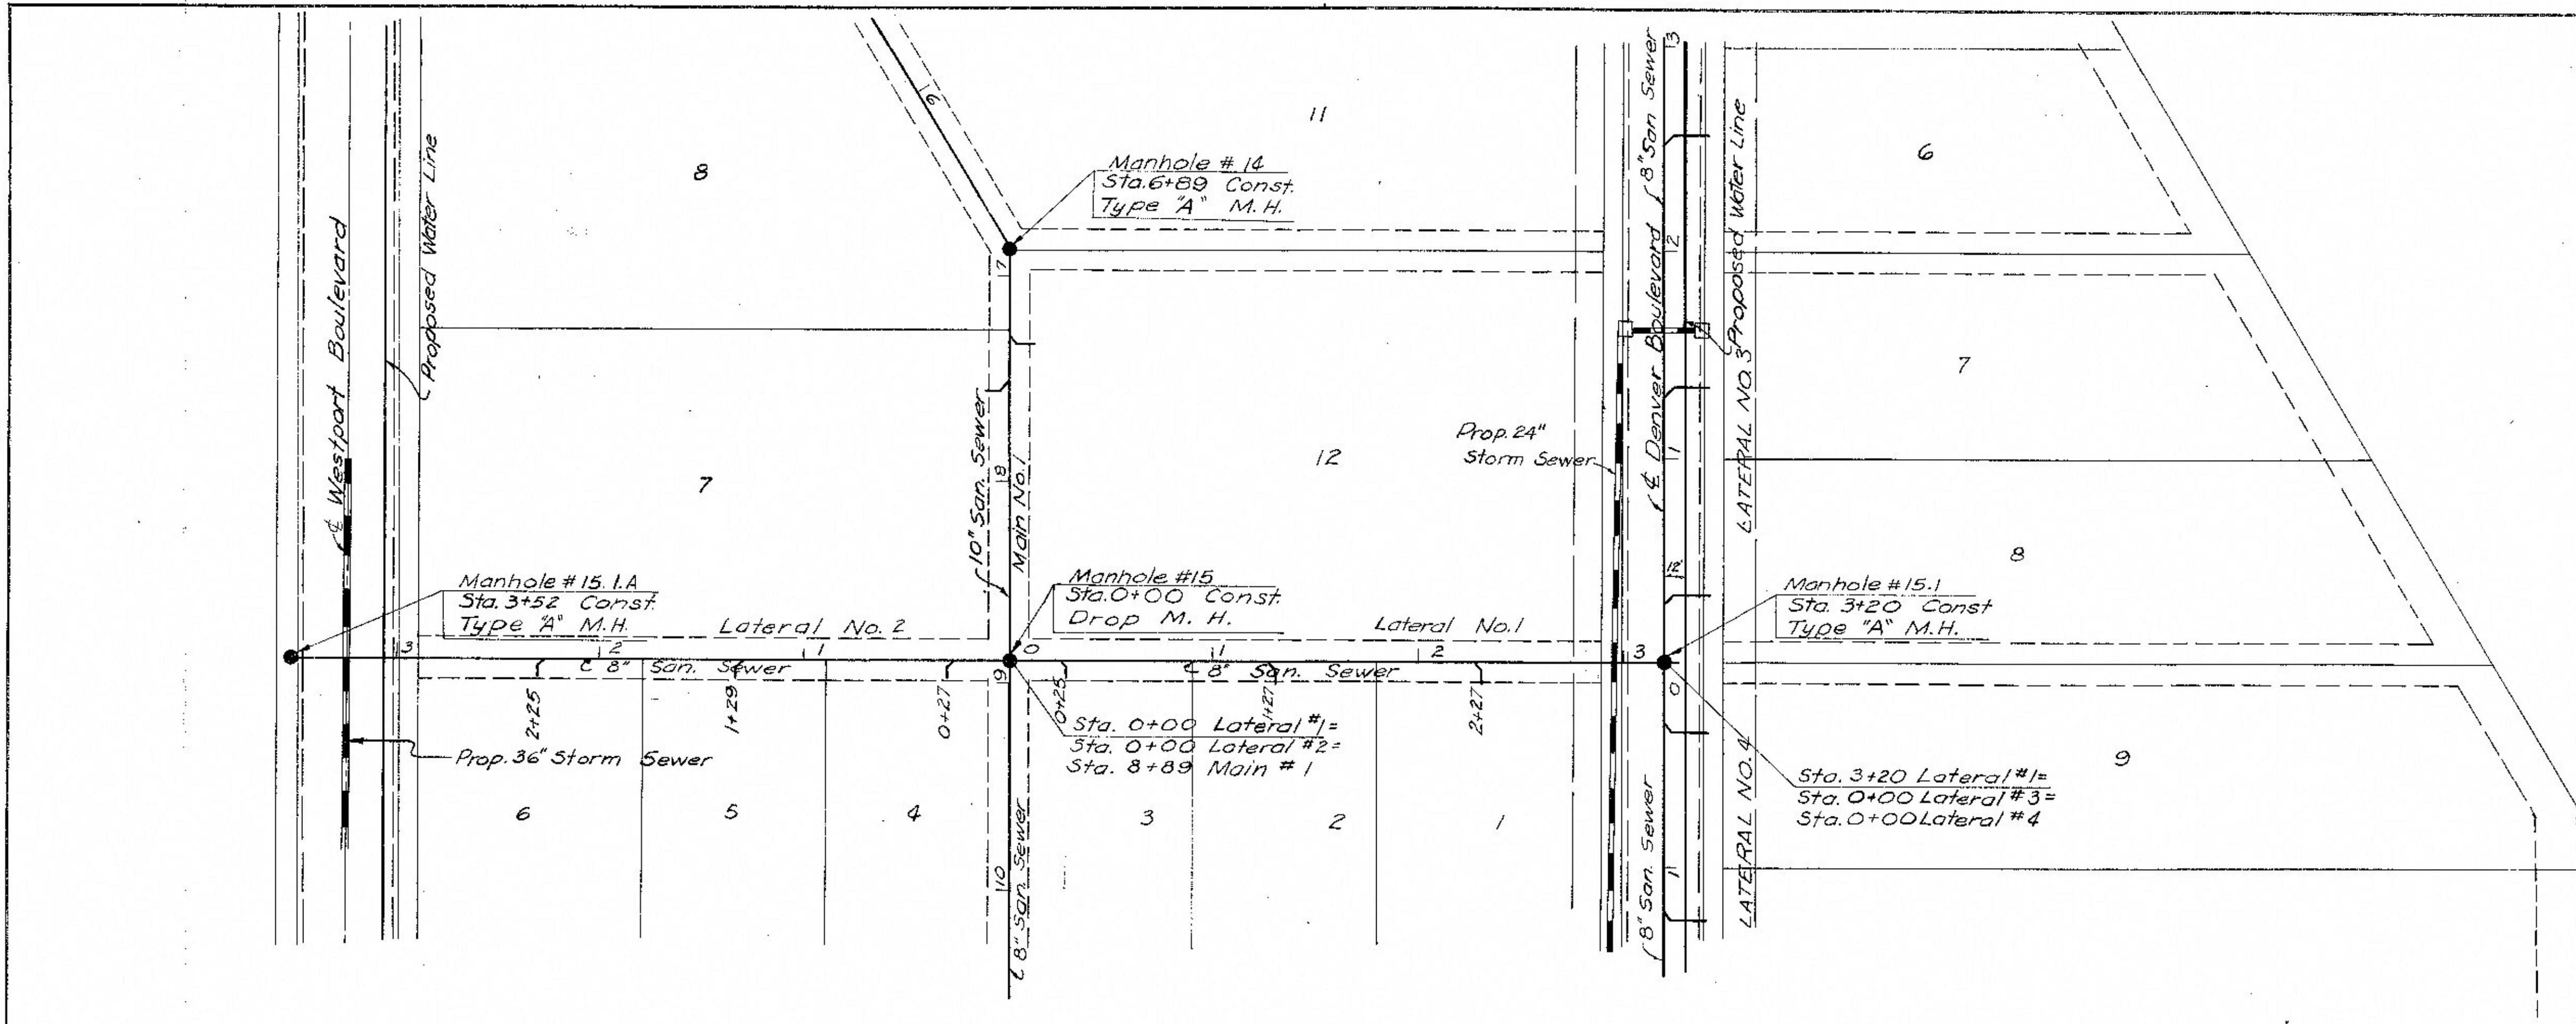