

1" = 50'

Match Below Right

Sta 26+14.29 PC

PLAN

DATE: _____


BY: _____

PROJECT: _____

NO. _____

NOTE BOOK ALIGNMENT (ELEVATION) _____

PL. OF WAY (WIDTH) _____

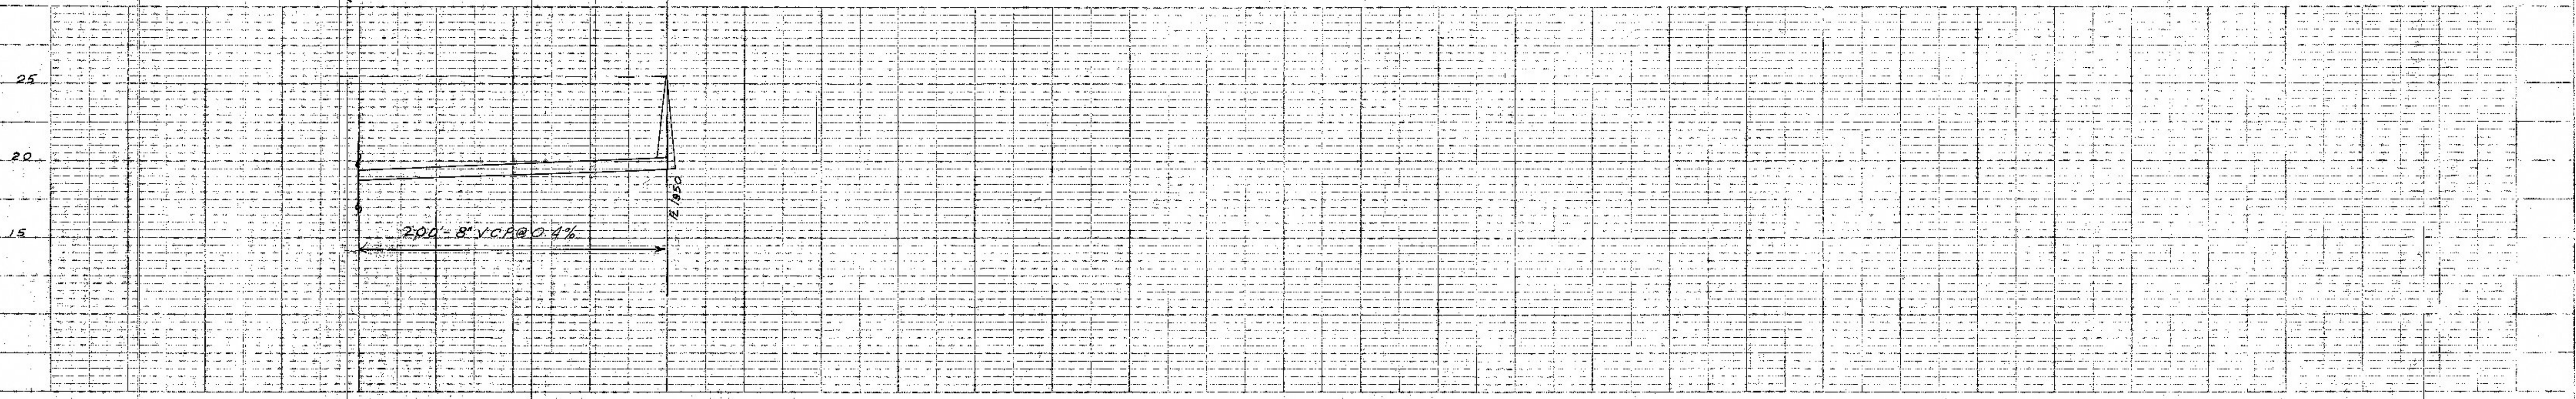

PROFILE

DATE: _____

BY: _____

PROJECT: _____

NO. _____

NOTE BOOK GRADES (ELEVATION) _____

PL. OF WAY (WIDTH) _____

1" = 50'

Exist. M.H.

Sta 11+55 B1

Sta 15+11.39 PC

Sta 18+28.13 PT

Match above left

