

PLAN	DATE
REV	
1	
2	
PROFILE	DATE
REV	
1	
2	
3	
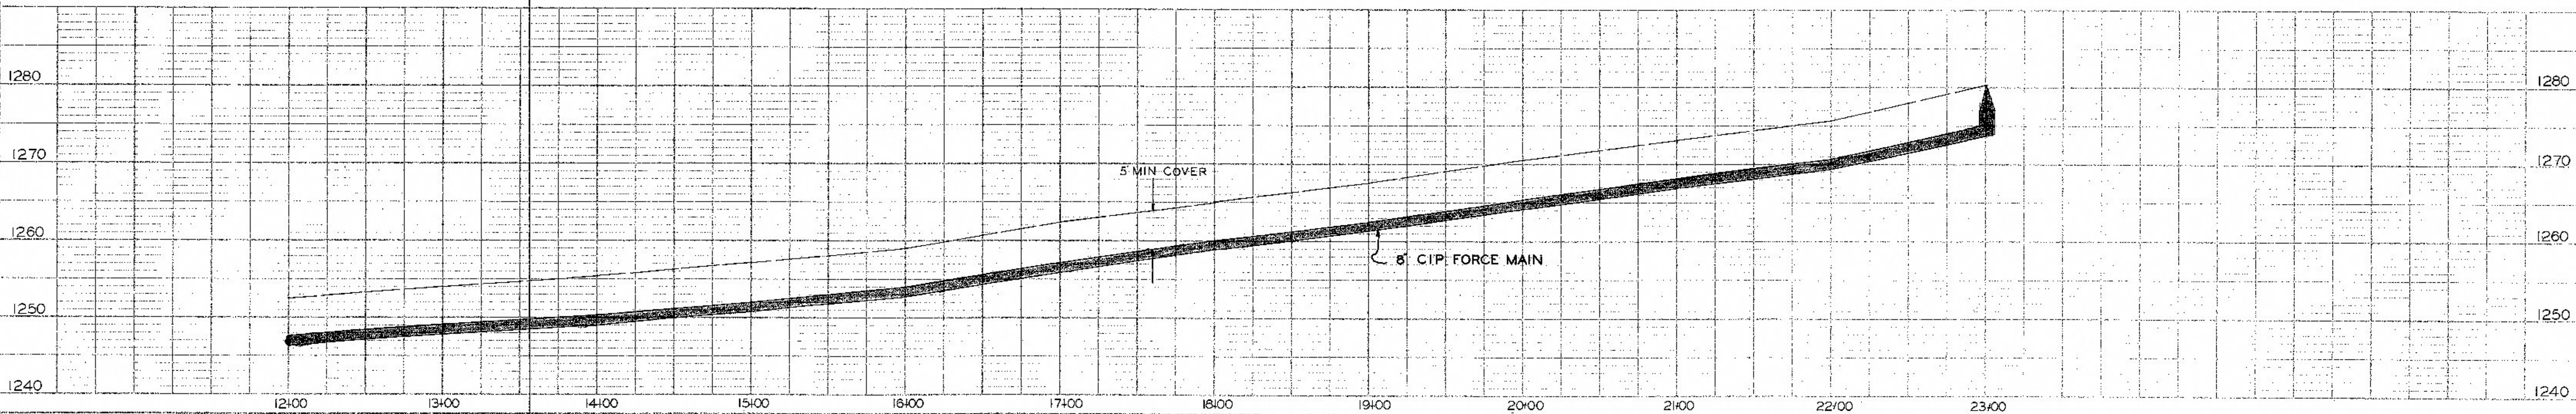
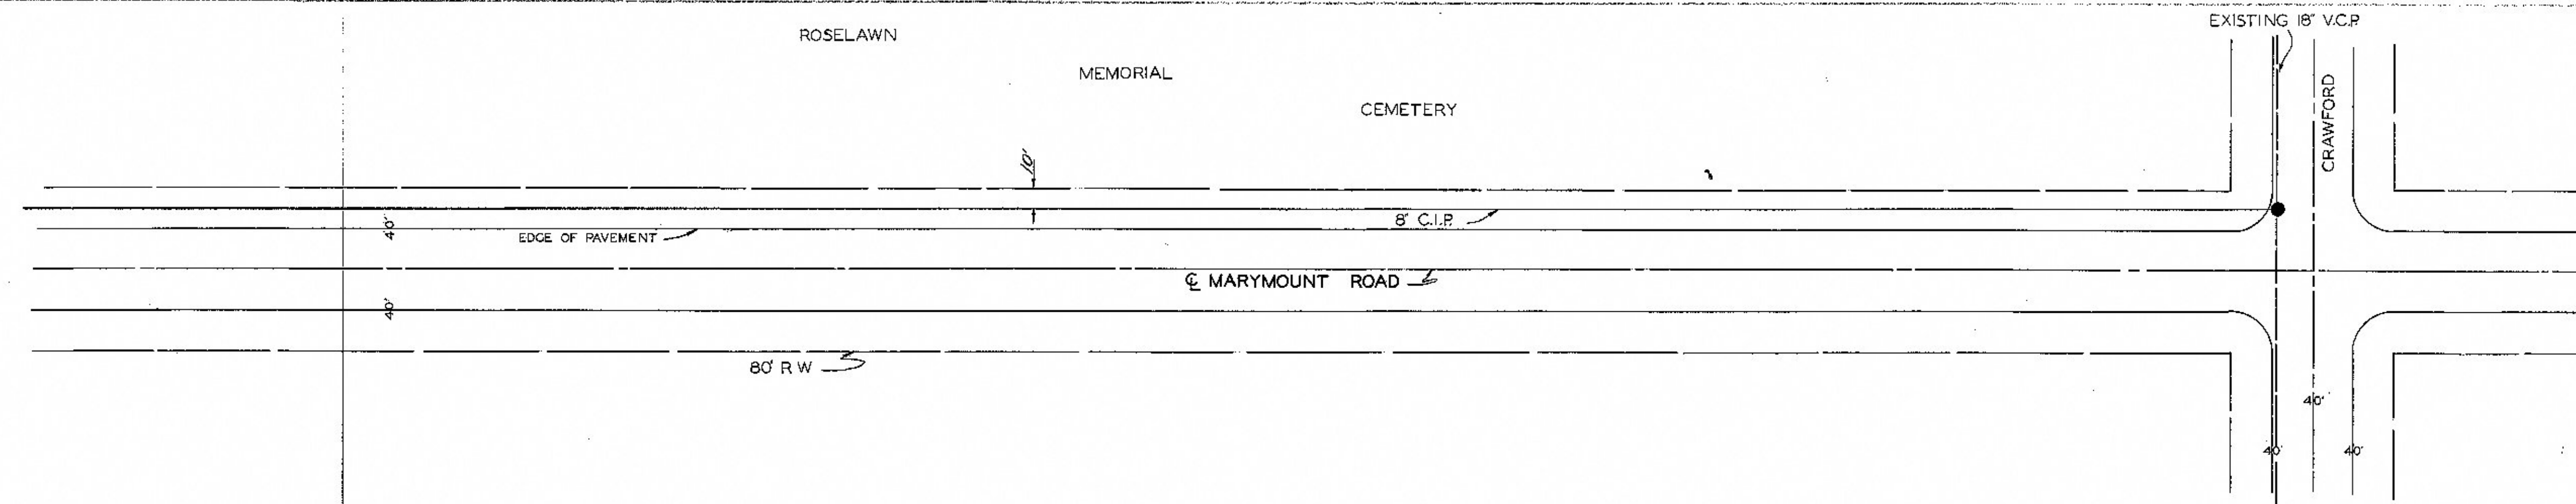
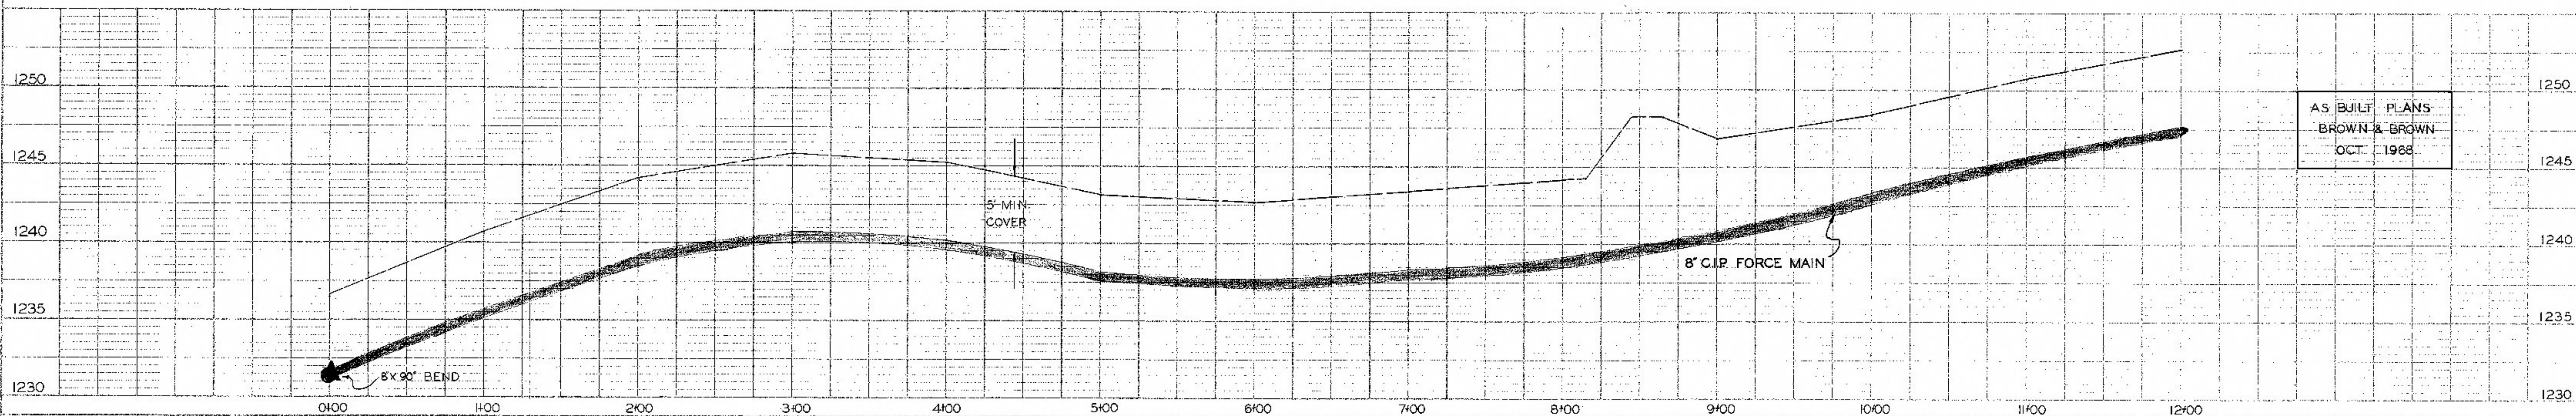
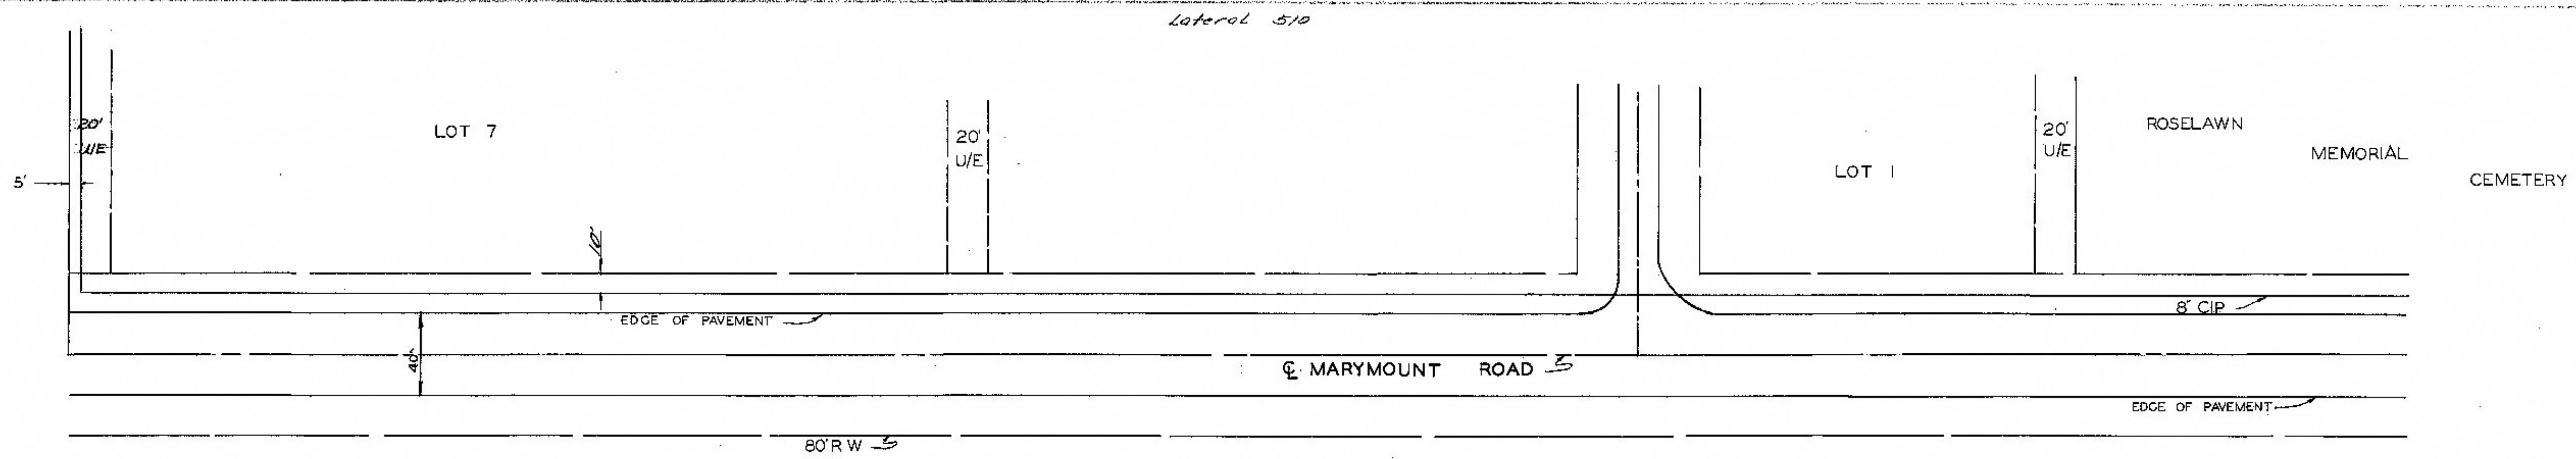


PLATE 2 - RISE AND FALL - C.I.P. FORCE MAIN  
 1968 ROSELAWN MEMORIAL CEMETERY AND ROSELAWN CEMETERY  
 PLANNING DEPARTMENT

Ridgeview Force Main As built