
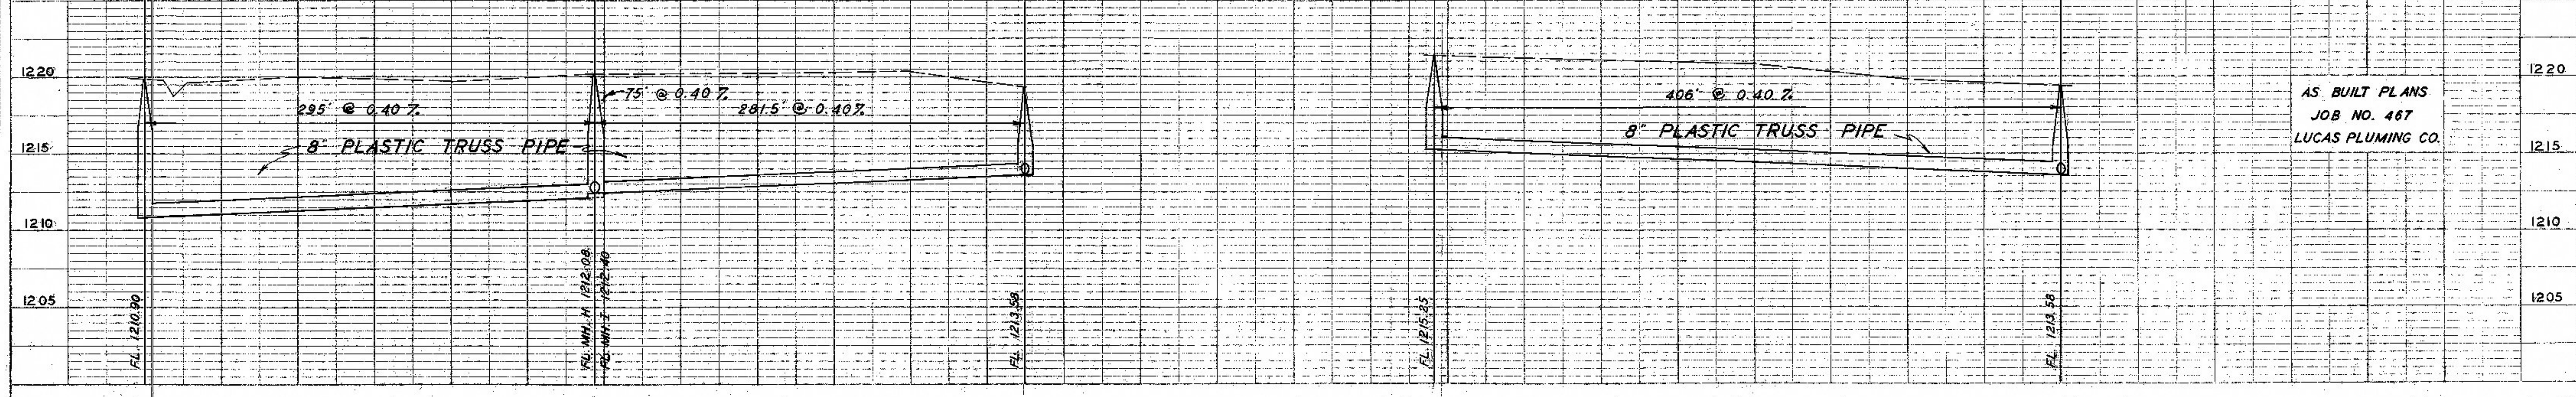
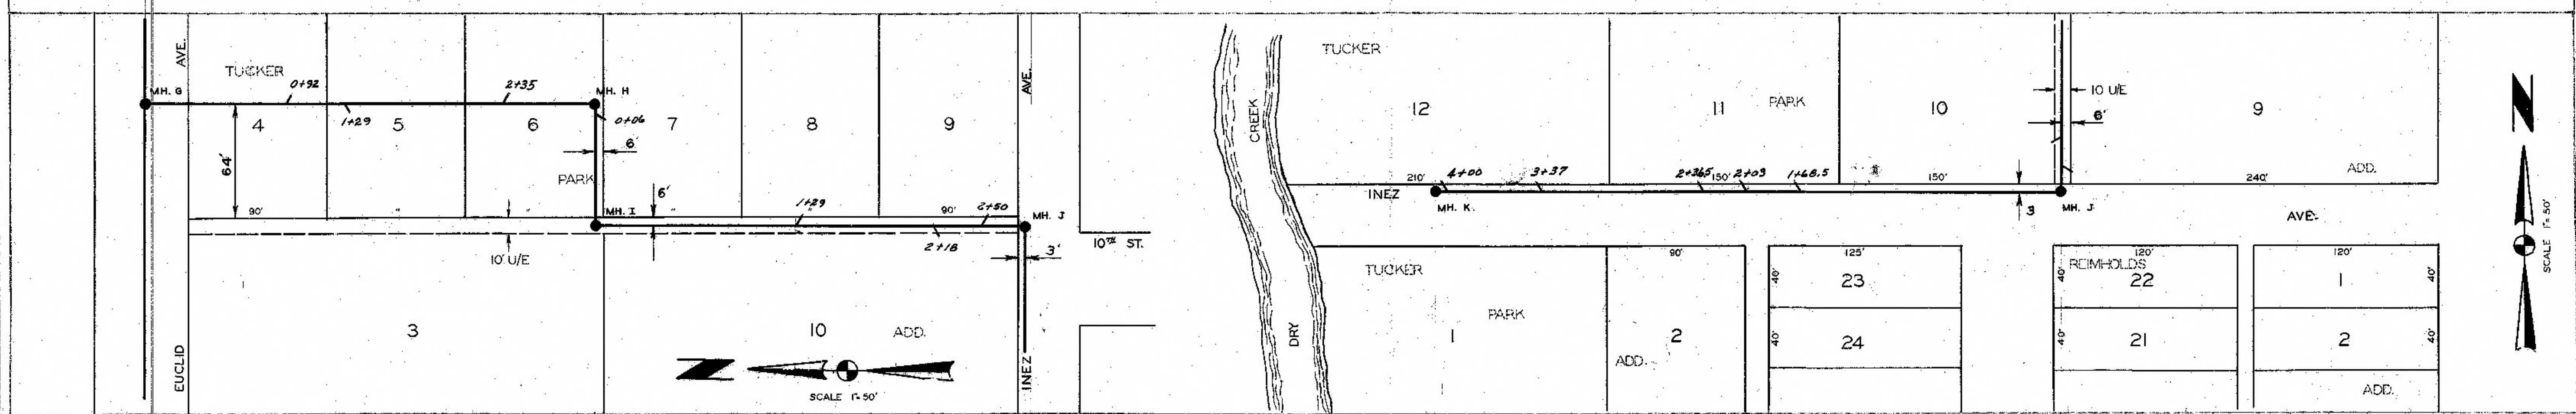
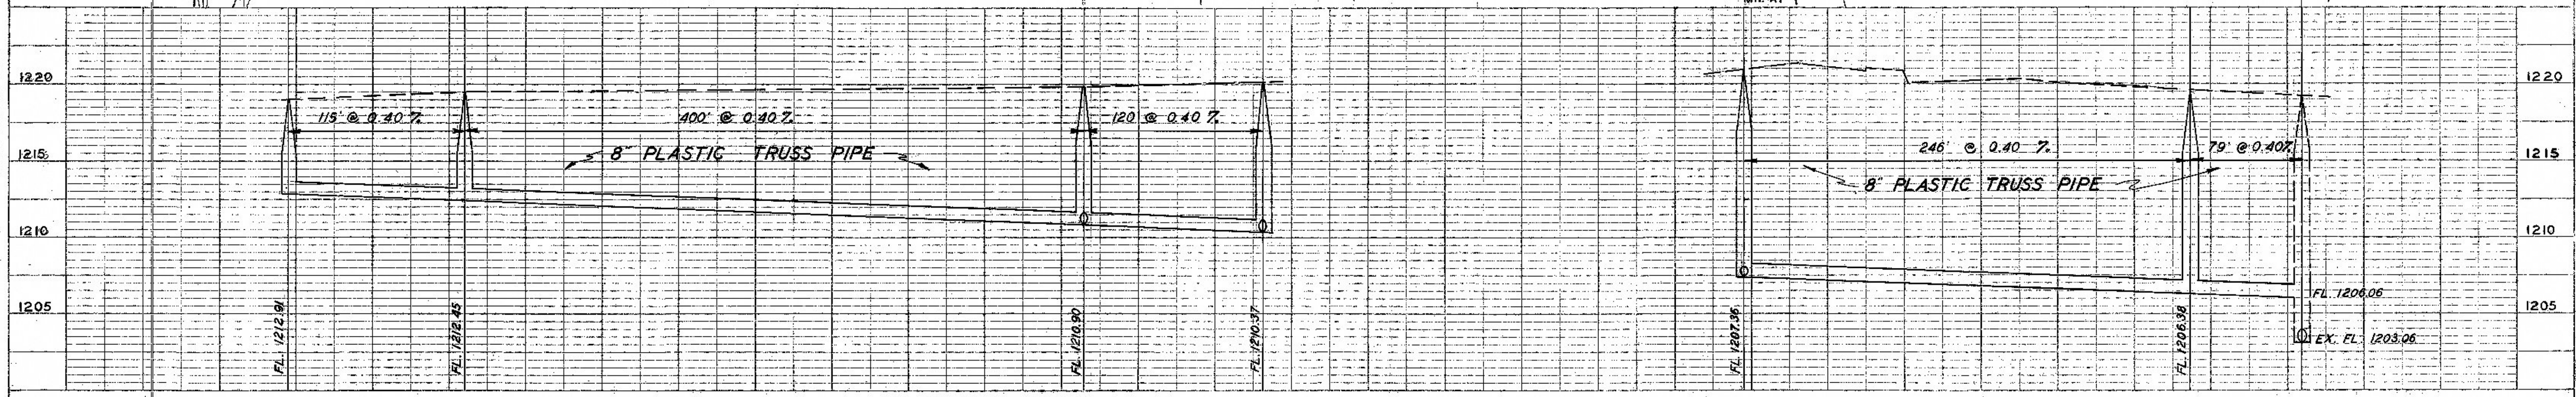


DRAWN BY: *C. Davis*
 CHECKED BY: *[Signature]*
 DATE: 12-2-87
 NO. 1
 NOTE BOOK ALIGNED CHECKED
 FT. OF WAY CHECKED

SURVEYED BY: *[Signature]*
 CHECKED BY: *[Signature]*
 DATE: 12-2-87
 NO. 1
 NOTE BOOK ALIGNED CHECKED
 FT. OF WAY CHECKED

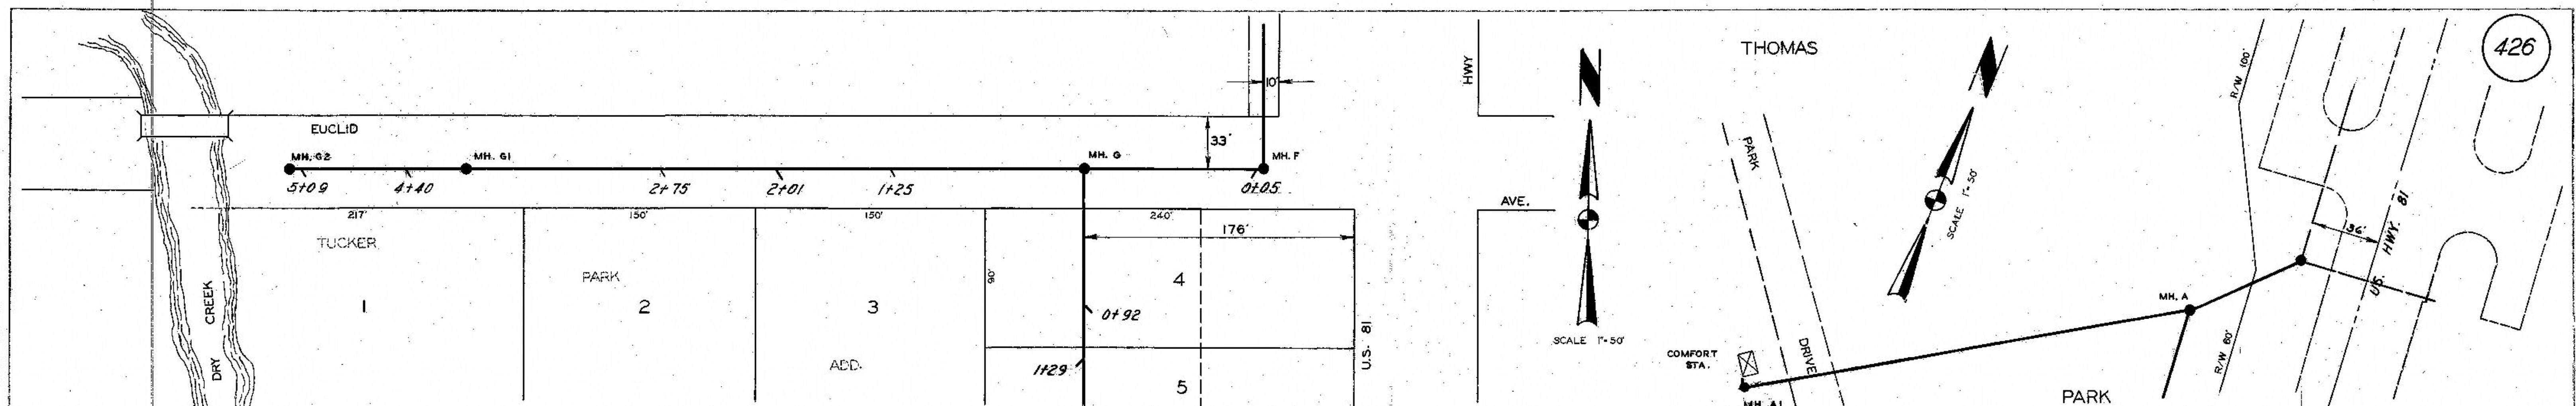

AS BUILT PLANS
 JOB NO. 467
 LUCAS PLUMBING CO.