



PLAN
 DATE: _____
 BY: _____
 CHECKED: _____
 NO. _____

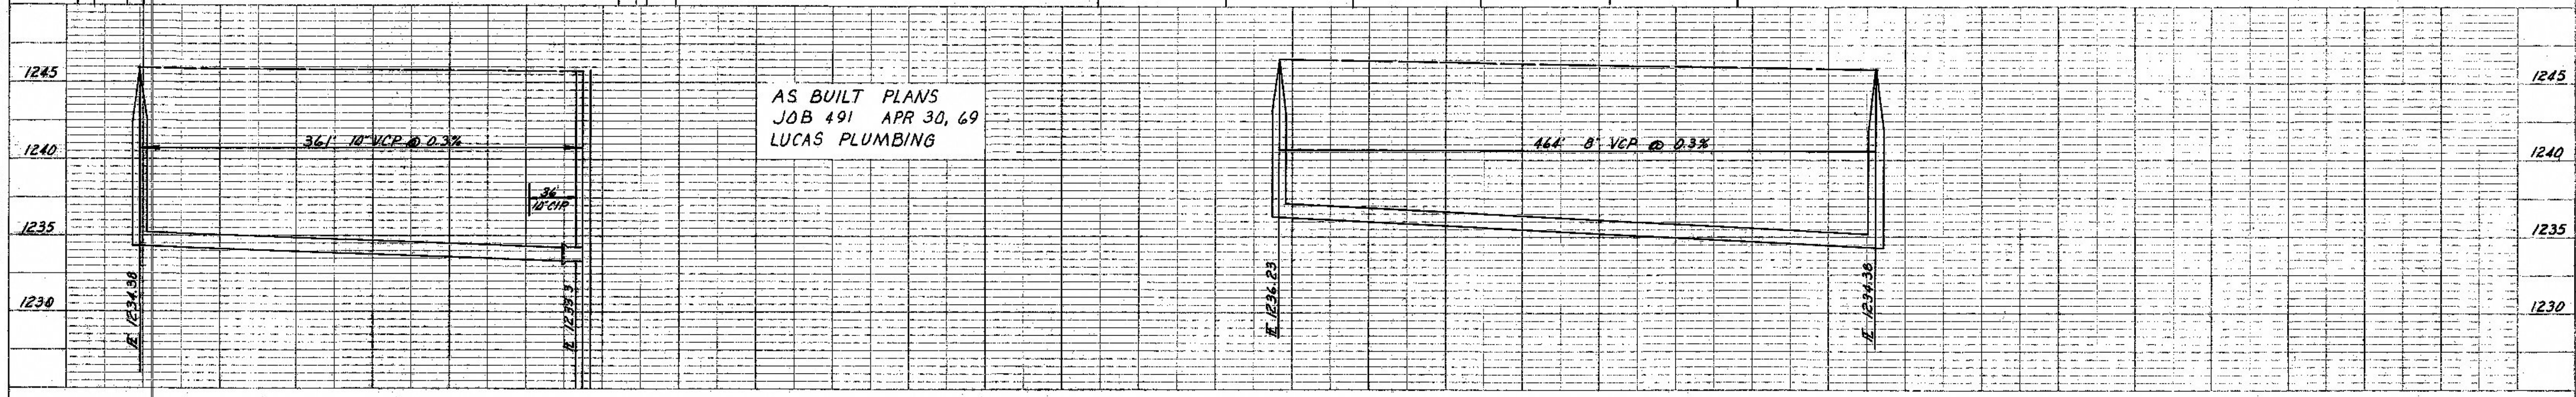

AS BUILT PLANS
 JOB 491 APR 30, 69
 LUCAS PLUMBING

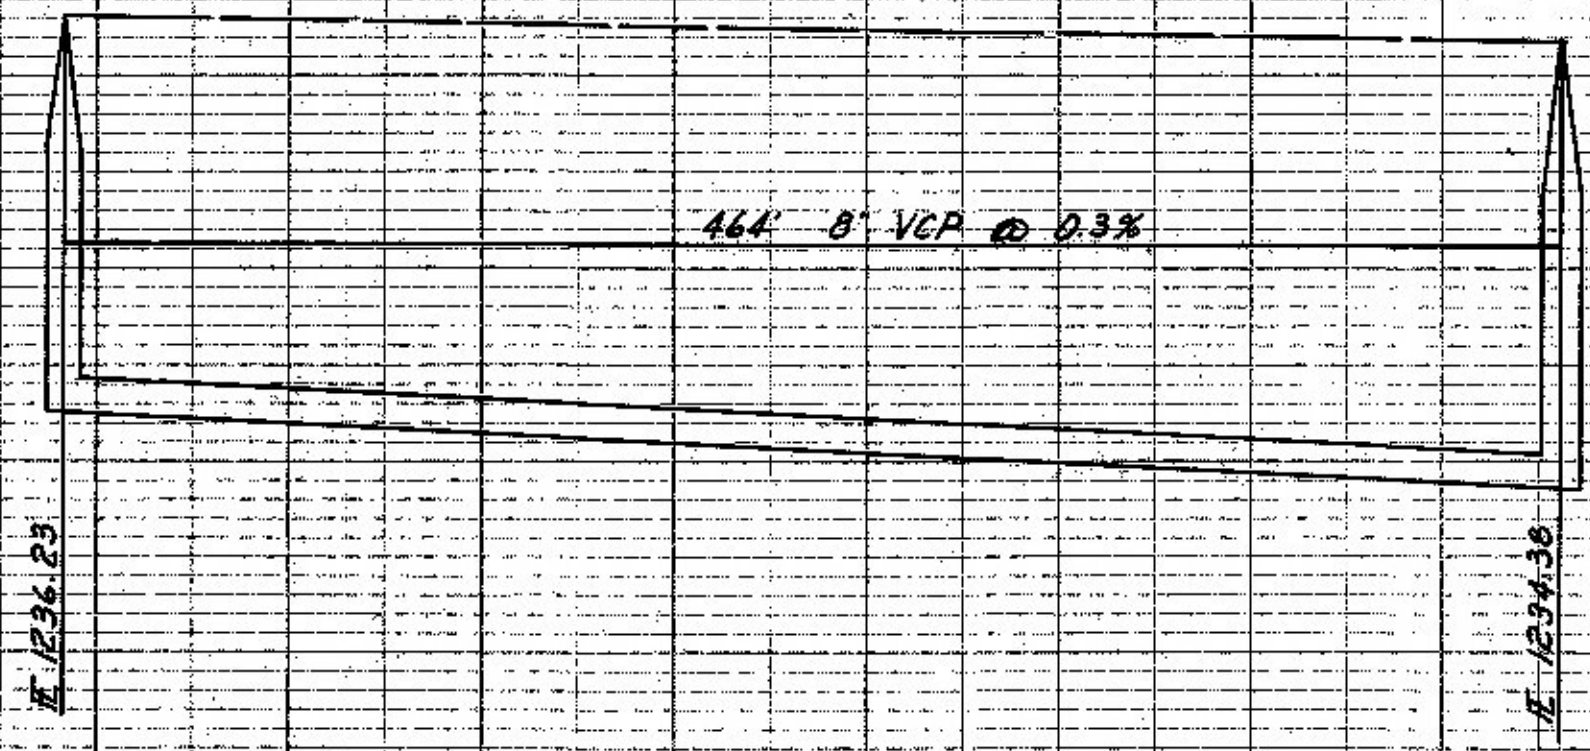

PROFILE
 DATE: _____
 BY: _____
 CHECKED: _____
 NO. _____

