


Scale - 1" = 50'

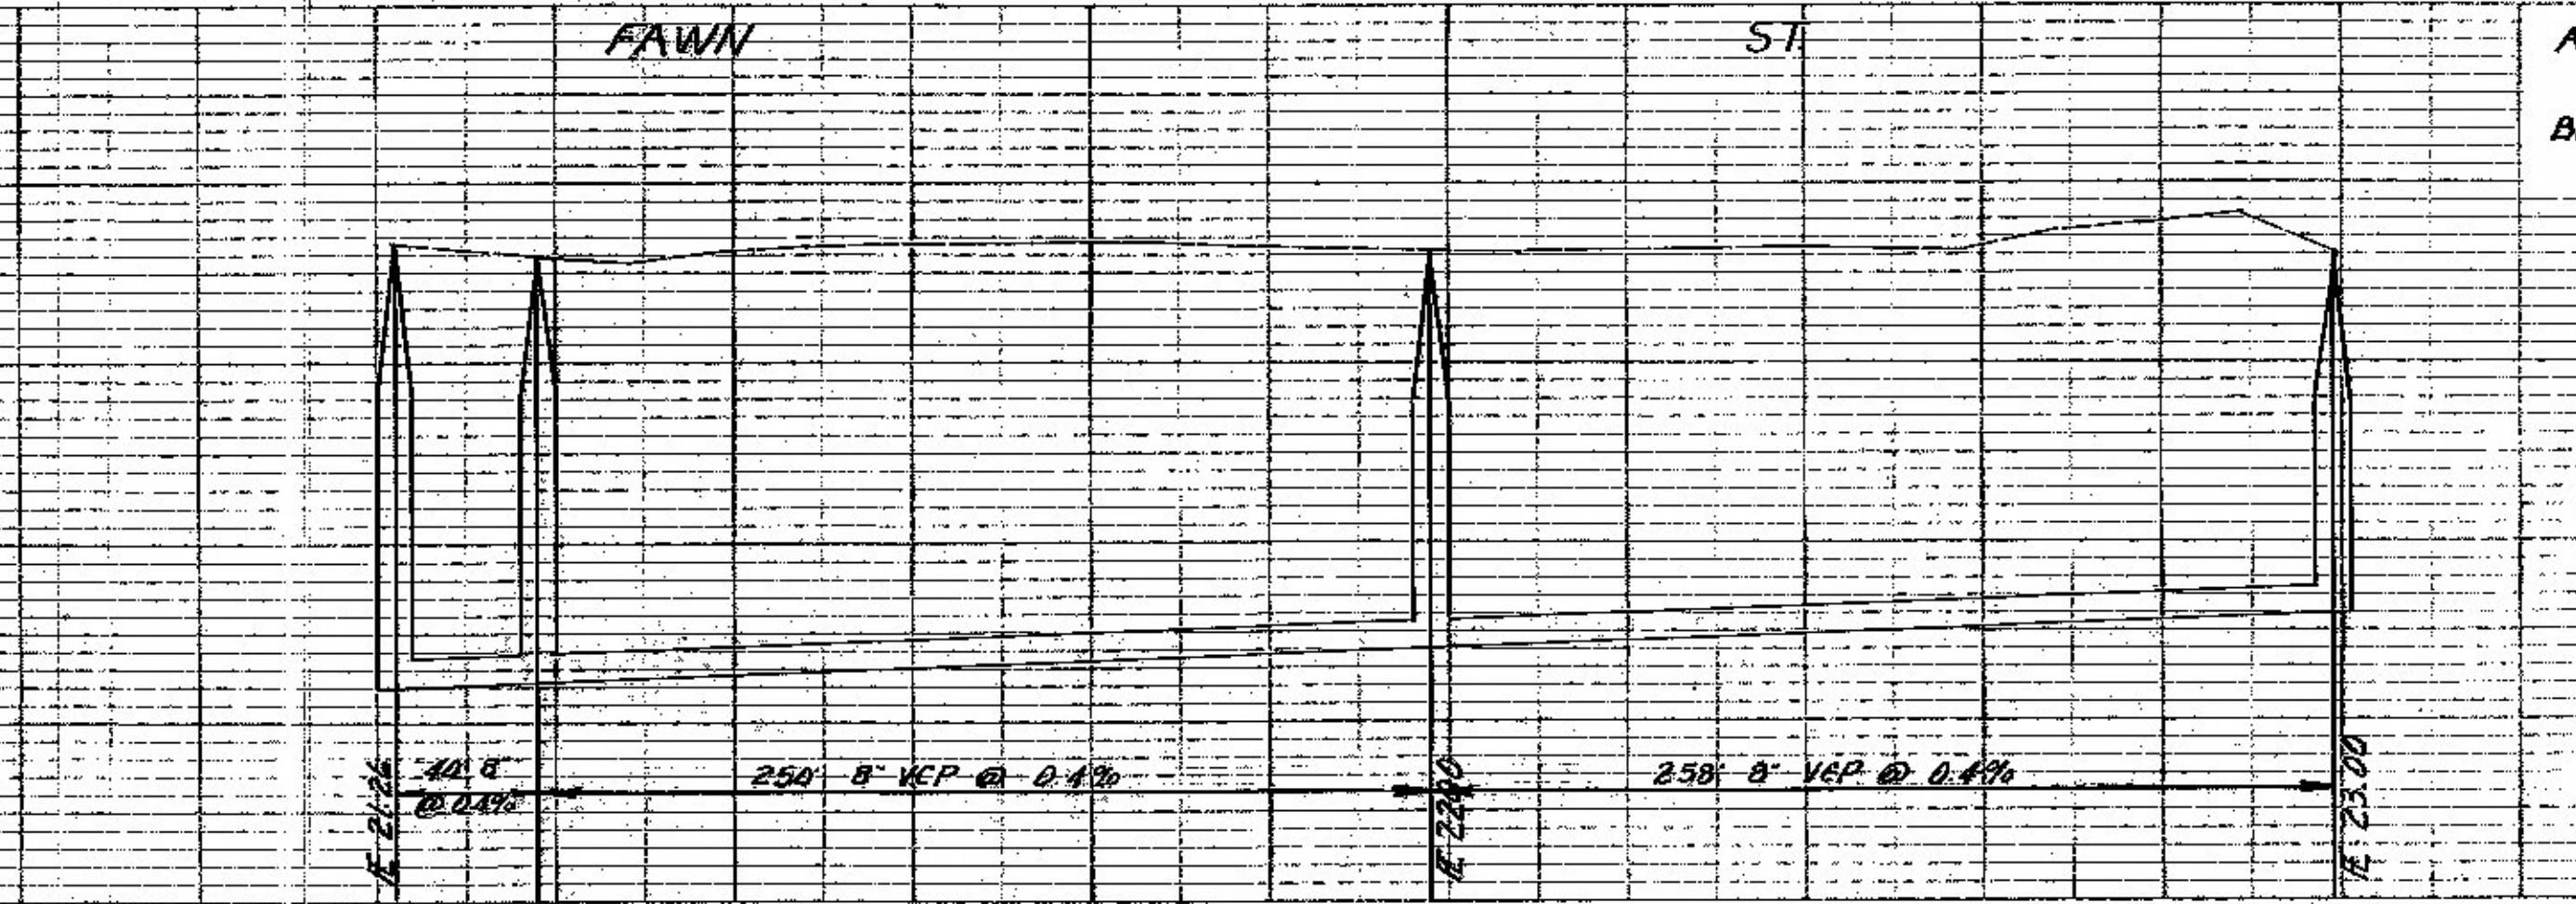

AS BUILT PLANS
JOB 508
BROWN & BROWN CONST.