



|      |                 |      |
|------|-----------------|------|
| PLAN | SURVEYED        | DATE |
|      | PLOTTED         |      |
|      | ALIGNED CHECKED |      |
|      | BY              |      |
|      | NO.             |      |

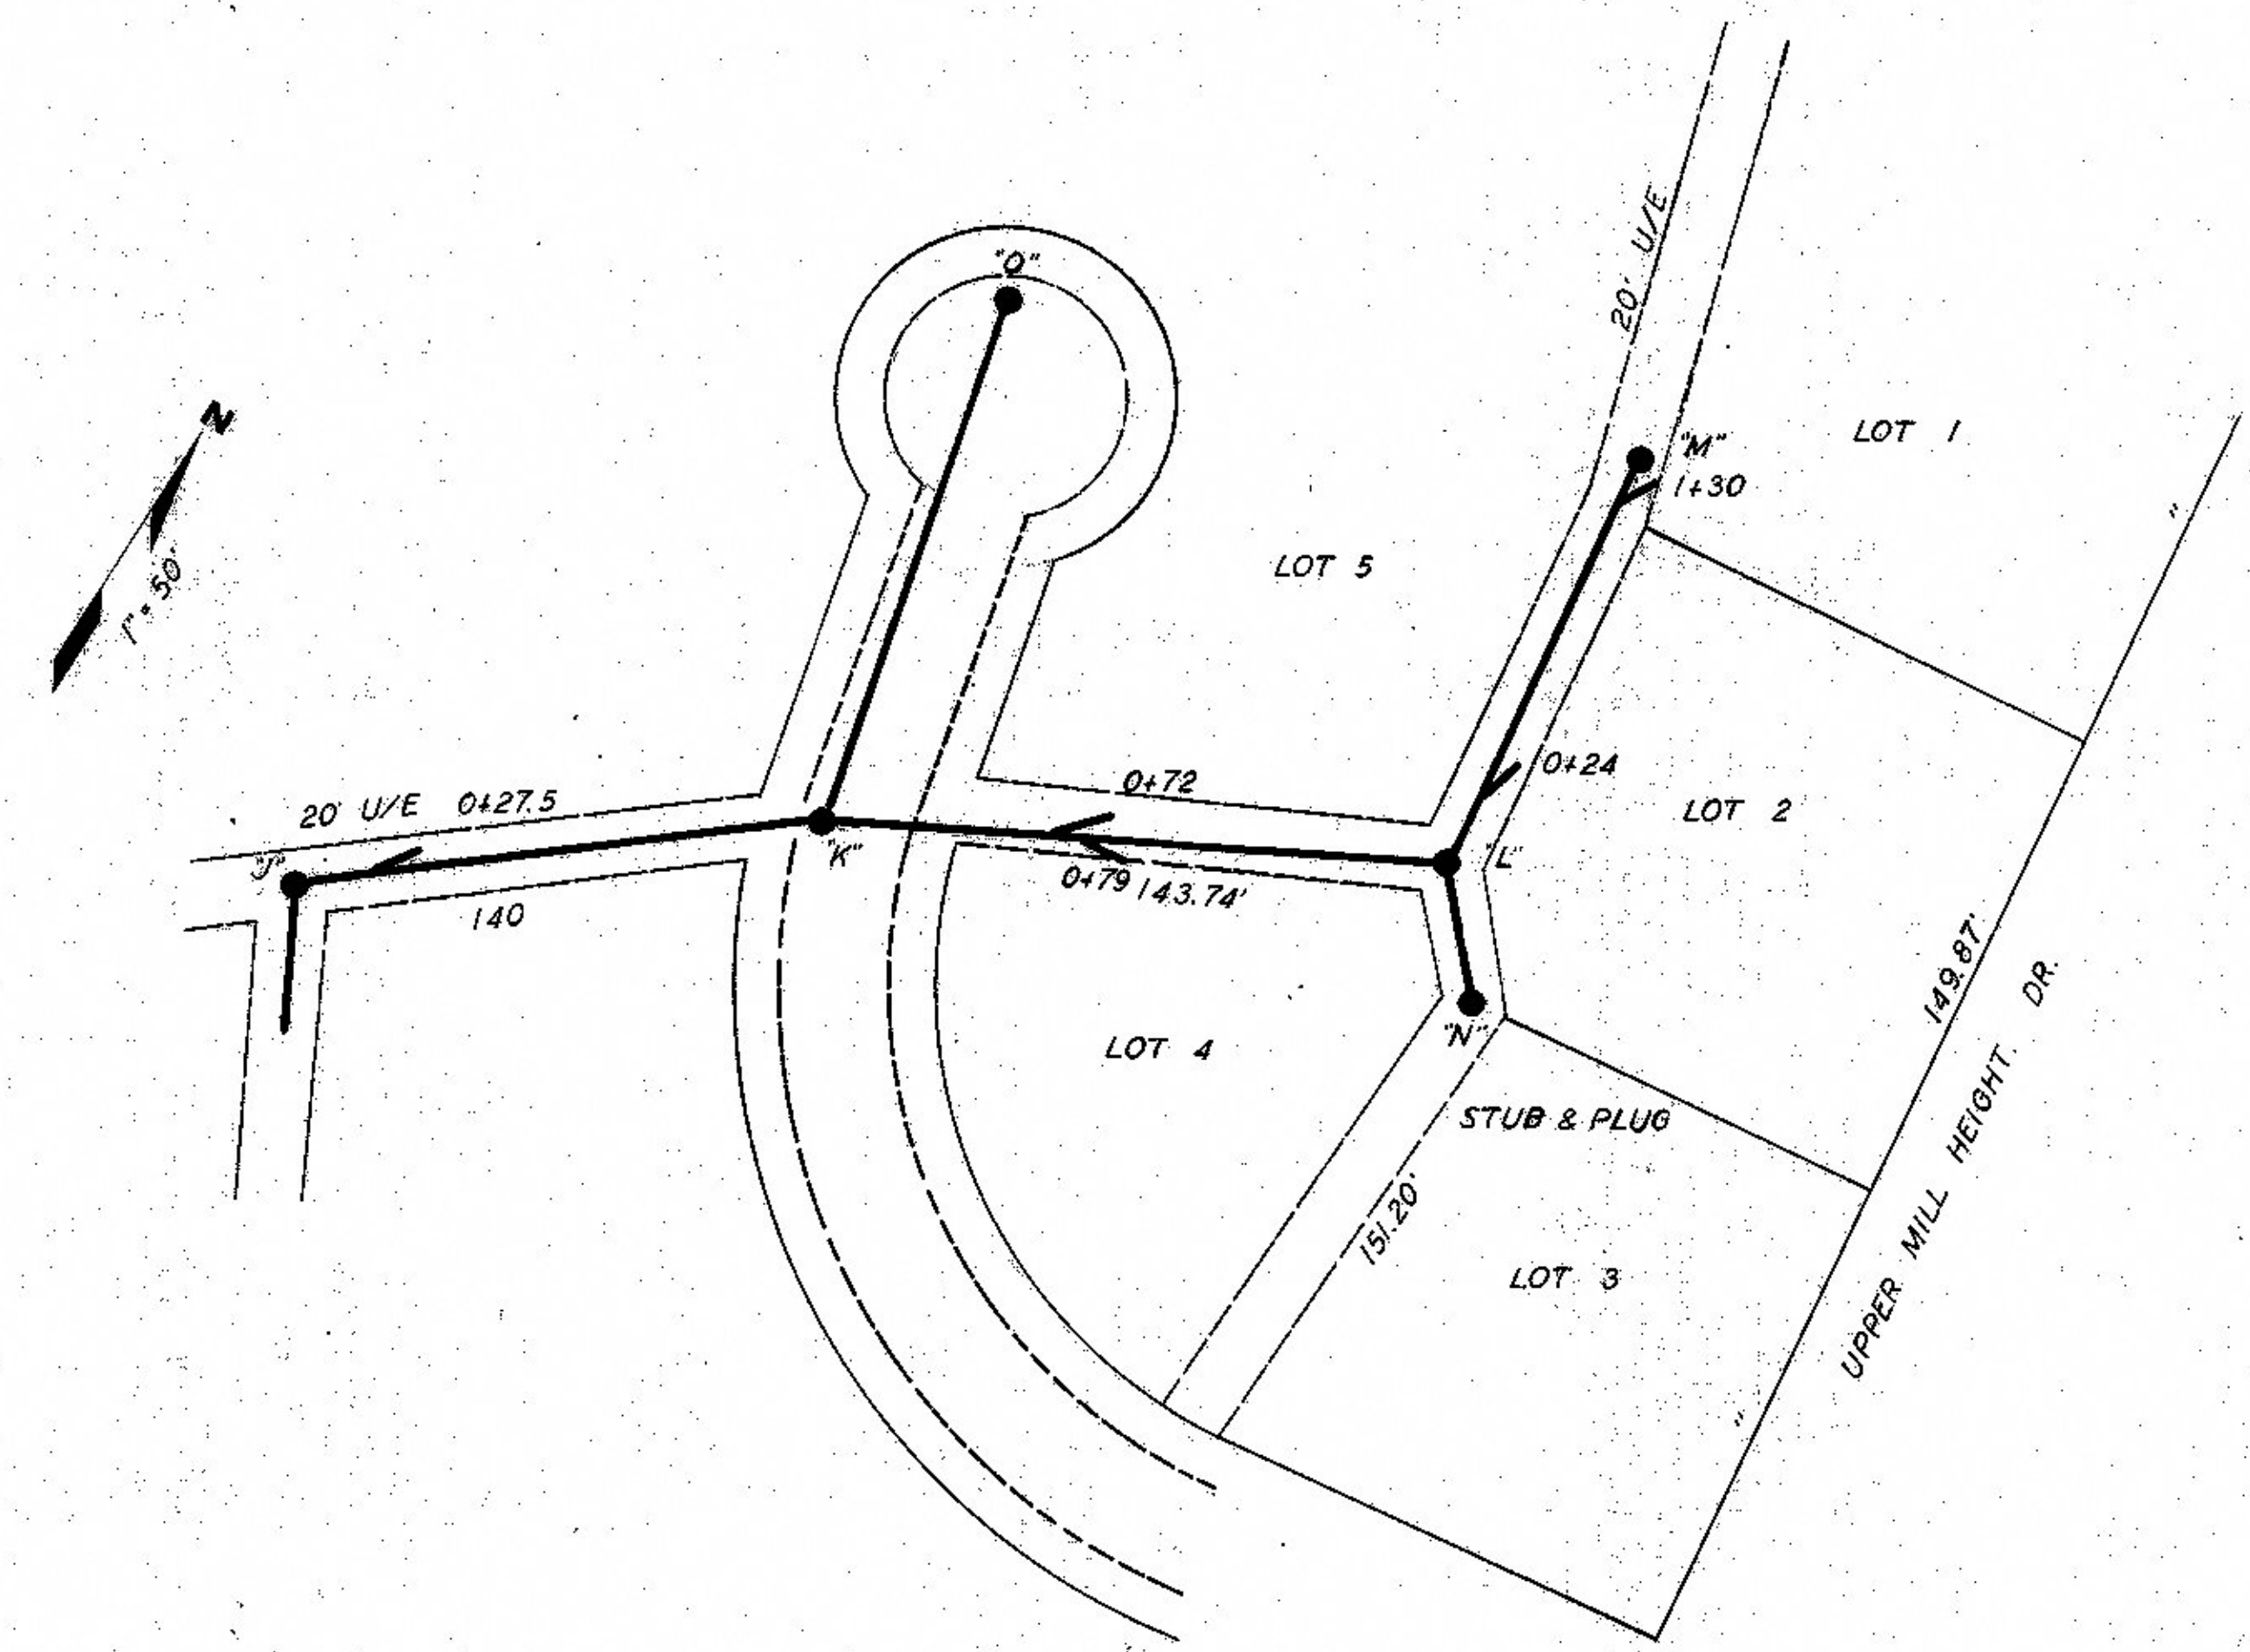

|         |                 |      |
|---------|-----------------|------|
| PROFILE | SURVEYED        | DATE |
|         | PLOTTED         |      |
|         | ALIGNED CHECKED |      |
|         | BY              |      |
|         | NO.             |      |

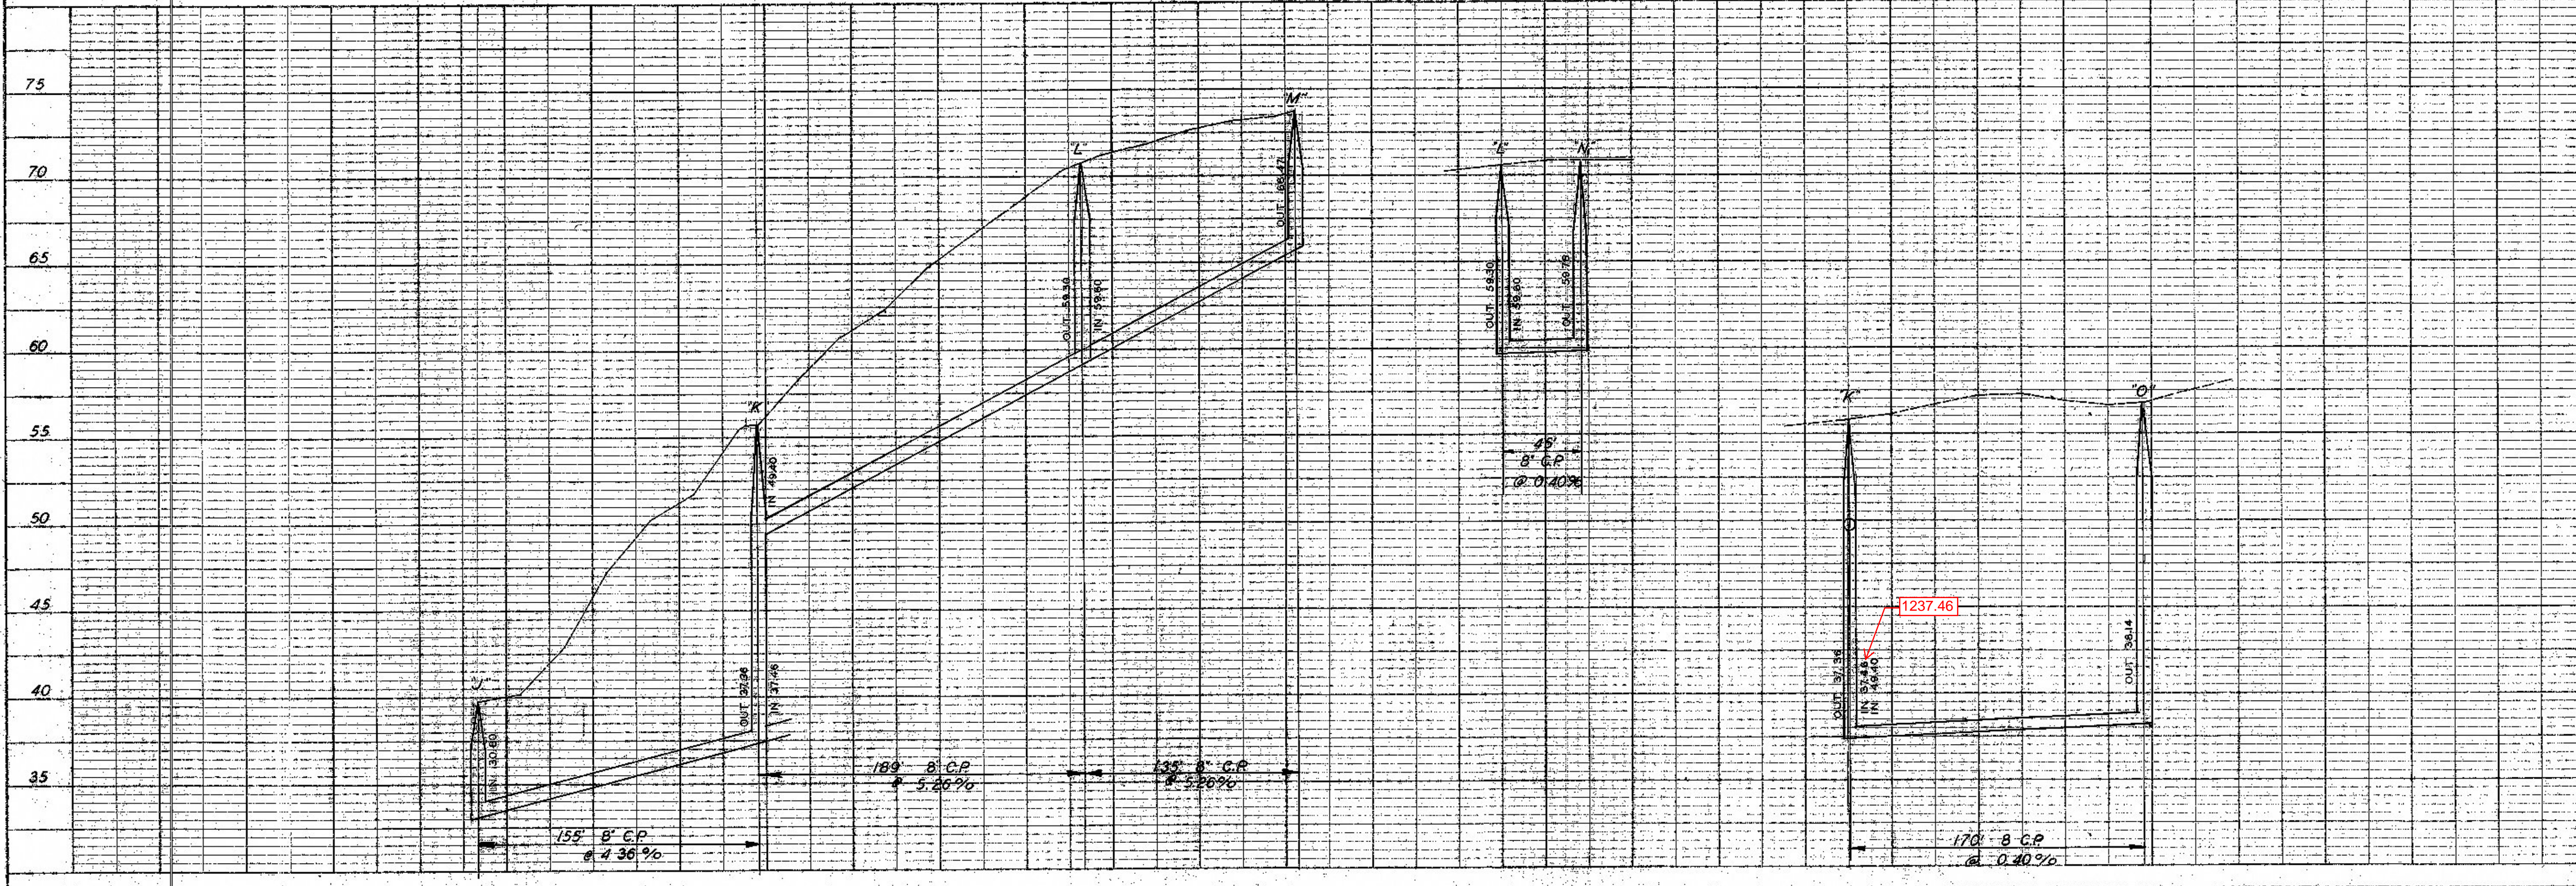

AS BUILT PLANS  
BROWN & BROWN CONST.  
MARCH 4, 1971